

Heaton
Cam

EXISTING 4"
SDR 26 PVC
WATER MAIN

INSTALL NEW 4" x 4" x 3"
TEE W/ DOUBLE BELL
REPAIR COUPLING AND 3"
GATE VALVE

INSTALL 1 STD.
FLUSH HYDRANT

RICHMOND

HORTON ROAD

BLOCK

LARABEE

WEST COUNTY LINE ROAD

INSTALL 3500' OF
3" SDR 26 PVC
WATER MAIN

KITTLE

ABEL

JOSEPH

PLAN LINE HORTON ROAD

SCALE: 1" = 500'

CHANGE ORDER NO. 3

DIVISION "D"

WATER MAIN EXTENSIONS
ELROD WATER CO., INC.

M.D. WESSLER & ASSOCIATES, INC.


SCALE: 1" = 500'

PROJECT NO.: 39592.04

FEB. 11, 1993

SHEET NO.: 1 OF 1

AS-BUILT 6/28/94

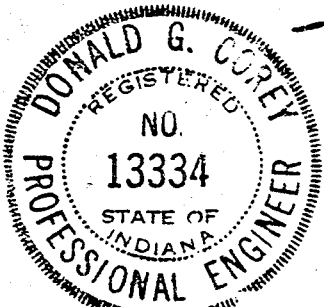

Donald G. Corey