



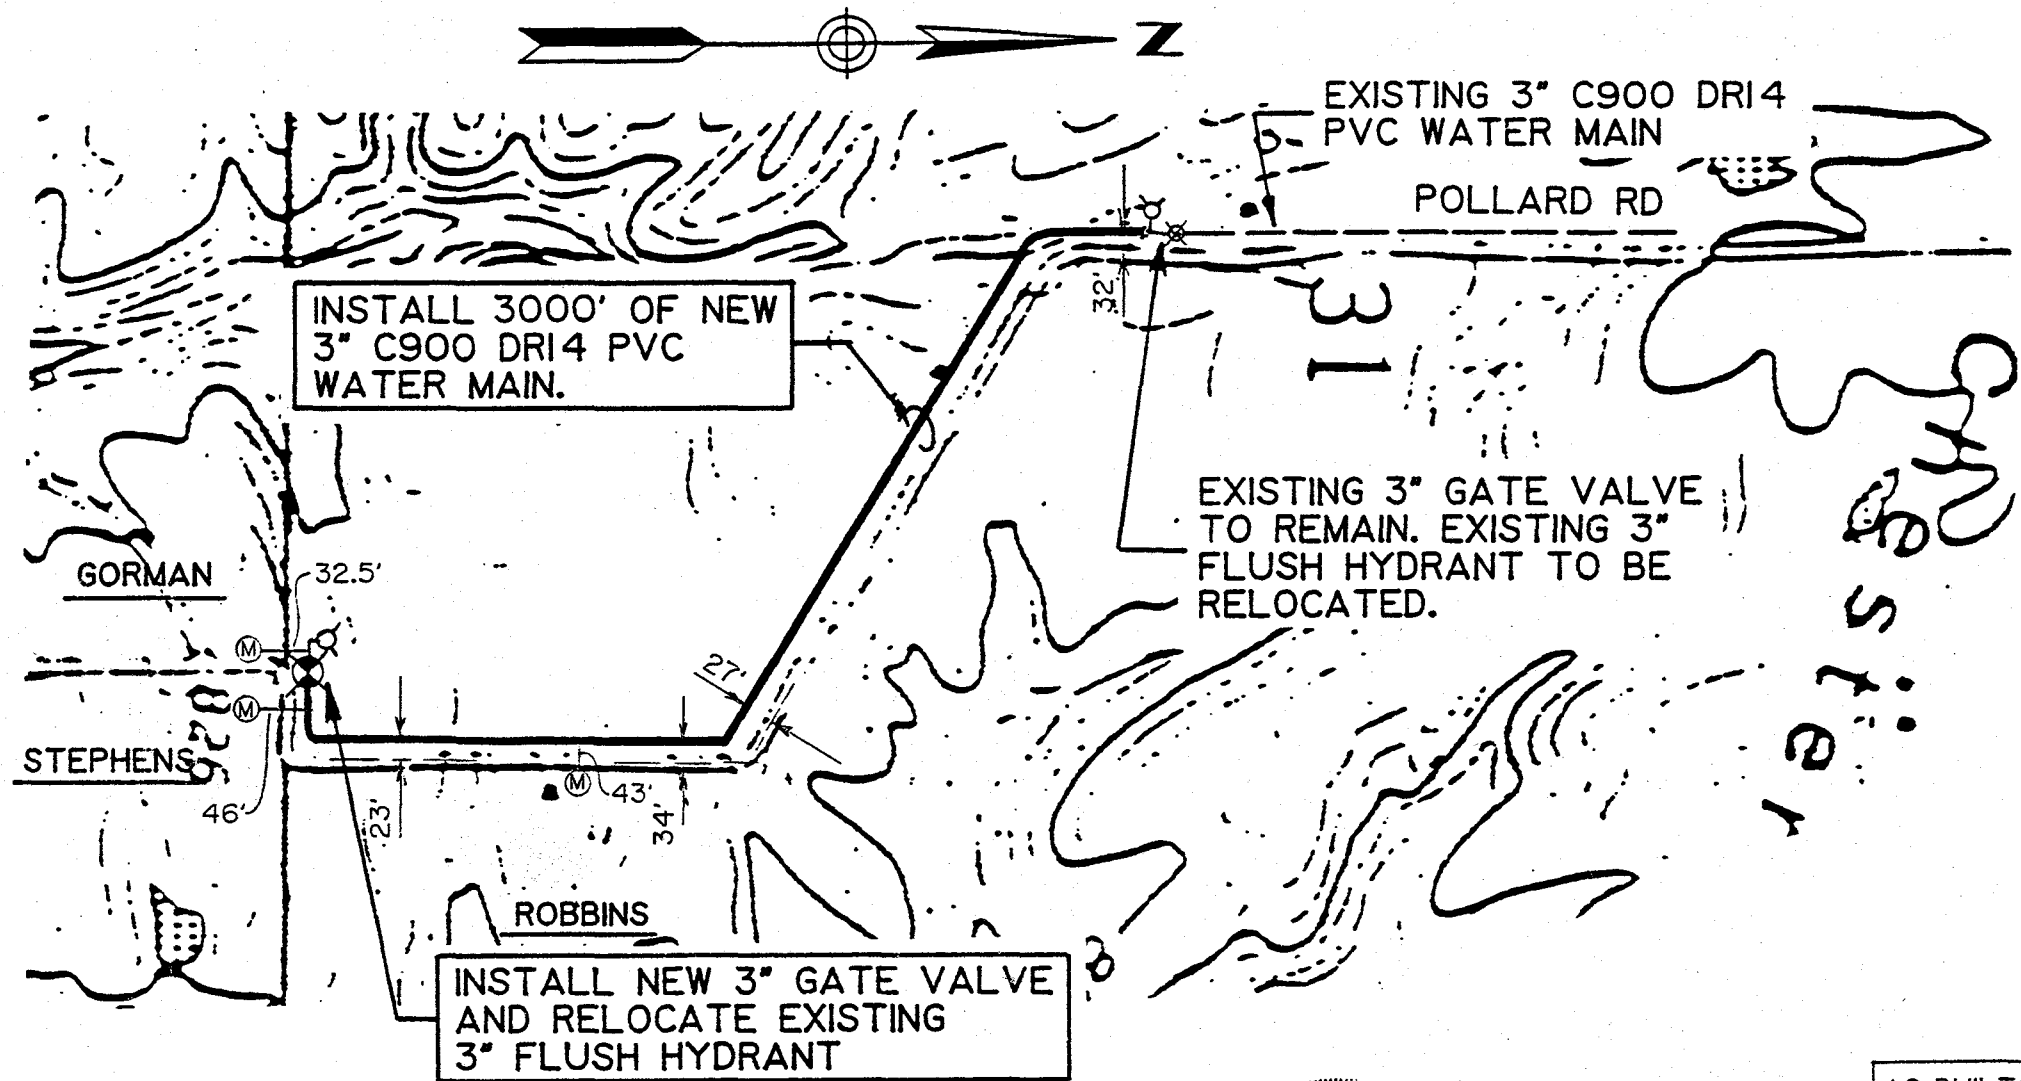

PLAN LINE POLLARD ROAD

SCALE: 1" = 500'

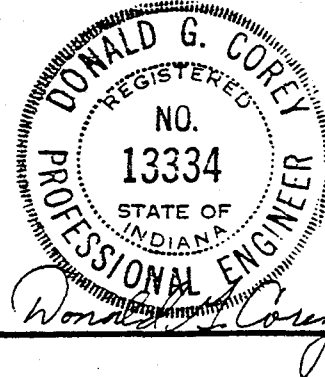

AS-BUILT 6/28/94

CHANGE ORDER NO. 3
DIVISION "D"
WATER MAIN EXTENSIONS
ELROD WATER CO., INC.

M.D. WESSLER & ASSOCIATES, INC.

SCALE: 1" = 500'

PROJECT NO. 39592.04

FEB. 11, 1993

SHEET NO. 1 OF 1