



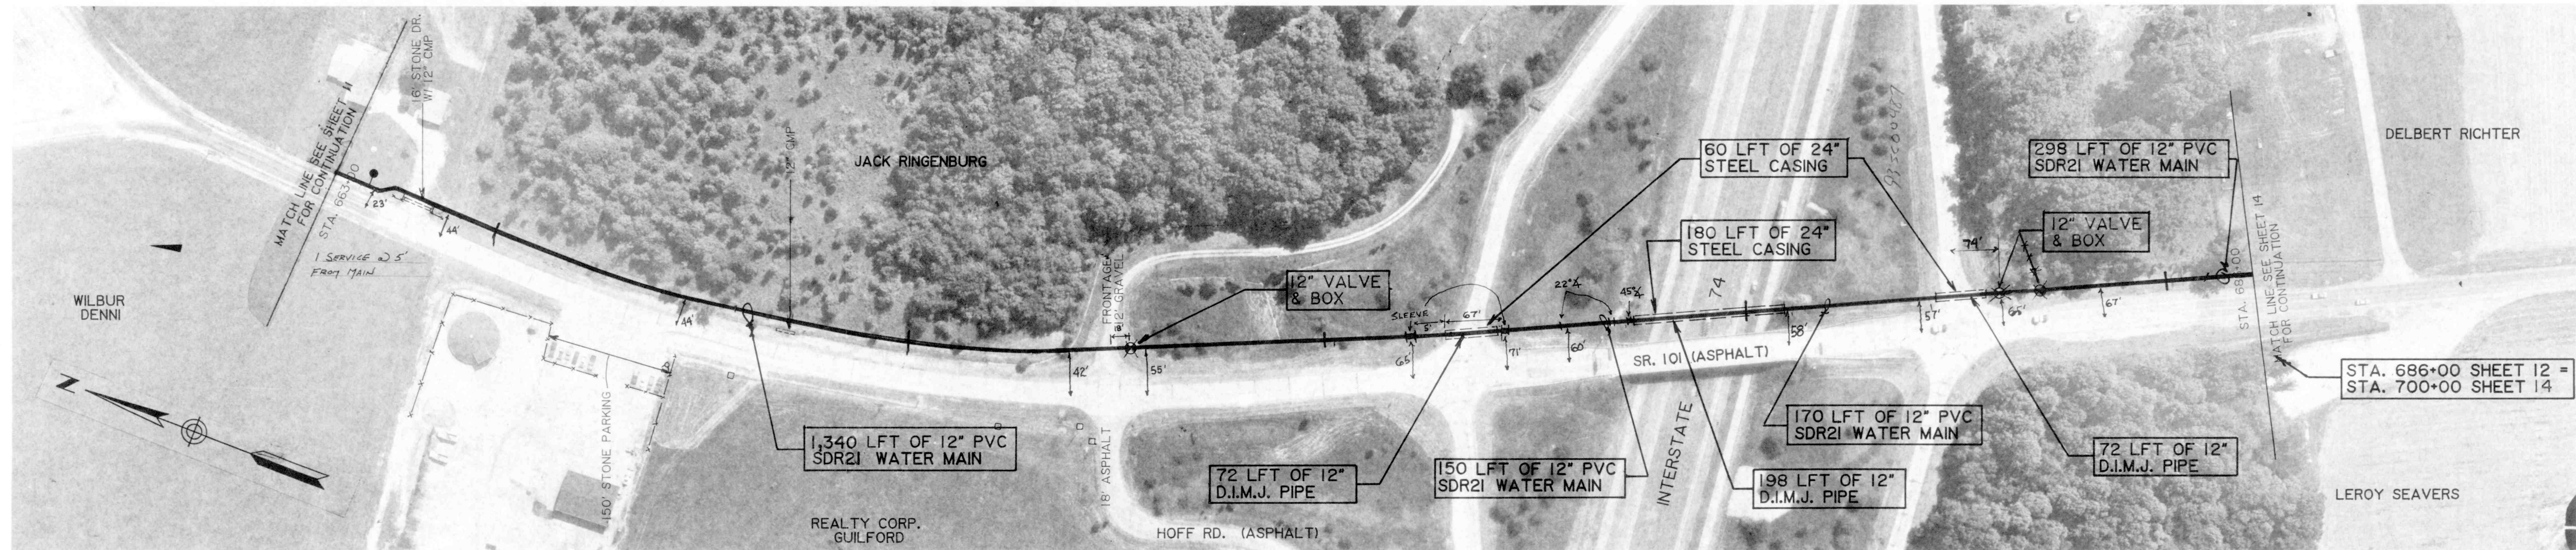

GROUND ELEV. = 990.0±
MAX. STATIC PRESS. = 77.9 PSI±

LINE A SR. 101

GROUND ELEV. 970.0±
MAX. STATIC PRESS. = 82.3 PSI±

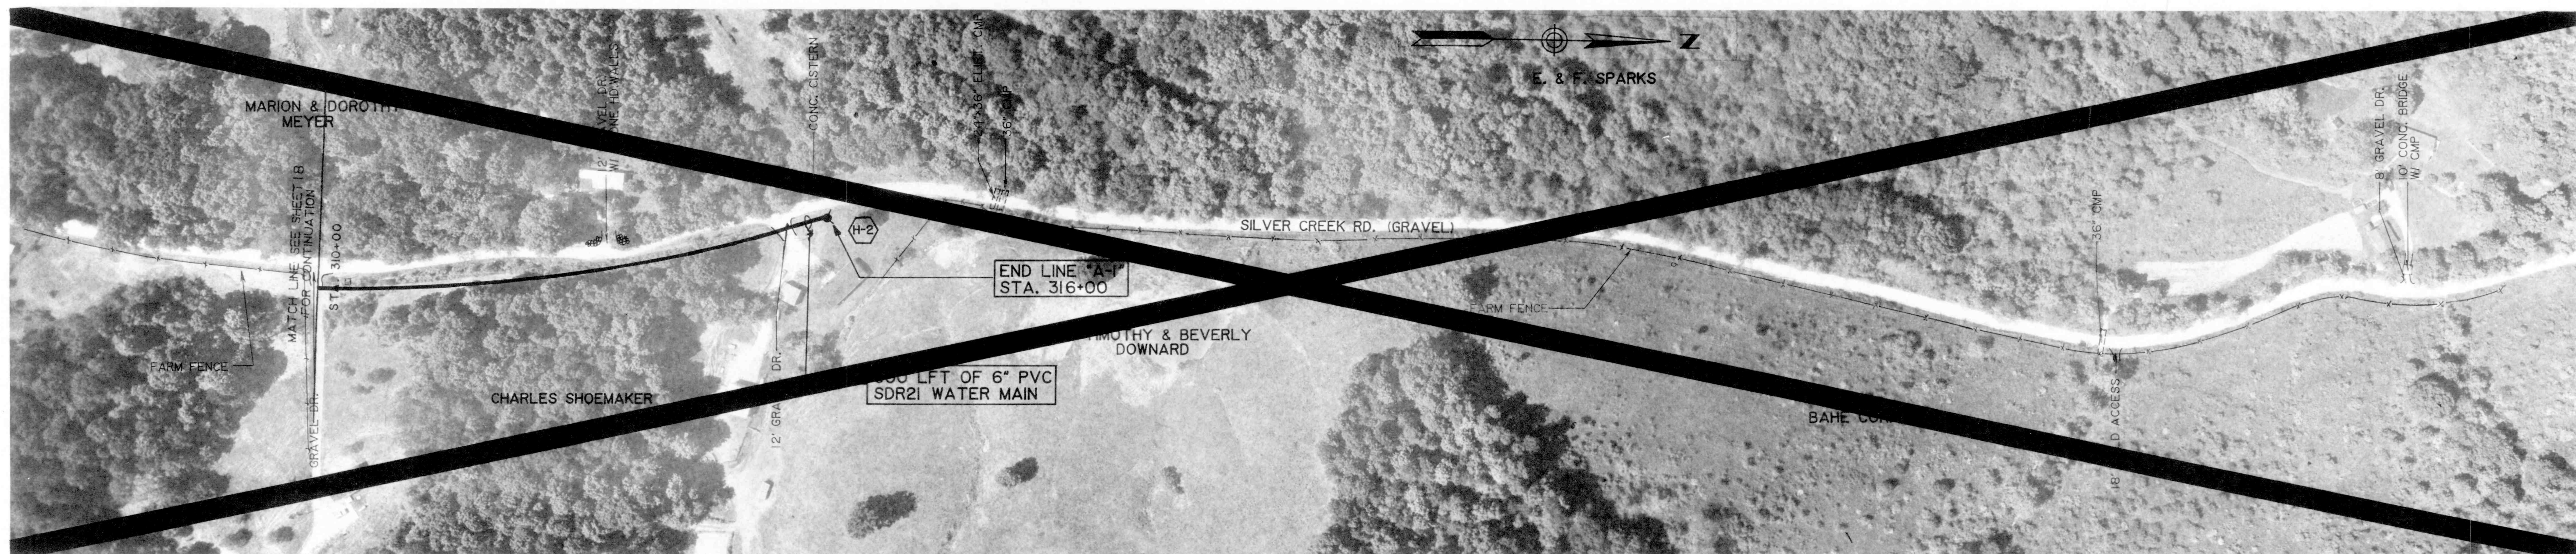

GROUND ELEV. = 865.0±
MAX. STATIC PRESS. = 127.8 PSI±

GROUND ELEV. = 850.0±
MAX. STATIC PRESS. = 134.2 PSI±

LINE A-1 SILVER CREEK RD.

CONTRACT "A"
WATER MAINS
LINES "A" & "A-1"
ELROD WATER COMPANY, INC.
DIVISION "E"
WATERWORKS SYSTEM IMPROVEMENTS

M.D. WESSLER and ASSOCIATES
CONSULTING ENGINEERS
6219 South East Street, Suite A
Indianapolis, Indiana 46227-2148

SCALE: 1" = 100'
DATE: OCT. 14, 1993
PROJECT NO.: 37391.04
DRAWN BY: CLG
APPROVED BY: DRC

NOT PUBLISHED
ALL RIGHTS RESERVED
EXCEPT FOR USES EXPRESSLY
PERMITTED IN WRITING, INFOR-
MATION SHOWN OR INCLUDED
IN THIS DOCUMENT IS SOLELY
THE PROPERTY OF M.D.
WESSLER & ASSOCIATES, INC.



PHOTOGRAPH BY: ACQUAIR SURVEYS, INC., SEYMOUR, INDIANA

SHEET A 12
OF 45

RECORD DRAWINGS
These drawings have been prepared from
information by others. Engineer will not
be responsible for errors and omissions
in the information or records from which
these drawings are produced.