
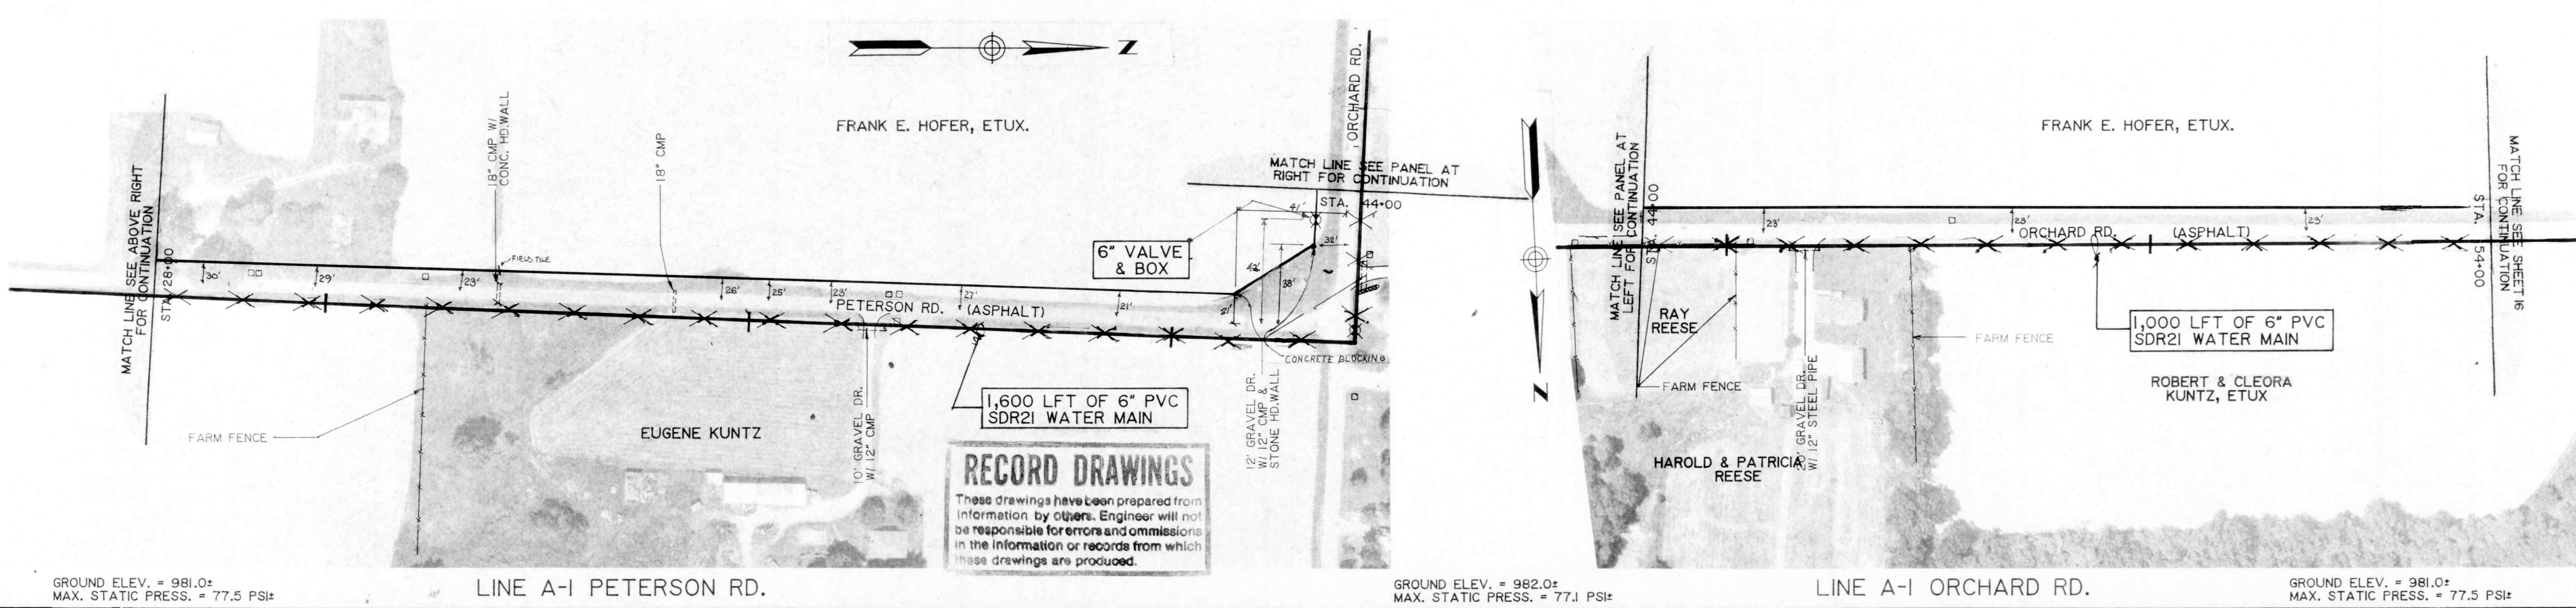


20 ALS

1100

McGraw-Hill
Engineering & Construction
Group

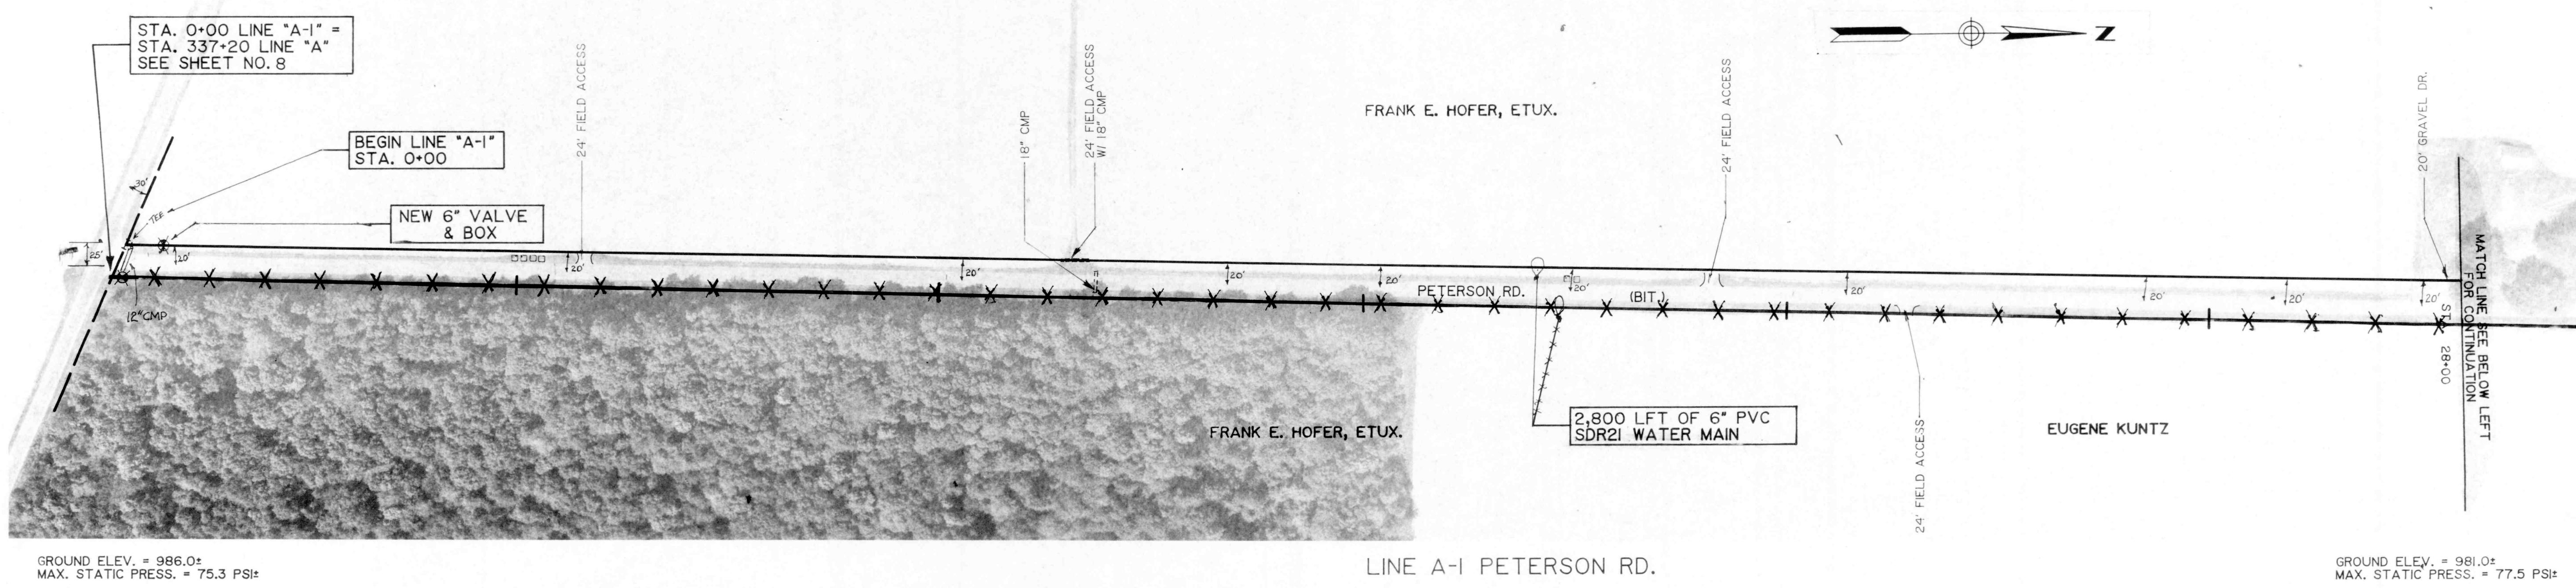

RECORD DRAWINGS
These drawings have been prepared from
information by others. Engineer will not
be responsible for errors and omissions
in the information or records from which
these drawings are produced.

NO.	DATE	BY	REVISIONS
1	10/3/94	CLG	CORRECTED PROP. OWNERS

CONTRACT "A"
WATER MAINS
LINE "A-1"
ELROD WATER COMPANY, INC.
DIVISION "E"
WATERWORKS SYSTEM IMPROVEMENTS

M.D. WESSLER
ASSOCIATES
CONSULTING ENGINEERS
6219 South East Street, Suite A
Indianapolis, Indiana 46227-2148

SCALE: 1" = 100'
DATE: OCT. 14, 1993
PROJECT NO.: 37391.04
DRAWN BY: CLG
APPROVED BY: DGC

NOT PUBLISHED
ALL RIGHTS RESERVED
EXCEPT FOR USES EXPRESSLY
PERMITTED IN WRITING, INFOR-
MATION SHOWN OR INCLUDED
IN THIS DOCUMENT IS SOLELY
THE PROPERTY OF M.D. WESSLER
& ASSOCIATES, INC.



SHEET A 15
OF 45

PHOTOGRAPHY BY ACCULAIR SURVEYS, INC., SEYMOUR, INDIANA