


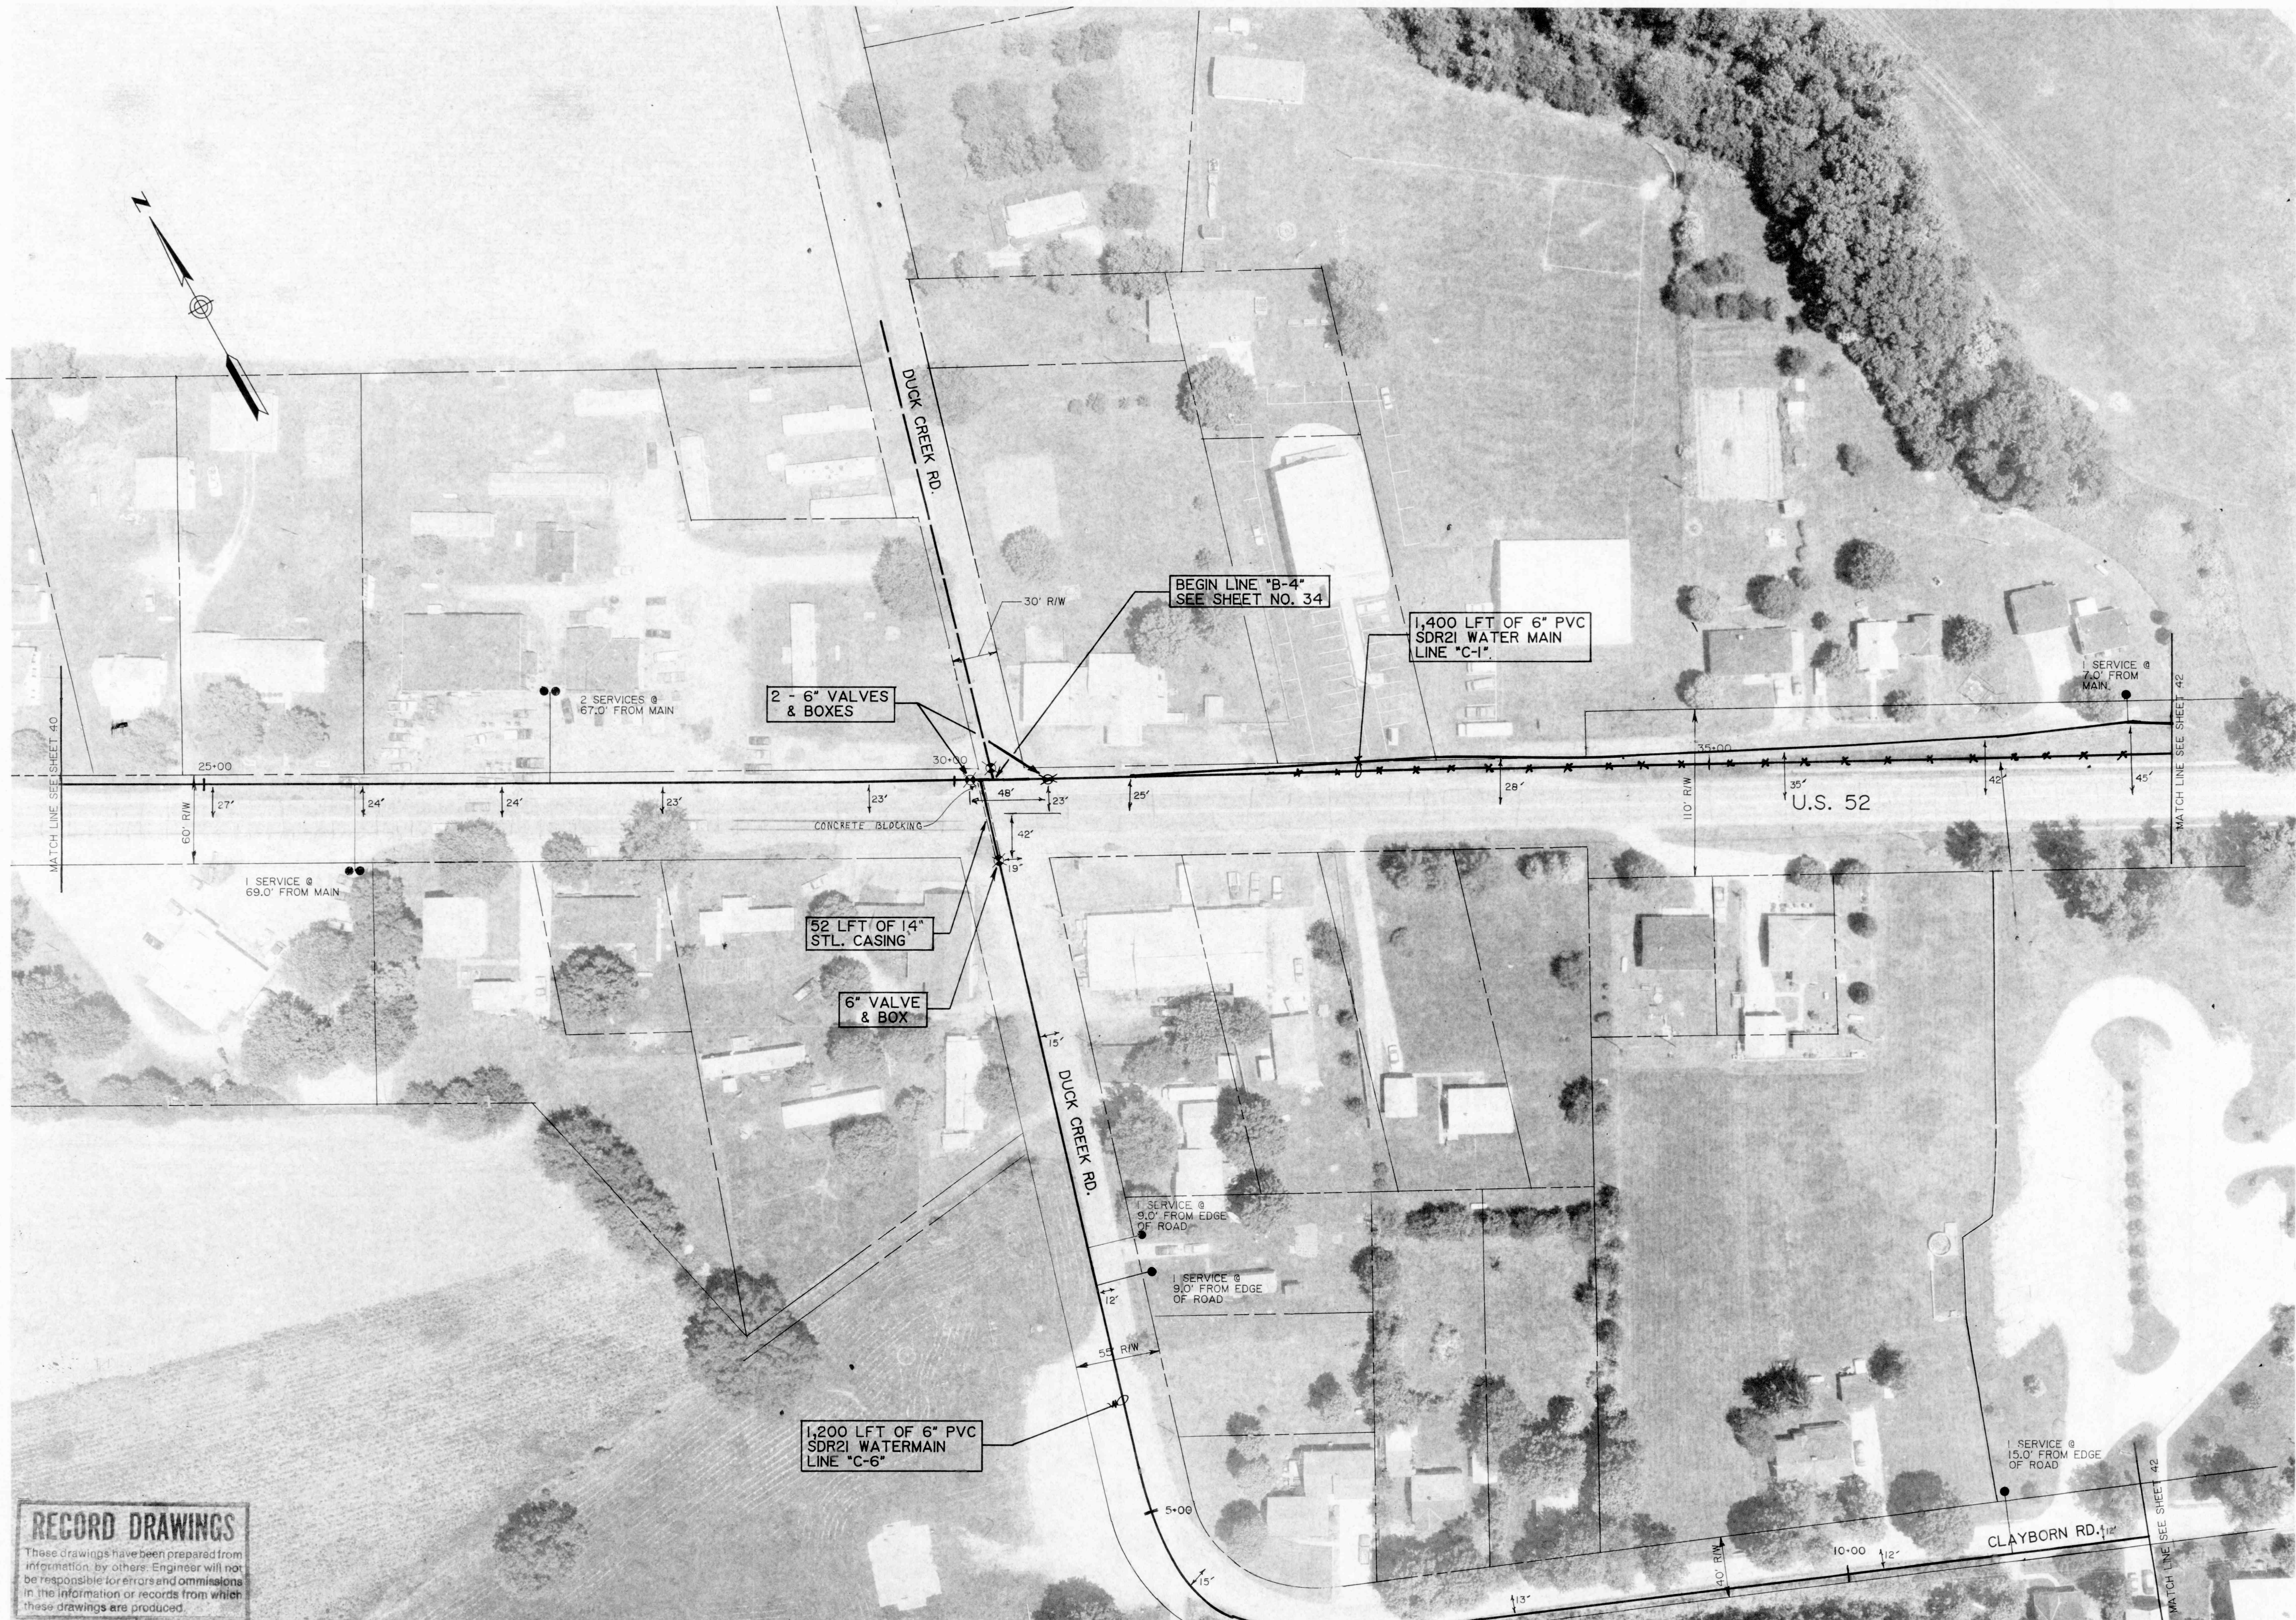

RECORD DRAWINGS
These drawings have been prepared from information by others. Engineer will not be responsible for errors and omissions in the information or records from which these drawings are produced.

CONTRACT "A" WATER MAINS LINES "C-1" & "C-6"		ELROD WATER COMPANY, INC. DIVISION "E" WATERWORKS SYSTEM IMPROVEMENTS	
M.B. WESSLER and ASSOCIATES CONSULTING ENGINEERS 6219 South East Street, Suite A Indianapolis, Indiana 46227-2148		DATE: 3/4/94 BY: CLG NO. 1 GENERAL REVISIONS	
SCALE: 1" = 50'	DATE: OCT. 14, 1993	PROJECT NO.: 37391.04	
DRAWN BY: CLG		APPROVED BY: DGC	
NOT PUBLISHED ALL RIGHTS RESERVED EXCEPT FOR USES EXPRESSLY PERMITTED IN WRITING, INFORMATION SHOWN OR INCLUDED IN THIS DOCUMENT IS SOLELY THE PROPERTY OF M.D. WESSLER & ASSOCIATES, INC.			
DOUGLAS B. WESSLER REGISTERED PROFESSIONAL ENGINEER NO. 13334 STATE OF INDIANA		SHEET A 41 OF 45	

PHOTOGRAPHY BY ACULAIR SURVEYS, INC., SEYMOUR, INDIANA