


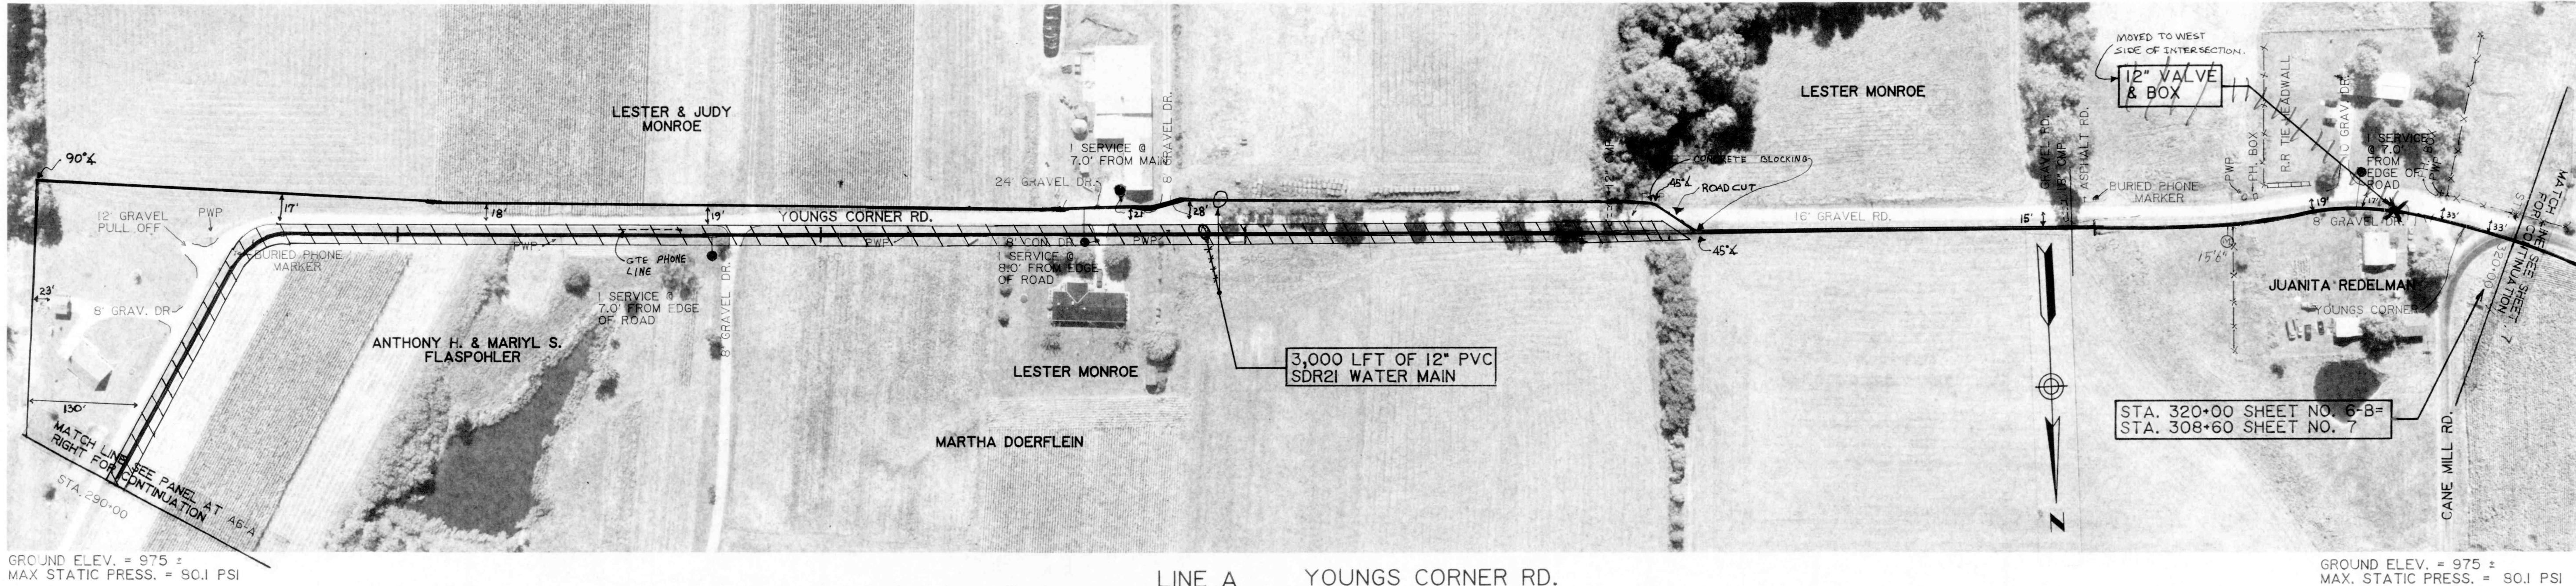

RECORD DRAWINGS

These drawings have been prepared from information by others. Engineer will not be responsible for errors and omissions in the information or records from which these drawings are produced.

SCALE: 1" = 100' DATE: 3/7/94 PROJECT NO.: 37391.04 DRAWN BY: CLG APPROVED BY: MAW		NOT PUBLISHED ALL RIGHTS RESERVED EXCEPT FOR USES EXPRESSLY PERMITTED IN WRITING, INFORMATION SHOWN OR INCLUDED IN THIS DOCUMENT IS SOLELY THE PROPERTY OF M.D. WESSLER & ASSOCIATES, INC.		MARTIN A. WESSLER REGISTERED No. 3300188 STATE OF INDIANA PROFESSIONAL ENGINEER		SHEET A6-B OF 45	
CONTRACT "A" WATER MAINS		ELROD WATER COMPANY, INC. DIVISION "E" WATERWORKS SYSTEM IMPROVEMENTS		M.D. WESSLER and ASSOCIATES CONSULTING ENGINEERS 6219 South East Street, Suite A Indianapolis, Indiana 46227-2148		2 10/3/94 CLG CORRECTED PROP. OWNERS 1 3/4/94 CLG ADDED THIS SHEET NO. DATE BY REVISIONS	