



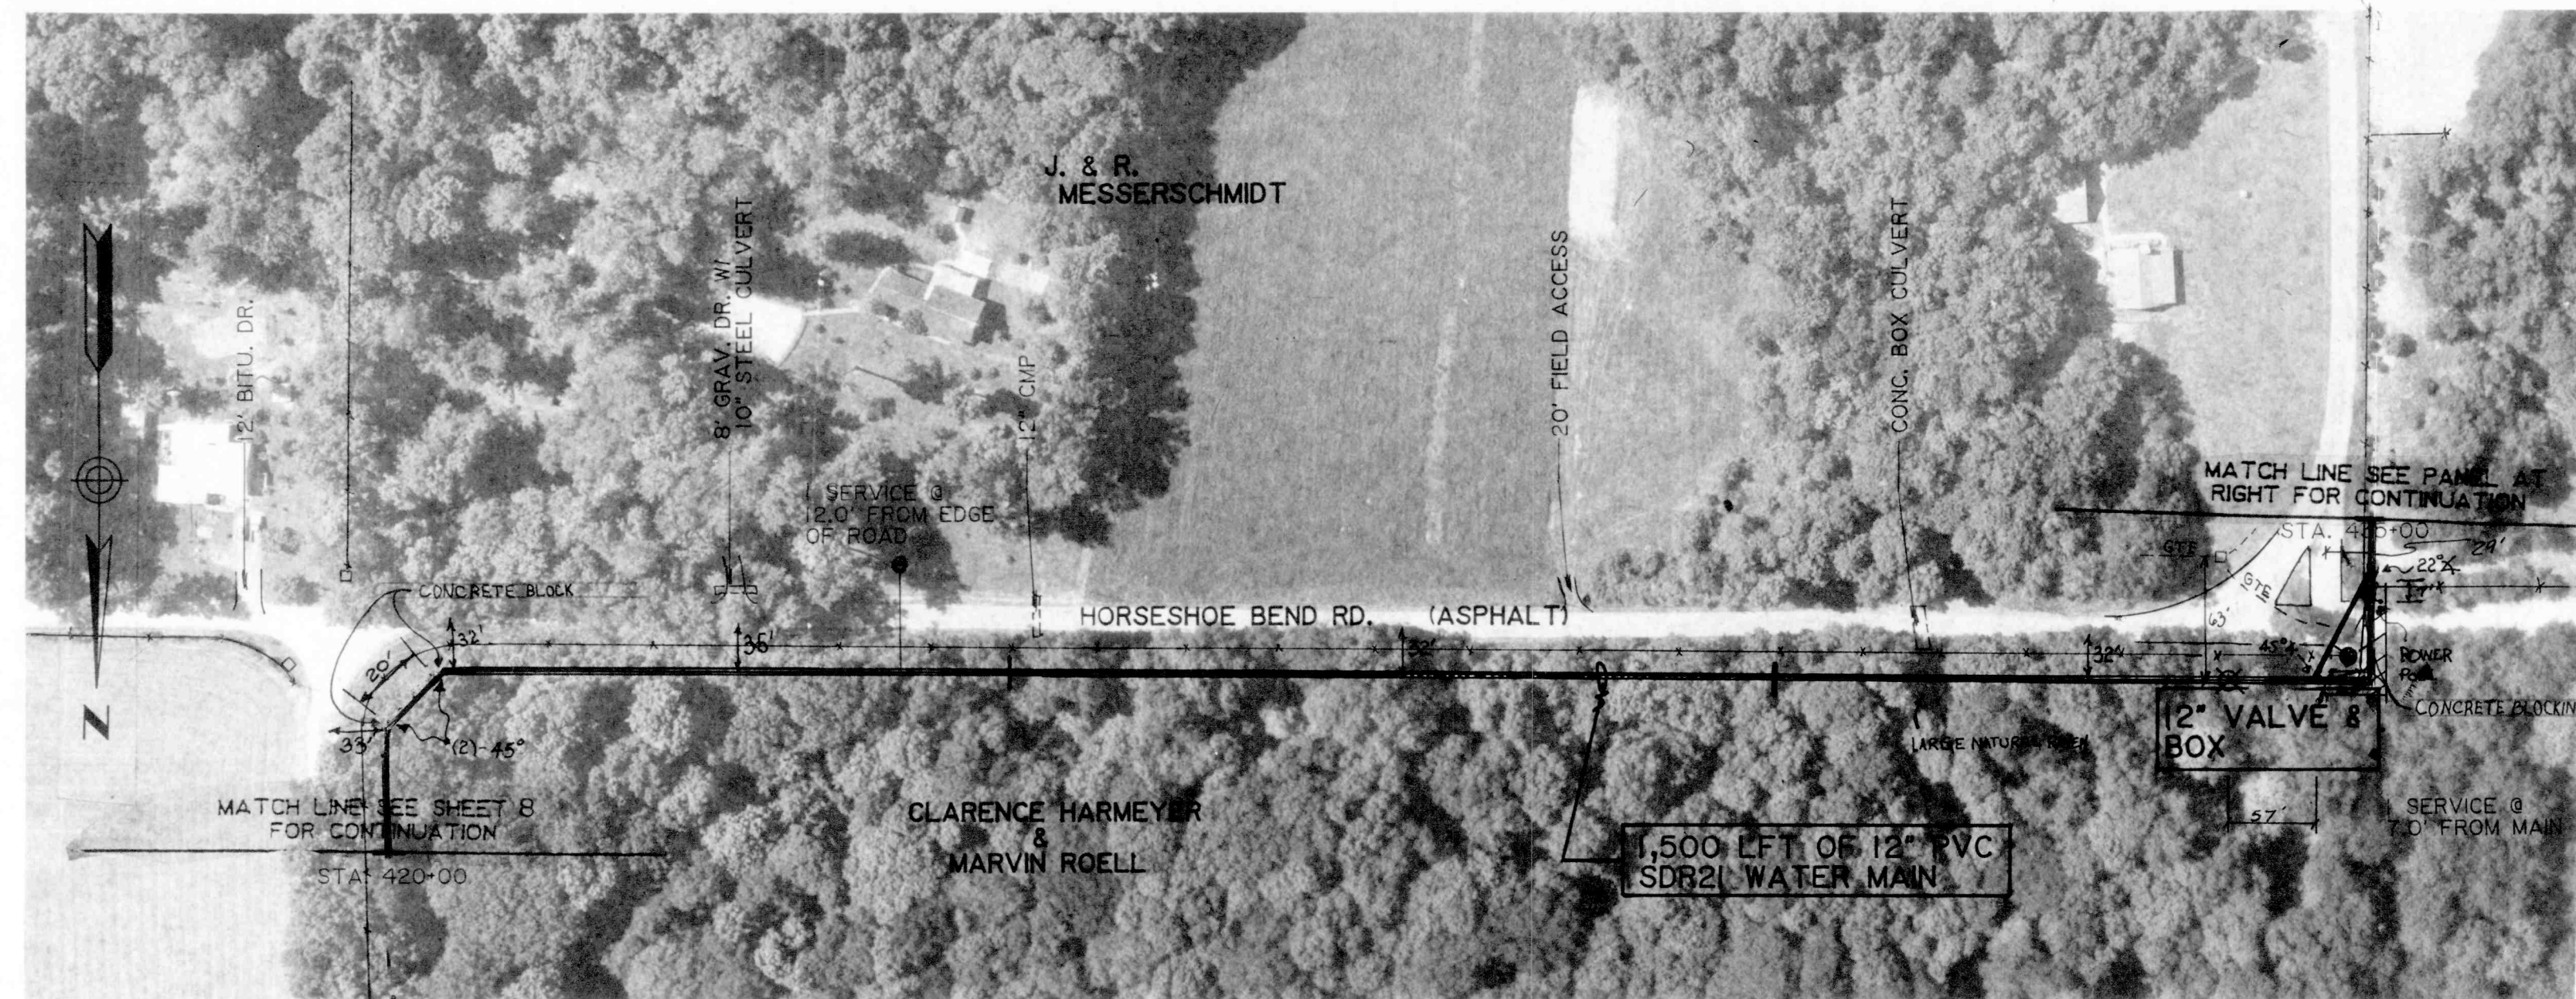

GROUND ELEV. = 980.0 ±
MAX. STATIC PRESS. = 77.9 PSI ±

LINE A HORSESHOE BEND RD.


GROUND ELEV. = 975.0 ±
MAX. STATIC PRESS. = 80.1 PSI ±

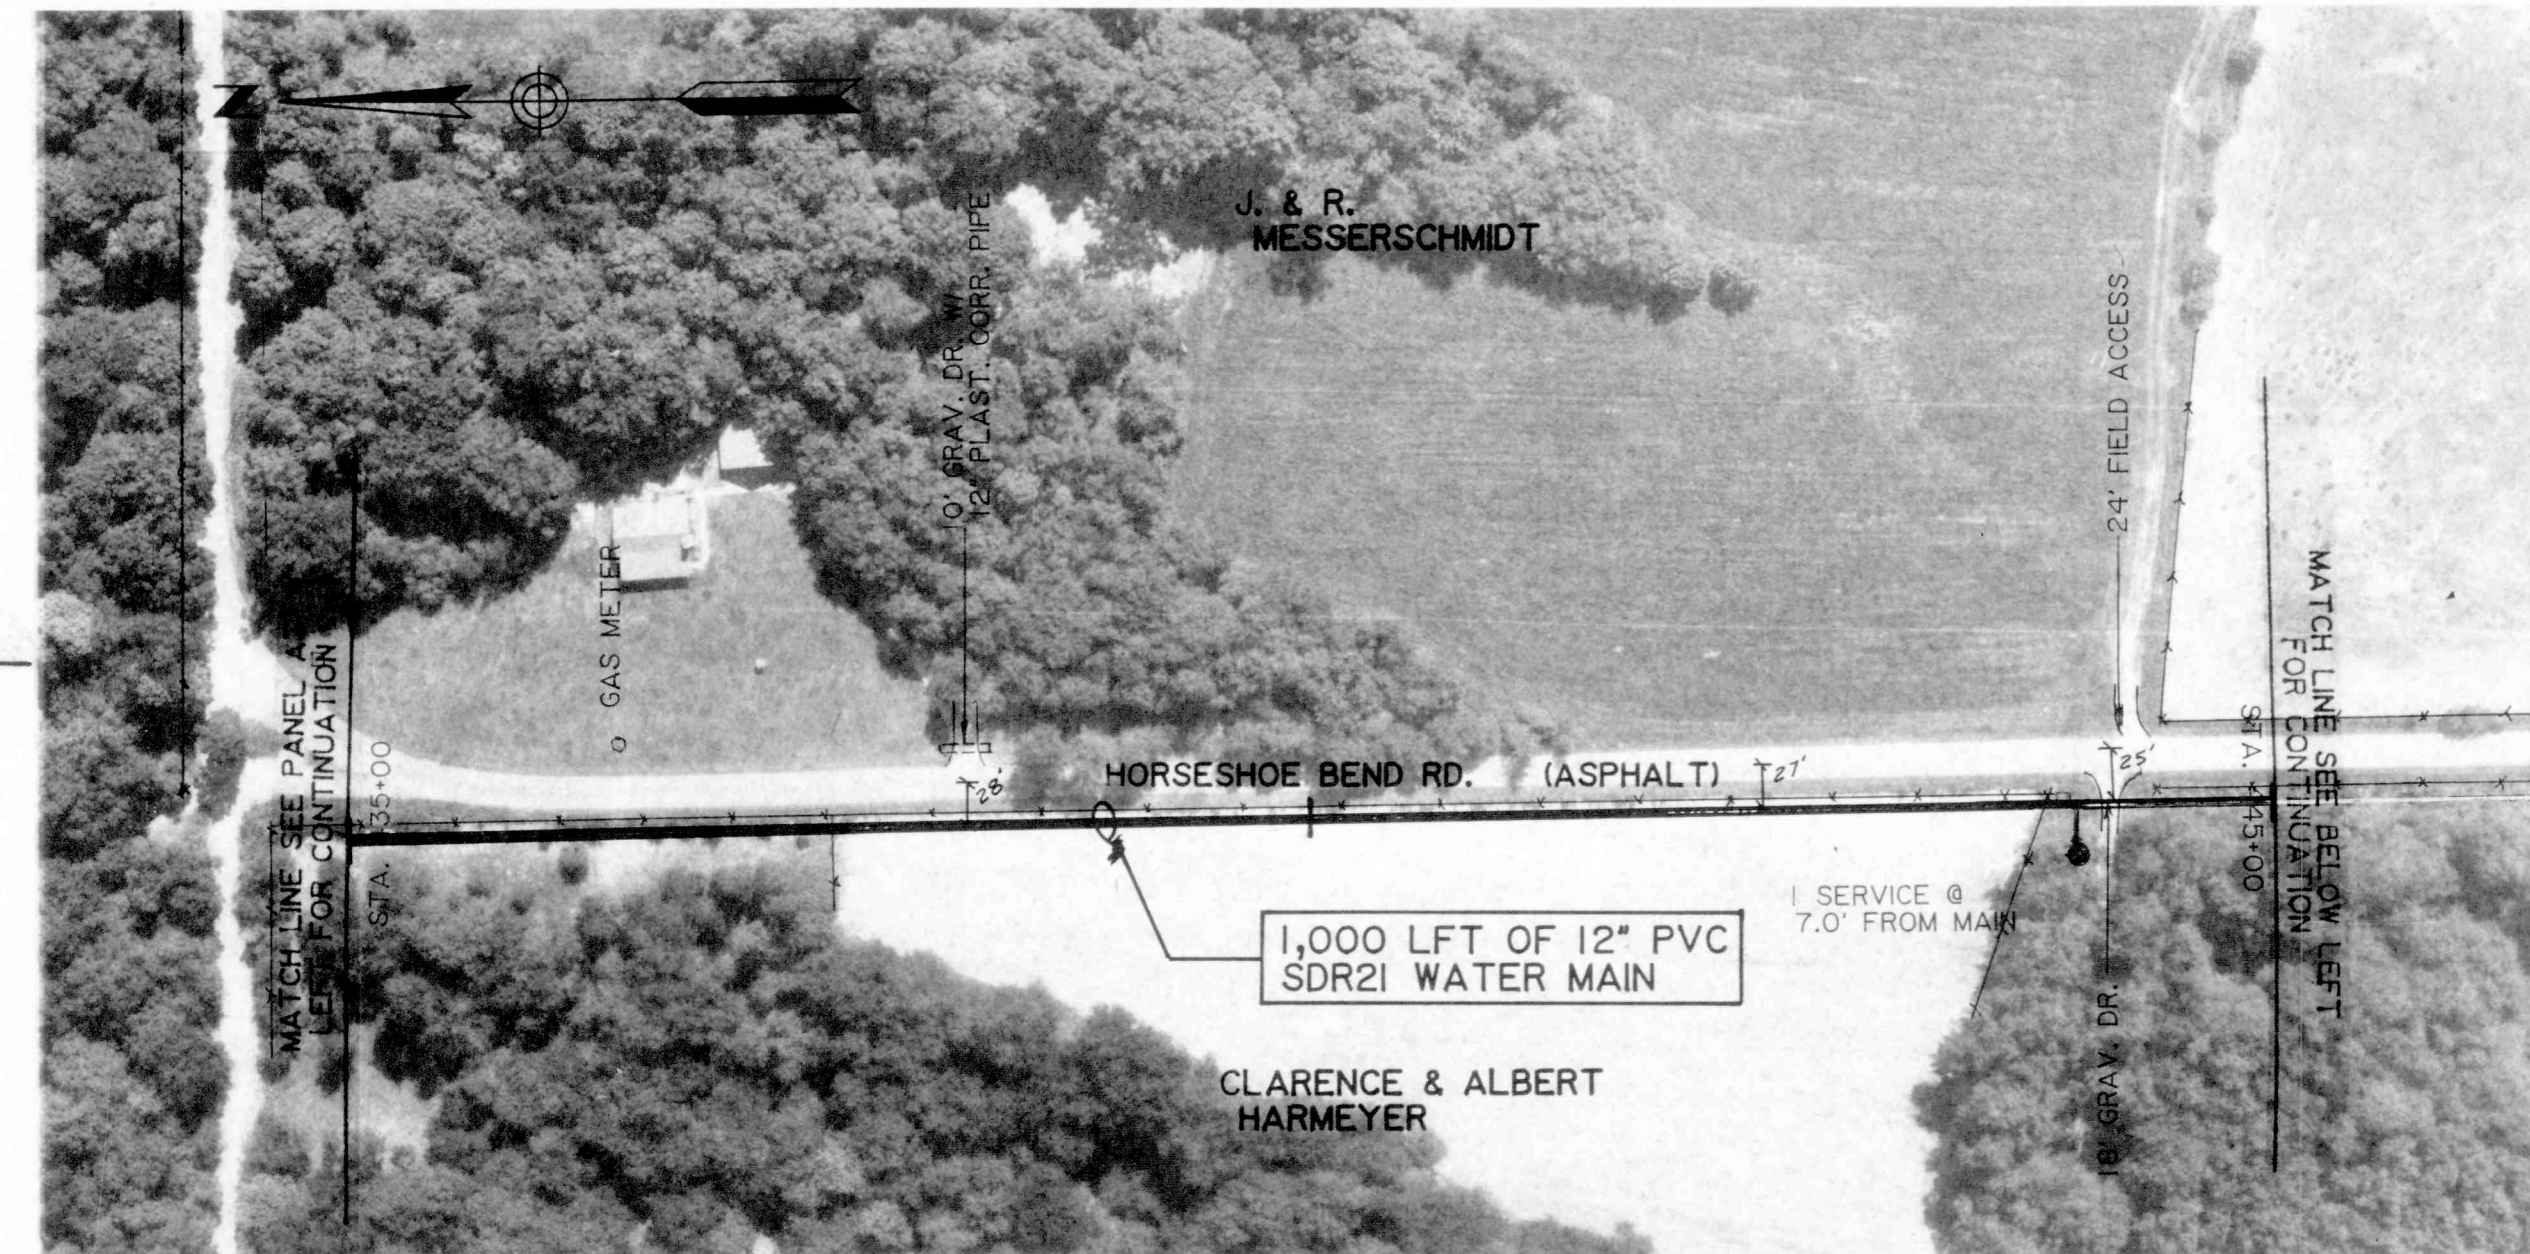

GROUND ELEV. = 975.0 ±
MAX. STATIC PRESS. = 80.1 PSI ±

LINE A HORSESHOE BEND RD.


GROUND ELEV. = 980.0 ±
MAX. STATIC PRESS. = 77.9 PSI ±

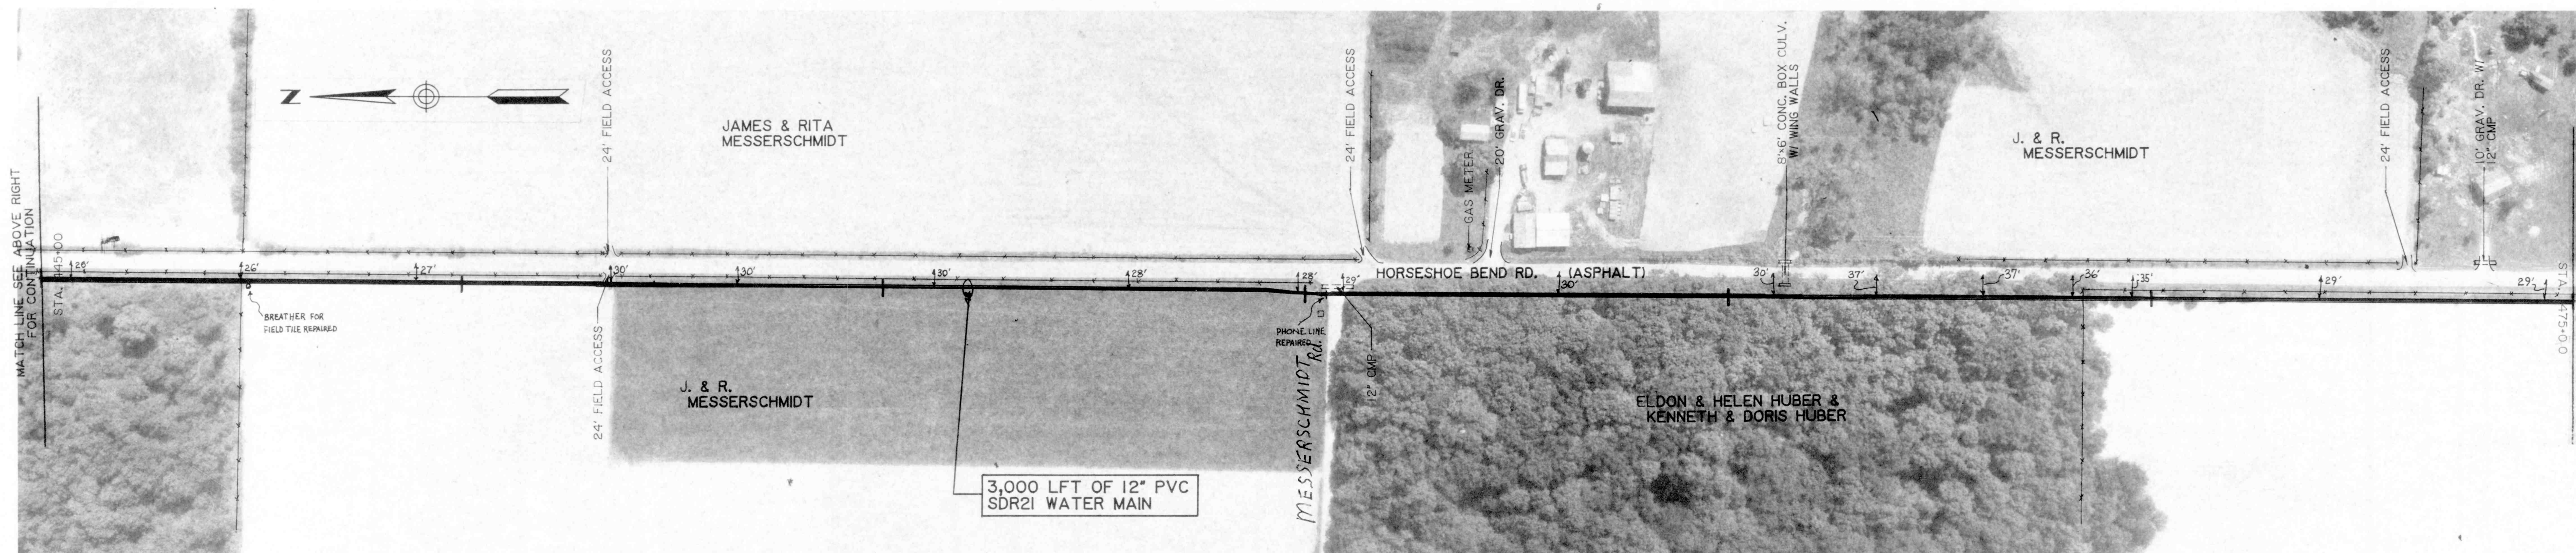

GROUND ELEV. = 980.0 ±
MAX. STATIC PRESS. = 77.9 PSI ±

LINE A HORSESHOE BEND RD.

GROUND ELEV. = 980.0 ±
MAX. STATIC PRESS. = 77.9 PSI ±

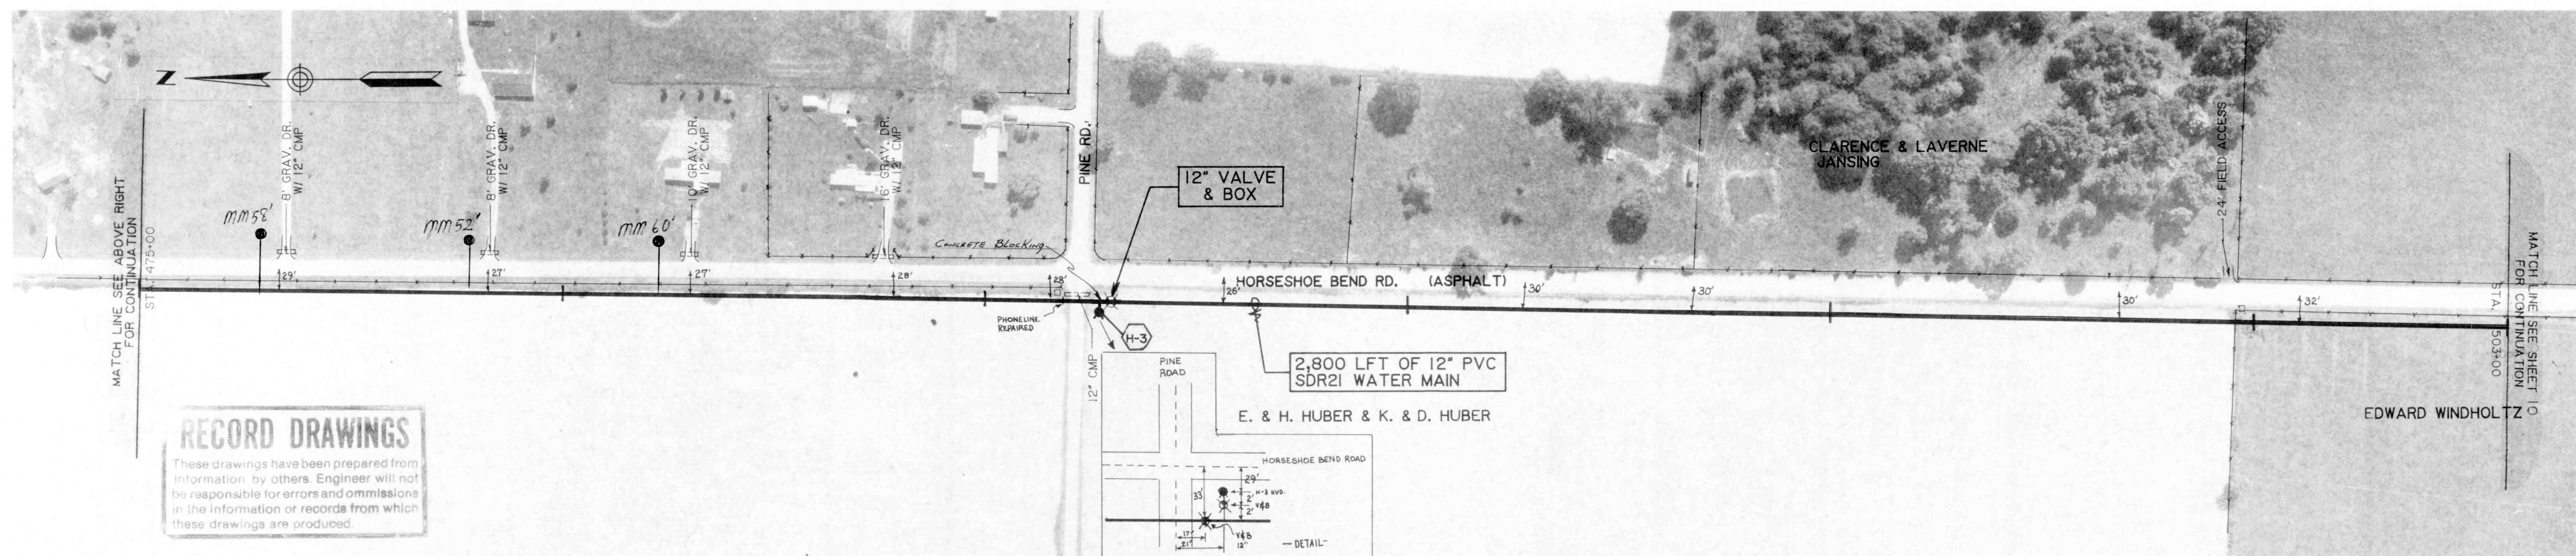

GROUND ELEV. = 980.0 ±
MAX. STATIC PRESS. = 77.9 PSI ±

LINE A HORSESHOE BEND RD.

GROUND ELEV. = 980.0 ±
MAX. STATIC PRESS. = 77.9 PSI ±

RECORD DRAWINGS
These drawings have been prepared from information by others. Engineer will not be responsible for errors and omissions in the information or records from which these drawings are produced.

CONTRACT "A"
WATER MAINS
LINE "A"
ELROD WATER COMPANY, INC.
DIVISION "E"
WATERWORKS SYSTEM IMPROVEMENTS

M.D. WESSLER and ASSOCIATES
CONSULTING ENGINEERS
6219 South East Street, Suite A
Indianapolis, Indiana 46227-2148

SCALE: 1" = 100'
DATE: OCT. 14, 1993
PROJECT NO.: 37391.04
DRAWN BY: CLG
APPROVED BY: DGC

NOT PUBLISHED
ALL RIGHTS RESERVED
EXCEPT FOR USES EXPRESSLY PERMITTED IN WRITING, INFORMATION SHOWN OR INCLUDED IN THIS DOCUMENT IS SOLELY THE PROPERTY OF M.D. WESSLER & ASSOCIATES, INC.

STATE OF INDIANA
PROFESSIONAL ENGINEER
NO. 13334
EDWARD WINDHOLTZ

SHEET A9

OF 45