

ELROD WATER COMPANY, INC.
MILAN, INDIANA

DIVISION "E"
WATERWORKS SYSTEM IMPROVEMENTS
CONTRACT "B"
WELLS AND TREATMENT FACILITIES

PLAN SHEET INDEX

SHEET DESCRIPTION	SHEET NO.
TITLE SHEET	1
LOCATION PLAN	2
WELLFIELD SITE PLAN	3
WELL TOWER AND PIT DETAILS	4
WELLFIELD ELECTRICAL SITE PLAN AND DETAILS	5
TANK SITE ELECTRICAL PLANS AND DETAILS	6
TREATMENT PLANT SITE PLAN	7
ACCESS ROAD PLAN AND PROFILE	8
BACKWASH LAGOON/AEROLATER DETAILS	9
FOUNDATION PLAN AND DETAILS	10
FLOOR PLAN AND SECTIONS	11
ROOF FRAMING PLAN AND SECTIONS	12
ELEVATIONS	13
HVAC AND PLUMBING PLANS	14
TREATMENT PLANT ELECTRICAL SITE PLAN AND DETAILS	15
ELECTRICAL FLOOR PLAN AND DETAILS	16
ELECTRICAL SCHEMATICS & DETAILS	17
SCHEDULES & DETAILS	18
DETAILS	19
WELL TOWER AND PIT DETAILS "RECORD DRAWINGS"	20
ELECTRICAL SCHEMATICS & LAYOUT "RECORD DRAWINGS"	21

BOARD OF DIRECTORS

JOYCE HUFFMAN, PRESIDENT
HENRY WESTERMAN, TREASURER
ALREENA NICKULIS, SECRETARY
ED ALLGEIER, MEMBER
MARY ENGEL, OFFICE MANAGER
NELSON ELLIOT, MEMBER
ROBERT HUMMEL, MEMBER
JEFFERY LAUB, MEMBER
FRANK MARTIN, MEMBER
DANIEL SCHMALTZ, MEMBER
JEFF MEINDERS, SUPERINTENDENT

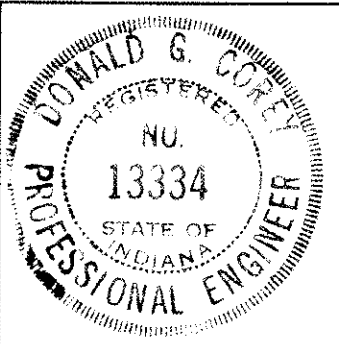
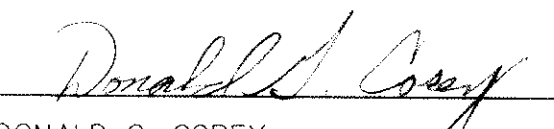
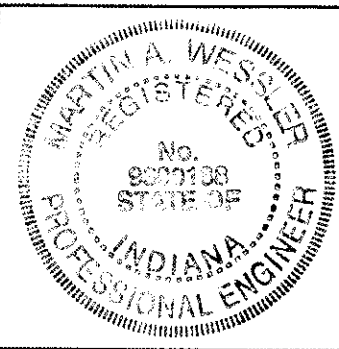

M.D. WESSLER and
ASSOCIATES
CONSULTING ENGINEERS

6219 South East Street, Suite A
Indianapolis, Indiana 46227-2148

OCTOBER 14, 1993
REVISED JANUARY 19, 1994

RECORD DRAWINGS
THESE DRAWINGS HAVE BEEN PREPARED FROM
INFORMATION BY OTHERS. ENGINEER WILL NOT
BE RESPONSIBLE FOR ERRORS AND OMISSIONS
IN THE INFORMATION OR RECORDS FROM WHICH
THESE DRAWINGS ARE PRODUCED.

CERTIFIED BY:

	 DONALD G. COREY REGISTERED ENGINEER STATE OF INDIANA NO. 13334
	 MARTIN A. WESSLER REGISTERED ENGINEER STATE OF INDIANA NO. 9300188