



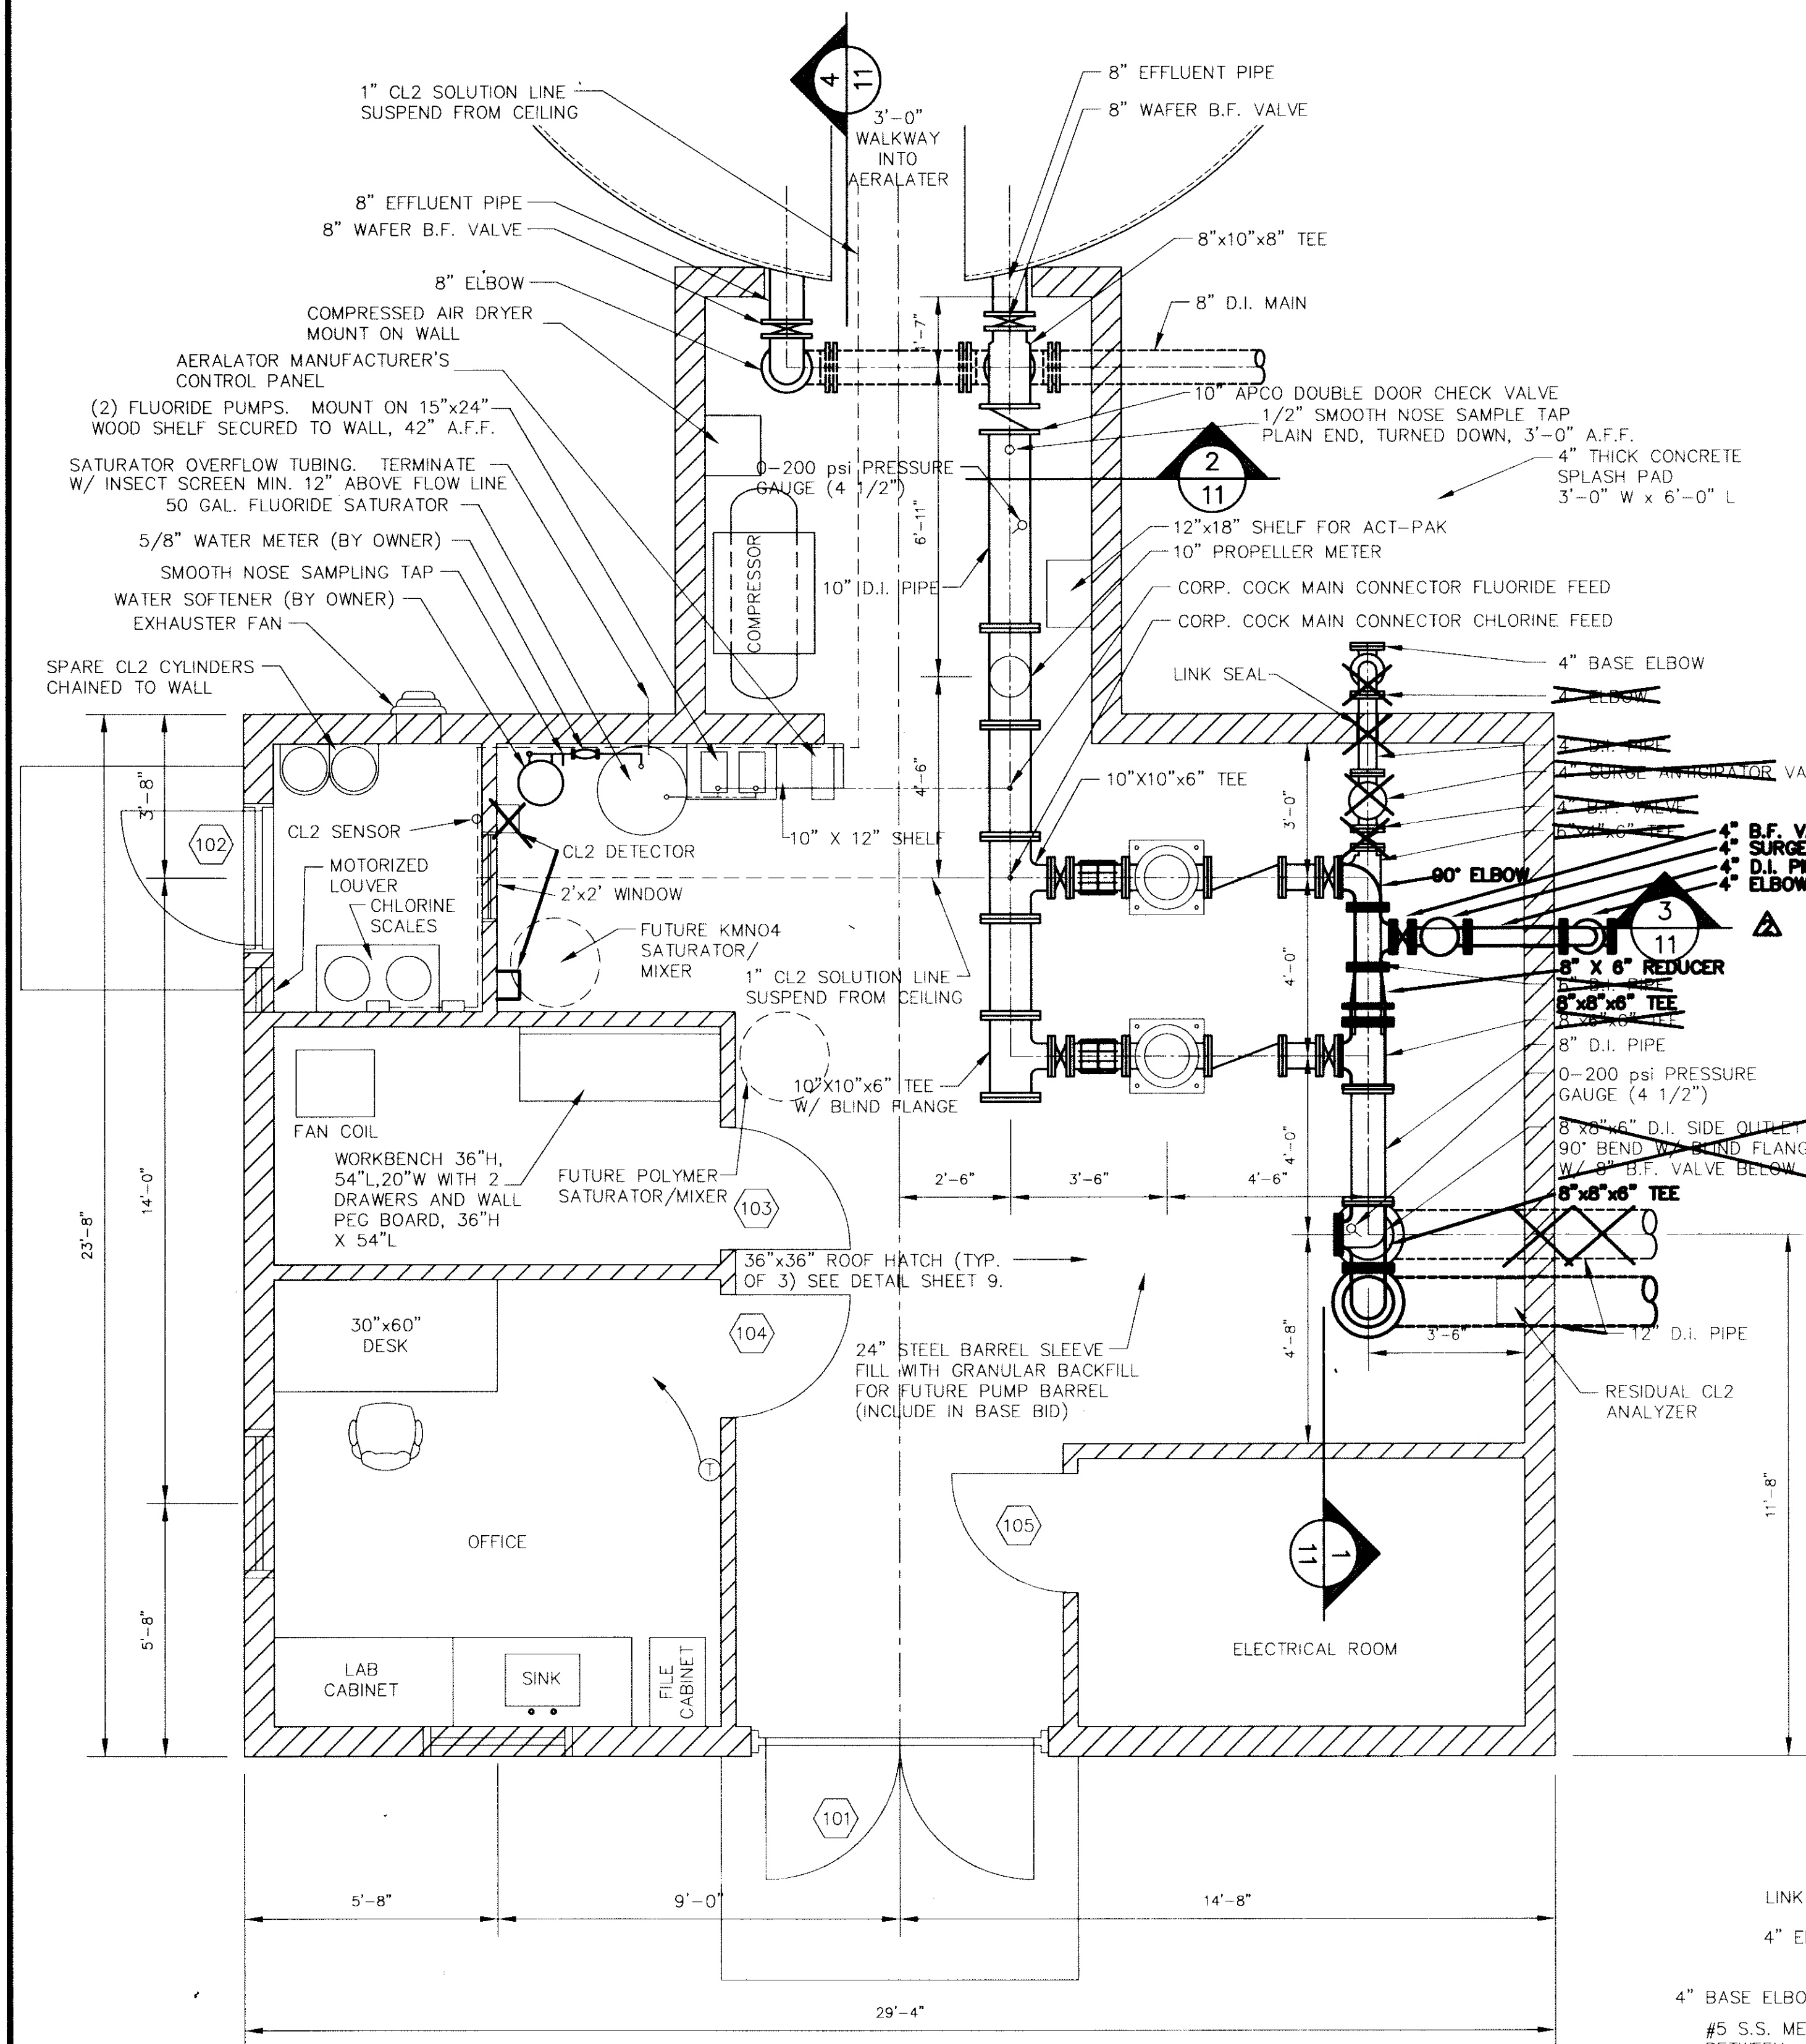


TREATMENT PLANT FLOOR PLAN
SCALE: 3/8" = 1'-0"


RECORD DRAWINGS
THESE DRAWINGS HAVE BEEN PREPARED FROM INFORMATION BY OTHERS. ENGINEER WILL NOT BE RESPONSIBLE FOR ERRORS AND OMISSIONS IN THE INFORMATION OR RECORDS FROM WHICH THESE DRAWINGS ARE PRODUCED.

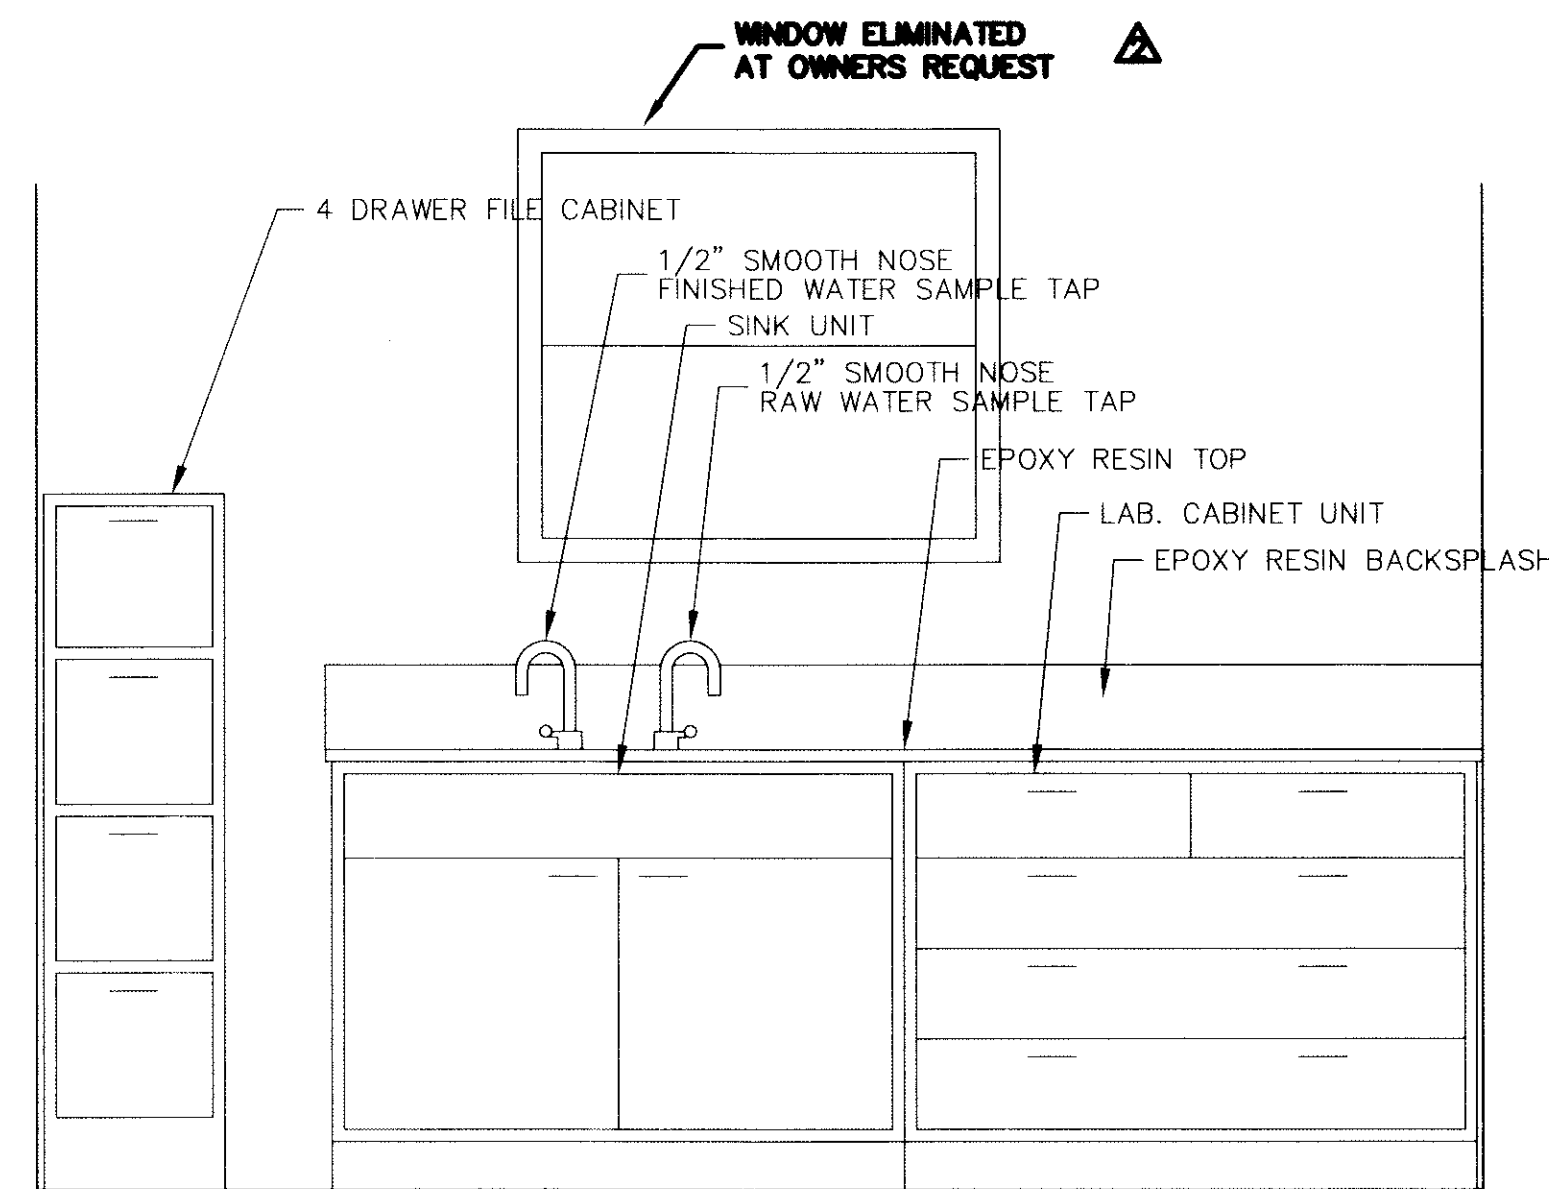

OFFICE SOUTH ELEVATION
SCALE: 3/4" = 1'-0"

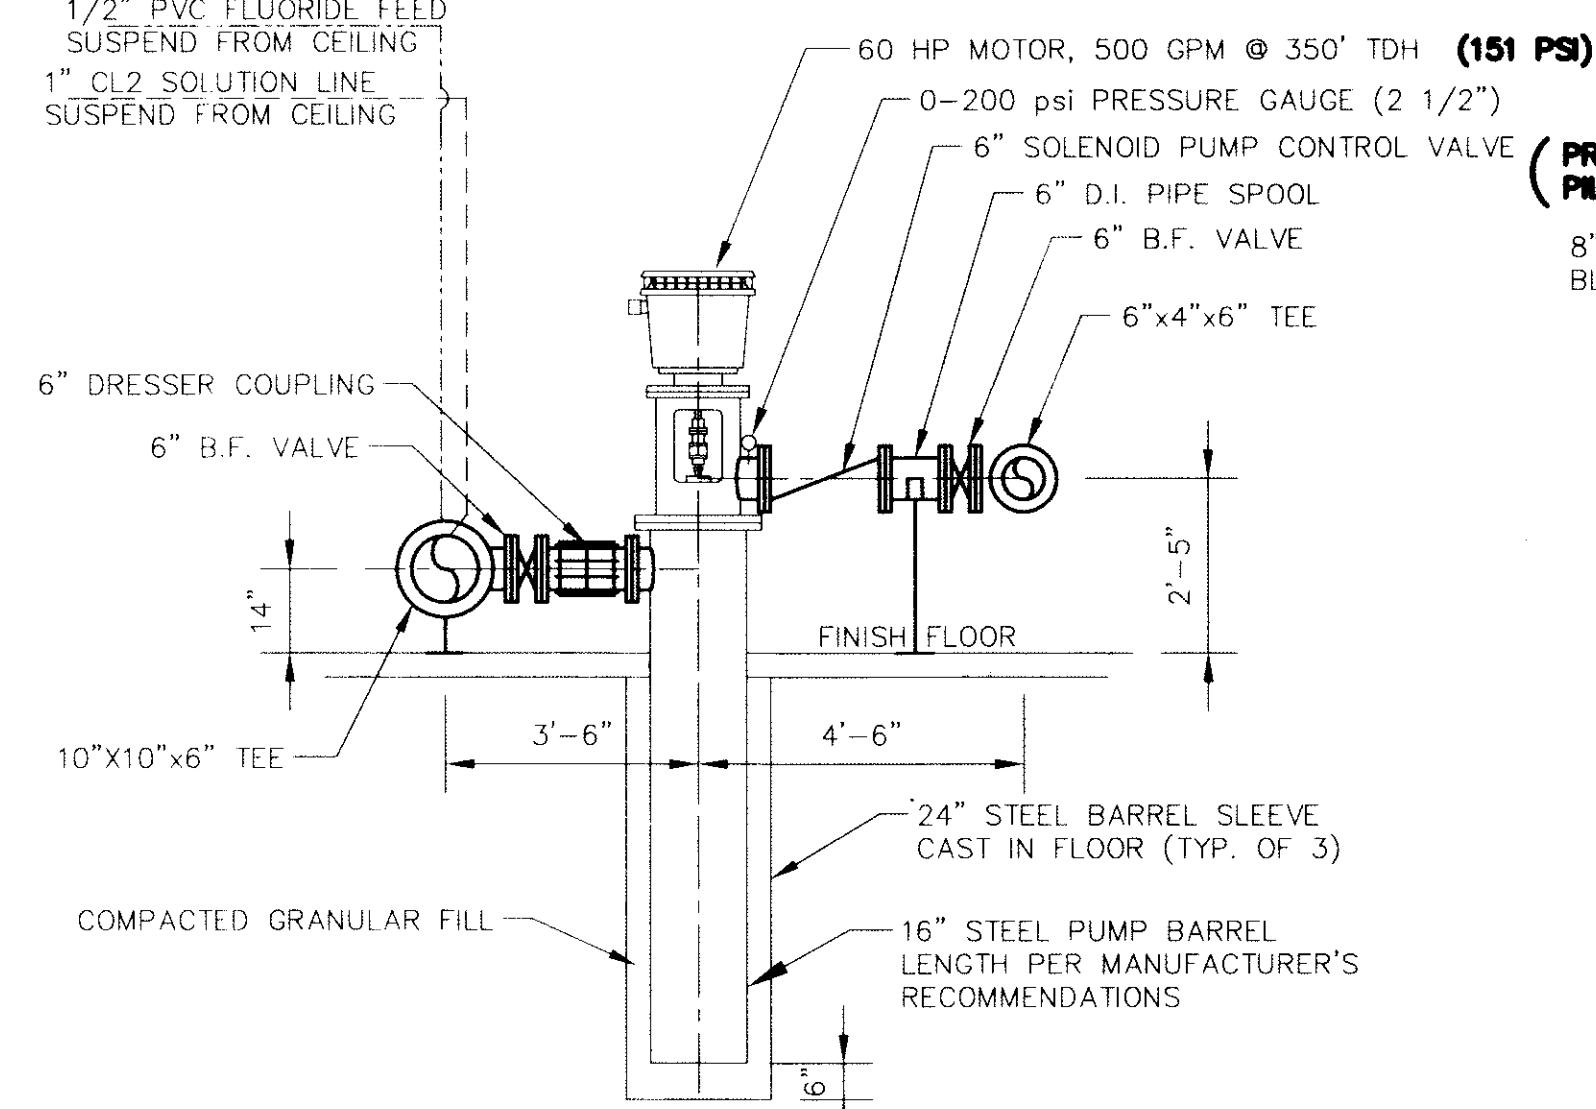


SECTION 3
SCALE: 3/8" = 1'-0"

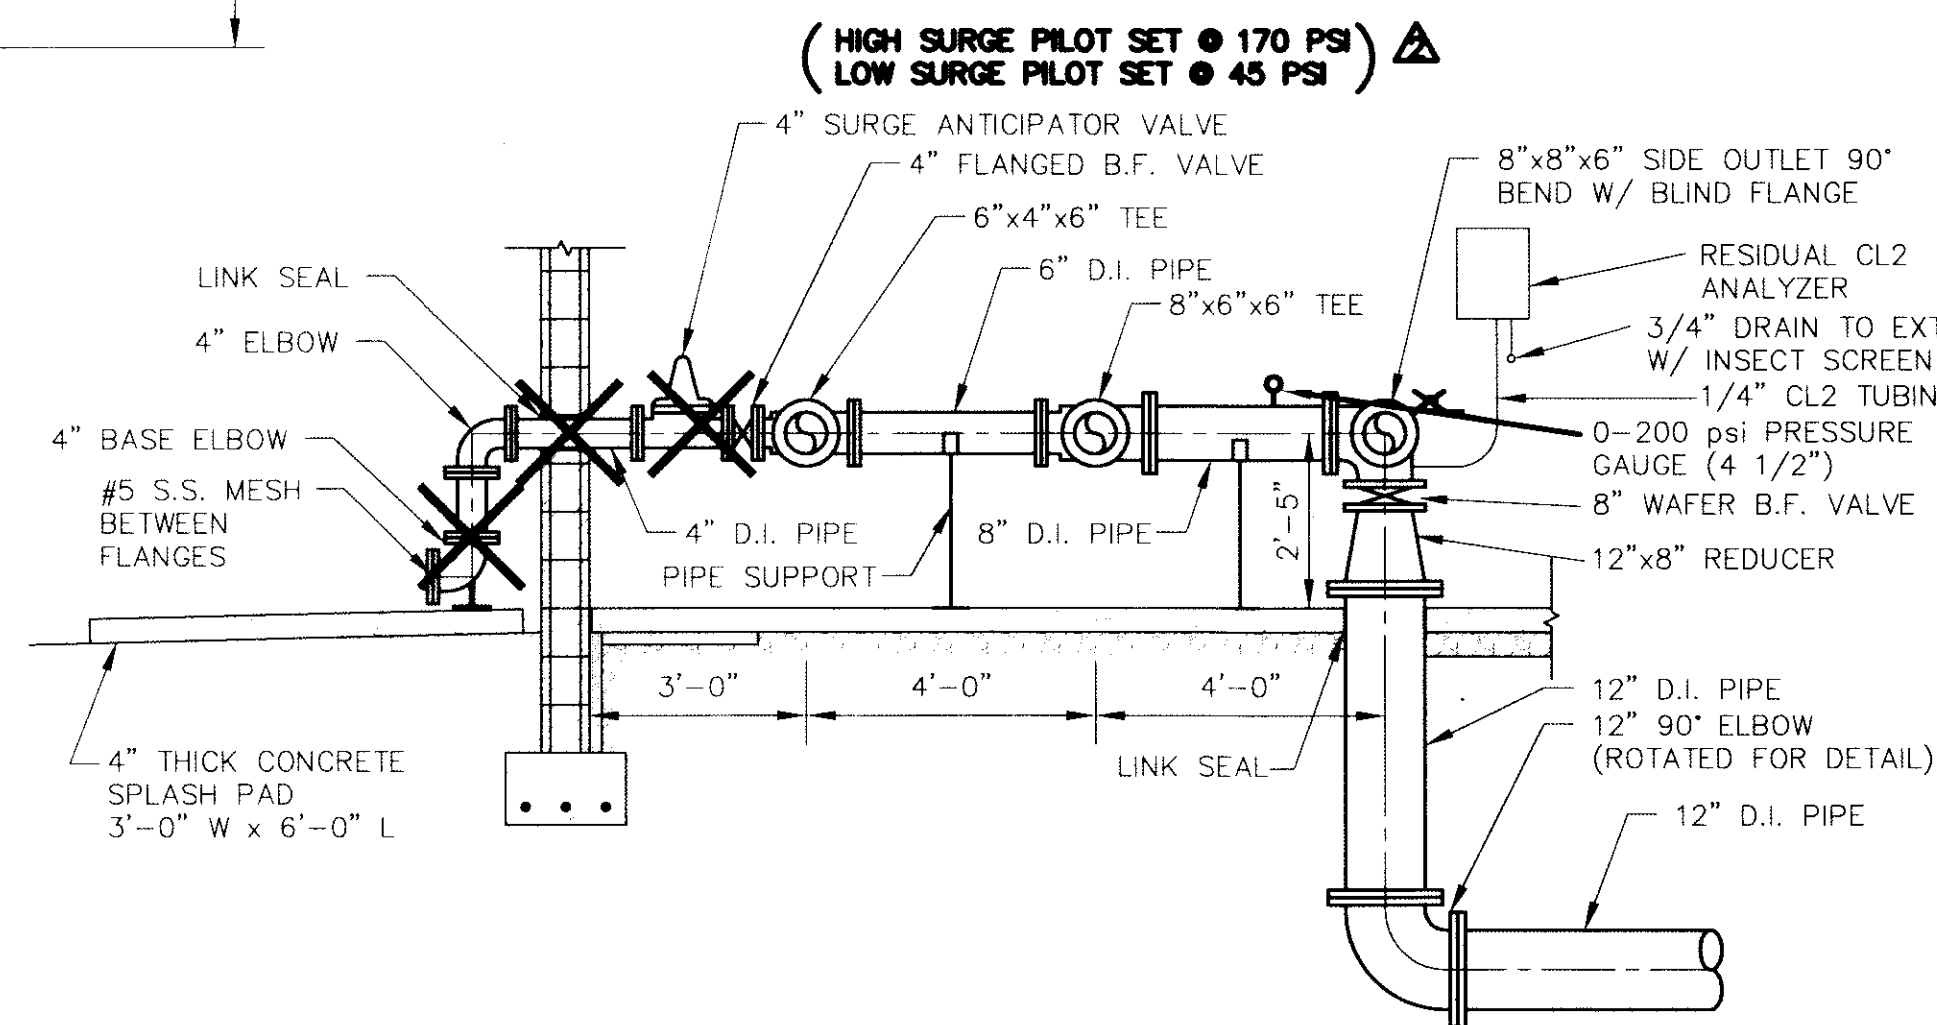


SECTION 1
SCALE: 3/8" = 1'-0"


- OFFICE NOTES:
1. SINK UNIT TO BE MODEL NO. 11BE47 AS MANUFACTURED BY TAYLOR/AMERICAN DESK CO., OR APPROVED EQUAL.
 2. CABINET UNIT TO BE MODEL NO. 101BE47 AS MANUFACTURED BY TAYLOR/AMERICAN DESK CO., OR APPROVED EQUAL.
 3. LABORATORY SINK TO BE MOLDED EPOXY RESIN WITH NO JOINTS OR SEAMS.
 4. LAB. TOP MATERIAL TO BE EPOXY RESIN, 1" THICK.
 5. LAB. CABINET FACE COLOR TO BE SELECTED BY OWNER UPON SUBMITTAL BY CONTRACTOR.
 6. 30"x60" DESK AND 4-DRAWER FILE CABINET TO BE MODELS NO. MDM4163 AND NO. HSF3142, AS MANUFACTURED BY HASKELL, OR APPROVED EQUAL. PROVIDE LOCKS AND KEYS FOR DESK AND FILE CABINET.
 7. REFER TO APPLICABLE SECTIONS OF THE SPECIFICATIONS.

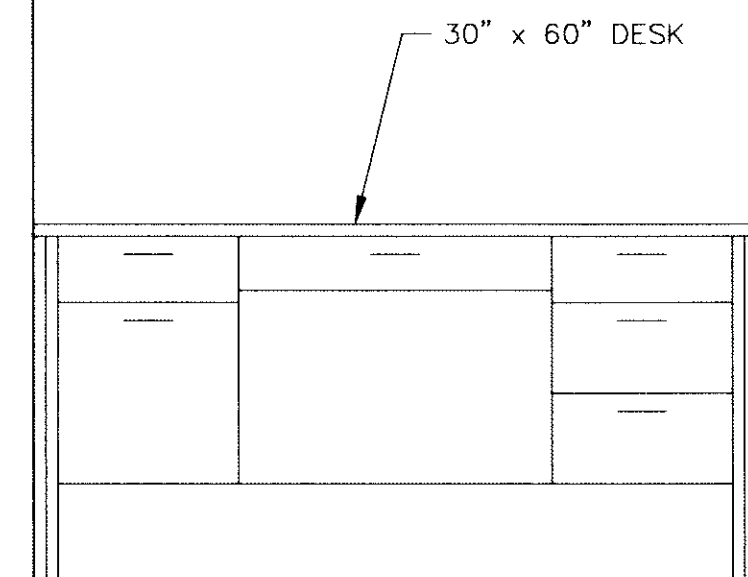

OFFICE NORTH ELEVATION
SCALE: 3/4" = 1'-0"

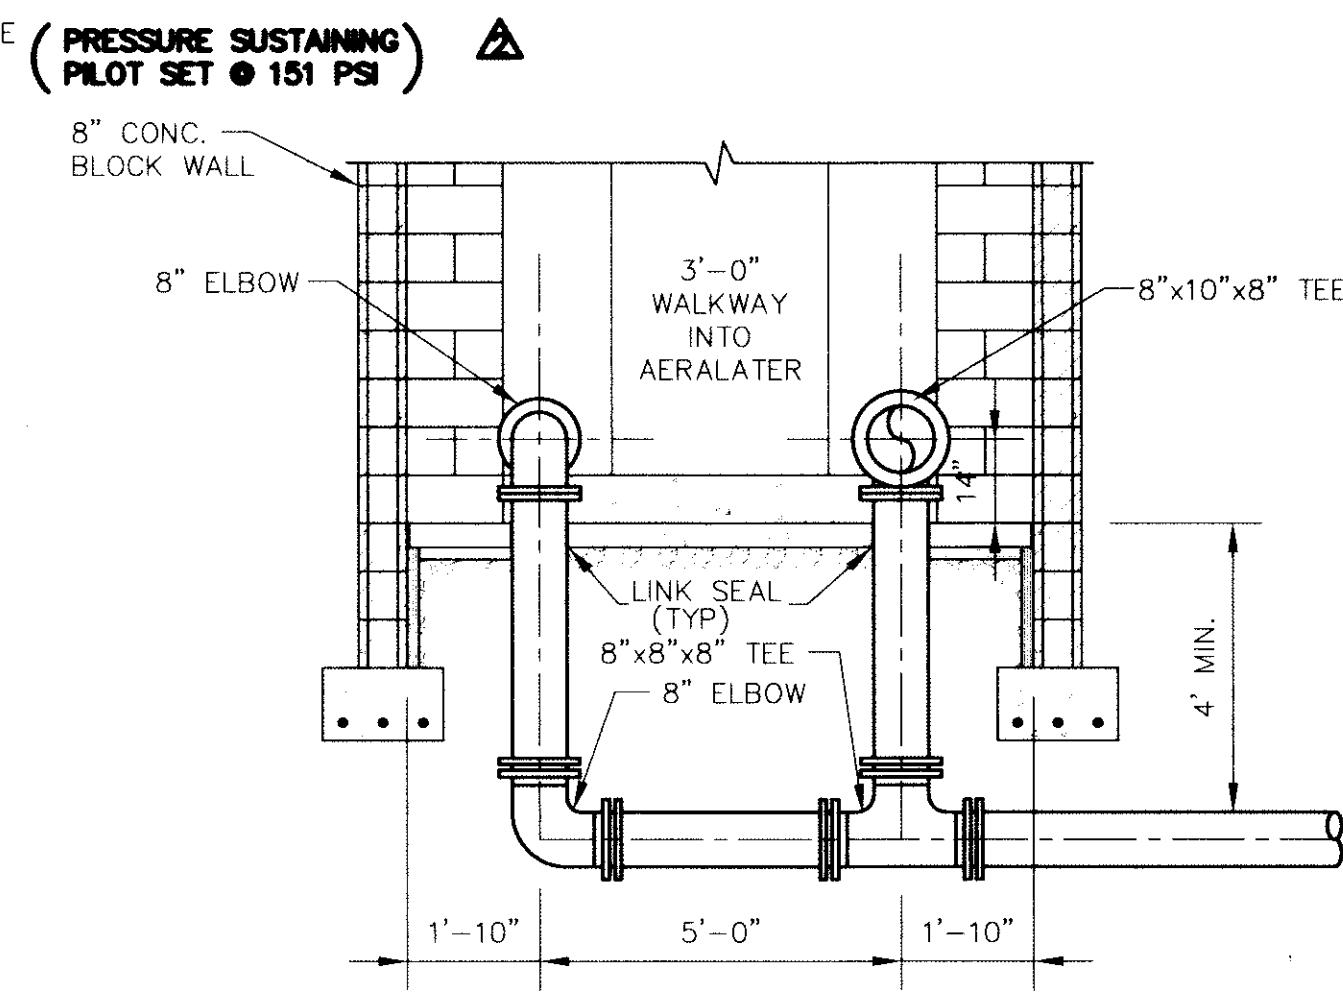

SECTION 2
SCALE: 3/8" = 1'-0"

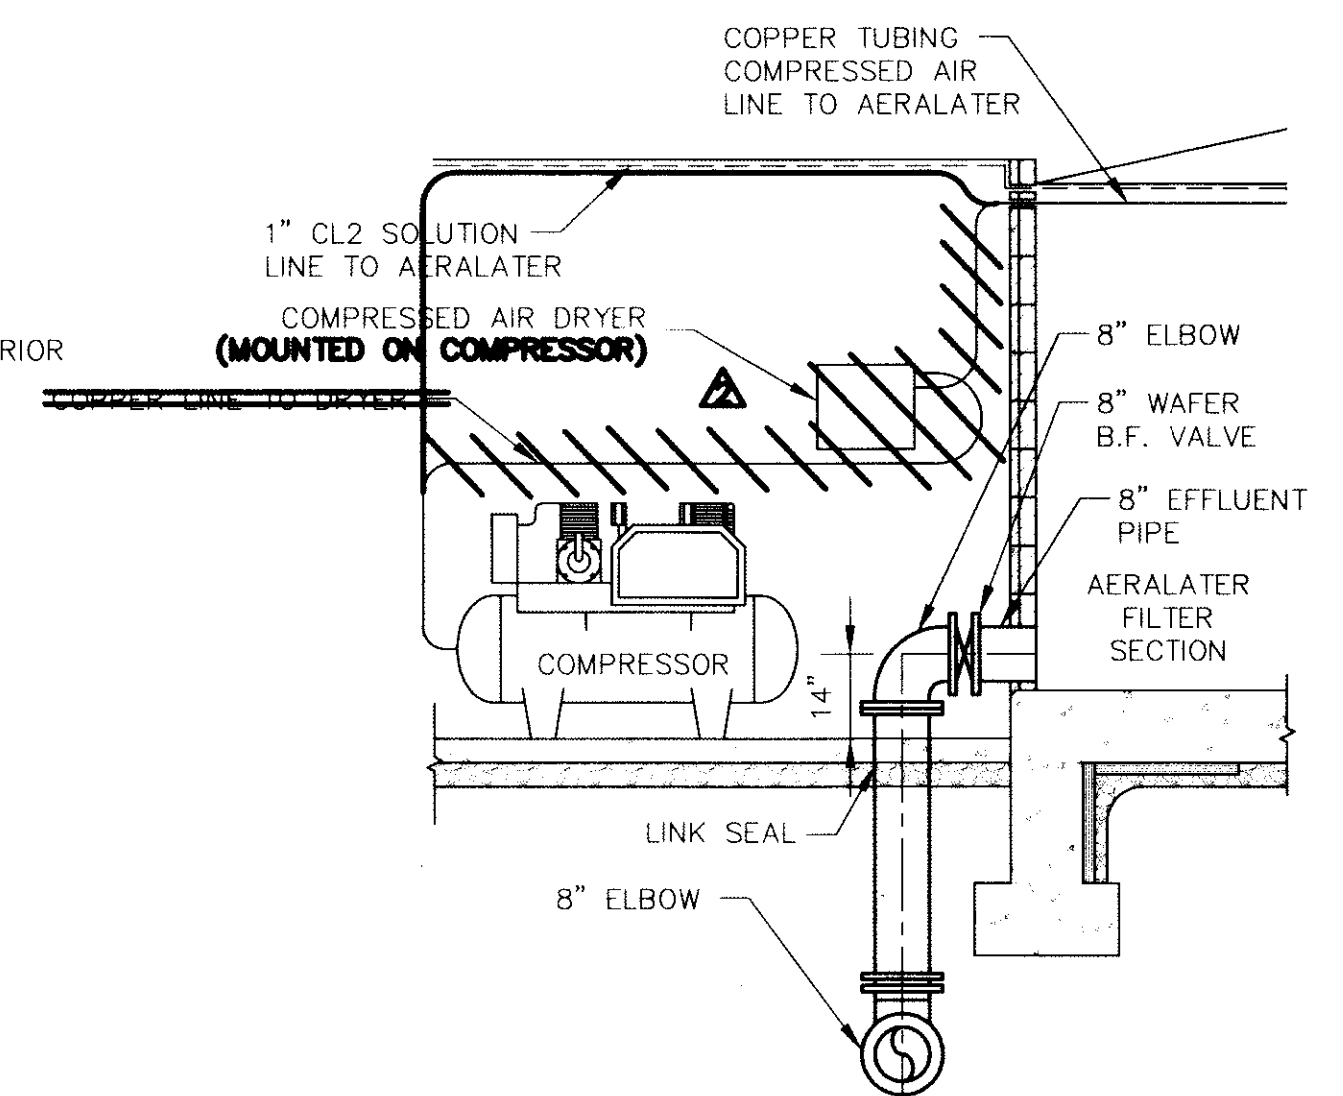

SECTION 4
SCALE: 3/8" = 1'-0"

SCALE: AS SHOWN DATE: OCT. 14, 1993 PROJECT NO.: 37391.04 DRAWN BY: M.A.W. APPROVED BY: D.G.C. PLOTTED: 4/12/94 CAD FILE: 373-B11.DWG	NOT PUBLISHED ALL RIGHTS RESERVED EXCEPT FOR USES EXPRESSLY PERMITTED IN WRITING, INFOR- MATION SHOWN OR INCLUDED IN THIS DOCUMENT IS SOLELY THE PROPERTY OF M.D. WESSLER & ASSOCIATES, INC.	M.D. WESSLER and ASSOCIATES CONSULTING ENGINEERS 6219 South East Street, Suite A Indianapolis, Indiana 46227-2148	CONTRACT "B"				
			WELLS AND TREATMENT FACILITIES				
			FLOOR PLAN AND SECTIONS				
			ELROD WATER COMPANY, INC.				
			DIVISION "E"				