



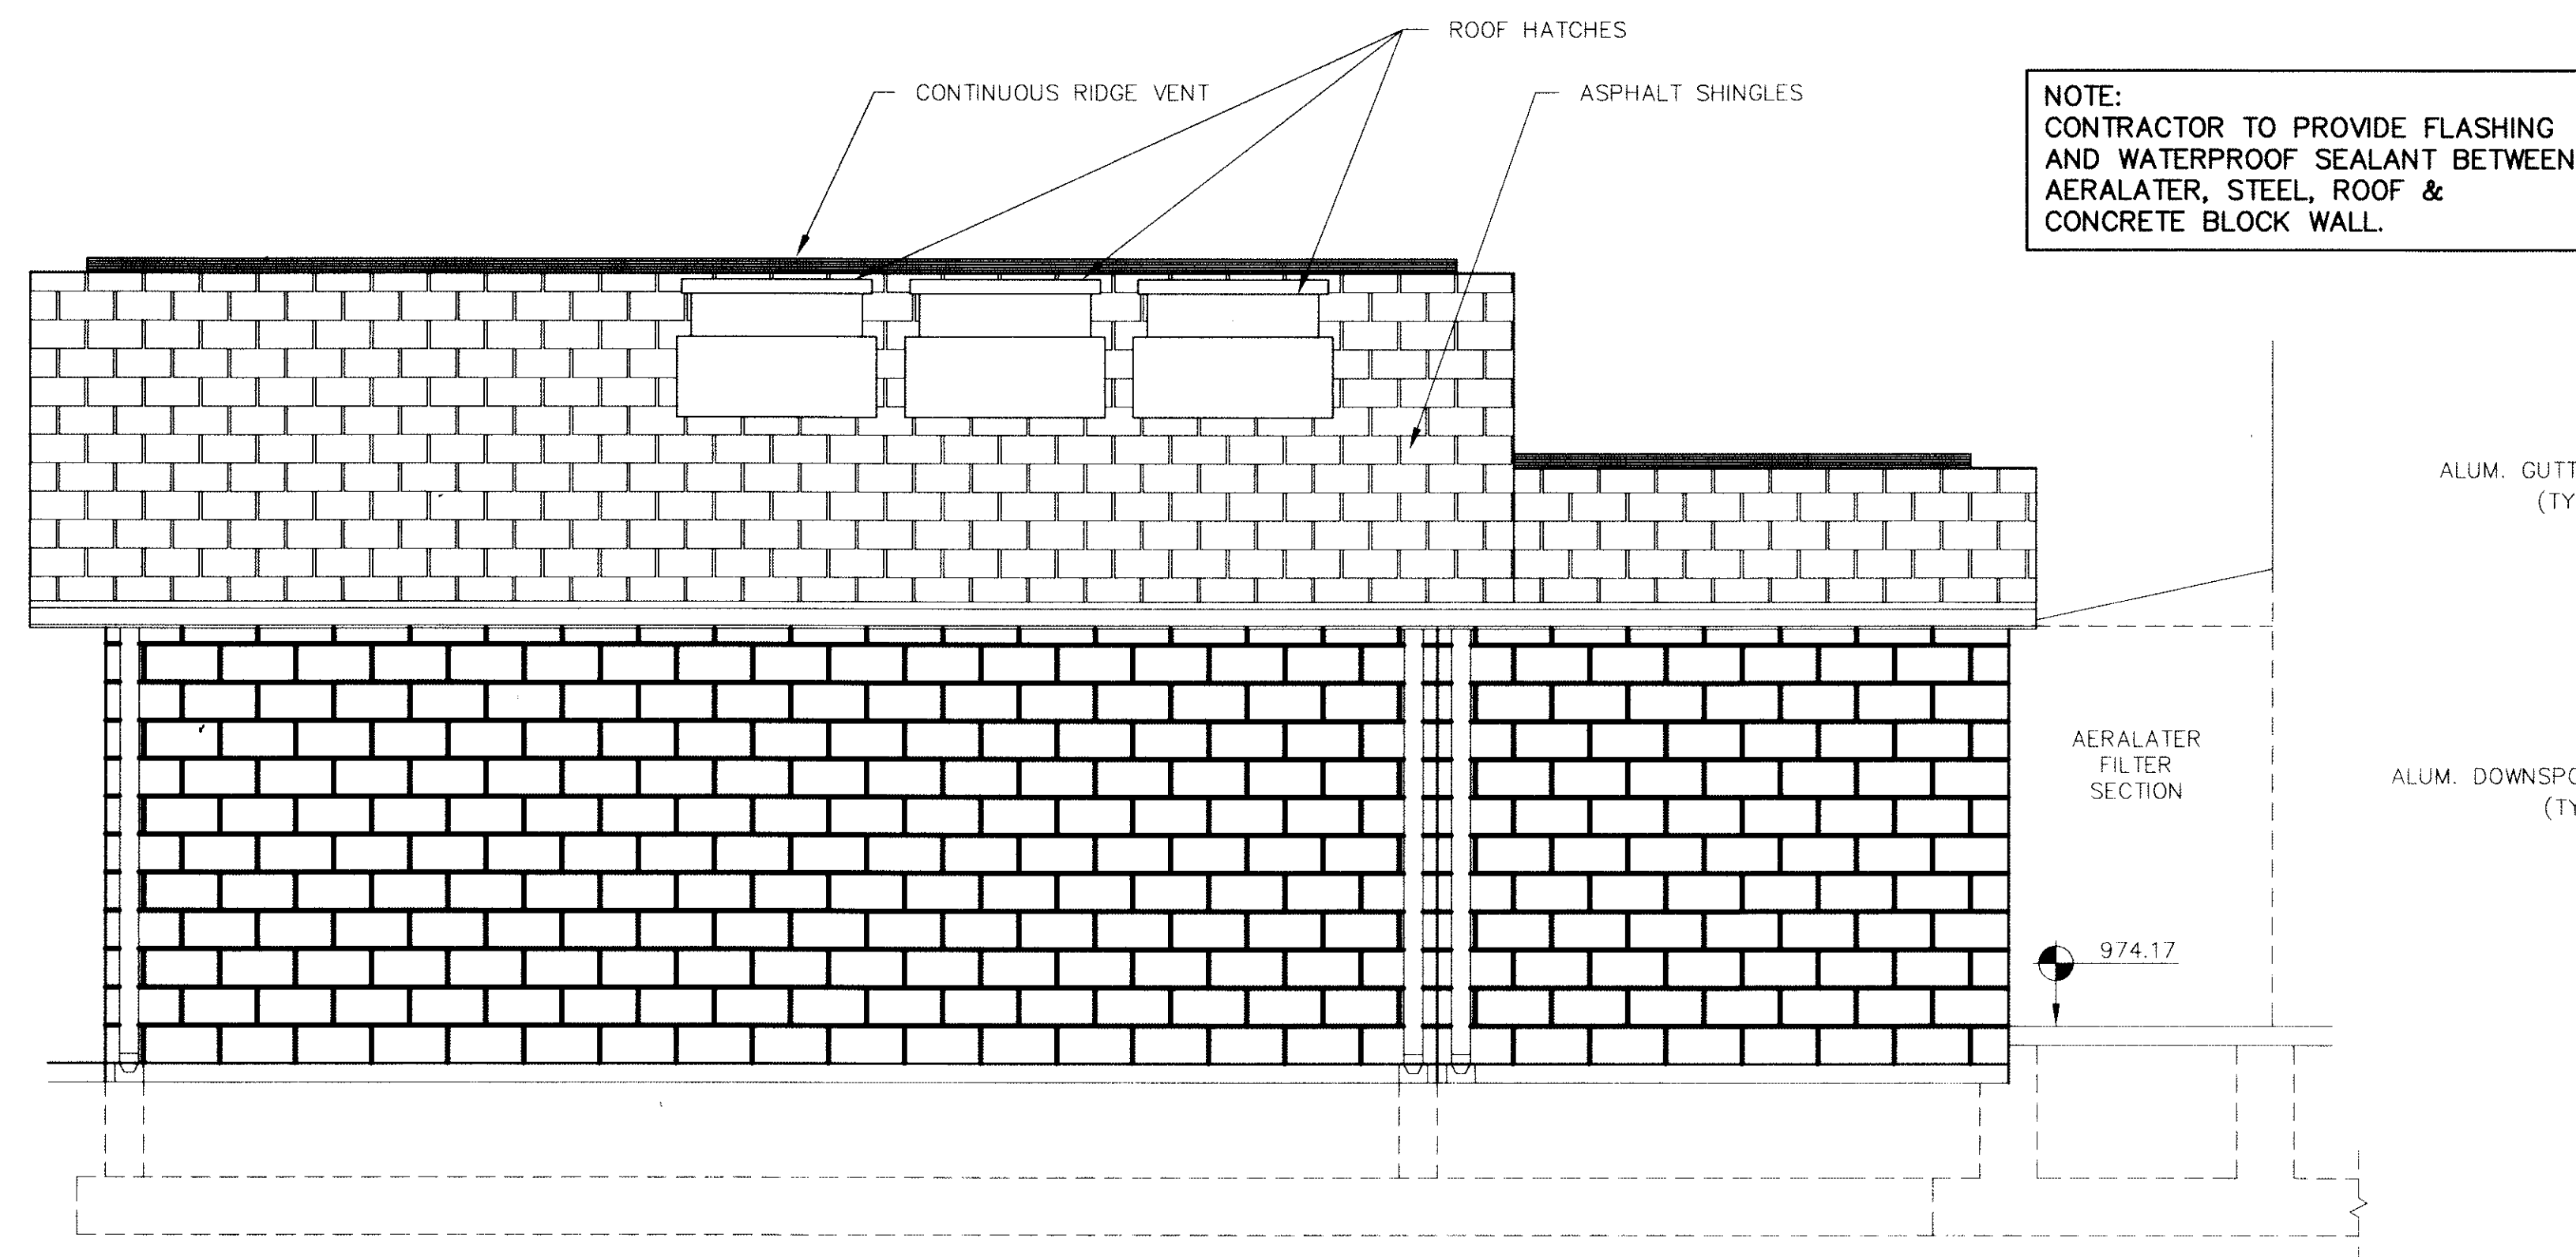


EAST ELEVATION
SCALE: 3/8" = 1'-0"

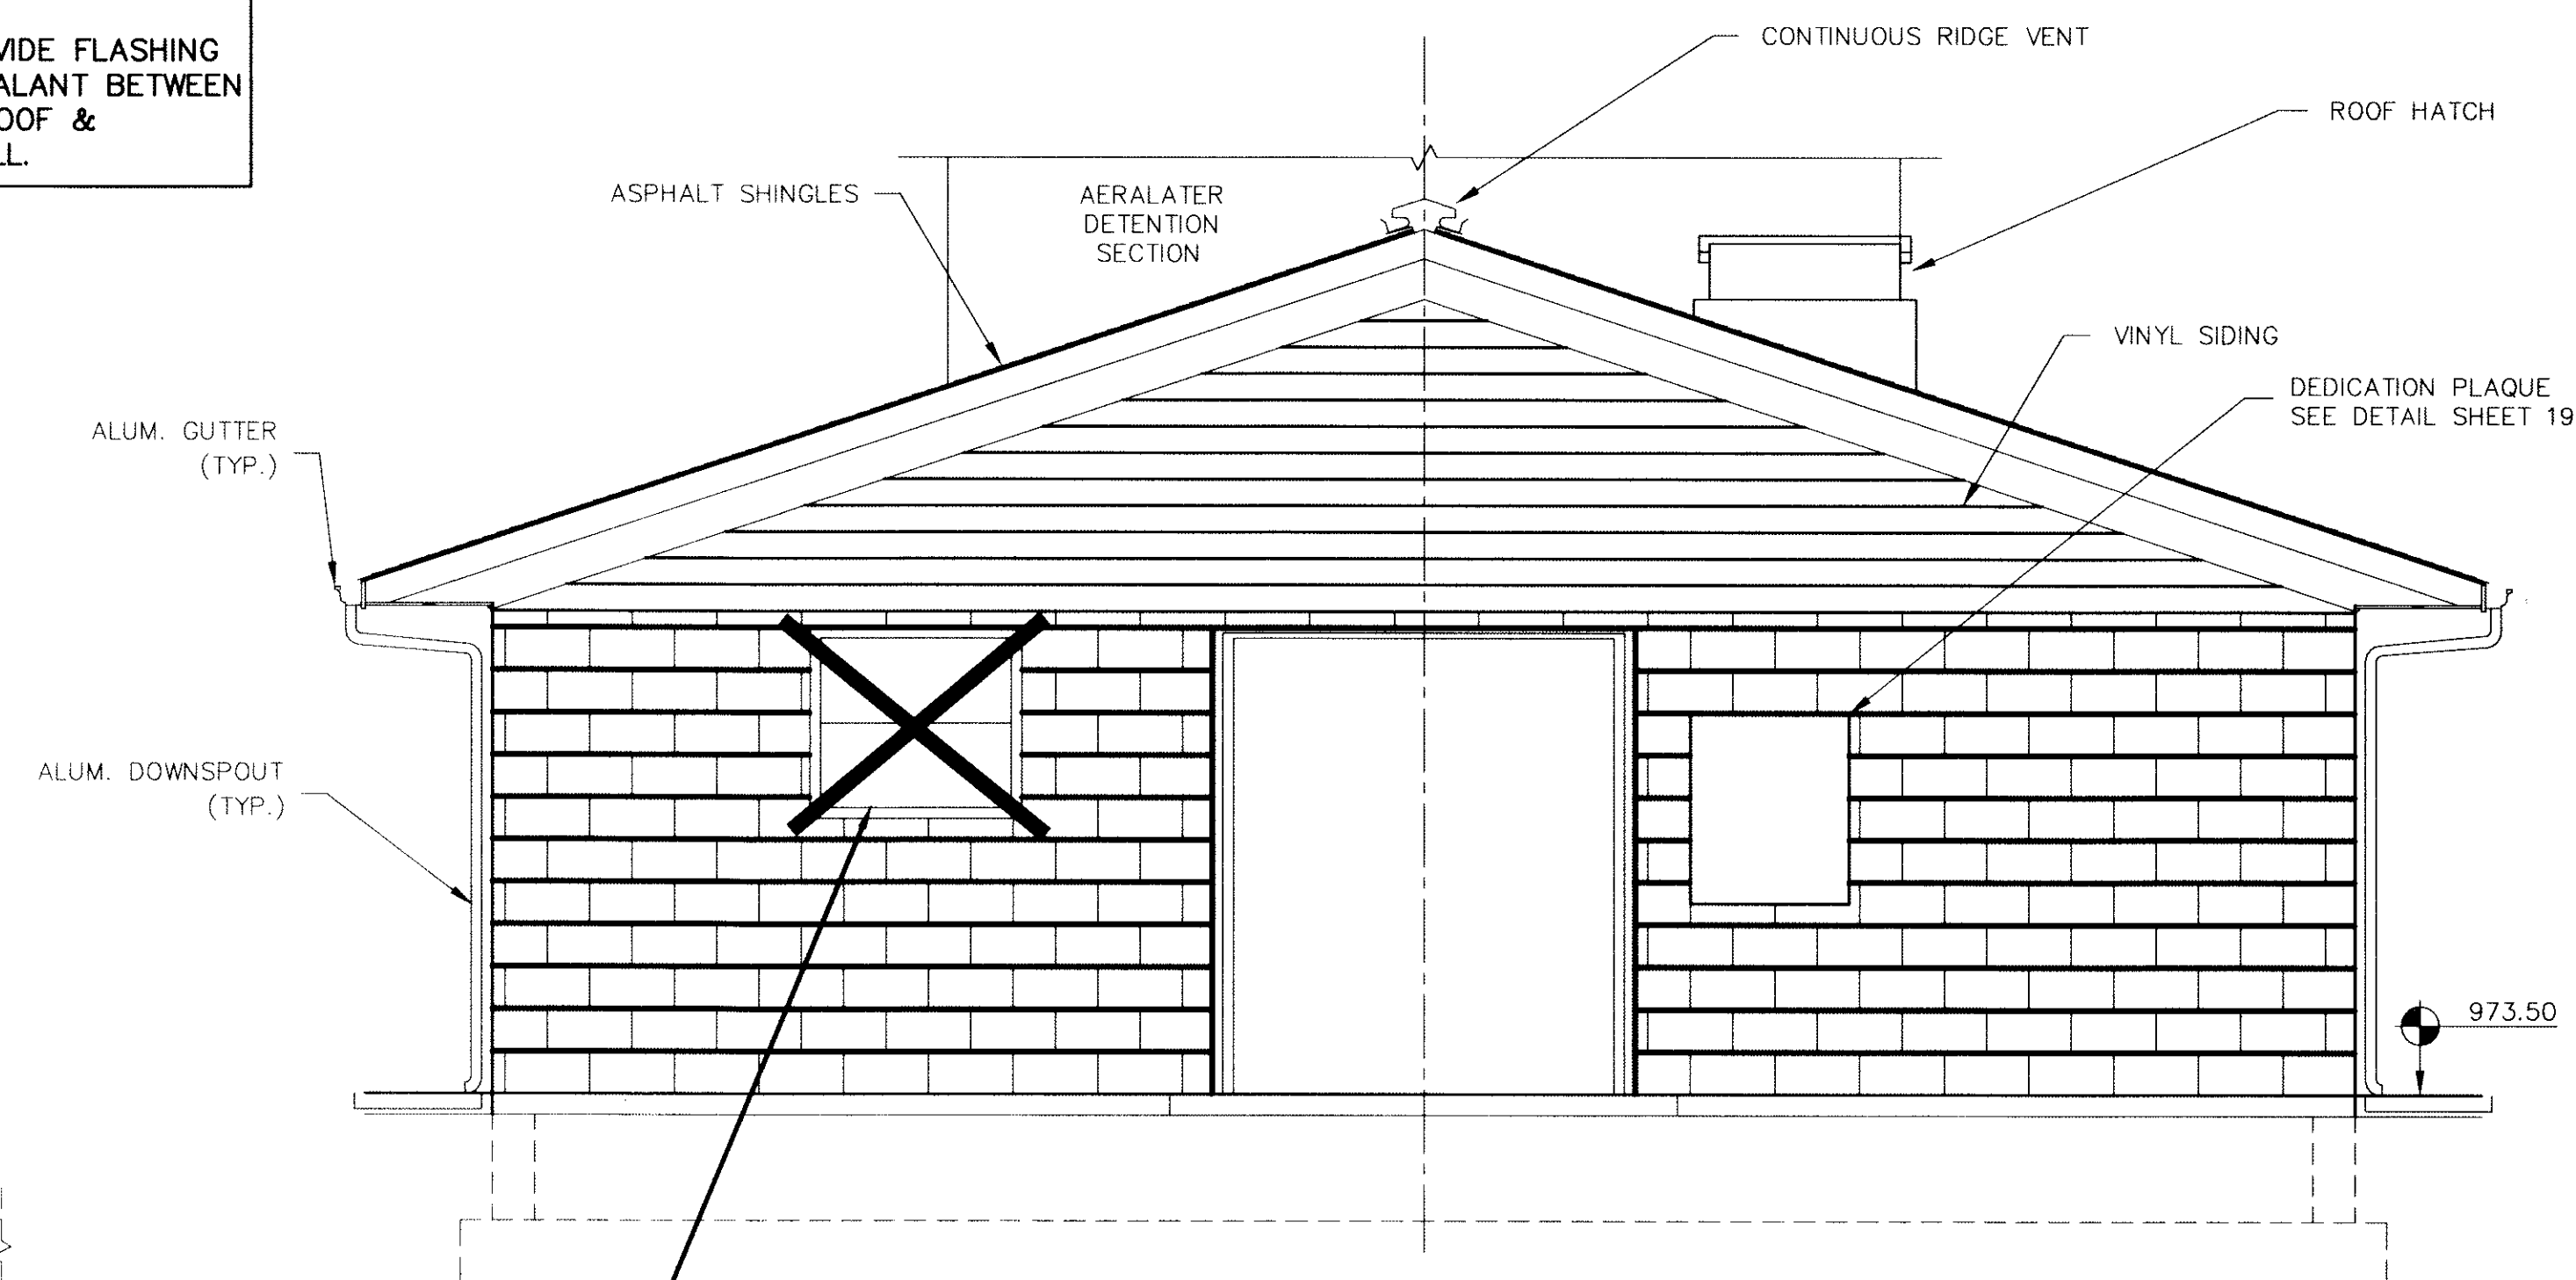


SOUTH ELEVATION
SCALE: $3/8" = 1'-0"$

WINDOWS DELETED PER
OWNERS REQUEST

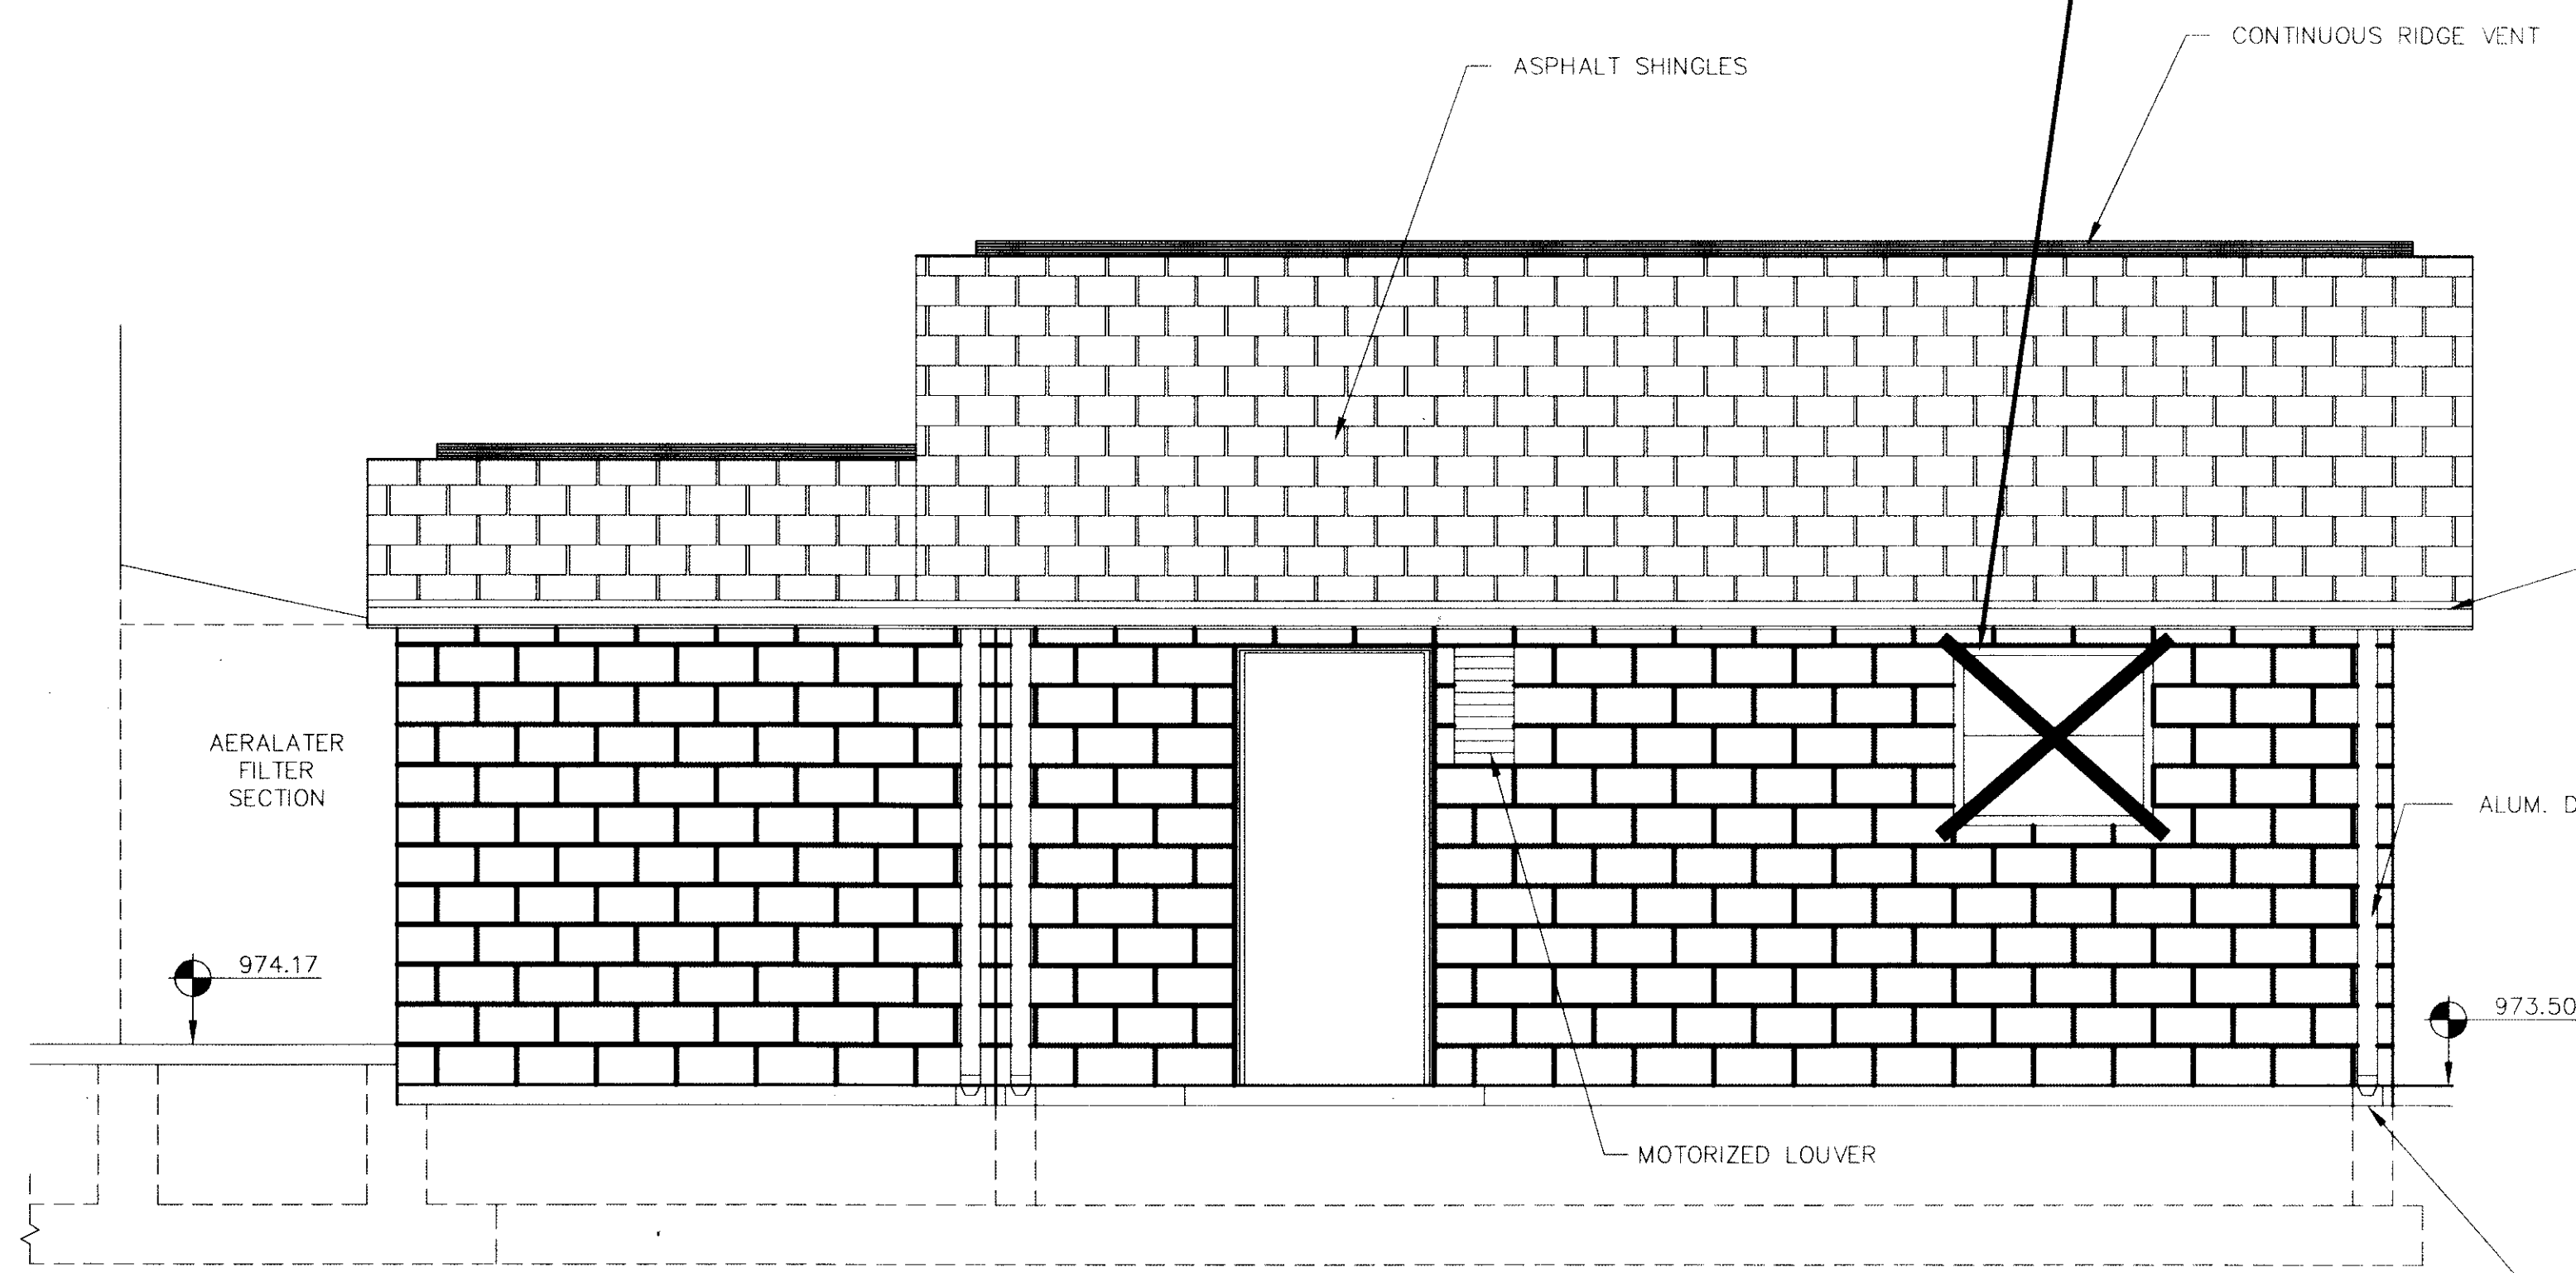

WEST ELEVATION
SCALE: 3/8" = 1'-0"

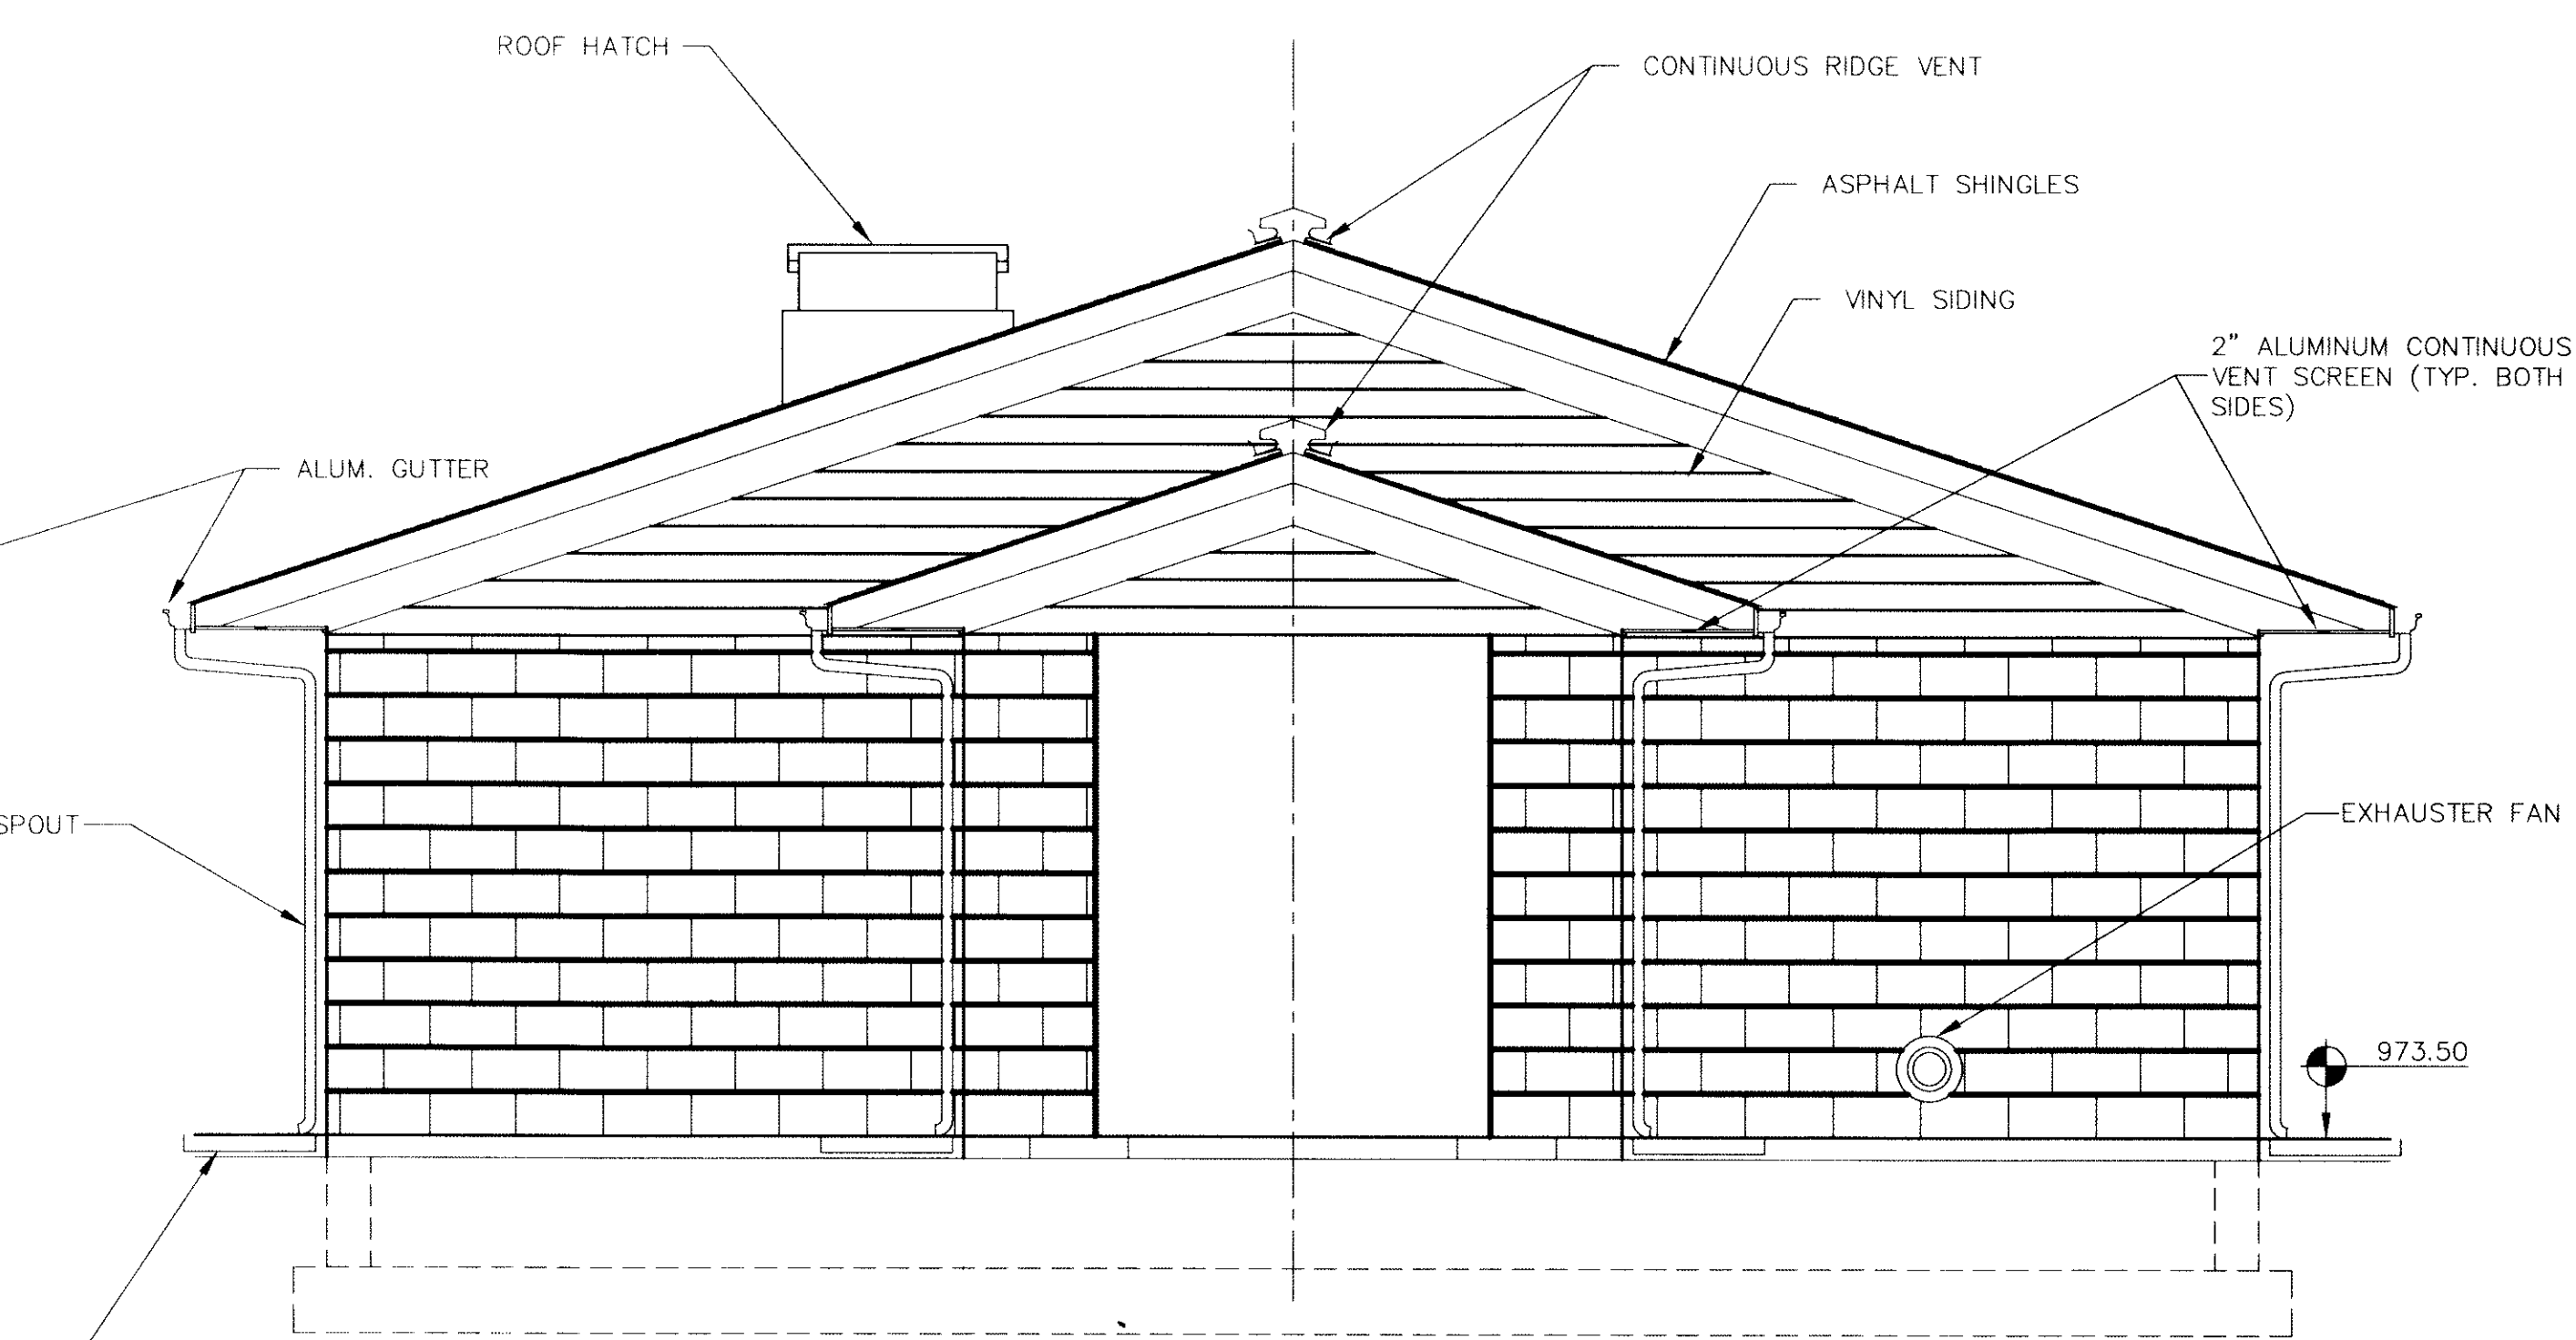

NORTH ELEVATION
SCALE: 3/8" = 1'-0"

RECORD DRAWINGS


THESE DRAWINGS HAVE BEEN PREPARED FROM
INFORMATION BY OTHERS. ENGINEER WILL NOT
BE RESPONSIBLE FOR ERRORS AND OMISSIONS
IN THE INFORMATION OR RECORDS FROM WHICH
THESE DRAWINGS ARE PRODUCED.

CONTRACT "B"					
WELLS AND TREATMENT FACILITIES					
ELEVATIONS					
ELROD WATER COMPANY, INC.					
DIVISION "E"		2	11/26/96	CLG	RECORD DRAWINGS
WATERWORKS SYSTEM IMPROVEMENTS		1	3/4/94	CLG	REVISED LENGTH OF BUILDING
			NO.	DATE	BY
					REVISIONS

M.D. **WESSLER** *and*
ASSOCIATES
CONSULTING ENGINEERS
6219 South East Street, Suite A
Indianapolis, Indiana 46227-2148

SCALE:	3/8" = 1'-0"
DATE:	OCT. 14, 1993
PROJECT NO.:	37391.04
DRAWN BY:	M.A.W.
APPROVED BY:	D.G.C.
PLOTTED:	4/13/94
CAD FILE:	373-B13.DWG

EXCEPT FOR USES EXPRESSLY
PERMITTED IN WRITING, INFOR-
MATION SHOWN OR INCLUDED
IN THIS DOCUMENT IS SOLELY
THE PROPERTY OF M.D.
WESSLER & ASSOCIATES, INC.

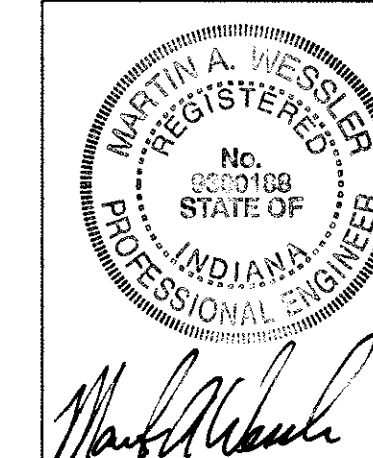

SHEET B13
OF 19