

# RECORD DRAWINGS

THESE DRAWINGS HAVE BEEN PREPARED FROM INFORMATION BY OTHERS. ENGINEER WILL NOT BE RESPONSIBLE FOR ERRORS AND OMISSIONS IN THE INFORMATION OR RECORDS FROM WHICH THESE DRAWINGS ARE PRODUCED.

TREATMENT PLANT PLUMBING PLAN  
SCALE:  $\frac{3}{8}" = 1'-0"$

NOTES:

1. ALL WATER PIPING SHALL BE TYPE "L" SOFT COPPER. ALL JOINTS IN PIPING SHALL BE MADE ABOVE THE FLOOR.

### LEGEND


- COLD WATER PIPING **(COPPER)**  
 --- DRAIN PIPE **(PVC)**  
 --- VENT PIPING **(PVC)**  
 ○ 4" F.D. FLOOR DRAIN (SIZE AS SHOWN)  
 ○ C.O. CLEAN OUT

<u>M.B.</u> <b>WESSLER</b> <i>and</i> <b>ASSOCIATES</b> CONSULTING ENGINEERS 6219 South East Street, Suite A Indianapolis, Indiana 46227-2148	CONTRACT "B" WELLS AND TREATMENT FACILITIES HVAC AND PLUMBING PLANS
	ELROD WATER COMPANY, INC. DIVISION "E" WATERWORKS SYSTEM IMPROVEMENTS

SCALE:	AS SHOWN
DATE:	OCT. 14, 1993
PROJECT NO.:	37391.04
DRAWN BY:	M.A.W.
APPROVED BY:	D.G.C.
PLOTTED:	4/14/94
CAD FILE:	373-B14.DWG

NOT PUBLISHED  
ALL RIGHTS RESERVED

EXCEPT FOR USES EXPRESSLY  
PERMITTED IN WRITING, INFOR-  
MATION SHOWN OR INCLUDED  
IN THIS DOCUMENT IS SOLELY  
THE PROPERTY OF M.D.  
WESSLER & ASSOCIATES, INC.

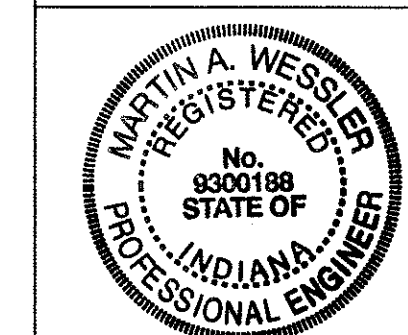

Mat Risch

SHEET B14  
OF 19