
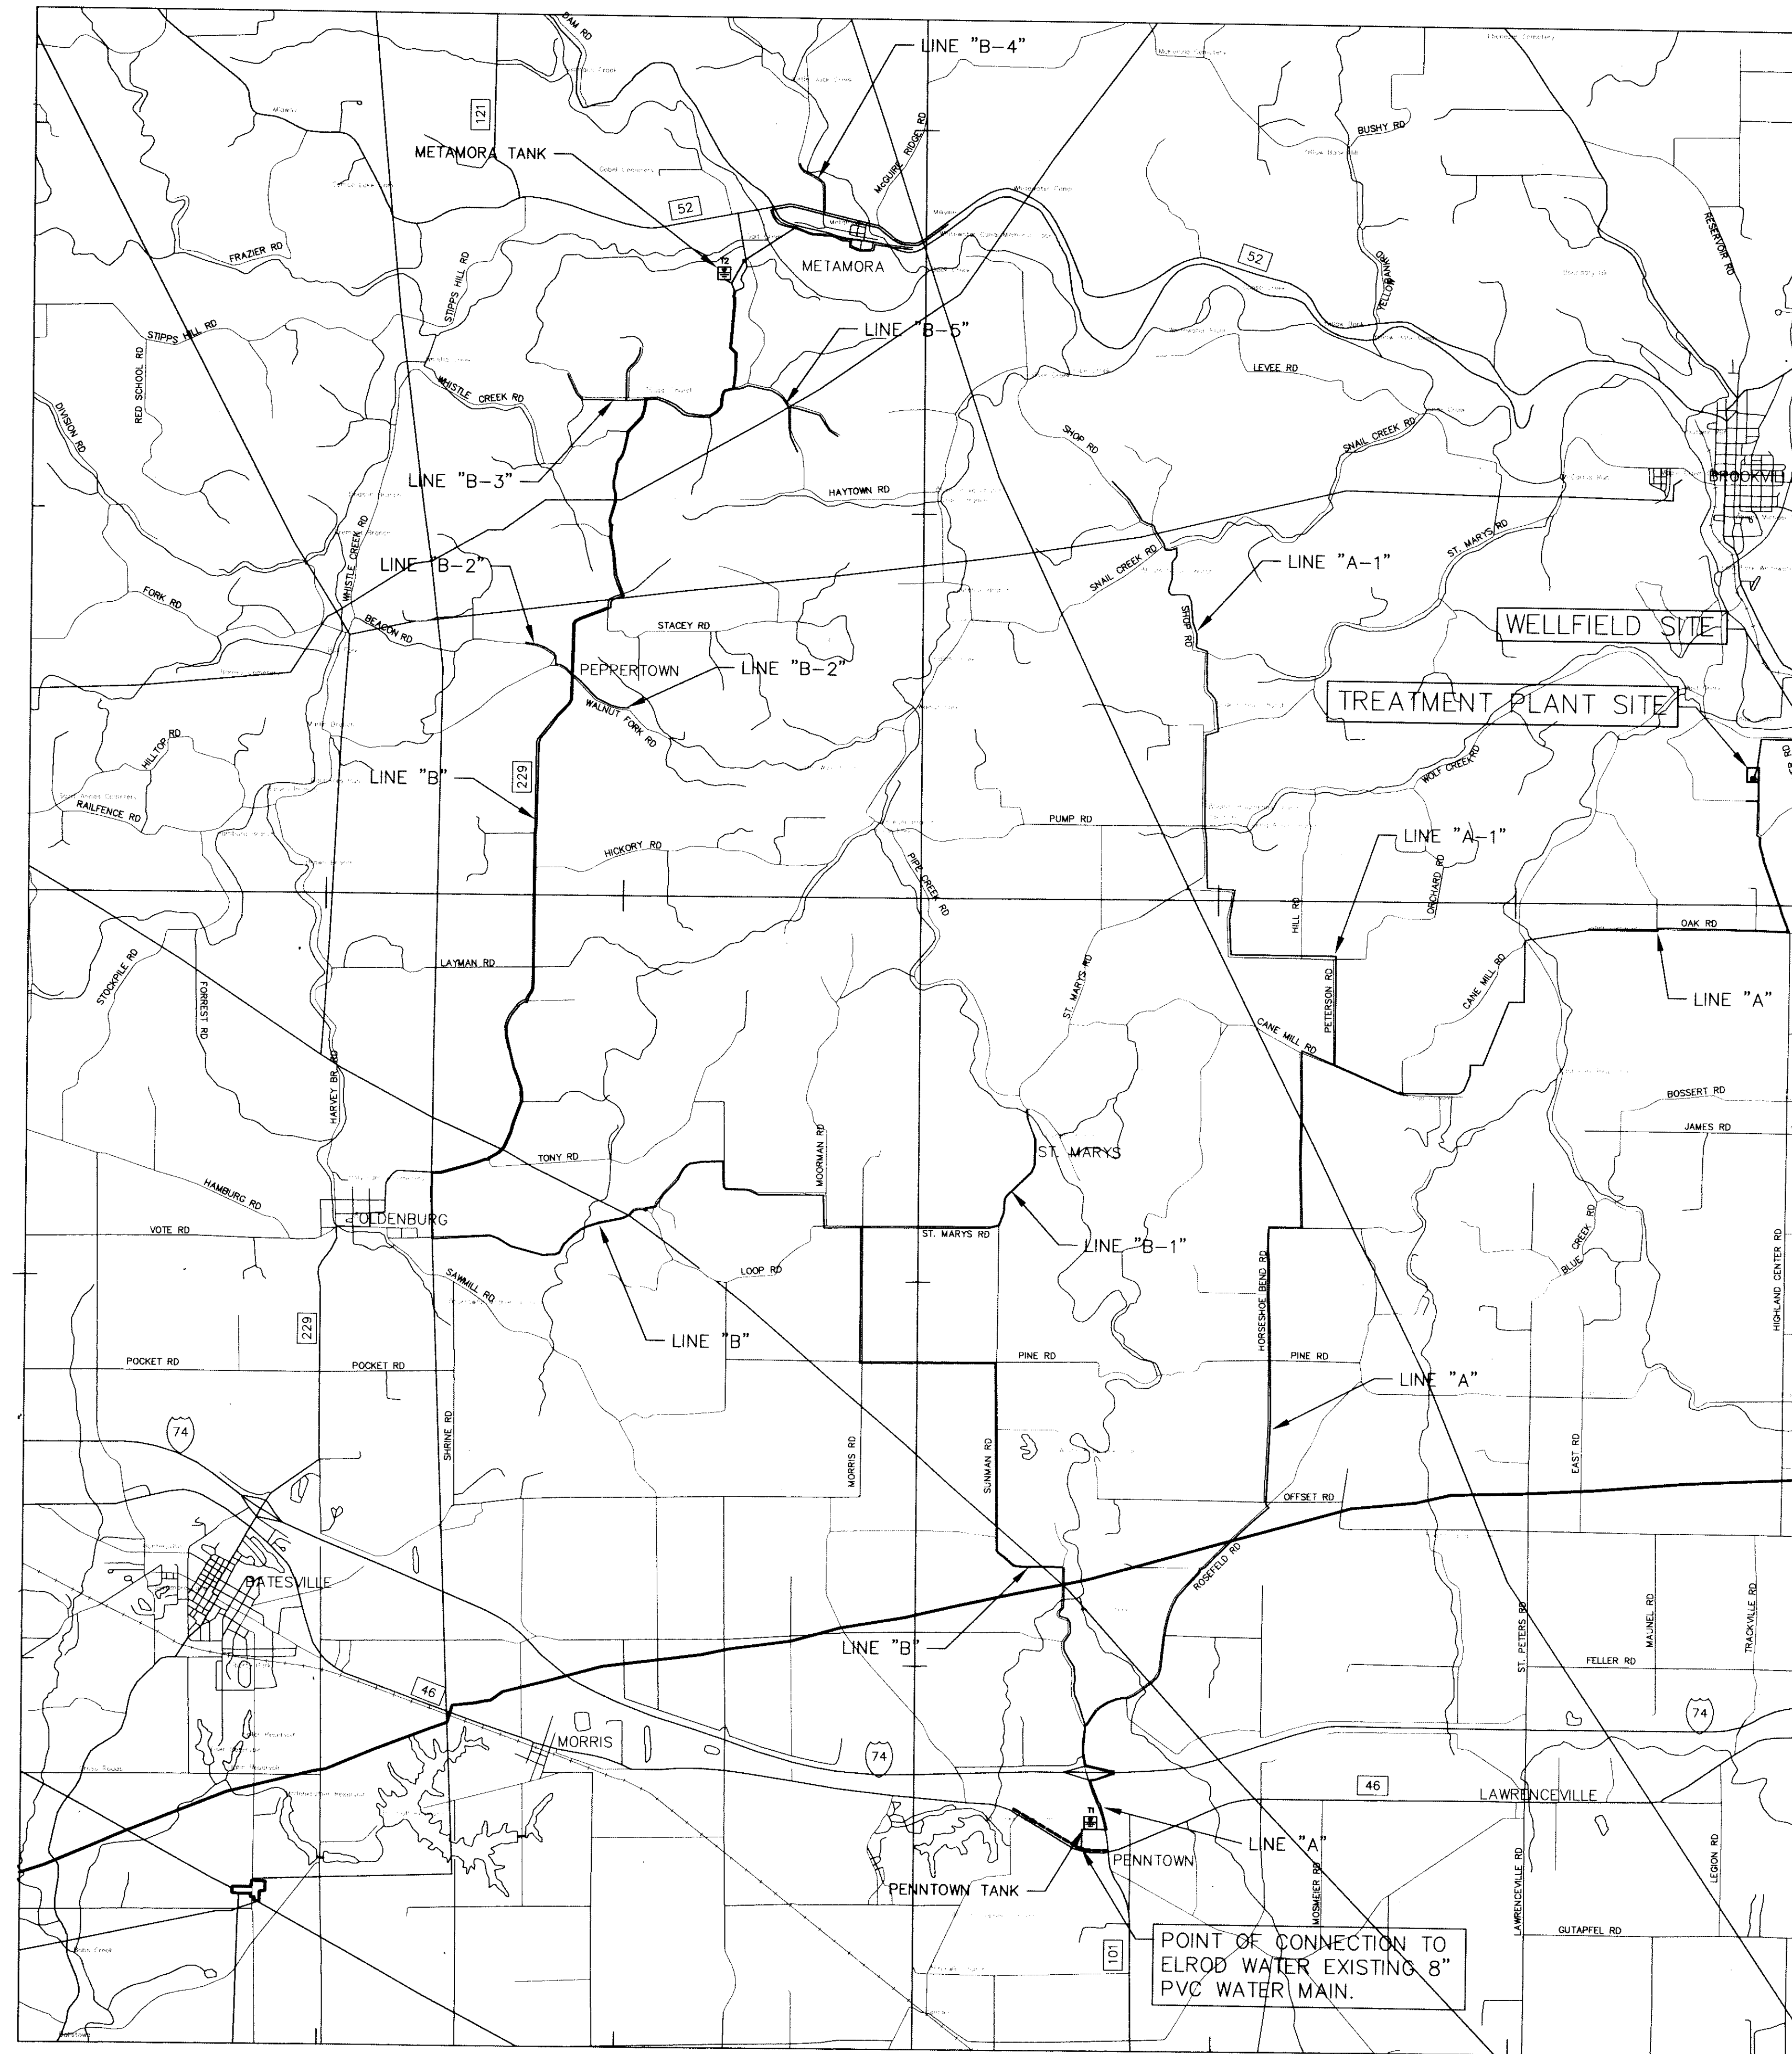


C:\LNG\373-B2 Tue Jun 25 15:02:23 1996

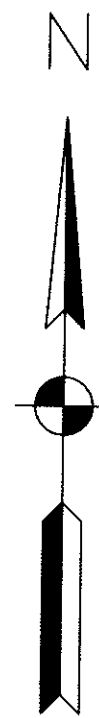

LOCATION PLAN  
SCALE: 1" = 4000'

### GENERAL LEGEND

- NEW WATER MAIN
- 8" W --- EXISTING WATER MAIN
- 3" G --- EXISTING GAS MAIN
- NEW VALVE
- NEW HYDRANT ASSEMBLY - TYPE 3
- △ BM-577 BENCH MARK
- CENTERLINE OF DITCH OR STREAM
- PROPERTY LINE
- EXISTING TREES AND BRUSH
- FENCE (TYPE INDICATED)
- MEINDERS PROPERTY OWNER
- 975 EXISTING CONTOURS AND ELEVATION
- 975 PROPOSED CONTOURS AND ELEVATION
- EXISTING TELEPHONE PEDESTAL
- EXISTING UTILITY POLE
- 974.6 EXISTING SPOT ELEVATION
- 970.0 PROPOSED SPOT ELEVATION

### WATER

ELROD WATER COMPANY, INC.  
P.O. BOX 395  
MILAN, IN 47031  
(812) 654-3200  
JEFF MEINDERS, SUPERINTENDENT

NORTH DEARBORN WATER CORPORATION  
P.O. BOX 481  
LAWRENCEBURG, IN 47025  
(812) 576-2177

### GAS

OHIO VALLEY GAS COMPANY  
P.O. BOX 445  
CONNERSVILLE, IN 47331  
(800) 326-1148

### CABLE TV

NW1 CABLE SYSTEMS INC.  
P.O. BOX  
MARTINSVILLE, IN  
(800) 466-0900

### RAILROAD

WHITWATER VALLEY RAILROAD  
P.O. BOX 406  
CONNERSVILLE, IN 47331  
(317) 825-2054

### ELECTRIC

PSI ENERGY  
200 E. VETERANS MEMORIAL DR.  
P.O. BOX 387  
CONNERSVILLE, IN 47331  
(317) 825-3195

SOUTHEASTERN INDIANA REMC  
P.O. BOX 196  
OSGOOD, IN 47037  
(800) 737-4111

RUSH COUNTY REMC  
P.O. BOX 7  
RUSHVILLE, IN 46173-0007  
(317) 932-4121

### TELEPHONE

GENERAL TELEPHONE COMPANY  
P.O. BOX 363  
CONNERSVILLE, IN 47331  
(800) 483-1000

SUNMAN TELEPHONE COMPANY  
P.O. BOX 145  
SUNMAN, IN 47041  
(812) 623-3822

### SEWAGE

INDIANA STATE BOARD OF HEALTH  
SANITARY ENGINEERING DEPARTMENT  
1330 W. MICHIGAN ST.  
INDIANAPOLIS, IN 46206  
(317) 633-0175

### GENERAL PLAN NOTES

1. ALL EXISTING LOCATIONS, SIZES AND INVERTS OF EXISTING UTILITIES ARE SHOWN BASED ON BEST INFORMATION POSSIBLE. HOWEVER, THE ENGINEER DOES NOT GUARANTEE OR ASSURE THAT SUCH INFORMATION IS TRUE OR EVEN APPROXIMATE. THIS CONTRACTOR SHALL DETERMINE WHICH UTILITIES MAY CONFLICT WITH HIS WORK AND VERIFY THEIR LOCATIONS, SIZES AND INVERTS, ETC., ADJUST HIS WORK ACCORDINGLY, AND NOTIFY THE ENGINEER OF ANY SUCH CONFLICTS. CONTRACTOR SHALL REFER TO APPLICABLE SECTIONS OF THE SPECIFICATIONS RELATIVE TO THE ABOVE.
2. CONTRACTOR SHALL BE RESPONSIBLE FOR CONTACTING ALL PERMIT ISSUING AGENCIES WITHIN THE TIME FRAME SPECIFIED BY THAT AGENCY PRIOR TO BEGINNING CONSTRUCTION.
3. ANY ALTERATIONS TO THESE PLANS NOT AUTHORIZED BY M.D. WESSLER AND ASSOCIATES, INC. AND NOT IN ACCORDANCE WITH THE PLANS AND RECORDS ON FILE AT M.D. WESSLER AND ASSOCIATES, INC.'S OFFICE SHALL RELIEVE M.D. WESSLER AND ASSOCIATES, INC. OF RESPONSIBILITY FOR OVERALL ACCURACY OF THESE PLANS.

**RECORD DRAWINGS**  
THESE DRAWINGS HAVE BEEN PREPARED FROM INFORMATION BY OTHERS. ENGINEER WILL NOT BE RESPONSIBLE FOR ERRORS AND OMISSIONS IN THE INFORMATION OR RECORDS FROM WHICH THESE DRAWINGS ARE PRODUCED.

SITE MAP  
NO SCALE

"DON'T DIG BLIND"



CALL TWO WORKING DAYS  
BEFORE YOU DIG  
IT'S THE LAW  
1-800-382-5544

|                                                                                                                                                                           |            |                                  |               |
|---------------------------------------------------------------------------------------------------------------------------------------------------------------------------|------------|----------------------------------|---------------|
| CONTRACT "B"                                                                                                                                                              |            | RECORD DRAWINGS                  |               |
| WELLS AND TREATMENT FACILITIES                                                                                                                                            |            | BY DATE                          |               |
| LOCATION PLAN                                                                                                                                                             |            | NO. 1                            |               |
| ELROD WATER COMPANY, INC.                                                                                                                                                 |            | 11/8/96                          |               |
| DIVISION "E"                                                                                                                                                              |            | CLG                              |               |
| WATERWORKS SYSTEM IMPROVEMENTS                                                                                                                                            |            | REVISIONS                        |               |
| M.D. WESSLER and ASSOCIATES                                                                                                                                               |            | CONSULTING ENGINEERS             |               |
| 6219 South East Street, Suite A                                                                                                                                           |            | Indianapolis, Indiana 46227-2148 |               |
| SCALE:                                                                                                                                                                    | AS SHOWN   | DATE:                            | OCT. 14, 1993 |
| PROJECT NO.:                                                                                                                                                              | 3739104    | DRAWN BY:                        | M.A.W.        |
| APPROVED BY:                                                                                                                                                              | D.G.C.     | PLOTTED:                         | 1/25/94       |
| CAD FILE:                                                                                                                                                                 | 373-B2.DWG |                                  |               |
| NOT PUBLISHED<br>ALL RIGHTS RESERVED                                                                                                                                      |            |                                  |               |
| EXCEPT FOR USES EXPRESSLY<br>PERMITTED IN WRITING, INFOR-<br>MATION SHOWN OR INCLUDED<br>IN THIS DOCUMENT IS SOLELY<br>THE PROPERTY OF M.D.<br>WESSLER & ASSOCIATES, INC. |            |                                  |               |
| DONALD G. COREY<br>REGISTERED<br>PROFESSIONAL ENGINEER<br>NO. 13334<br>STATE OF INDIANA                                                                                   |            |                                  |               |
| SHEET B2                                                                                                                                                                  |            |                                  |               |
| OF 19                                                                                                                                                                     |            |                                  |               |