

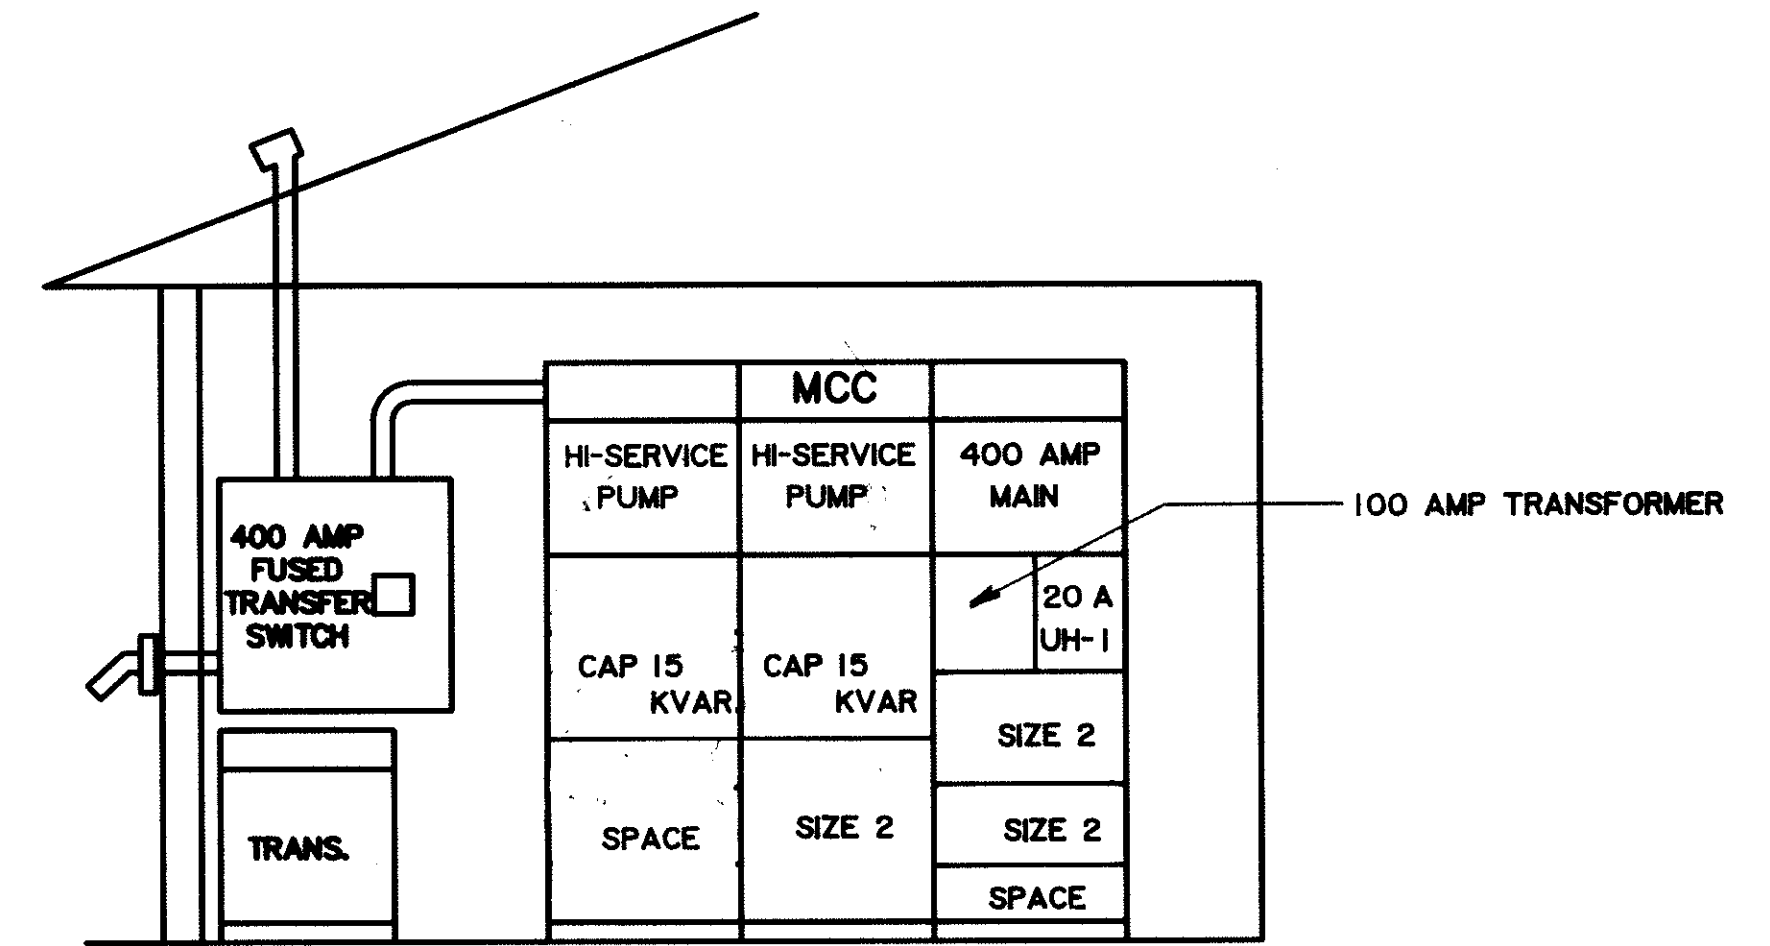
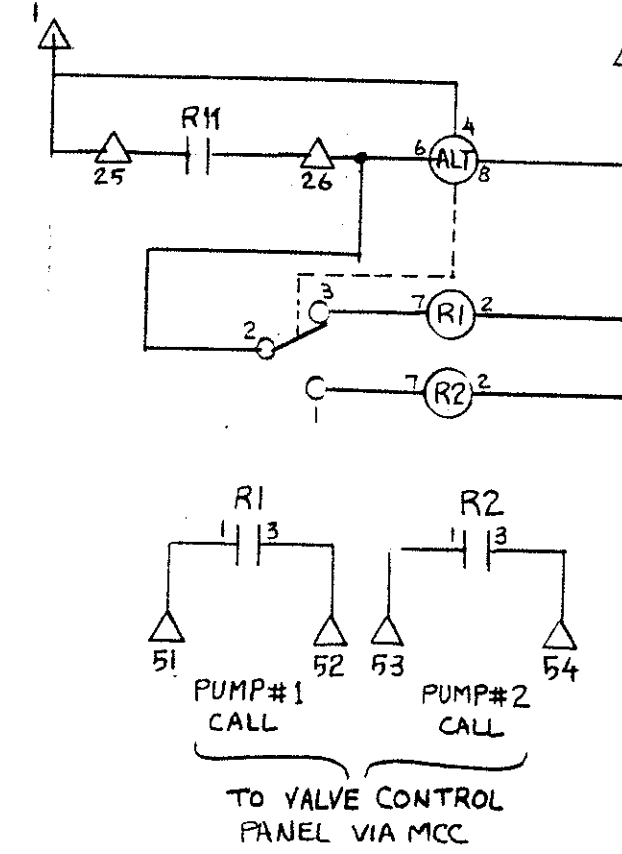
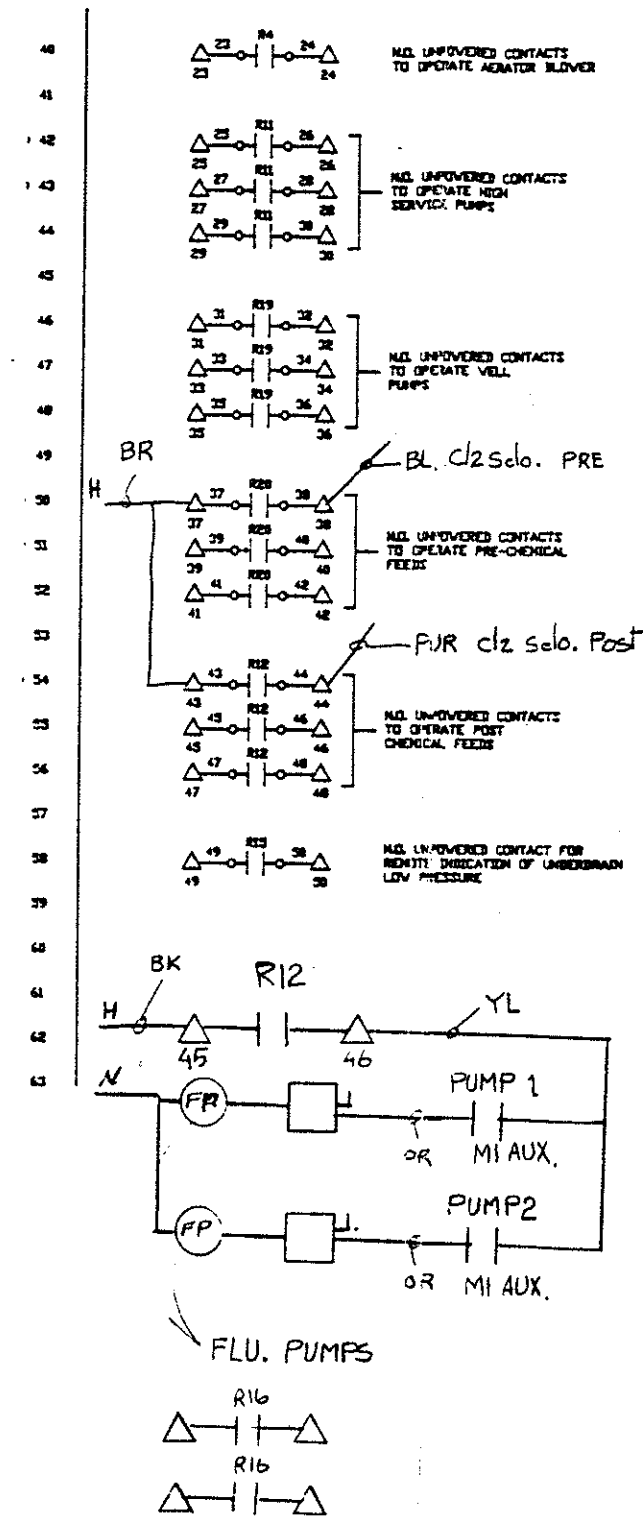


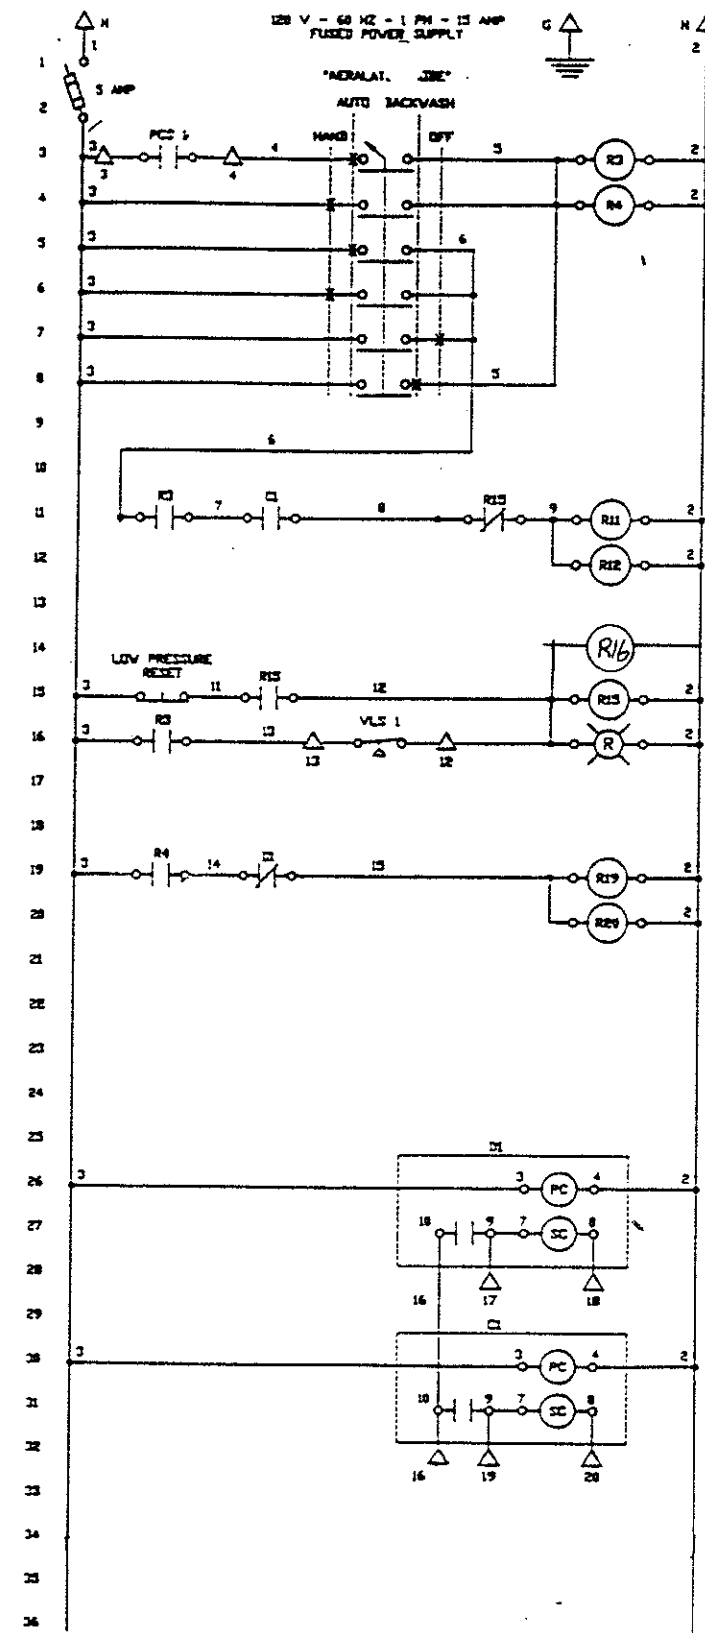

MOTOR CONTROL CENTER LAYOUT
SCALE: NONE

VALVE PANEL WIRING
SCALE: NONE

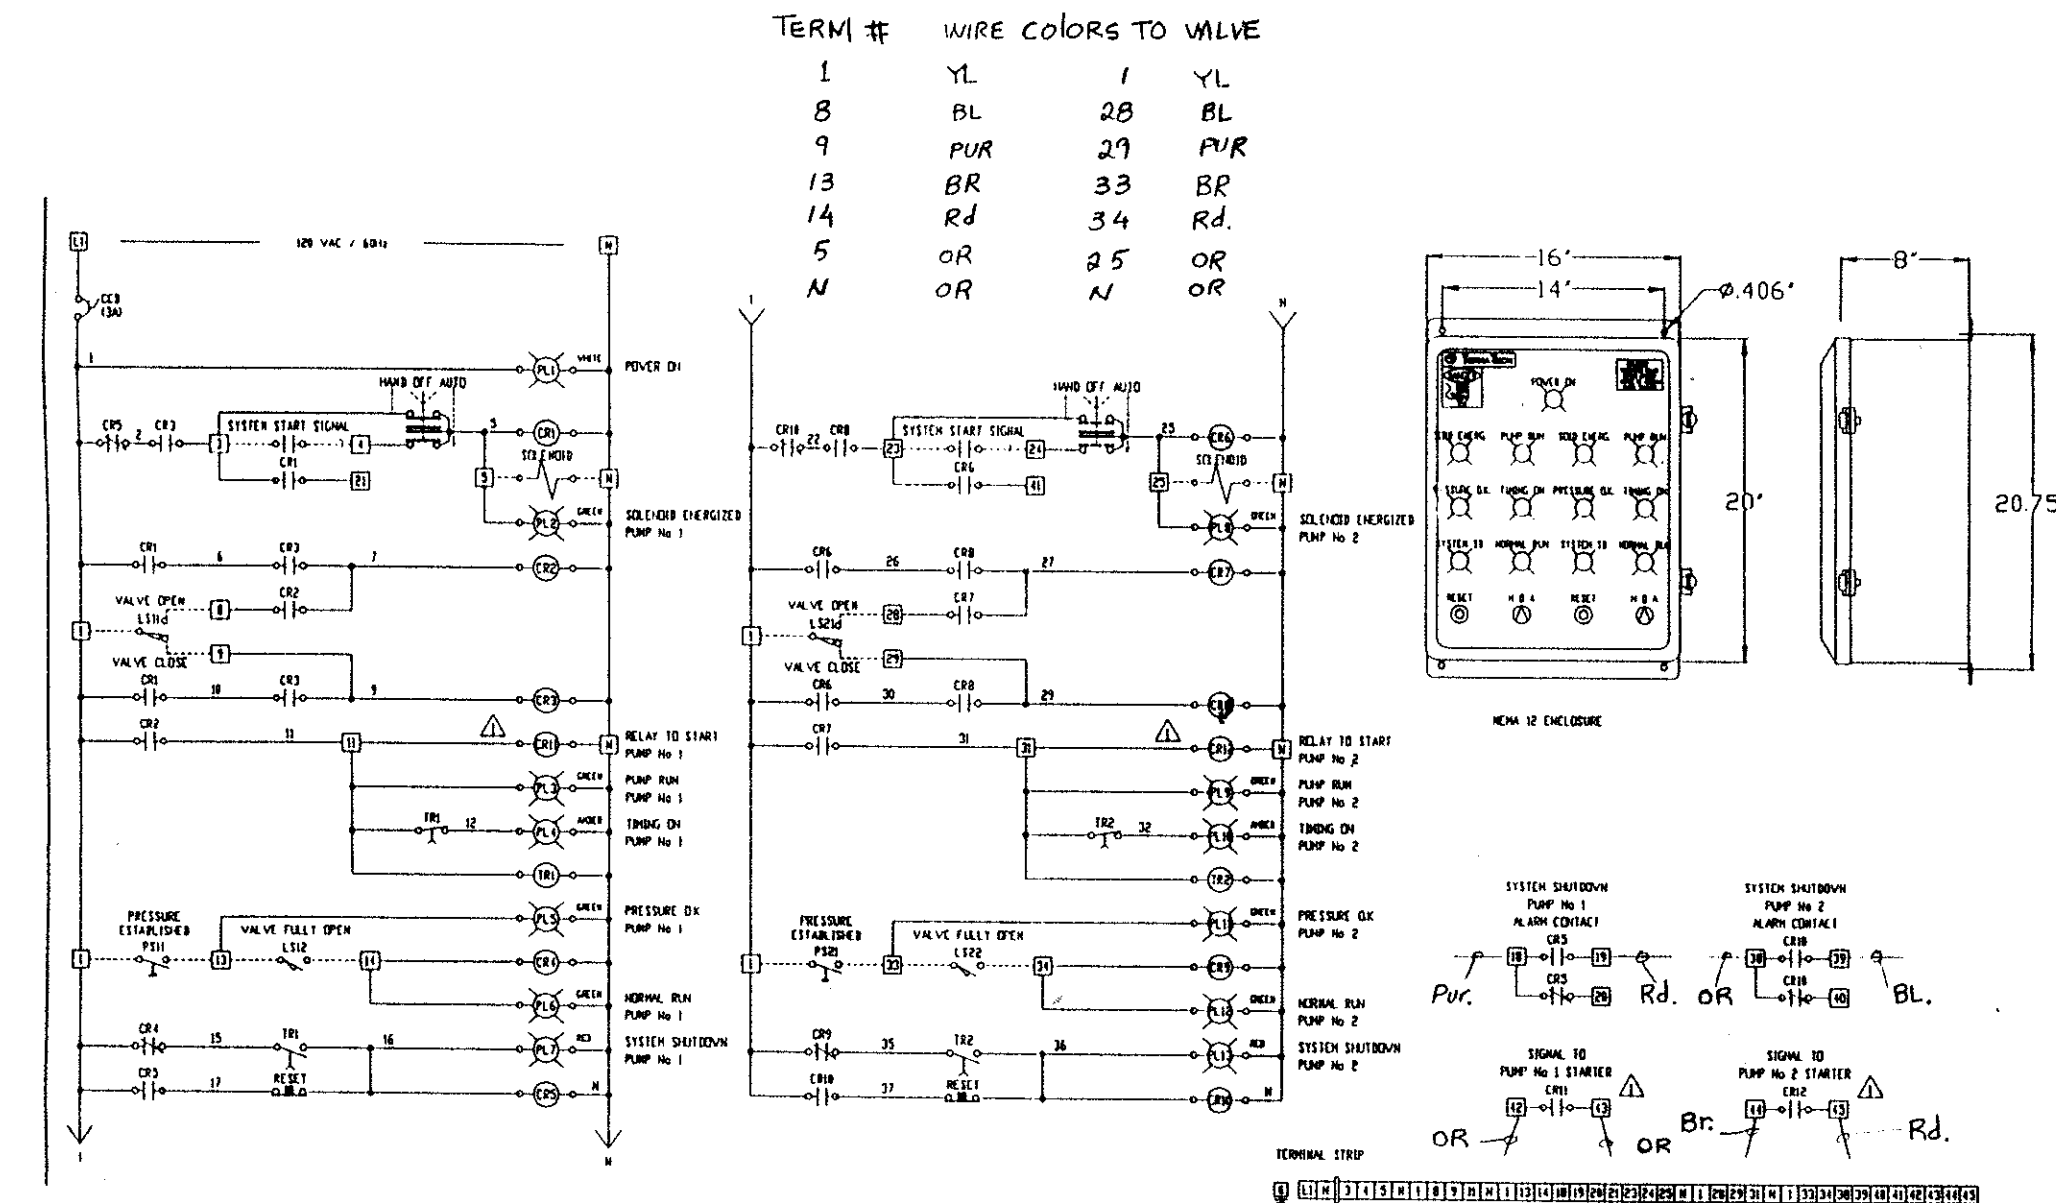

RECORD DRAWINGS
THESE DRAWINGS HAVE BEEN PREPARED FROM INFORMATION BY OTHERS. ENGINEER WILL NOT BE RESPONSIBLE FOR ERRORS AND OMISSIONS IN THE INFORMATION OR RECORDS FROM WHICH THESE DRAWINGS ARE PRODUCED.

VALVE CONTROL PANEL
SCALE: NONE

CONTRACT "B"	
WELLS AND TREATMENT FACILITIES	
ELECTRICAL SCHEMATICS & LAYOUT	
ELROD WATER COMPANY, INC.	
DIVISION "E"	
WATERWORKS SYSTEM IMPROVEMENTS	
DATE	BY
11/8/96	CLG
1	ND
RECORD DRAWINGS	
REVISIONS	

SCALE:	AS SHOWN
DATE:	OCT 14, 1993
PROJECT NO.:	37391.04
DRAWN BY:	M.A.W.
APPROVED BY:	M.D.W.
PLOTTED:	4/14/94
CAD FILE:	373-821.DWG

NOT PUBLISHED
ALL RIGHTS RESERVED

EXCEPT FOR USES EXPRESSLY PERMITTED IN WRITING, INFORMATION SHOWN OR INCLUDED IN THIS DOCUMENT IS SOLELY THE PROPERTY OF M.D. WESSLER & ASSOCIATES, INC.

M.D. WESSLER and ASSOCIATES
CONSULTING ENGINEERS
6219 South East Street, Suite A
Indianapolis, Indiana 46227-2148

REGISTERED PROFESSIONAL ENGINEER
No. 12215
STATE OF INDIANA

M.D. Wessler
SHE'