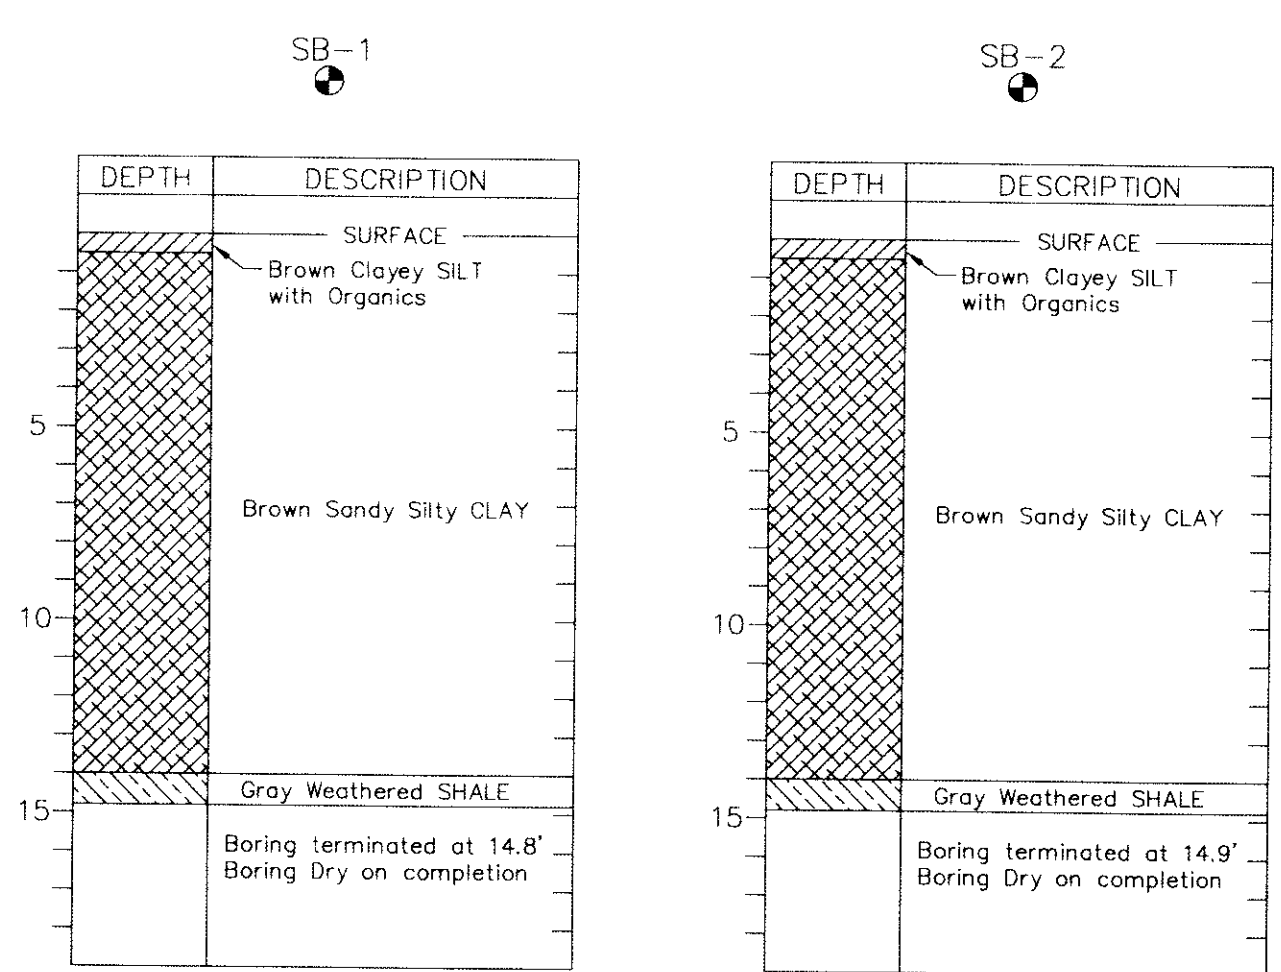


LEGEND

- |  |                                 |
|--|---------------------------------|
|  | NEW WATER MAIN                  |
|  | EXISTING WATER MAIN             |
|  | EXISTING GAS MAIN               |
|  | NEW VALVE                       |
|  | NEW HYDRANT ASSEMBLY - TYPE 3   |
|  | BENCH MARK                      |
|  | CENTERLINE OF DITCH OR STREAM   |
|  | PROPERTY LINE                   |
|  | EXISTING TREES AND BRUSH        |
|  | FENCE (TYPE INDICATED)          |
|  | PROPERTY OWNER                  |
|  | EXISTING CONTOURS AND ELEVATION |
|  | PROPOSED CONTOURS AND ELEVATION |
|  | EXISTING TELEPHONE PEDESTAL     |
|  | EXISTING UTILITY POLE           |
|  | EXISTING SPOT ELEVATION         |
|  | PROPOSED SPOT ELEVATION         |
|  | SOIL BORING LOCATION            |

ENLARGED SITE PLAN

SCALE: 1" = 20'

SOIL BORING LOGS

# RECORD DRAWINGS

THESE DRAWINGS HAVE BEEN PREPARED FROM INFORMATION BY OTHERS. ENGINEER WILL NOT BE RESPONSIBLE FOR ERRORS AND OMISSIONS IN THE INFORMATION OR RECORDS FROM WHICH THESE DRAWINGS ARE PRODUCED.

[illegible]