

# ELROD WATER COMPANY, INC. MILAN, INDIANA

## DIVISION "E" WATERWORKS SYSTEM IMPROVEMENTS CONTRACT "C" WATER STORAGE TANKS

### PLAN SHEET INDEX

<u>SHEET DESCRIPTION</u>	<u>SHEET NO.</u>
TITLE SHEET	1
LOCATION PLAN	2
400,000 GALLON ELEVATED TANK	3
100,000 GALLON GROUND TANK	4

### BOARD OF DIRECTORS

JOYCE HUFFMAN, PRESIDENT	NELSON ELLIOT, MEMBER
HENRY WESTERMAN, TREASURER	ROBERT HUMMEL, MEMBER
ALREENA NICKULIS, SECRETARY	JEFFERY LAUB, MEMBER
ED ALLGEIER, MEMBER	FRANK MARTIN, MEMBER
MARY ENGEL, OFFICE MANAGER	DANIEL SCHMALTZ, MEMBER
JEFF MEINDERS, SUPERINTENDENT	

*M.A.* **WESSLER** *and*  
**ASSOCIATES**


**CONSULTING ENGINEERS**

6219 South East Street, Suite A  
Indianapolis, Indiana 46227-2148


OCTOBER 14, 1993  
REVISED MARCH 4, 1994

**RECORD DRAWINGS**  
These drawings have been prepared from  
information furnished by others. Engineer will not  
be responsible for errors and omissions  
the information or records from which  
these drawings are produced.

**CERTIFIED BY:**

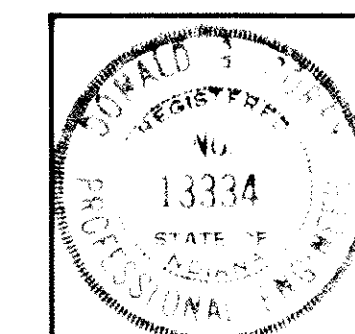

DONALD G. COREY  
REGISTERED ENGINEER STATE OF INDIANA NO. 13334

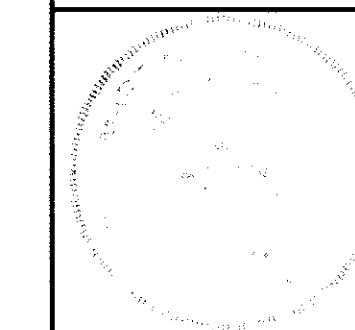

*Martin A. Wessler*  
MARTIN A. WESSLER  
REGISTERED ENGINEER STATE OF INDIANA NO. 9300188