

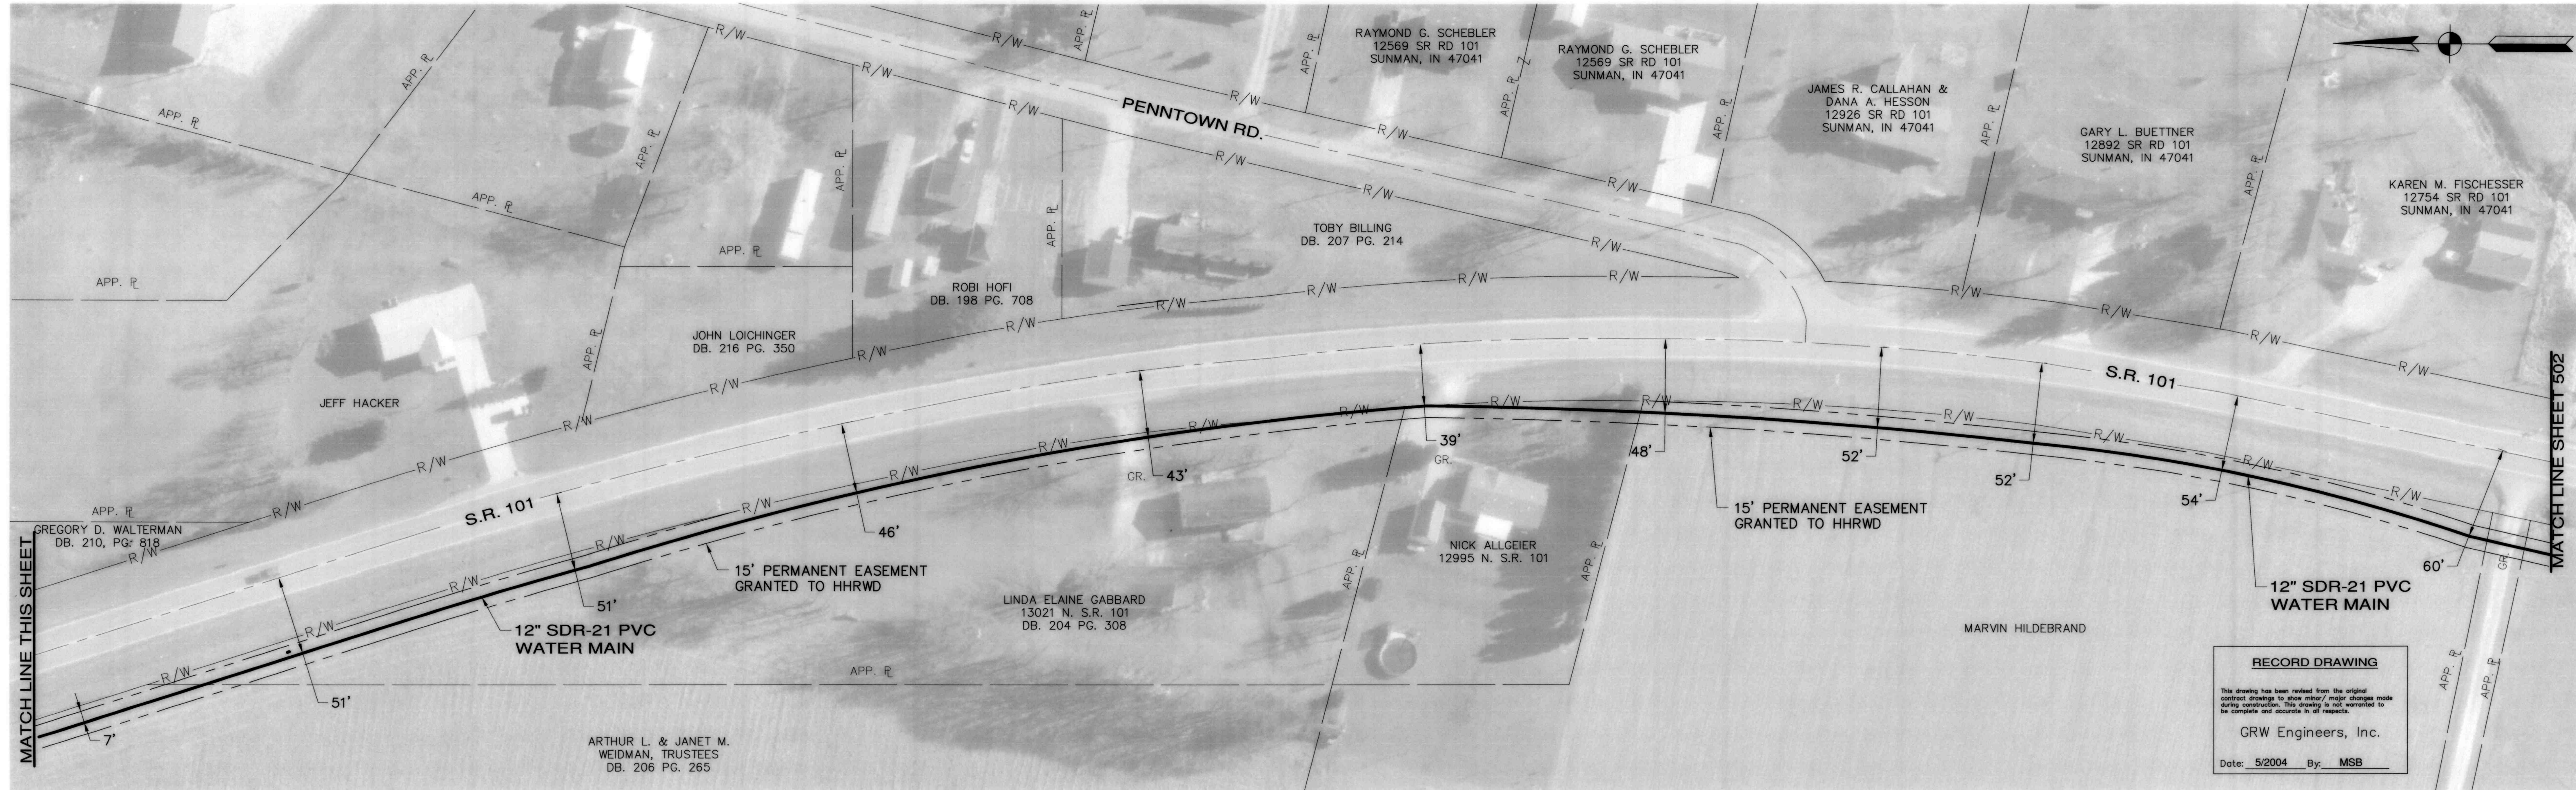


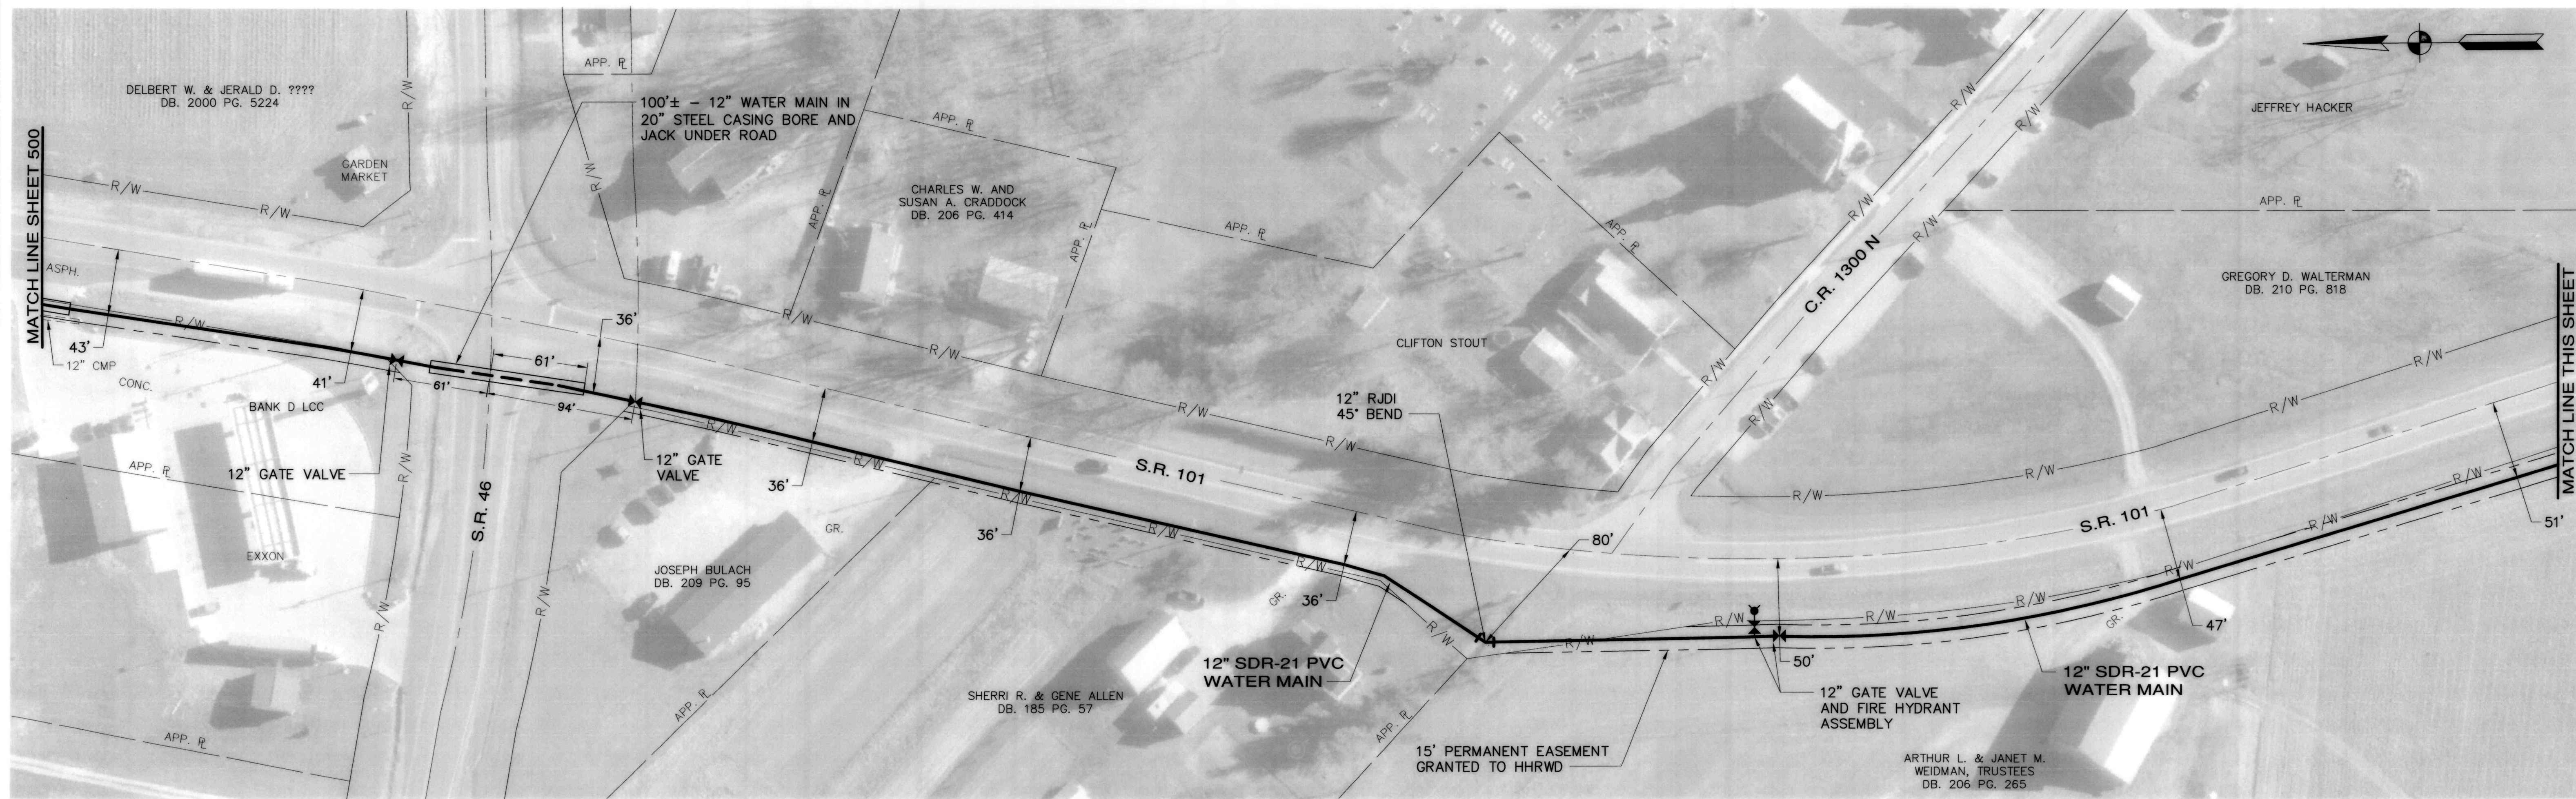

- NOTES:
- 1) THE UTILITIES AND THEIR LOCATION SHOWN ON PLANS ARE APPROXIMATE. CONTRACTOR SHALL VERIFY ALL UTILITIES IN THE FIELD AND NOTIFY ALL UTILITY COMPANIES PRIOR TO INSTALLATION OF THE WATER LINE.
 - 2) ALL PIPING SHALL BE CLASS 200 PVC UNLESS OTHERWISE NOTED.
 - 3) 48" MINIMUM COVER REQUIRED OVER TOP OF WATER LINE.
 - 4) THE LOCATION OF AIR RELEASE VALVES IS APPROXIMATE. VALVES SHALL BE LOCATED AND INSTALLED BY THE CONTRACTOR AT THE HIGH POINT ALONG THE WATER LINE.

NO.	AS-BUILT REVISION DESCRIPTION	DATE	BY
1		5/2004	MSB
REVISIONS			

**HOOSIER HILLS REGIONAL
WATER DISTRICT**
 DIVISION "F" WATERWORKS SYSTEM IMPROVEMENTS
 CONTRACT F-1
 S.R. 101
 GRW PROJECT NO. 2745-04

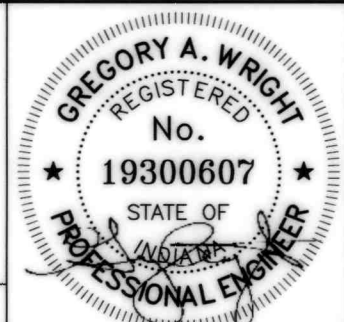

GRW Engineers, Inc.
 Engineers, Architects, Planners
 INDIANAPOLIS, INDIANA
 LOUISVILLE & LEXINGTON, KENTUCKY
 CINCINNATI, OHIO
 NASHVILLE, TENNESSEE
 ARLINGTON, TEXAS

DRAWN: BJD	DATE: JULY 2002
FILE NAME: SHEET501.DWG	SCALE: 1" = 50'
CHECKED:	SHEET NO. 501
APPROVED:	

RECORD DRAWING
 This drawing has been revised from the original contract drawings to show minor/major changes made during construction. This drawing is not warranted to be complete and accurate in all respects.
 GRW Engineers, Inc.
 Date: 5/2004 By: MSB

I:\2745\dwg\F-1\Record Dwg\Sheet 501.dwg, 11/8/2004 9:03:08 AM