
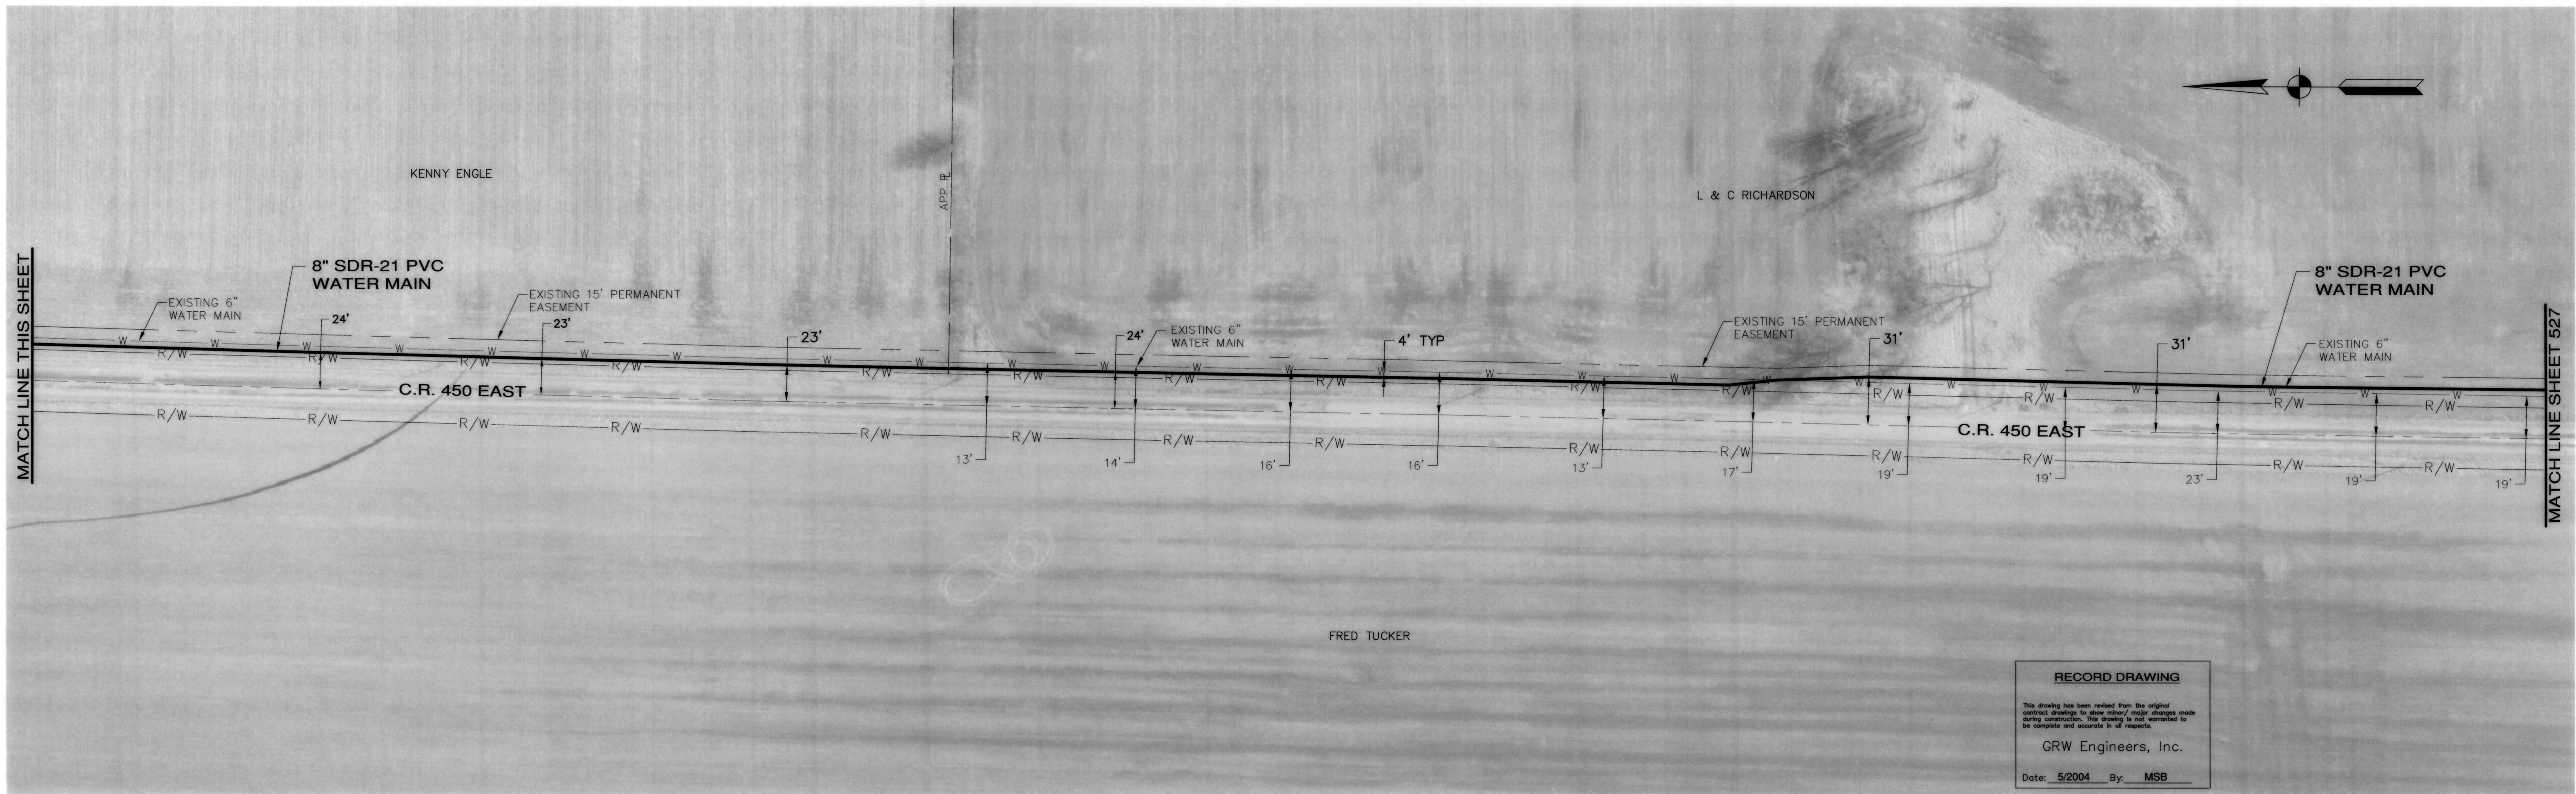


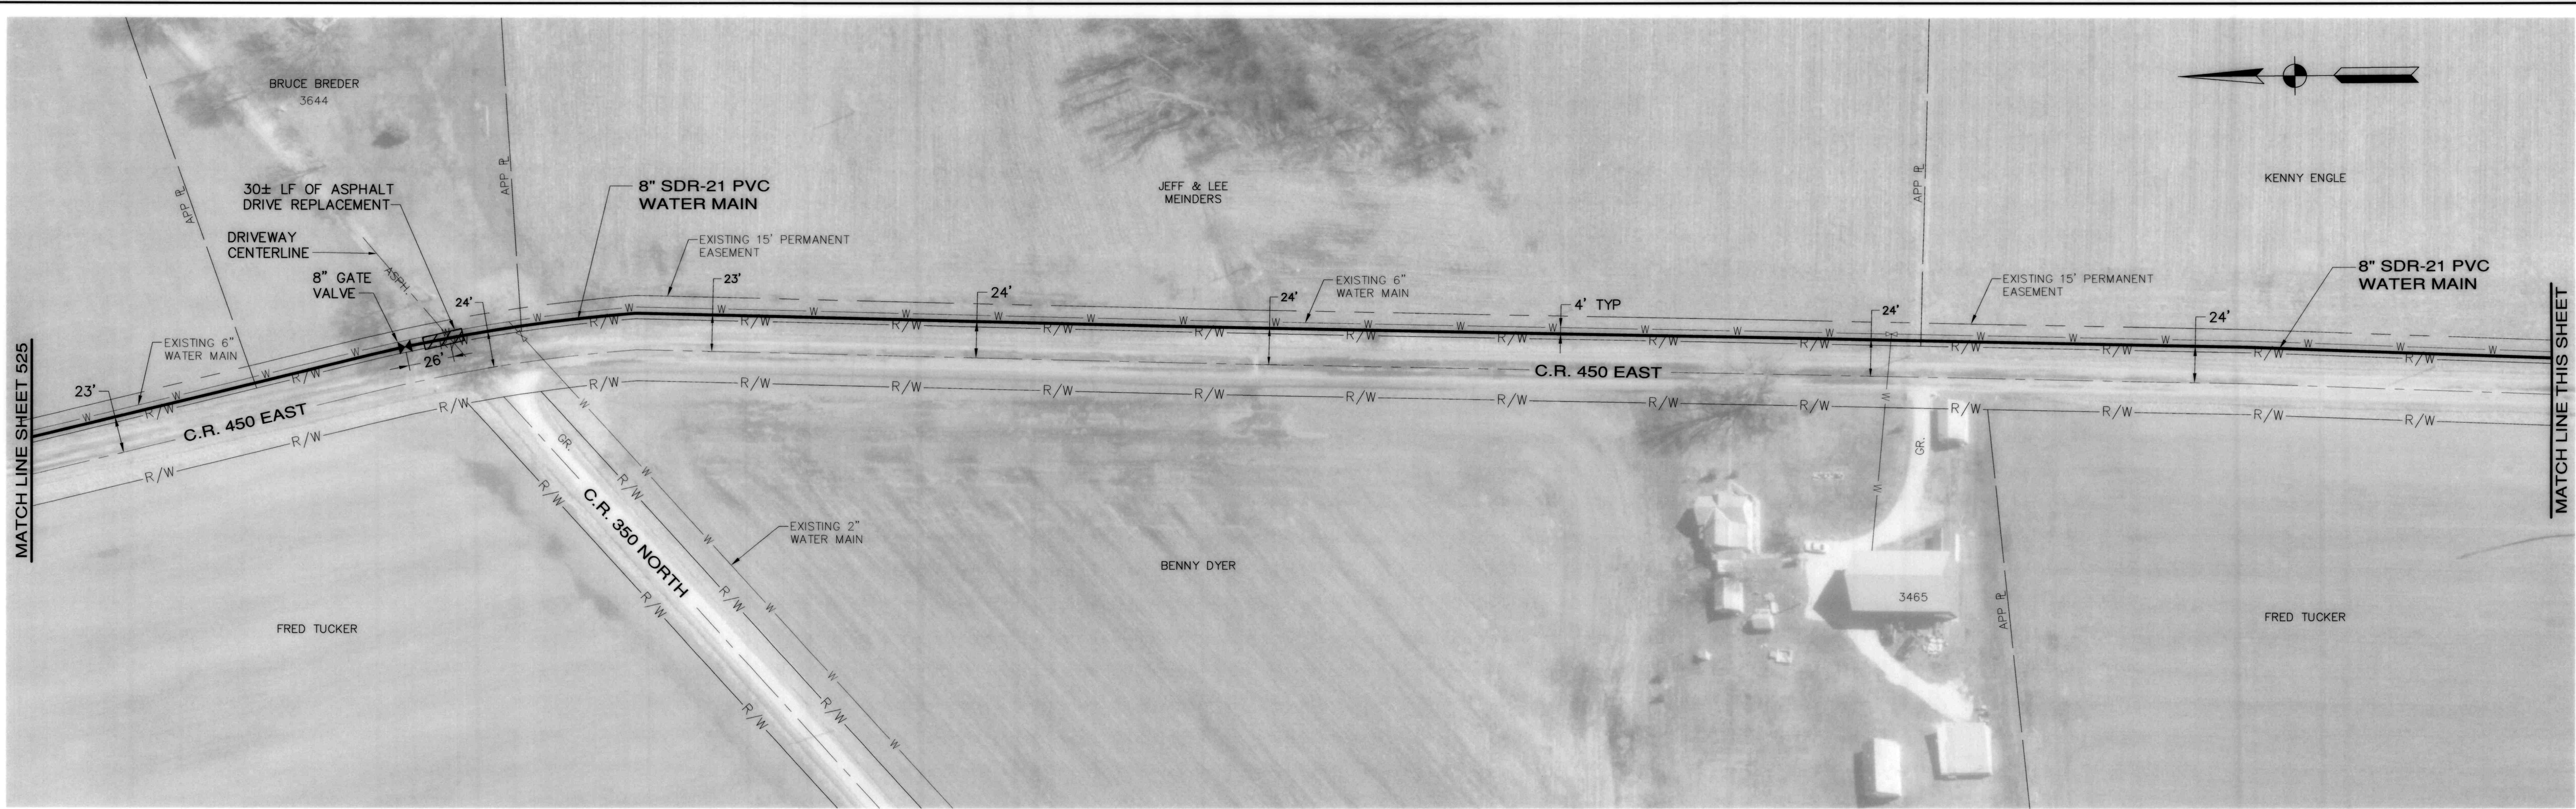

RECORD DRAWING

This drawing has been revised from the original contract drawings to show minor major changes made during construction. This drawing is not warranted to be complete and accurate in all respects.

GRW Engineers, Inc.

Date: 5/2004 By: MSB

NOTES:

- 1). THE UTILITIES AND THEIR LOCATION SHOWN ON PLANS ARE APPROXIMATE. CONTRACTOR SHALL VERIFY ALL UTILITIES IN THE FIELD AND NOTIFY ALL UTILITY COMPANIES PRIOR TO INSTALLATION OF THE WATER LINE.
- 2). ALL PIPING SHALL BE CLASS 200 PVC UNLESS OTHERWISE NOTED.
- 3). 48" MINIMUM COVER REQUIRED OVER TOP OF WATER LINE.
- 4). THE LOCATION OF AIR RELEASE VALVES IS APPROXIMATE. VALVES SHALL BE LOCATED AND INSTALLED BY THE CONTRACTOR AT THE HIGH POINT ALONG THE WATER LINE.


NO.	AS-BUILT REVISION DESCRIPTION	5/2004 DATE	MSB BY
1			
REVISIONS			

**HOOSIER HILLS REGIONAL
WATER DISTRICT**

DIVISION "F" WATERWORKS SYSTEM IMPROVEMENTS

**CONTRACT F-1
C.R. 450 EAST**

GRW PROJECT NO. 2745-04

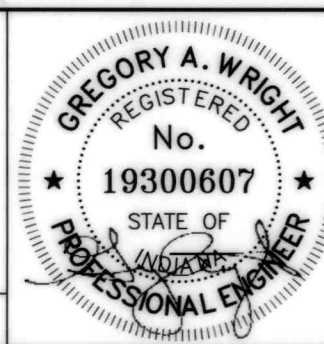

DRAWN: BJD	DATE: JULY 2002
FILE NAME: SHEETS26.DWG	SCALE: 1" = 50'
CHECKED:	SHEET NO. 526
APPROVED:	