




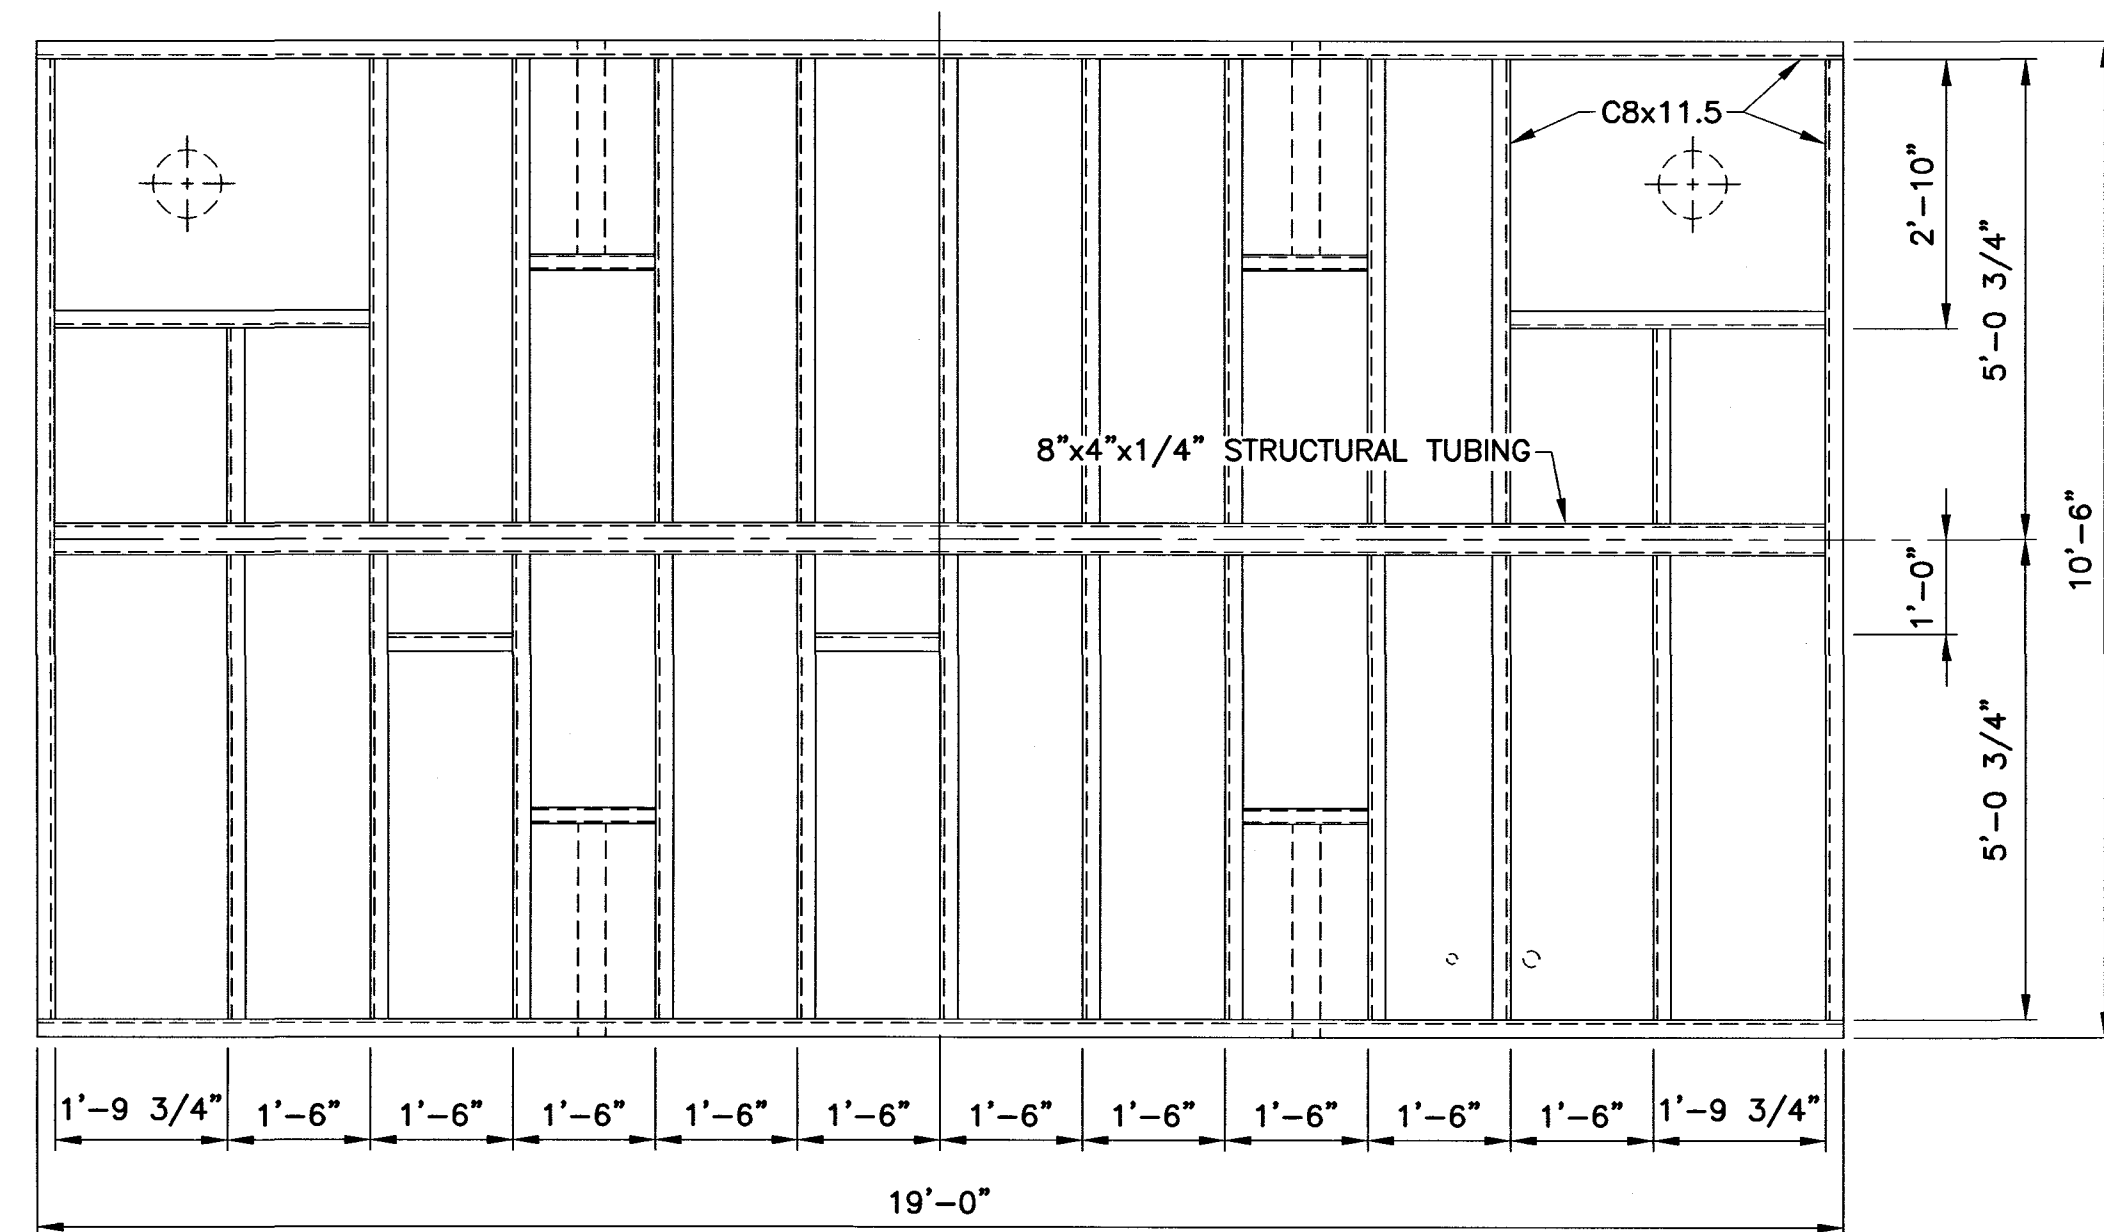

SKID PLAN

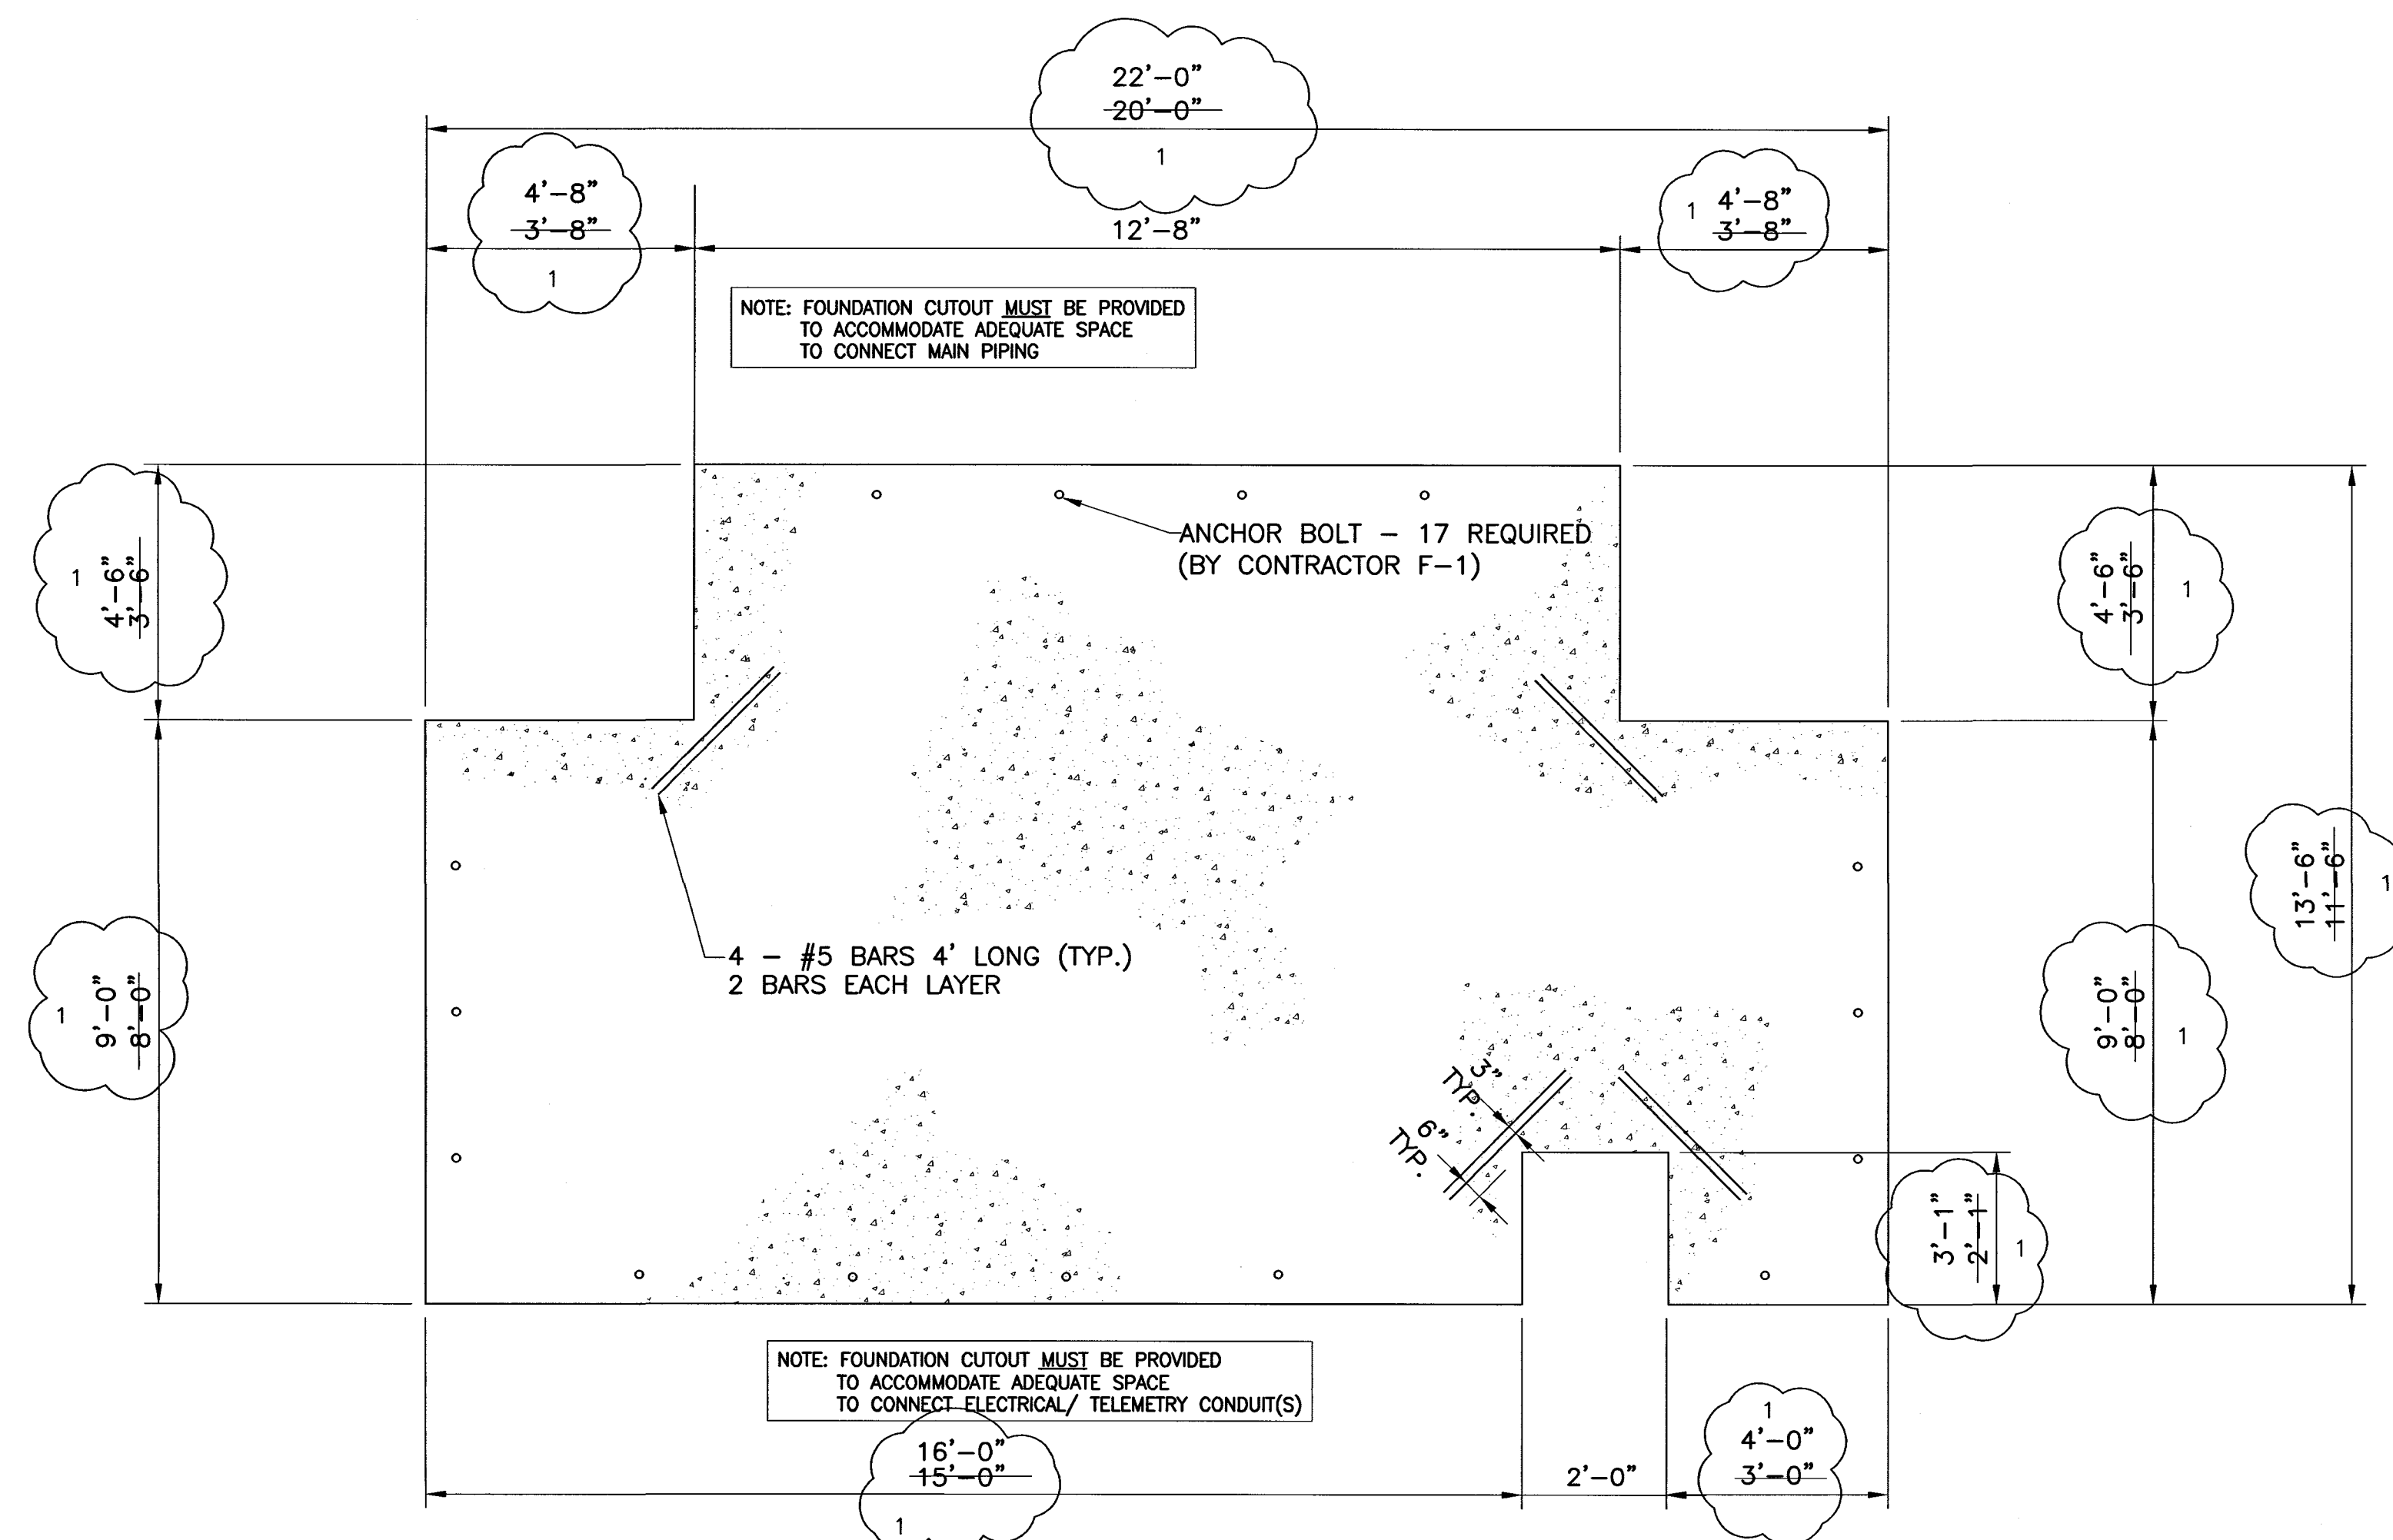

TYPICAL FOUNDATION LAYOUT

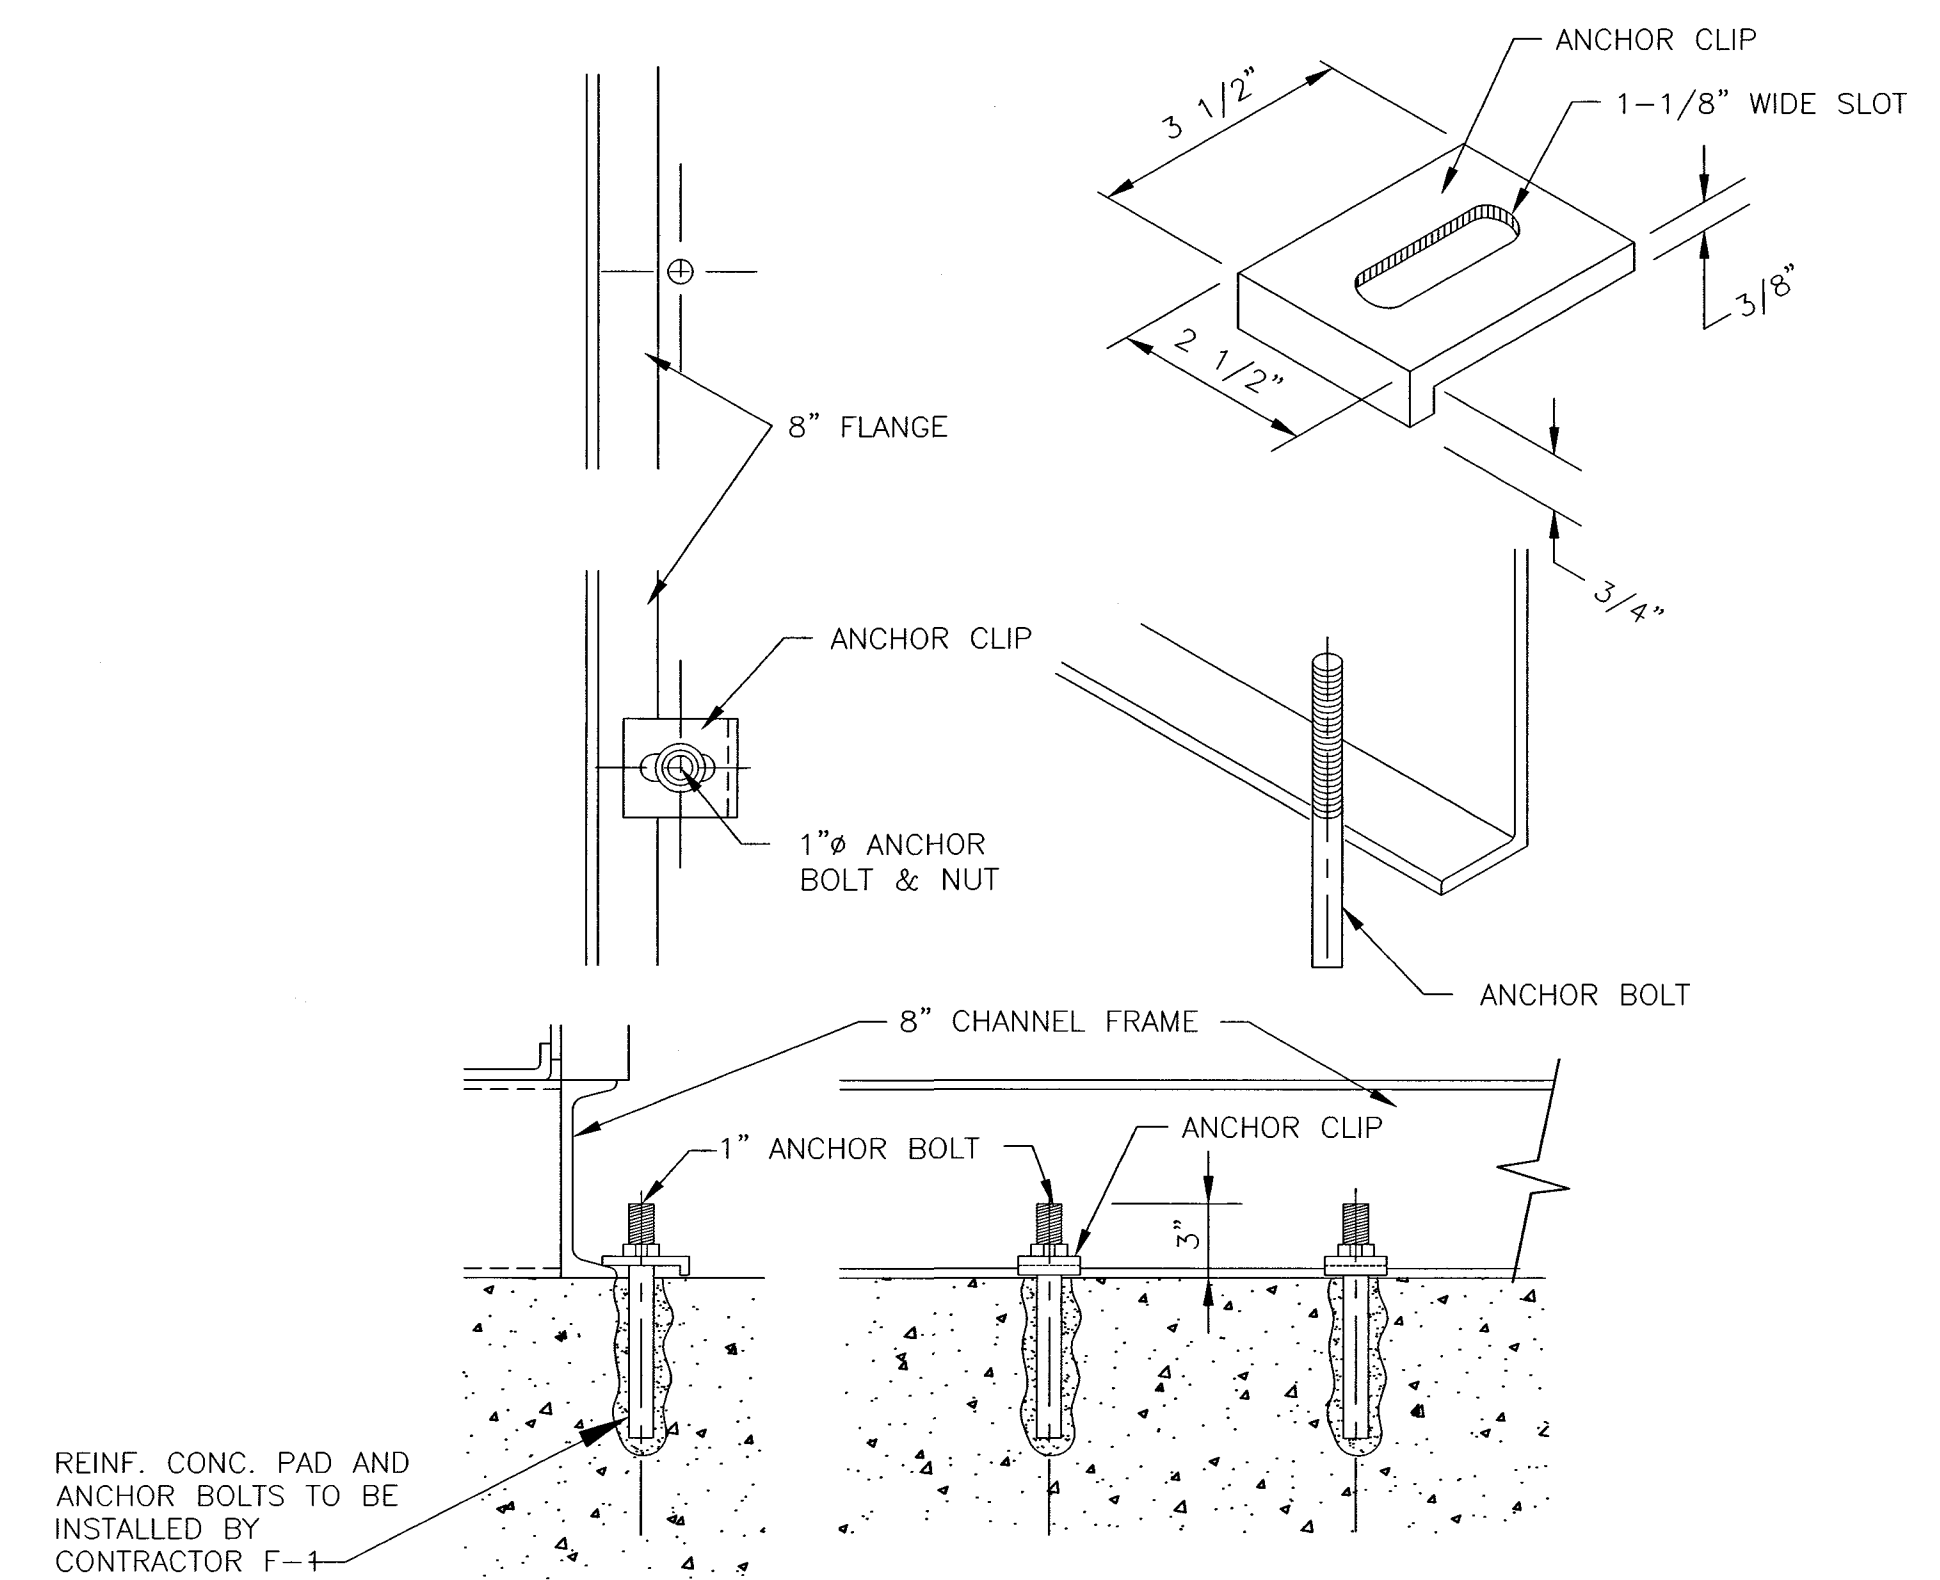

TYPICAL ANCHOR DETAIL

NOTE: ANCHOR CLIPS FURNISHED BY CONTRACTOR F-3
ANCHOR BOLTS AND NUTS FURNISHED AND
INSTALLED BY CONTRACTOR F-1

RECORD DRAWING

This drawing has been revised from the original contract drawings to show minor / major changes made during construction. This drawing is not warranted to be complete and accurate in all respects.

GRW Engineers, Inc.

Date: 5/2004 By: MSB

NOTES:


1. ALL PIPING AND EQUIPMENT WILL BE ADEQUATELY SUPPORTED AND BRACED.
2. DEHUMIDIFIER MUST BE POWERED UP AND TURNED ON IMMEDIATELY AFTER THIS STATION IS SET IN PLACE.
3. DO NOT SHIM STATION. IT IS INTENDED THAT THE MAIN FLOOR MEMBERS BE IN CONTINUOUS CONTACT WITH THE CONCRETE PAD.
4. ASTM REQUIREMENTS FOR STEEL ARE AS FOLLOWS: PLATE STEEL = ASTM A-36 AND STRUCTURAL STEEL = ASTM A-36.

LEGEND:

FCA - FLANGED COUPLING ADAPTER
RFA - RESTRAINED FLANGE ADAPTER
EPC - ELASTOMER PIPE CONNECTOR

NO.	DESCRIPTION	DATE	BY
1	AS-BUILT REVISIONS	5/2004	MSB
REVISIONS			

**HOOSIER HILLS REGIONAL
WATER DISTRICT**
DIVISION "F" WATERWORKS SYSTEM IMPROVEMENTS
CONTRACT F-1
PIERCEVILLE PUMP STATION FOUNDATION DETAILS
GRW PROJECT NO. 2745-04

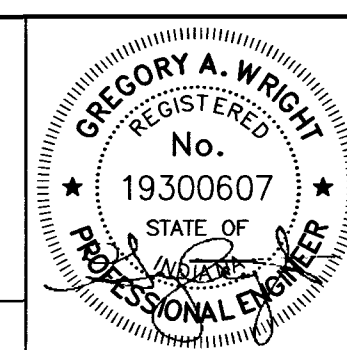

GRW Engineers, Inc.
Engineers, Architects, Planners
INDIANAPOLIS, INDIANA
LOUISVILLE & LEXINGTON, KENTUCKY
CINCINNATI, OHIO
NASHVILLE, TENNESSEE
ARLINGTON, TEXAS

DRAWN: BJD	DATE: JULY 2002
FILE NAME: SHEET545-F1.DWG	SCALE: 1/2"=1'-0"
CHECKED:	SHEET NO.
APPROVED:	545