




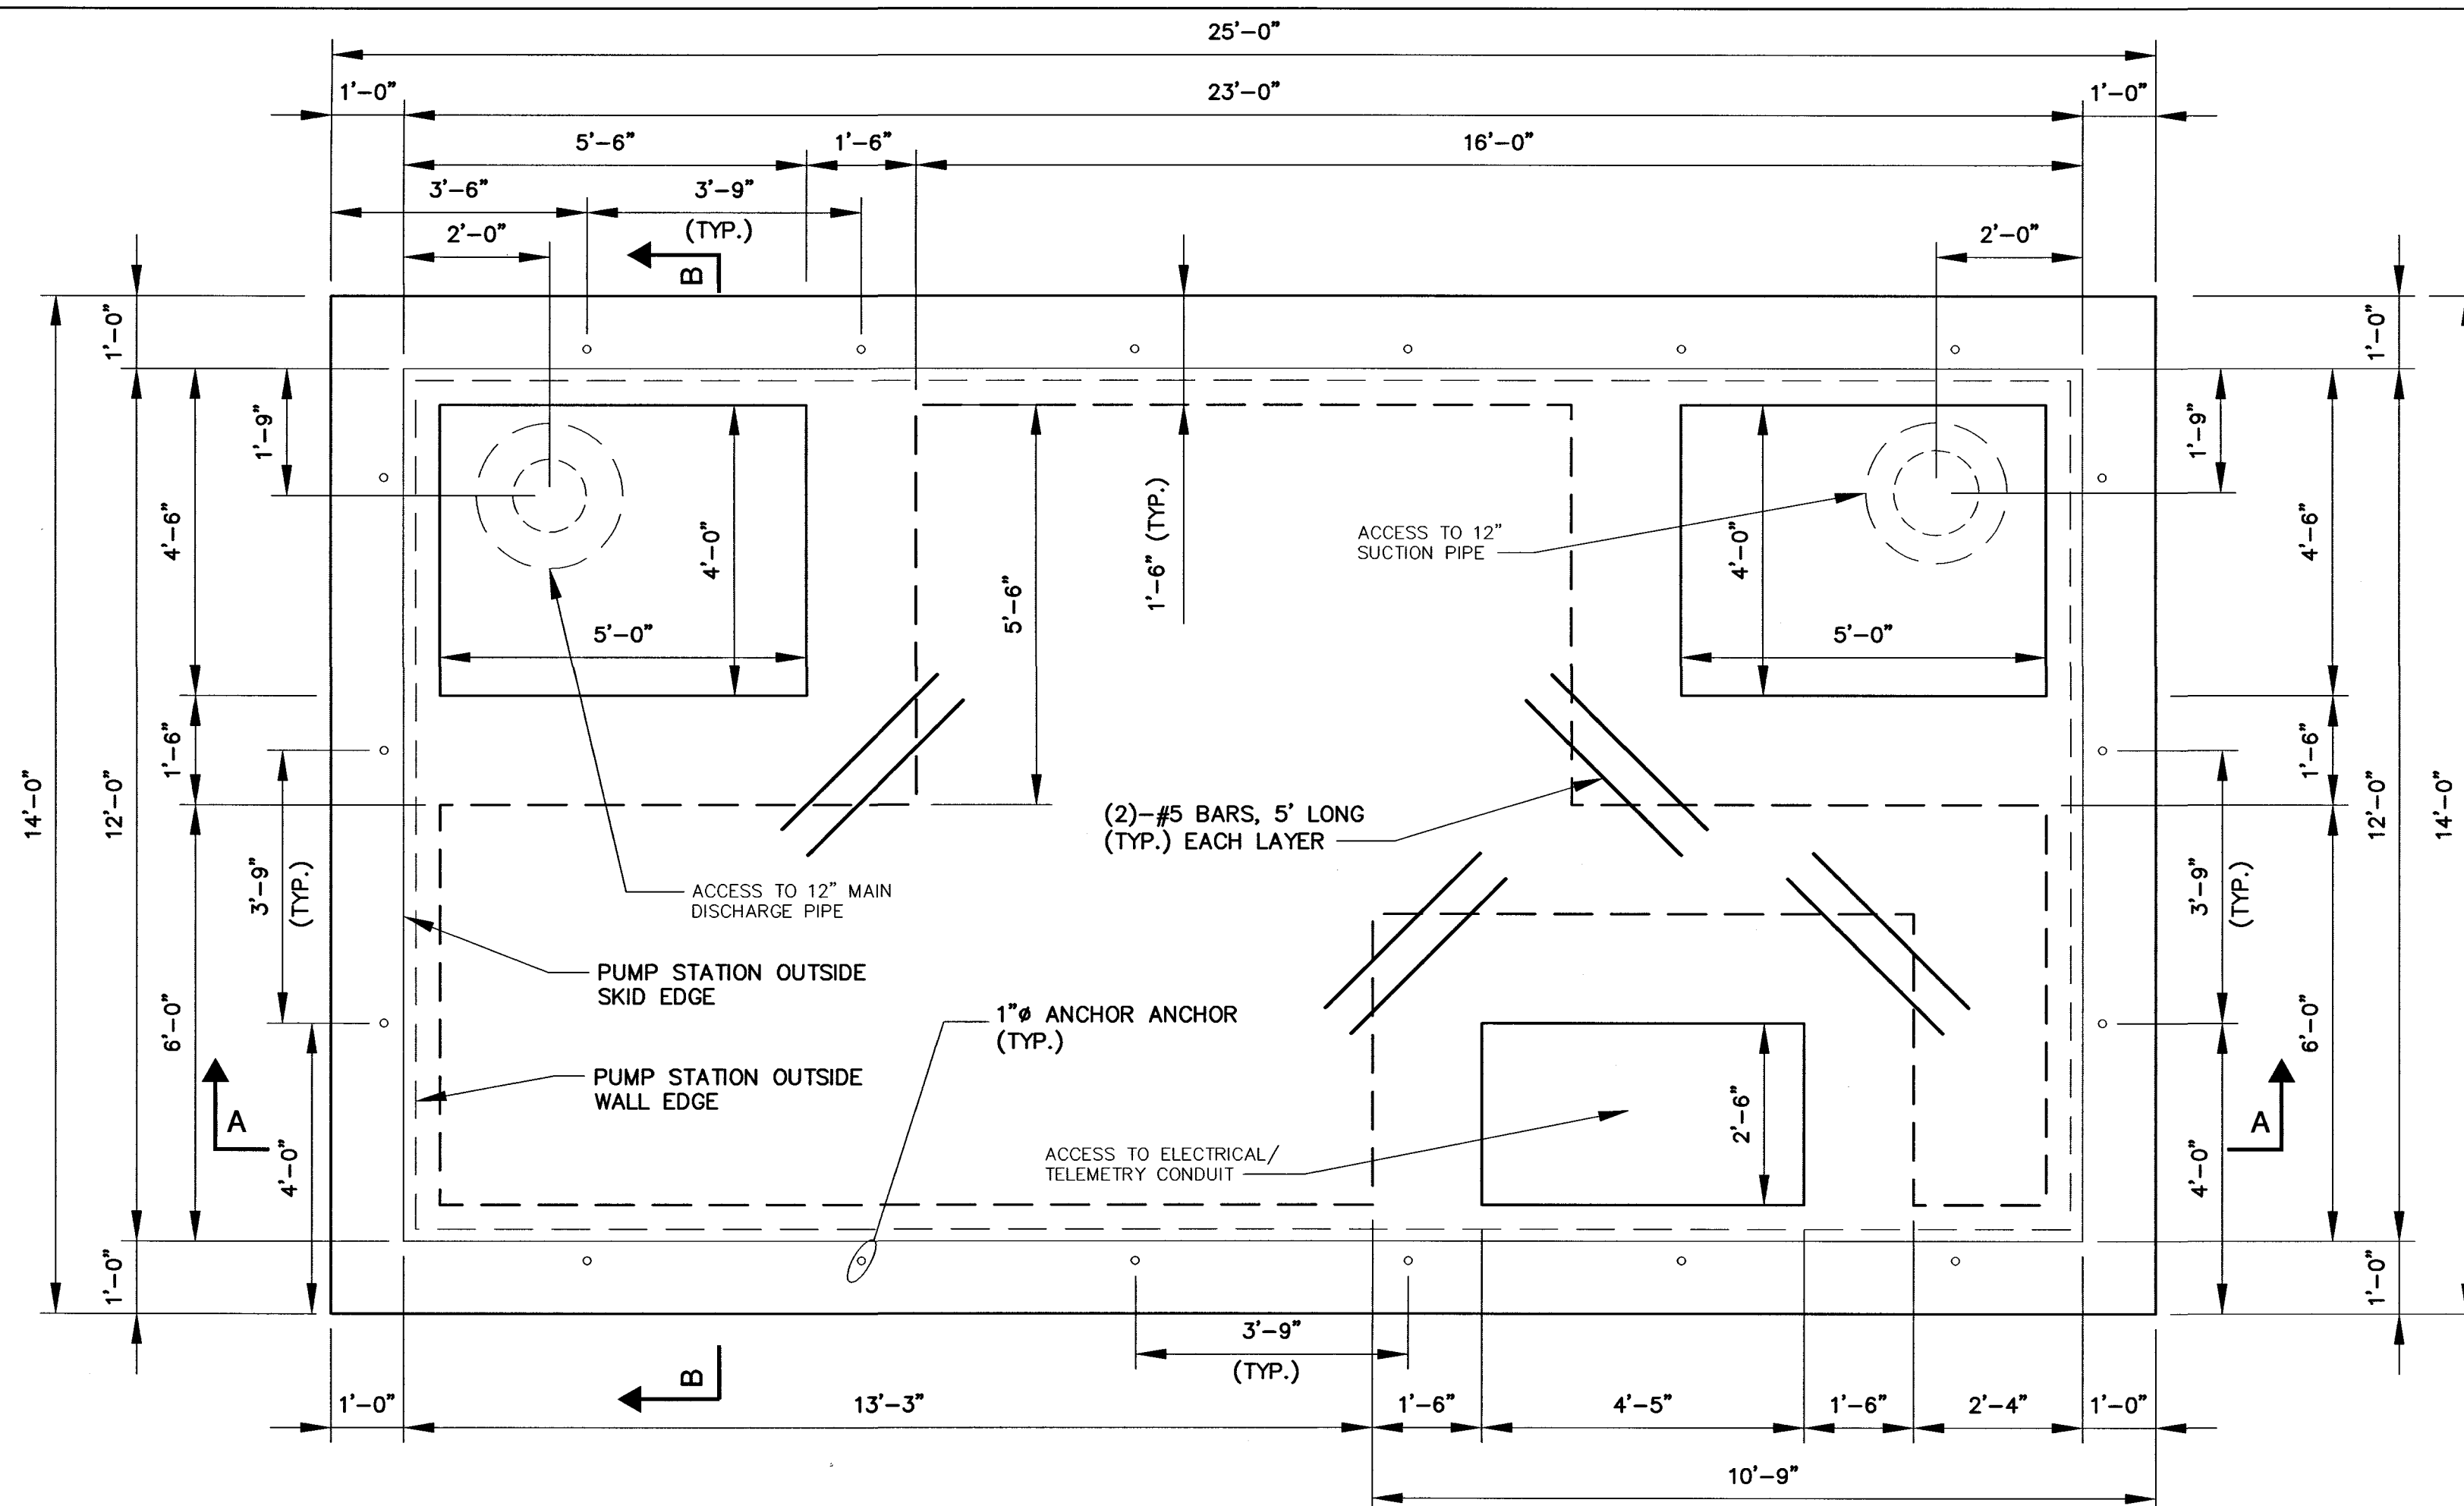


TYPICAL FOUNDATION LAYOUT
SCALE: AS SHOWN

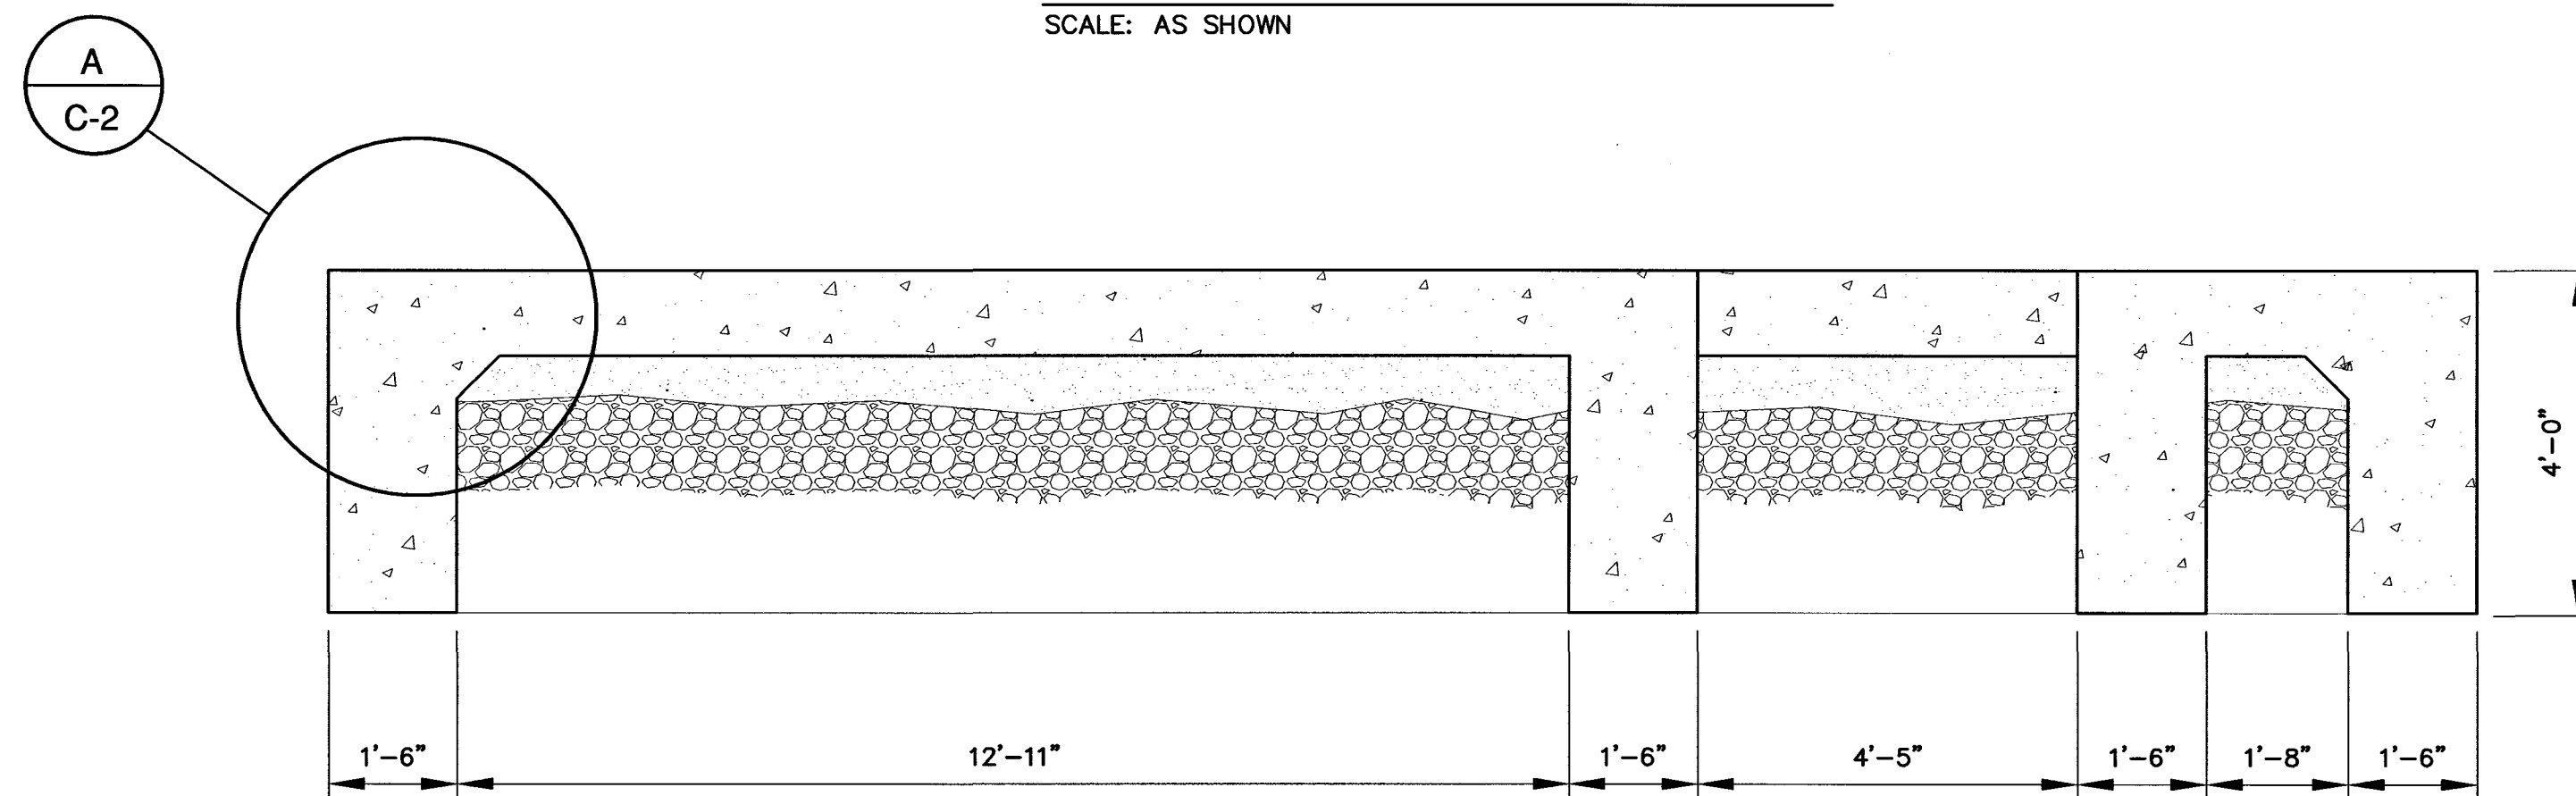


SECTION A-A
SCALE: AS SHOWN

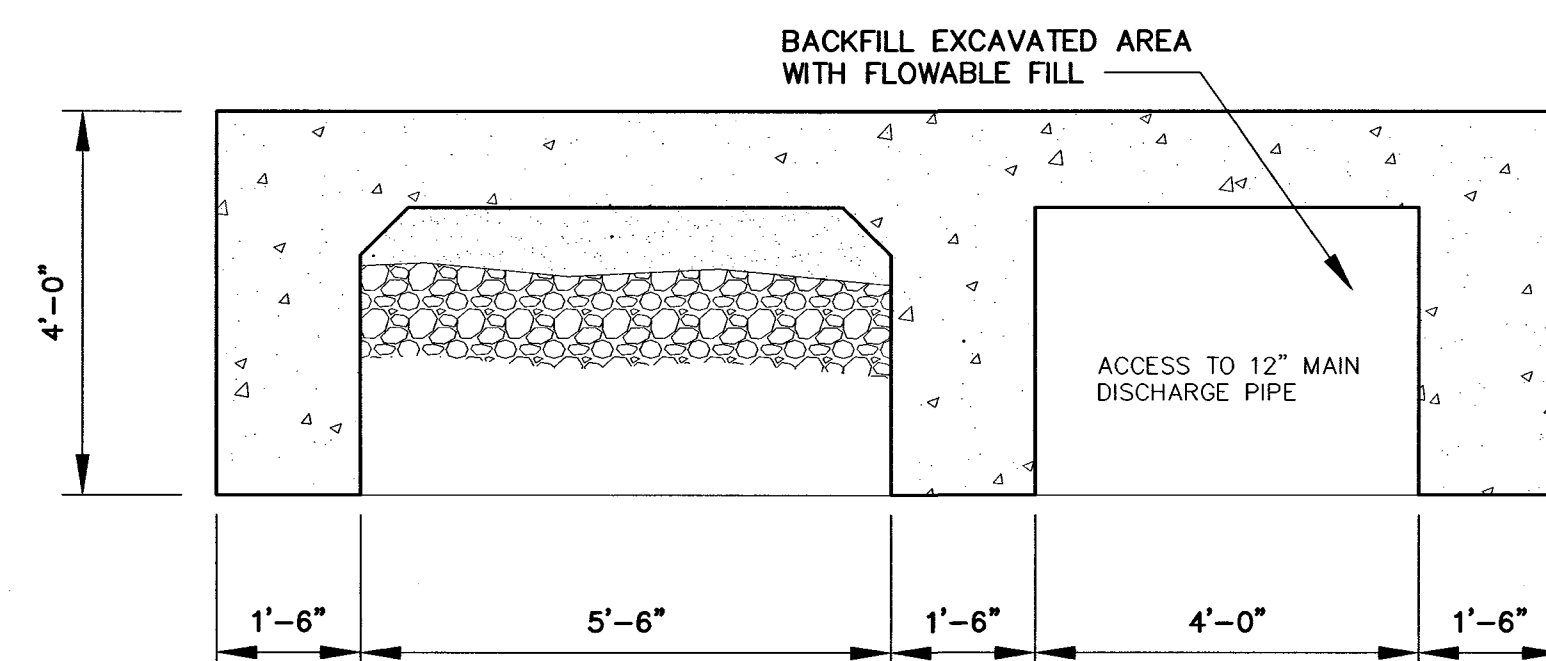


SECTION B-B
SCALE: AS SHOWN

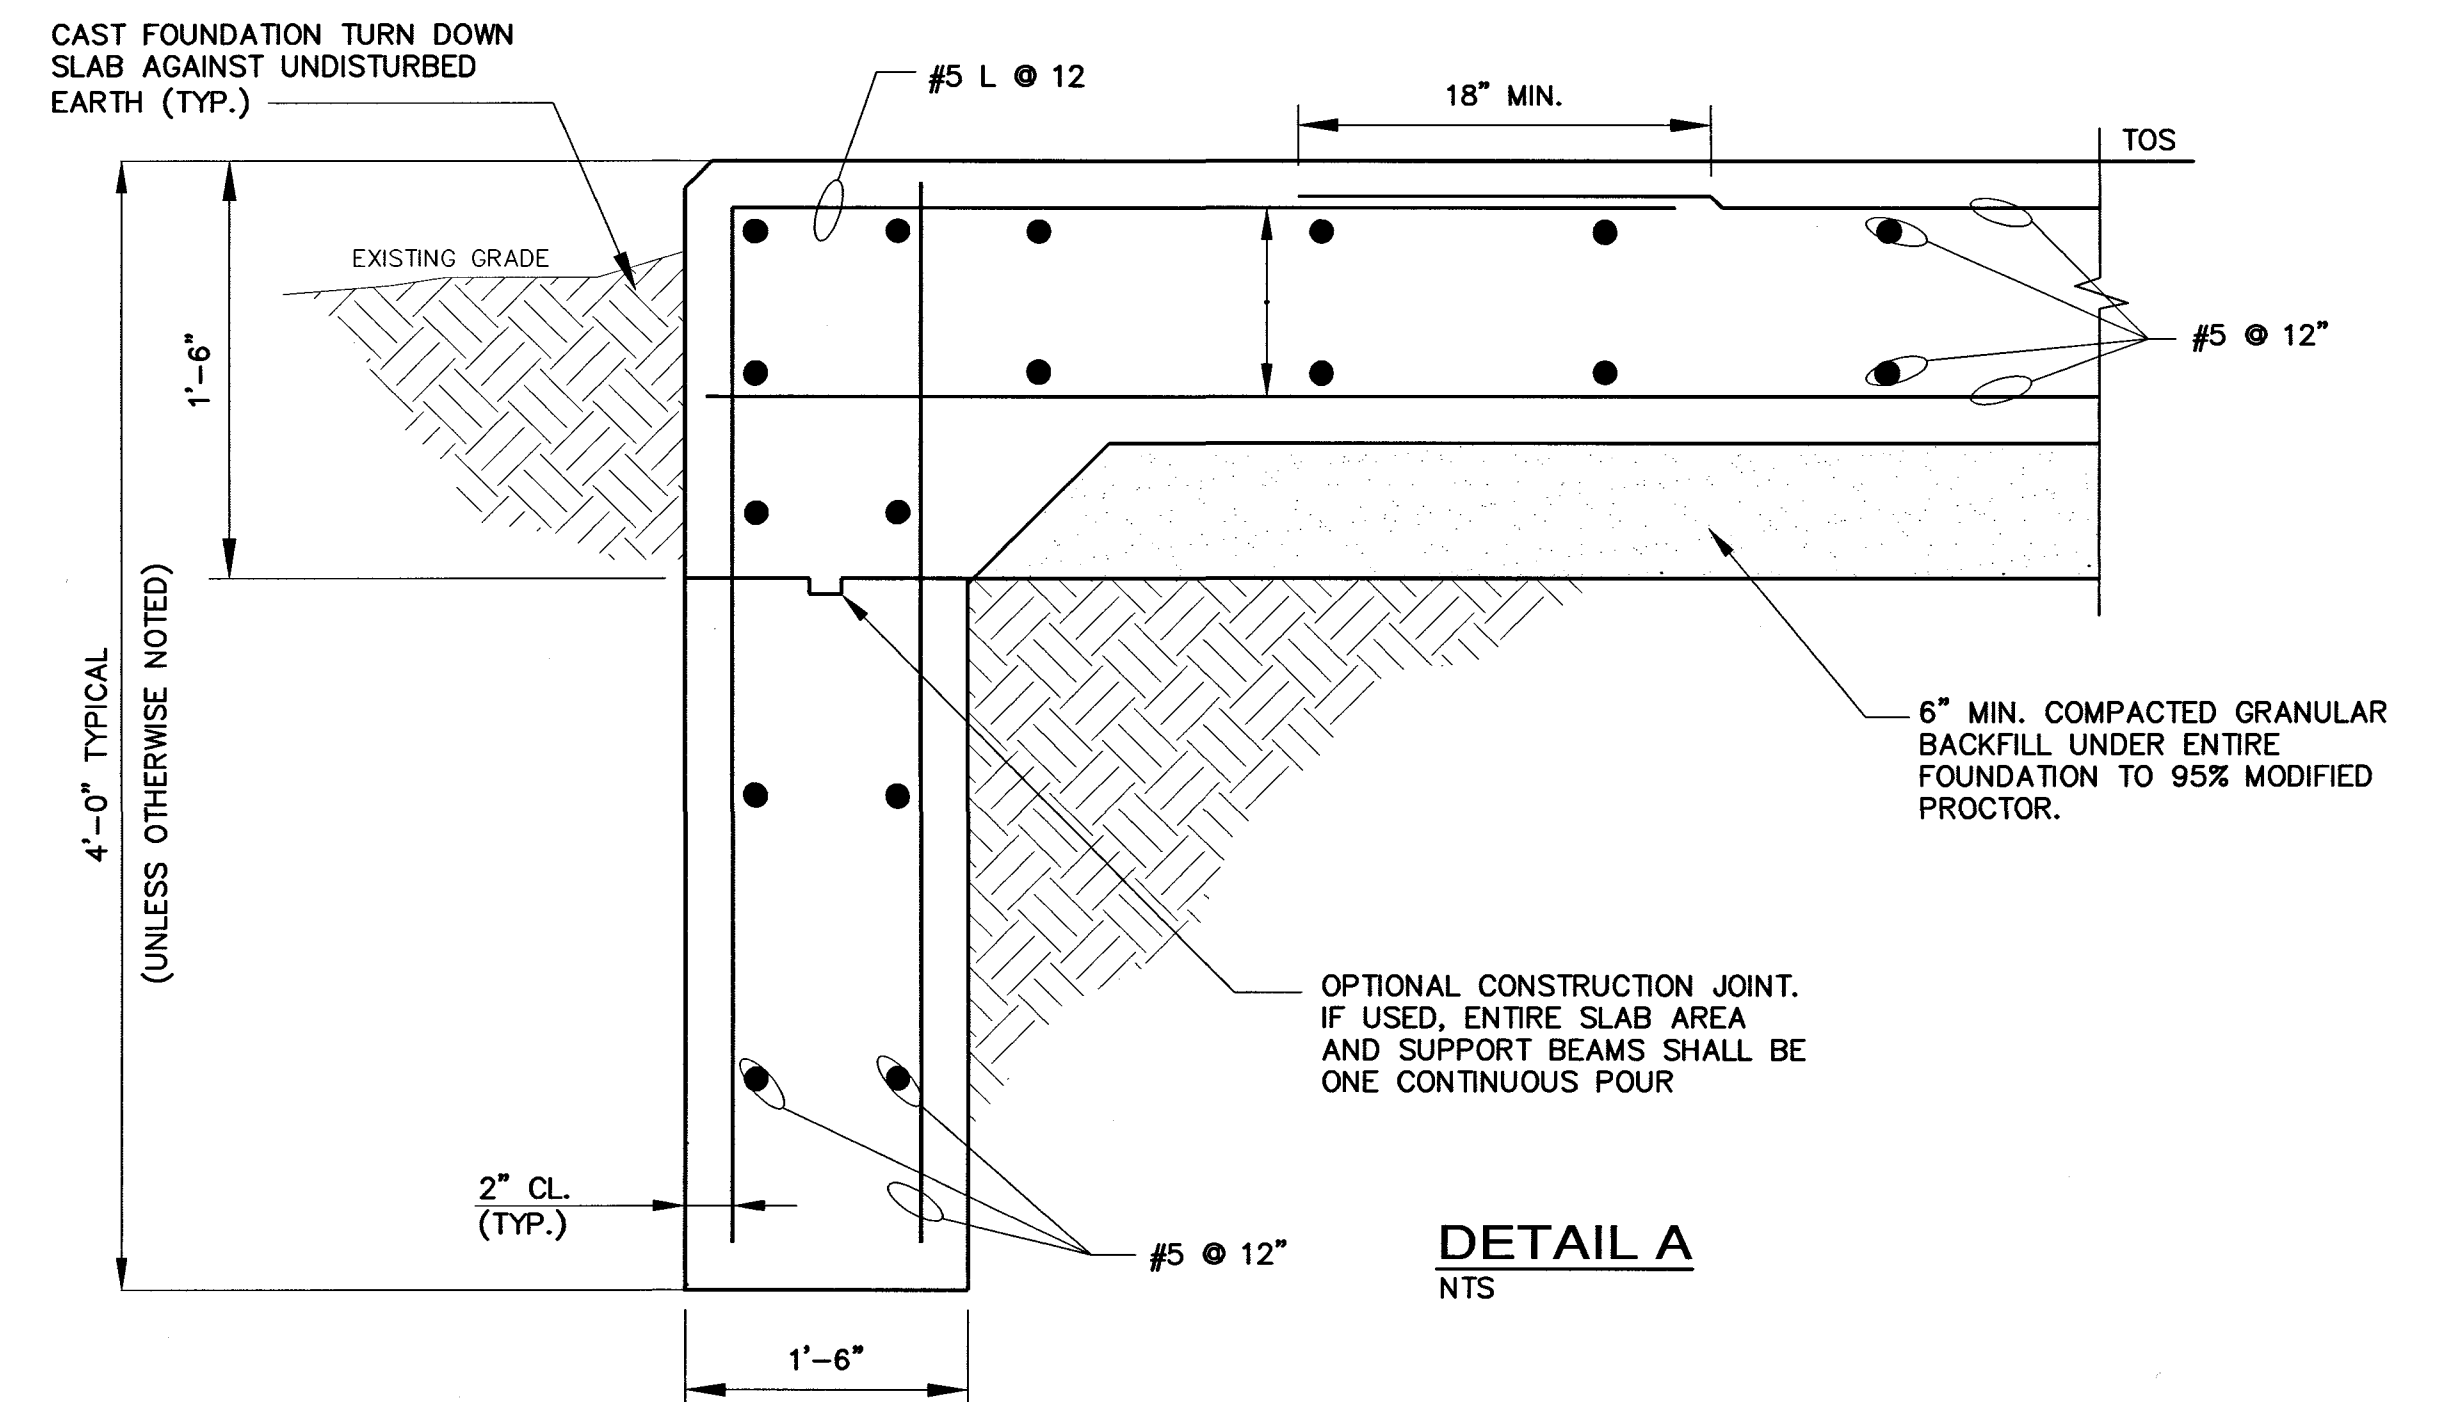

DETAIL A
NTS

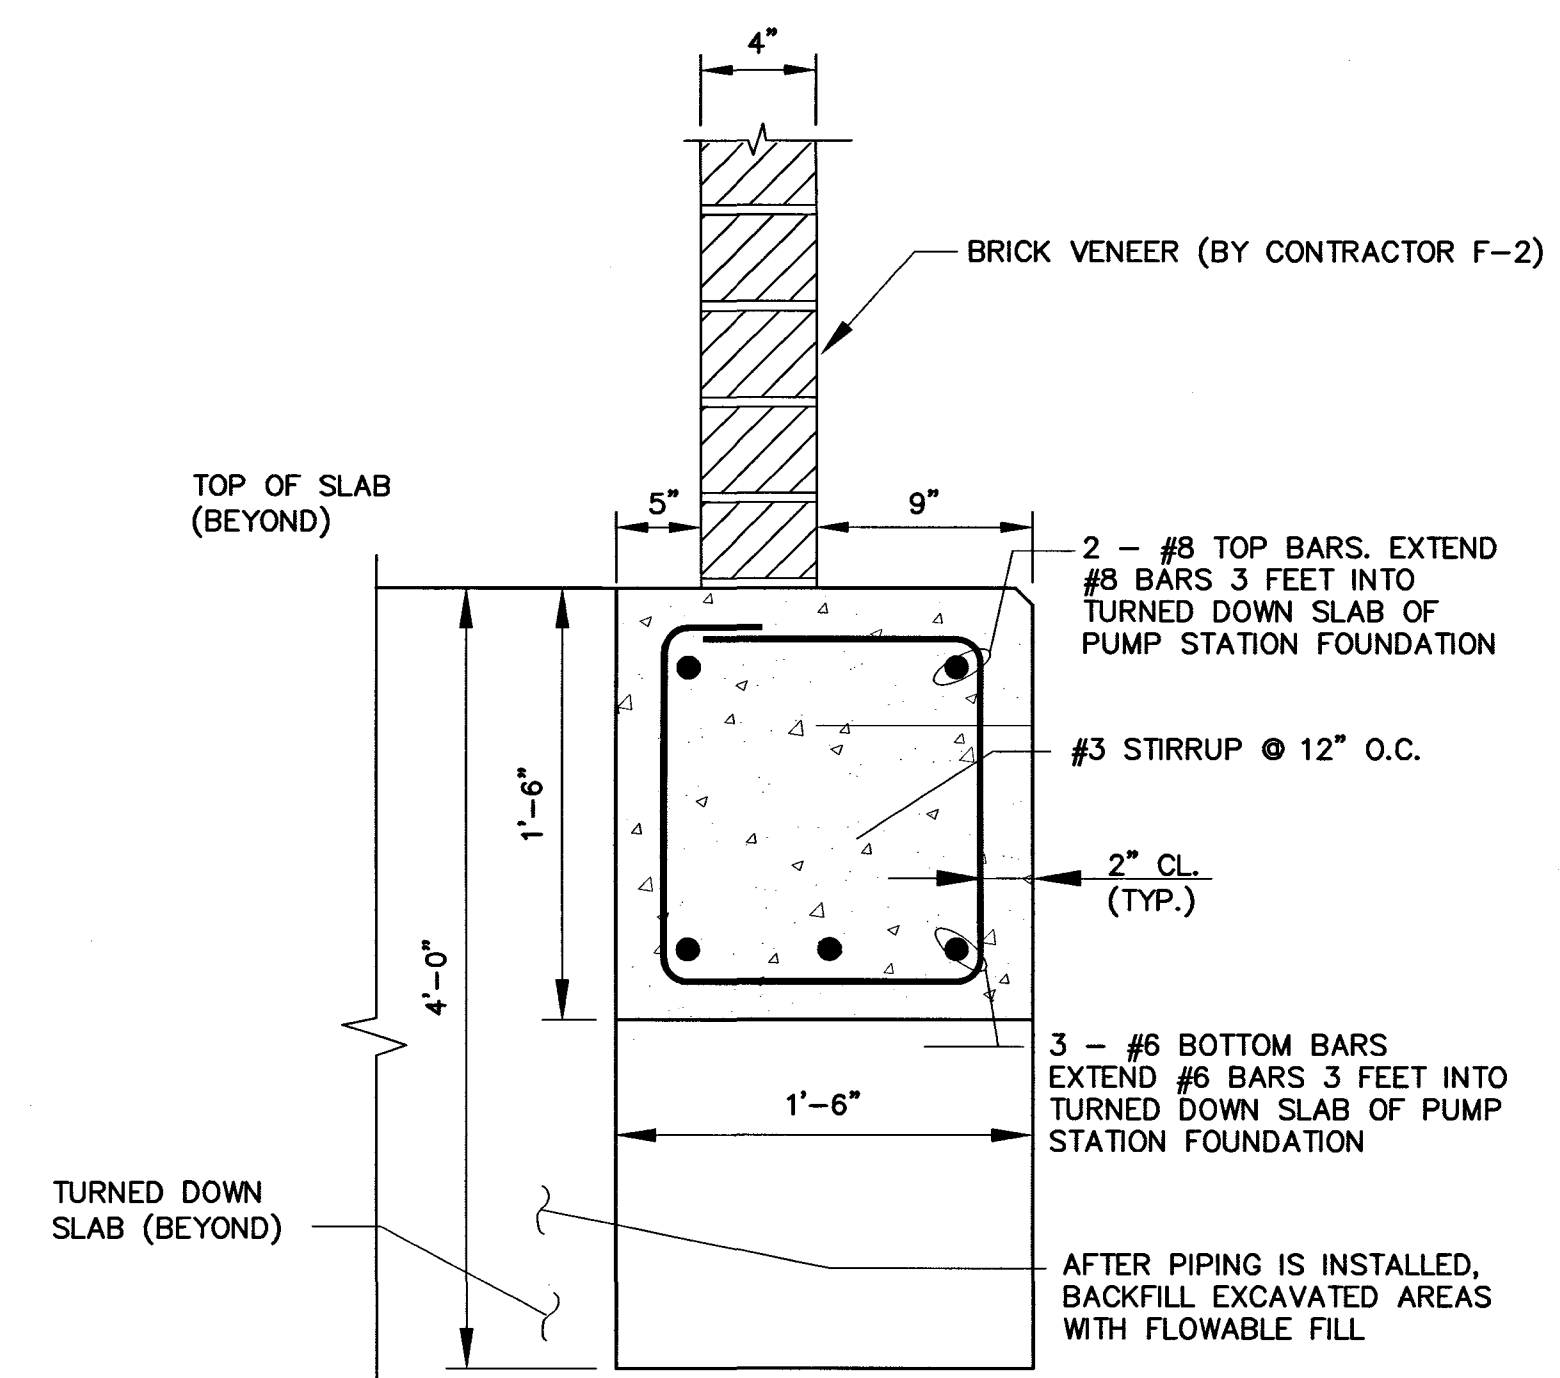

DETAIL B
NTS

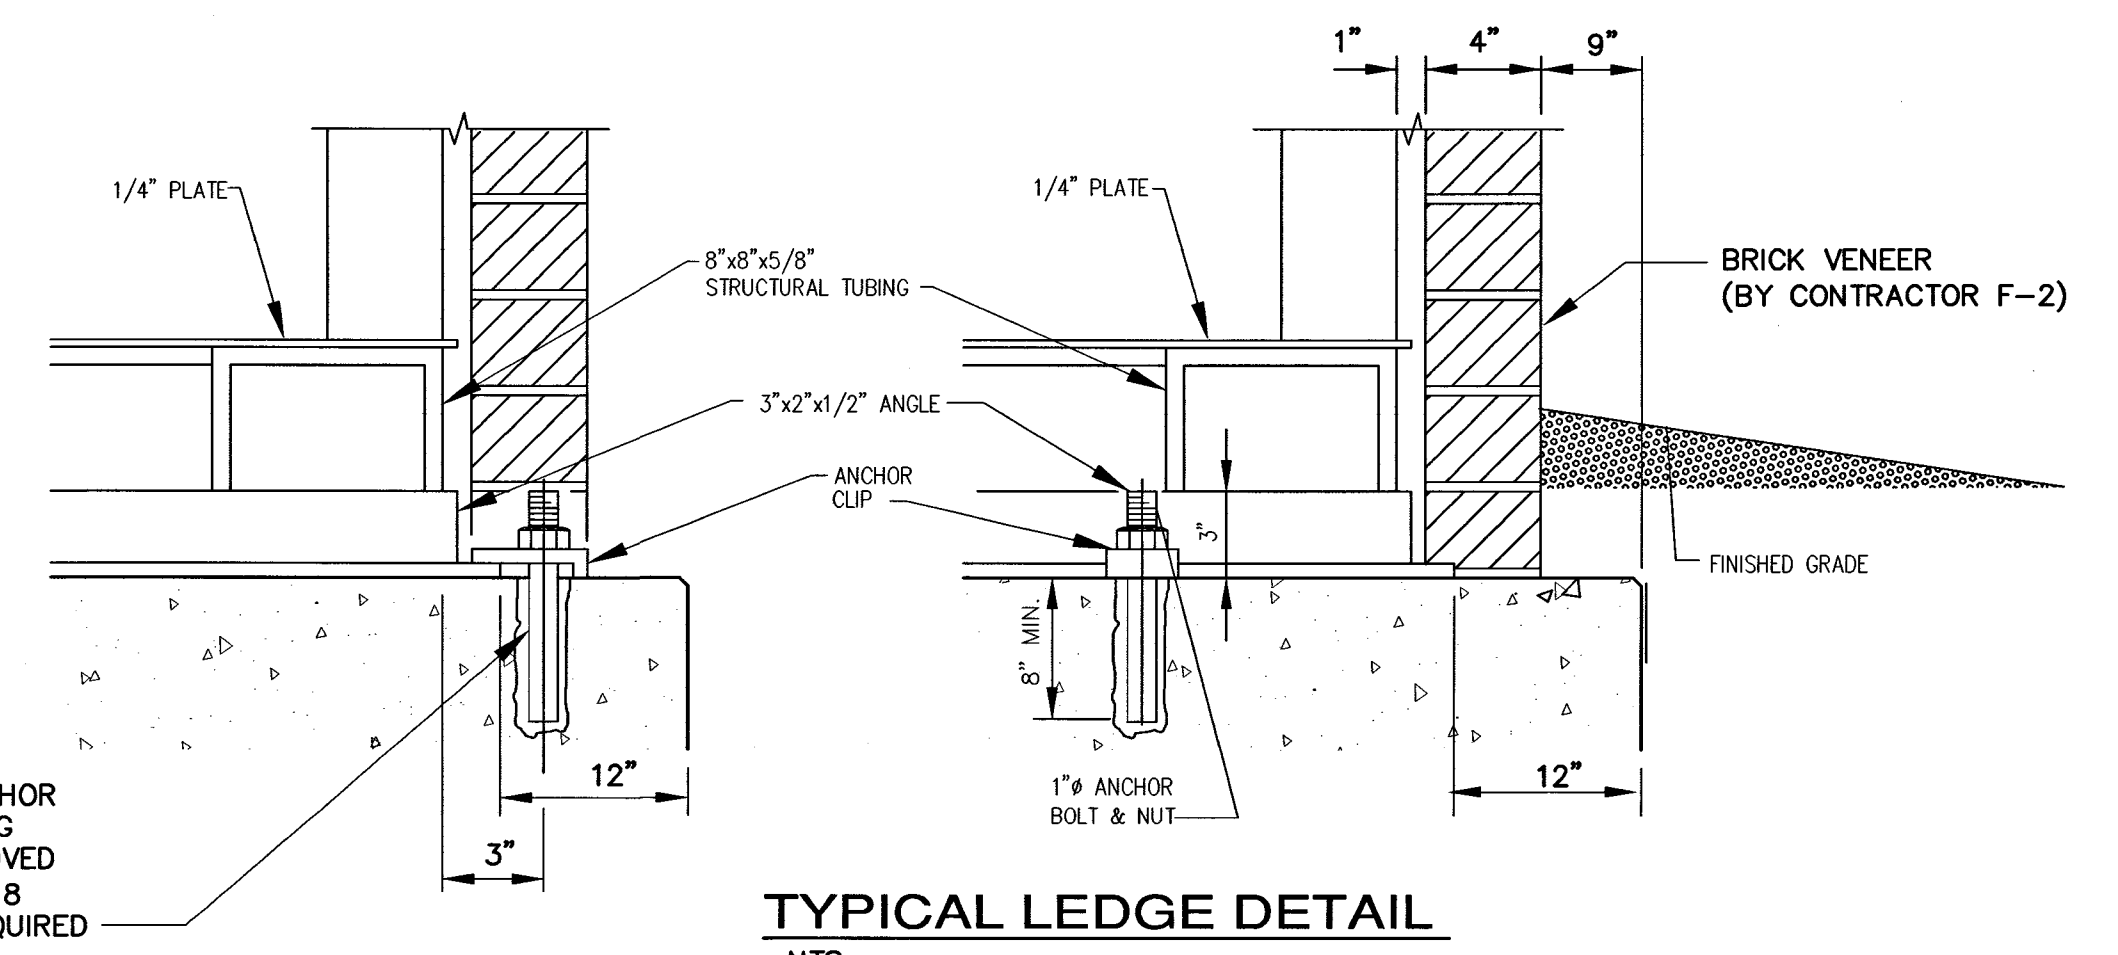

TYPICAL LEDGE DETAIL
NTS

RECORD DRAWING
This drawing has been reviewed from the original contract drawings to show minor/major changes made during construction. This drawing is not warranted to be complete and accurate in all respects.
GRW Engineers, Inc.
Date: 5/2004 By: MSB

NOTES:


1. UNLESS OPTIONAL CONSTRUCTION JOINT IS USED, THE ENTIRE FOUNDATION SHALL BE POURED IN ONE CONTINUOUS POUR (TURN DOWN SLAB, FOUNDATION PAD AND BEAMS.) CONCRETE STRENGTH SHALL BE HIGH-EARLY 4000 PSI.
2. FOUNDATION DRAINS AND ELECTRICAL CONDUITS SHALL BE INSTALLED PRIOR TO POURING CONCRETE FOUNDATION. BACKFILL PER NOTE 4.
3. WATER MAINS WITHIN FOUNDATION FOOTPRINT SHALL NOT BE INSTALLED UNTIL DETAIL "B" SUPPORT BEAM HAS BEEN CONSTRUCTED.
4. ALL DISTURBED AREA & EXCAVATIONS FROM SITE DEMOLITION SHALL BE BACKFILLED WITH COMPACTED GRANULAR BACKFILL INDOT #53 STONE IN 8" LIFTS TO 95% MODIFIED PROCTOR.

NOTES:

NO.	DESCRIPTION	DATE	BY
1	AS-BUILT	5/2004	MSB
REVISIONS			

**HOOSIER HILLS REGIONAL
WATER DISTRICT**
DIVISION "F" WATERWORKS SYSTEM IMPROVEMENTS
DELETION OF OSGOOD SUPPLY
SPADES ROAD PUMP STATION PLAN

GRW PROJECT NO. 2745

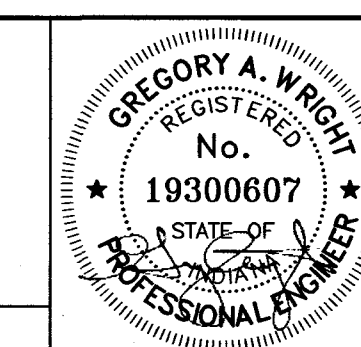

GRW Engineers, Inc.
Engineers, Architects, Planners
INDIANAPOLIS, INDIANA
LOUISVILLE & LEXINGTON, KENTUCKY
CINCINNATI, OHIO
NASHVILLE, TENNESSEE
ARLINGTON, TEXAS

DRAWN: GCR	DATE: MAY 2003
FILE NAME: SHEET 603.dwg	SCALE: 1/2"=1'
CHECKED:	SHEET NO.
APPROVED:	603