

NOTES:

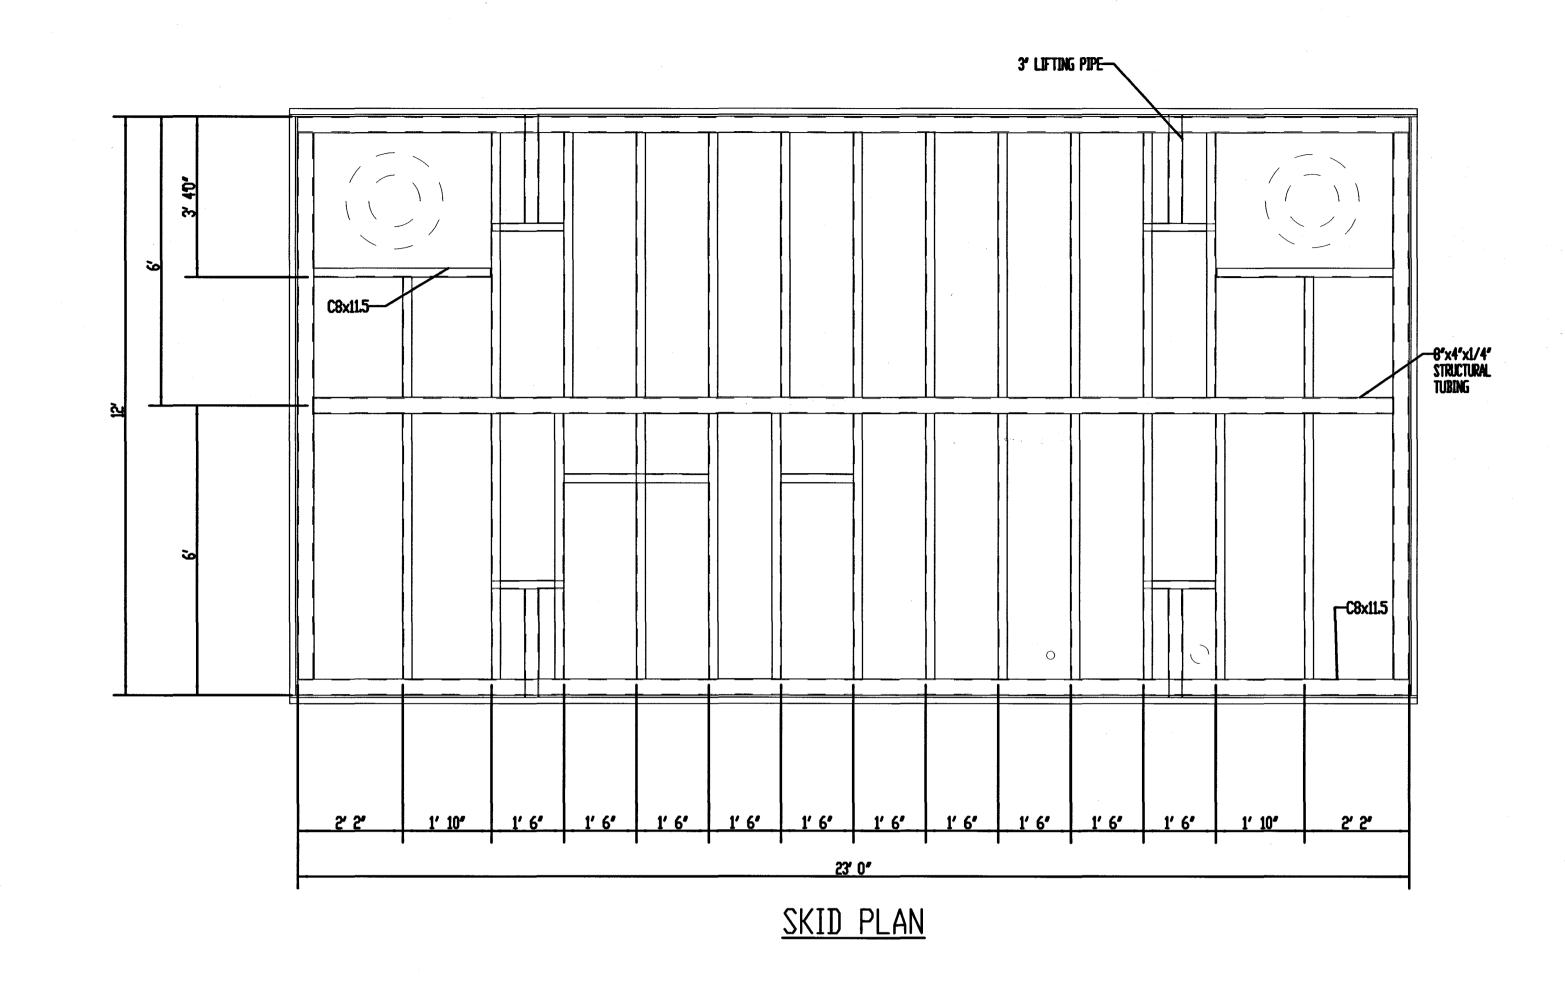


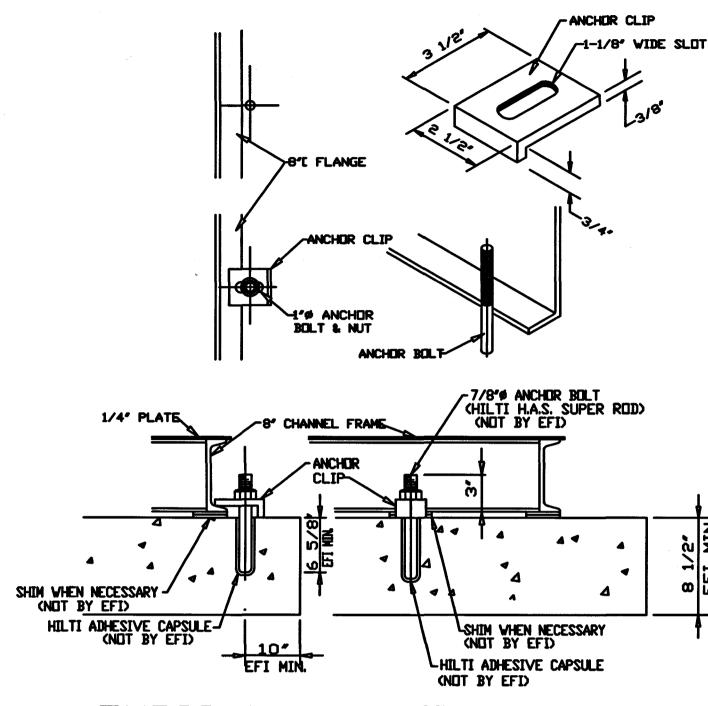

TYPICAL ANCHOR DETAIL

NOTE: ANCHOR CLIPS FURNISHED BY E.F. I .
ANCHOR BOLTS AND NUTS BY INSTALLER
FOUNDATION AND ANCHOR BOLT DESIGN AND DIMENSIONS
AS DIRECTED BY ENGINEER

SHIMS MAY BE REQUIRED AROUND PERIMETER
OF WATERSHED TO ENSURE PROPER LEVEL
WITHOUT PROPER LEVEL ENGINEERED FLUID
CANNOT BE RESPONSIBLE FOR PROPER DOOR OPERATION.

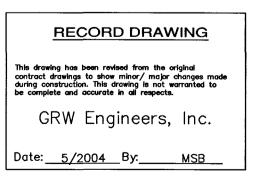

HOOS

V
DIVISION "F" WATER

1 AS-BUILT 5/2004 MSB DELETE

NO. DESCRIPTION DATE BY SPADES

REVISIONS GRW PROJECT NO. 2745

HOOSIER HILLS REGIONAL
WATER DISTRICT
SION "F" WATERWORKS SYSTEM IMPROVEME

DIVISION "F" WATERWORKS SYSTEM IMPROVEMENTS
DELETION OF OSGOOD SUPPLY
SPADES ROAD PUMP STATION PLAN



GRW Engineers, Inc.
Engineers, Architects, Planners
INDIANAPOLIS, INDIANA
LOUISVILLE & LEXINGTON, KENTUCKY
CINCINNATI, OHIO
NASHVILLE, TENNESSEE
ARLINGTON, TEXAS

	DRAWN: GCR	DATE: MAY 2003
nc. ers	FILE NAME: Sht.604.dwg	SCALE: 1/2"=1'
	CHECKED:	SHEET NO.
Y	APPROVED:	1 604