



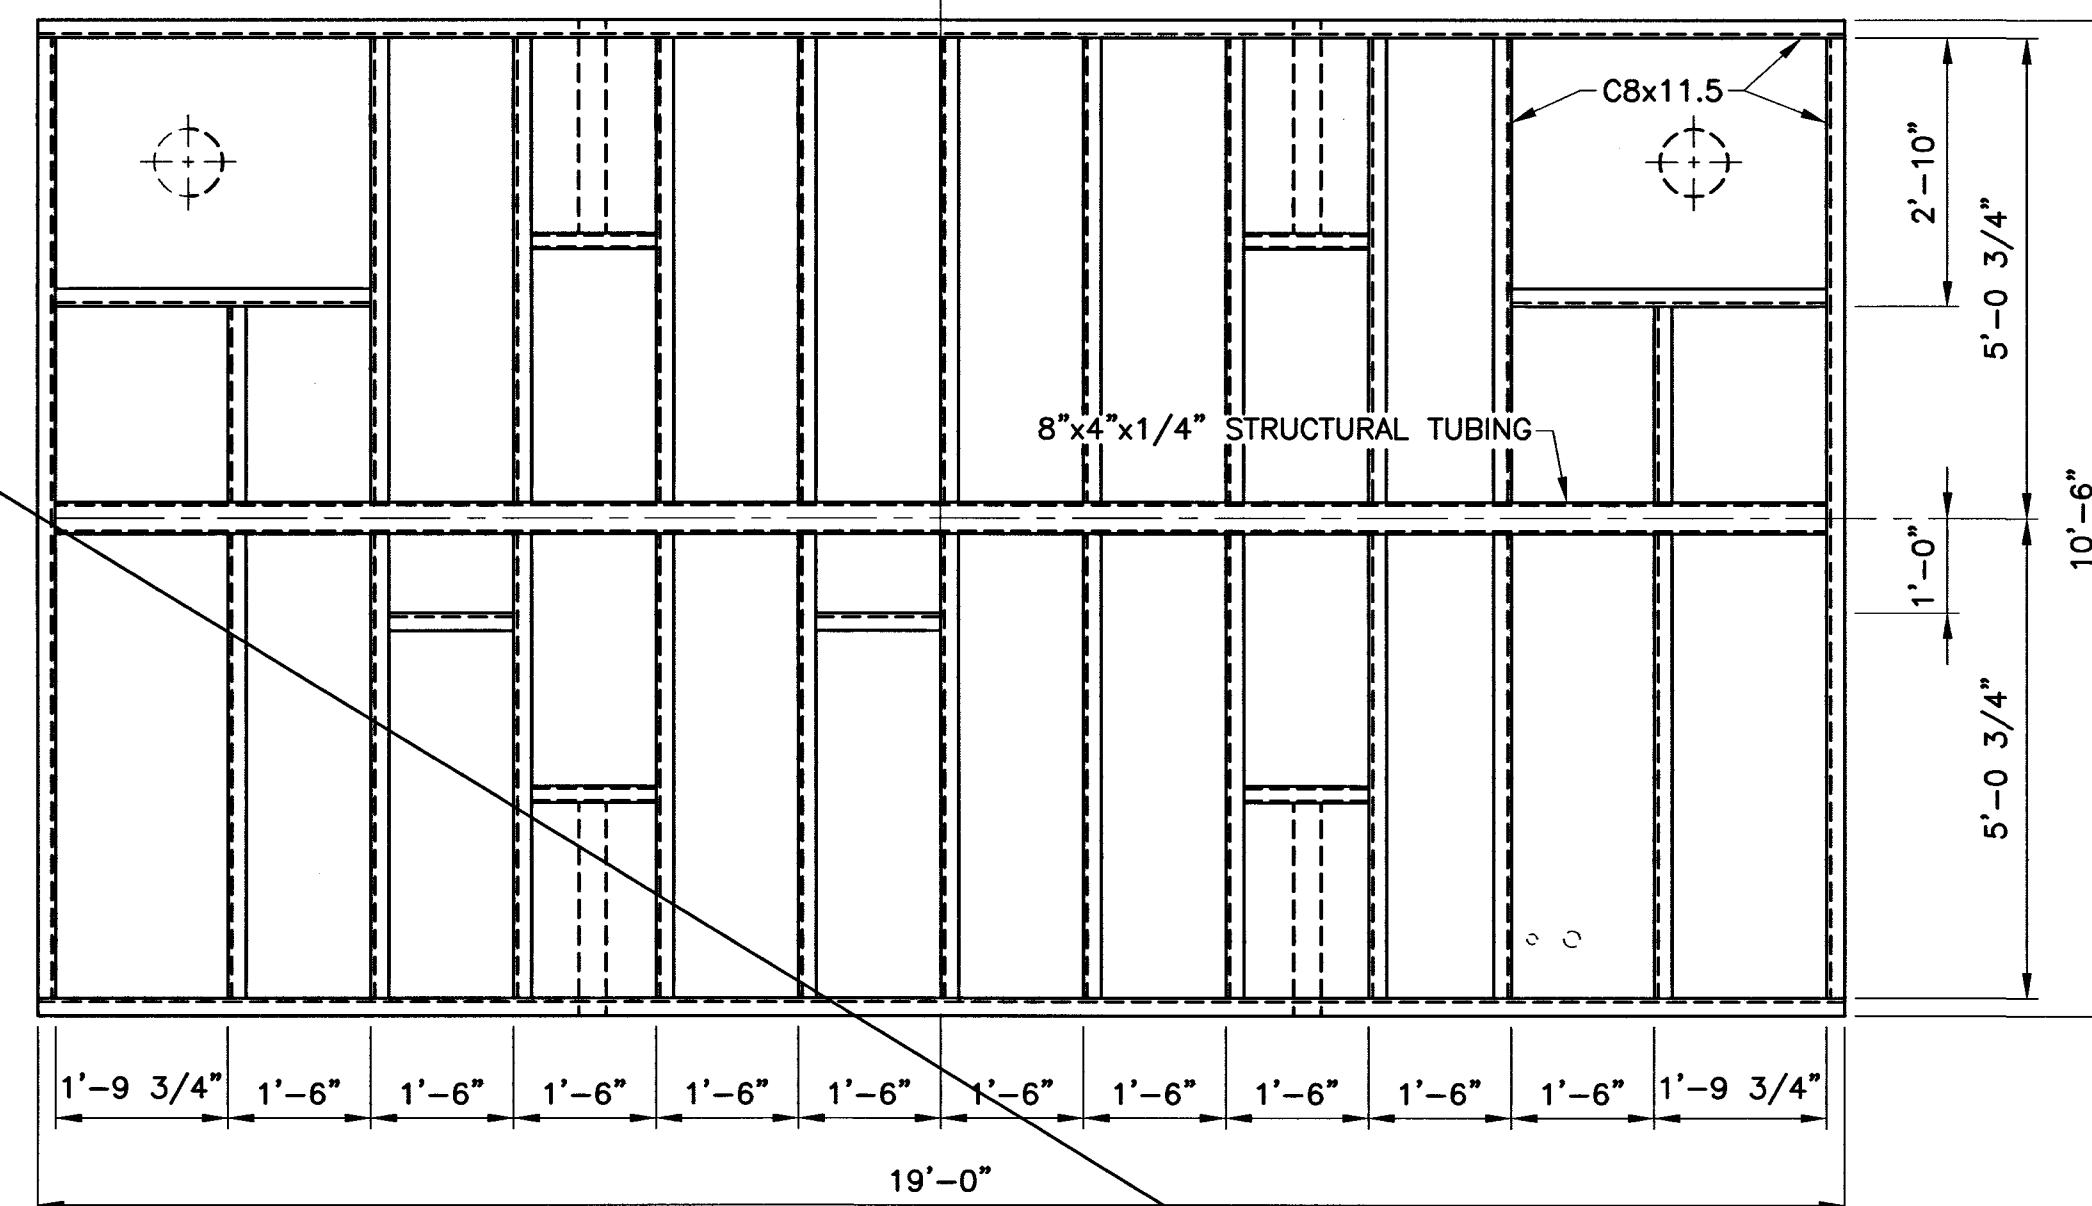


SKID PLAN

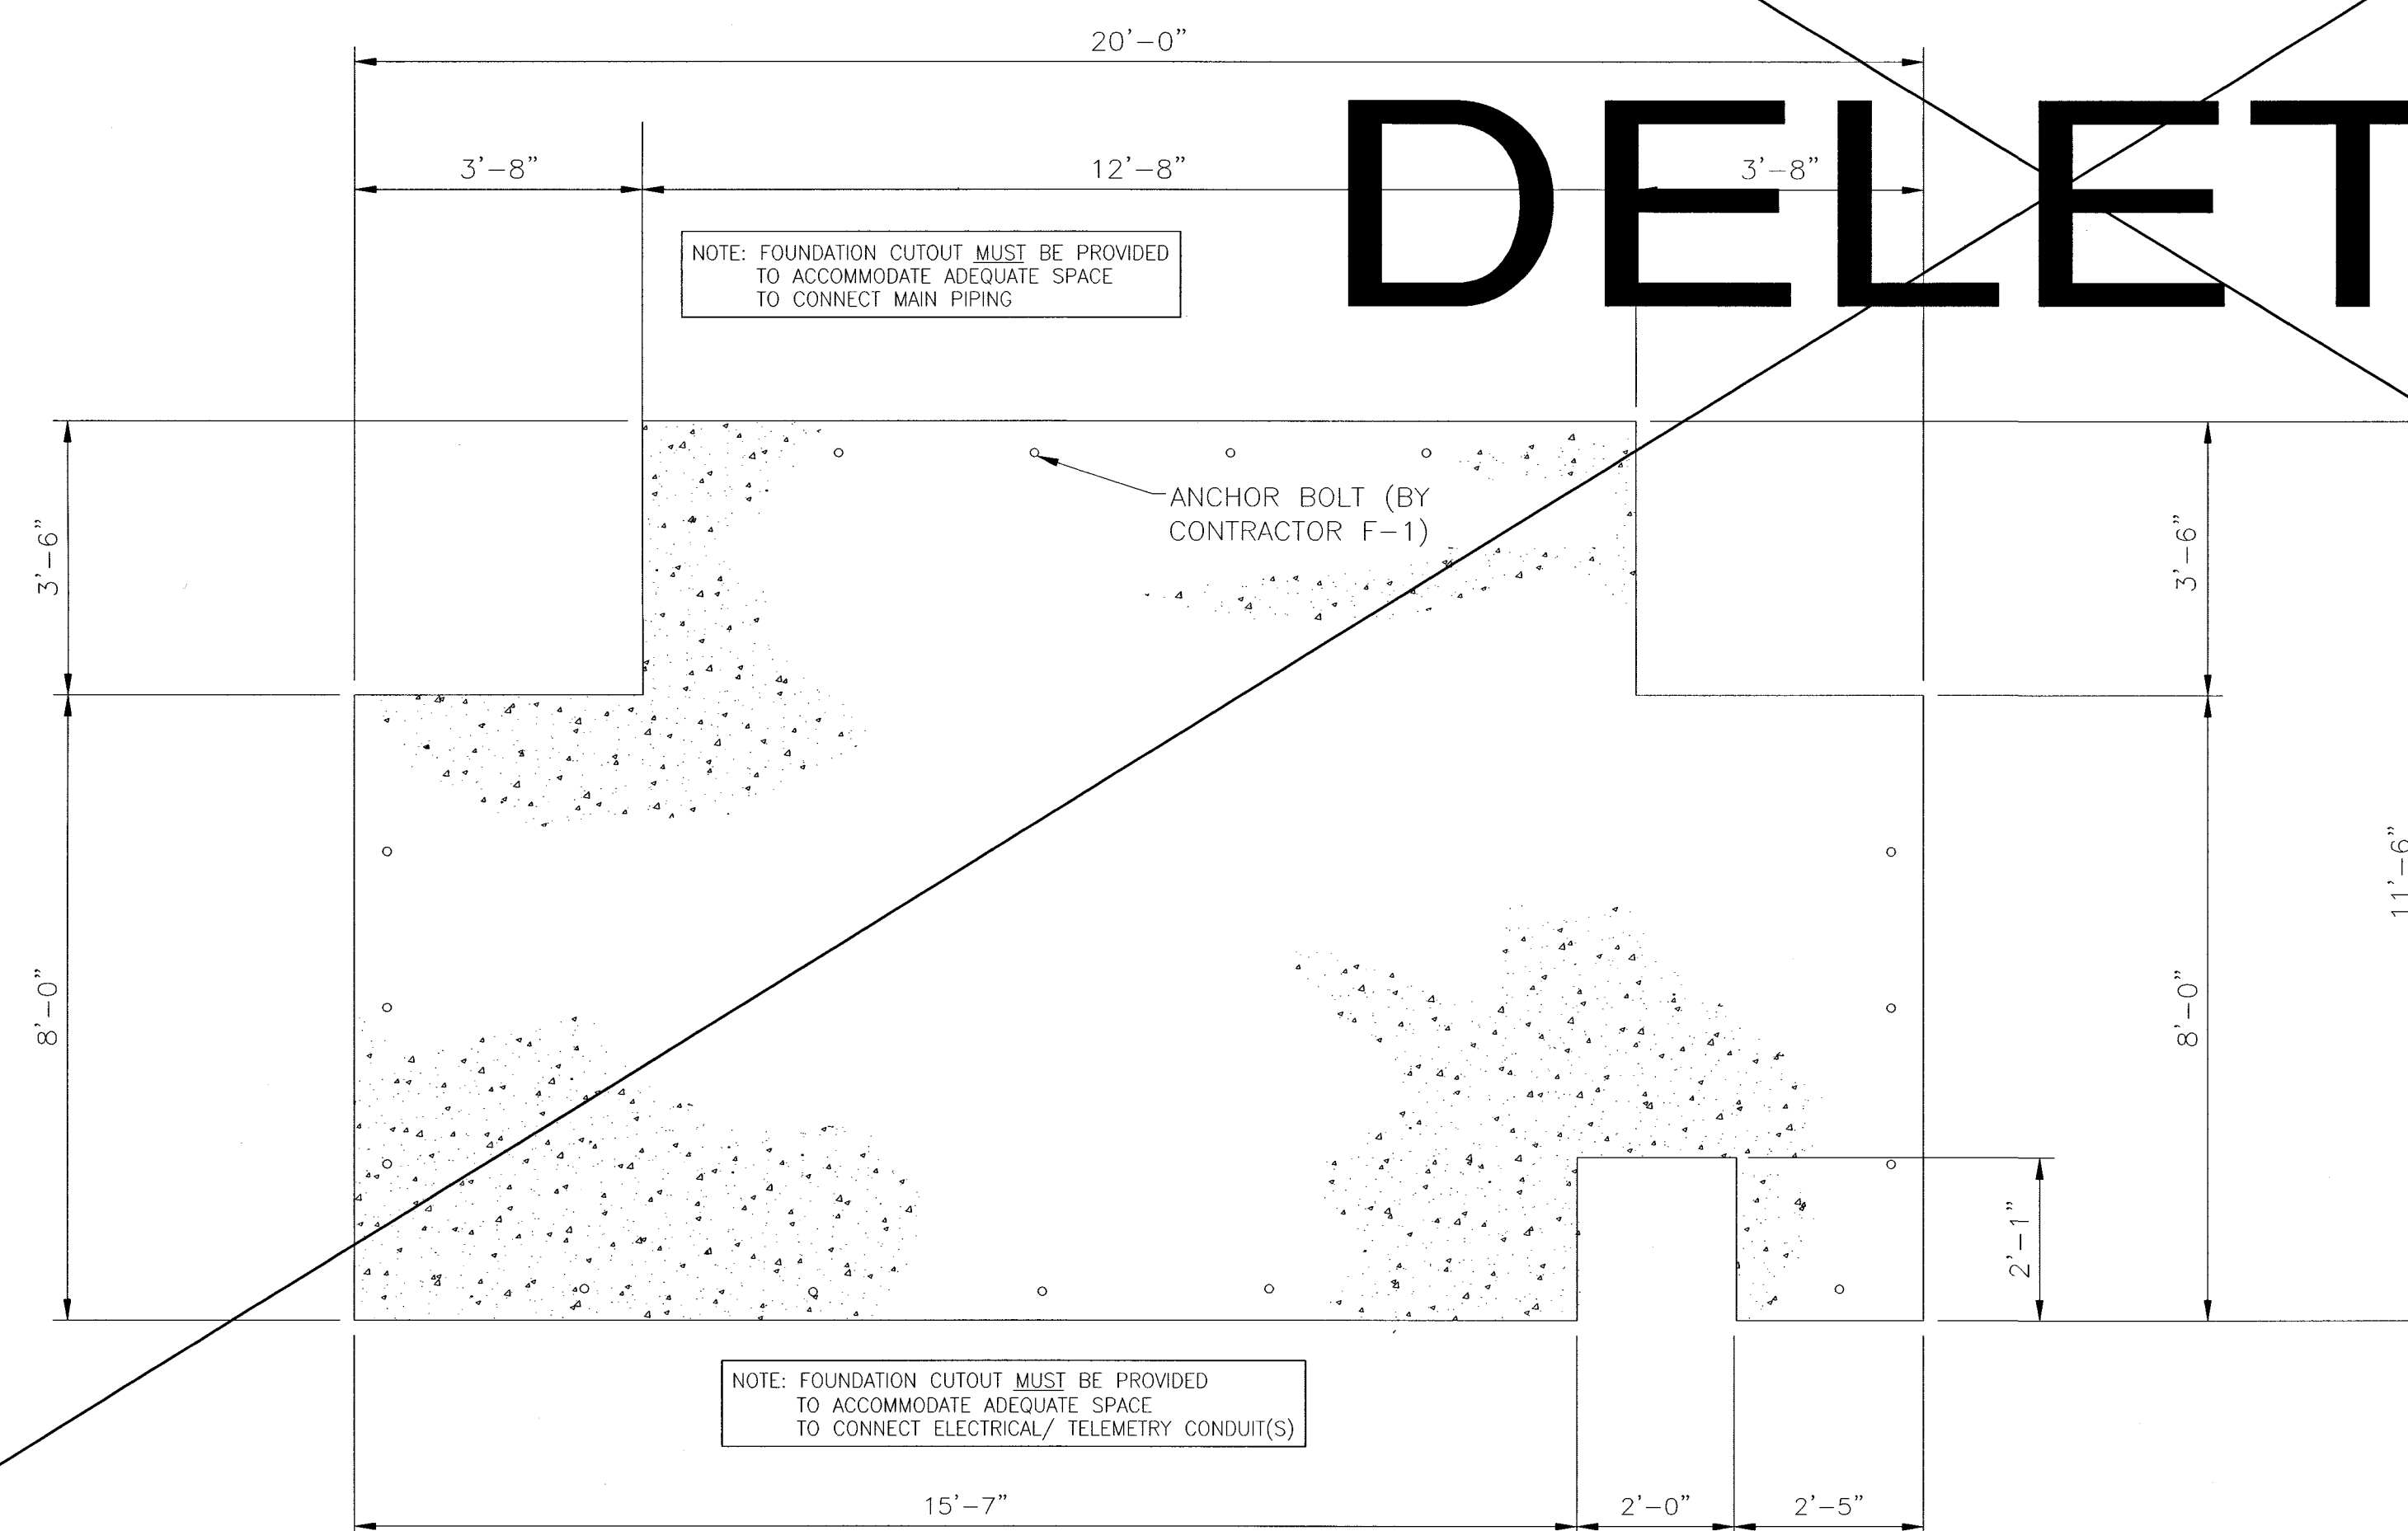

TYPICAL FOUNDATION LAYOUT

(PROVIDED BY CONTRACTOR F-1)

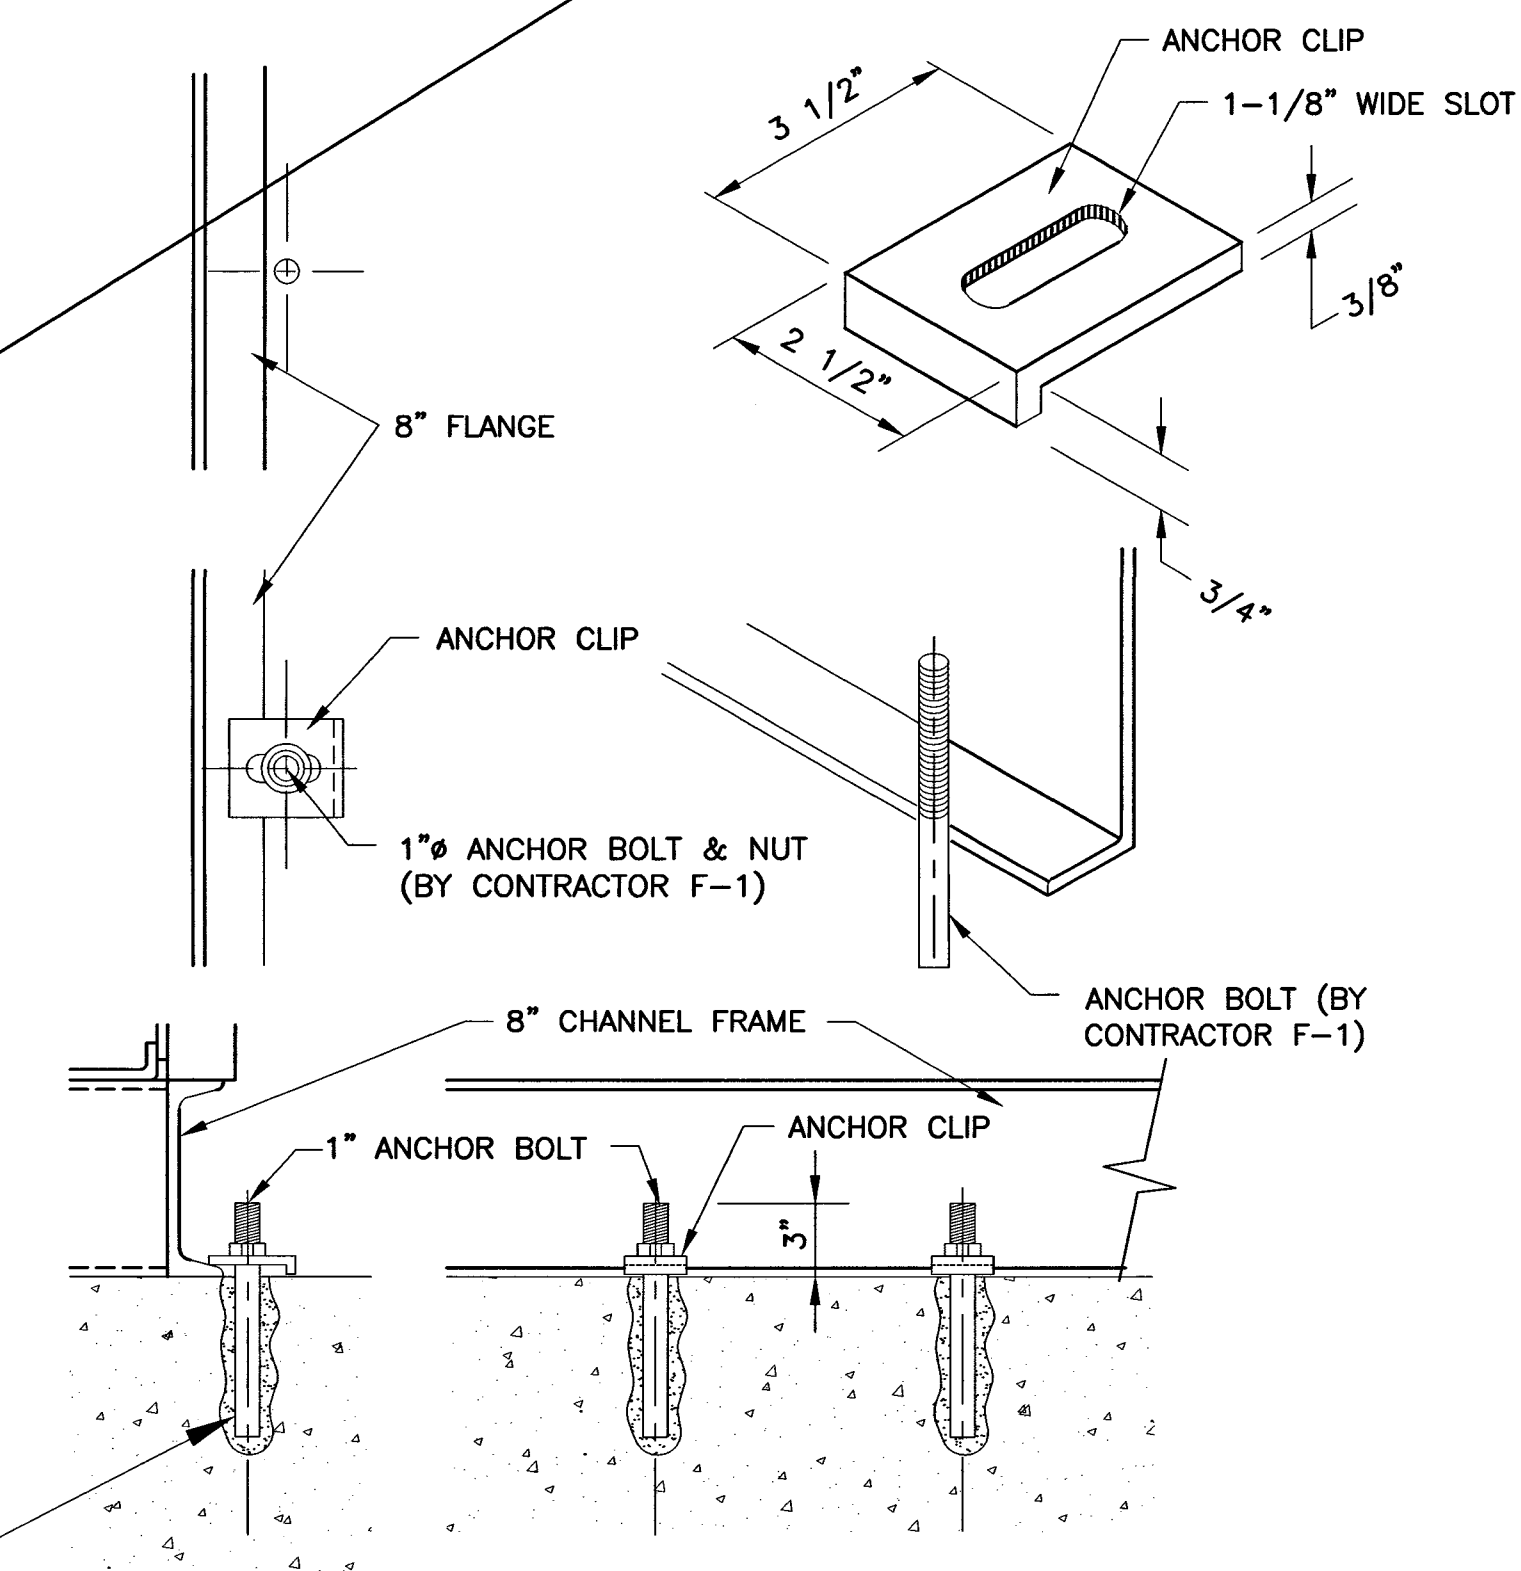

TYPICAL ANCHOR DETAIL

NOTE: ANCHOR CLIPS FURNISHED BY CONTRACTOR F-2
ANCHOR BOLTS AND NUTS FURNISHED AND
INSTALLED BY CONTRACTOR F-1

NOTES:


LEGEND:

FCA - FLANGED COUPLING ADAPTER
RFA - RESTRAINED FLANGE ADAPTER
EPC - ELASTOMER PIPE CONNECTOR

NO.	DESCRIPTION	DATE	BY
1	AS-BUILT	5/2004	MSB
REVISIONS			

HOOSIER HILLS REGIONAL
WATER DISTRICT
DIVISION "F" WATERWORKS SYSTEM IMPROVEMENTS
CONTRACT F-2
PIERCEVILLE PUMP STATION DETAILS

GRW PROJECT NO. 2745-04

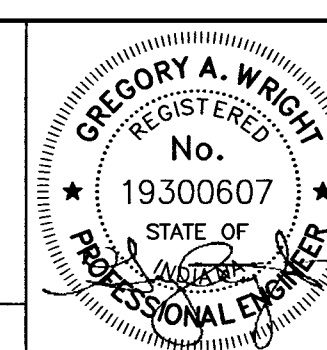

GRW Engineers, Inc.
Engineers, Architects, Planners
INDIANAPOLIS, INDIANA
LOUISVILLE & LEXINGTON, KENTUCKY
CINCINNATI, OHIO
NASHVILLE, TENNESSEE
ARLINGTON, TEXAS

DRAWN: BJD	DATE: JULY 2002
FILE NAME: SHEET577.DWG	SCALE: 1/2"=1'-0"
CHECKED:	SHEET NO.
APPROVED:	577