




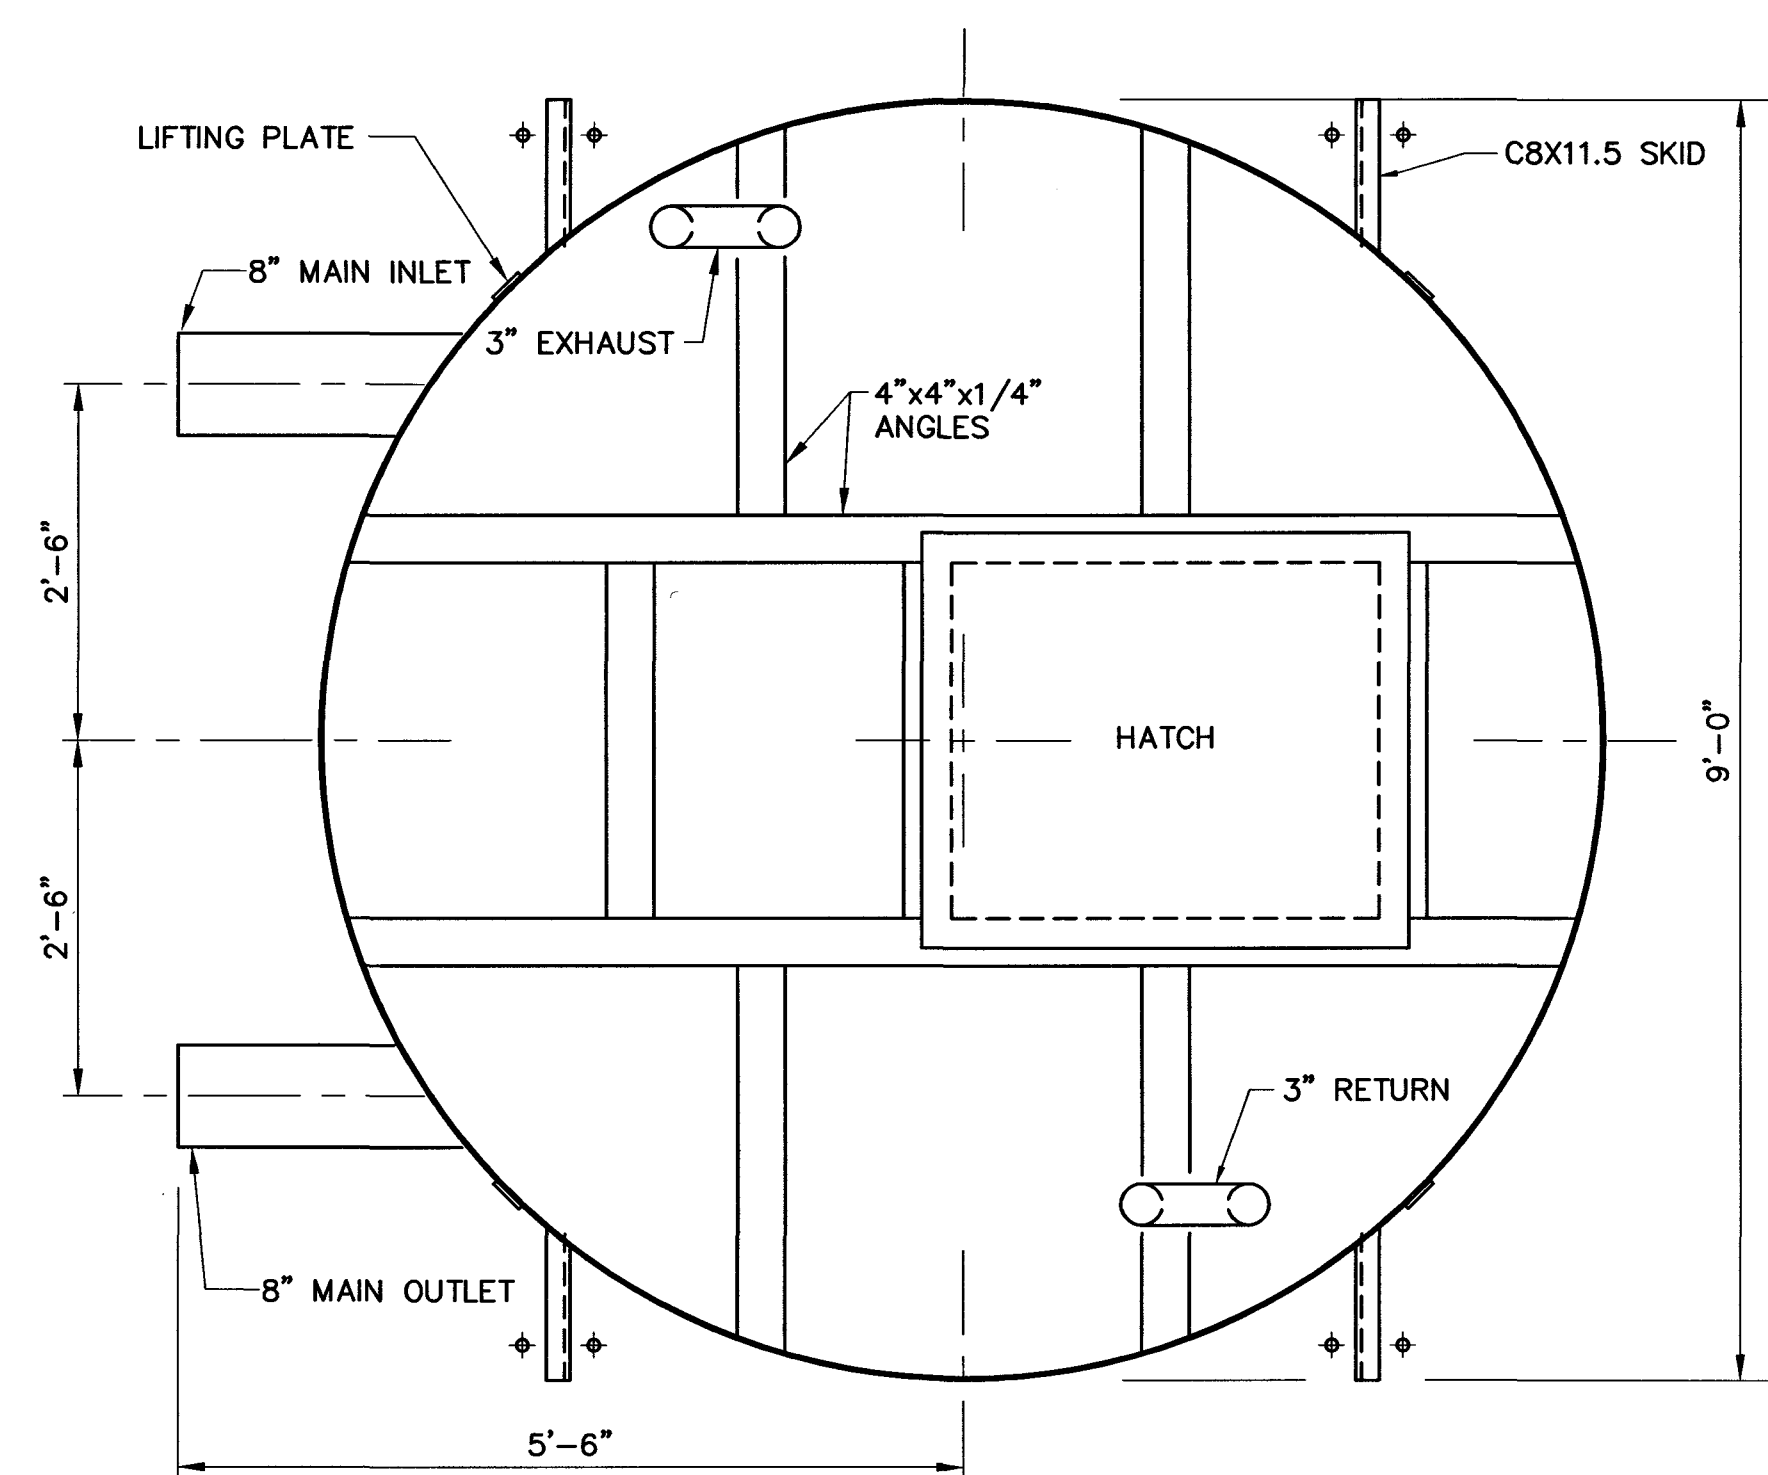


EXTERIOR PLAN

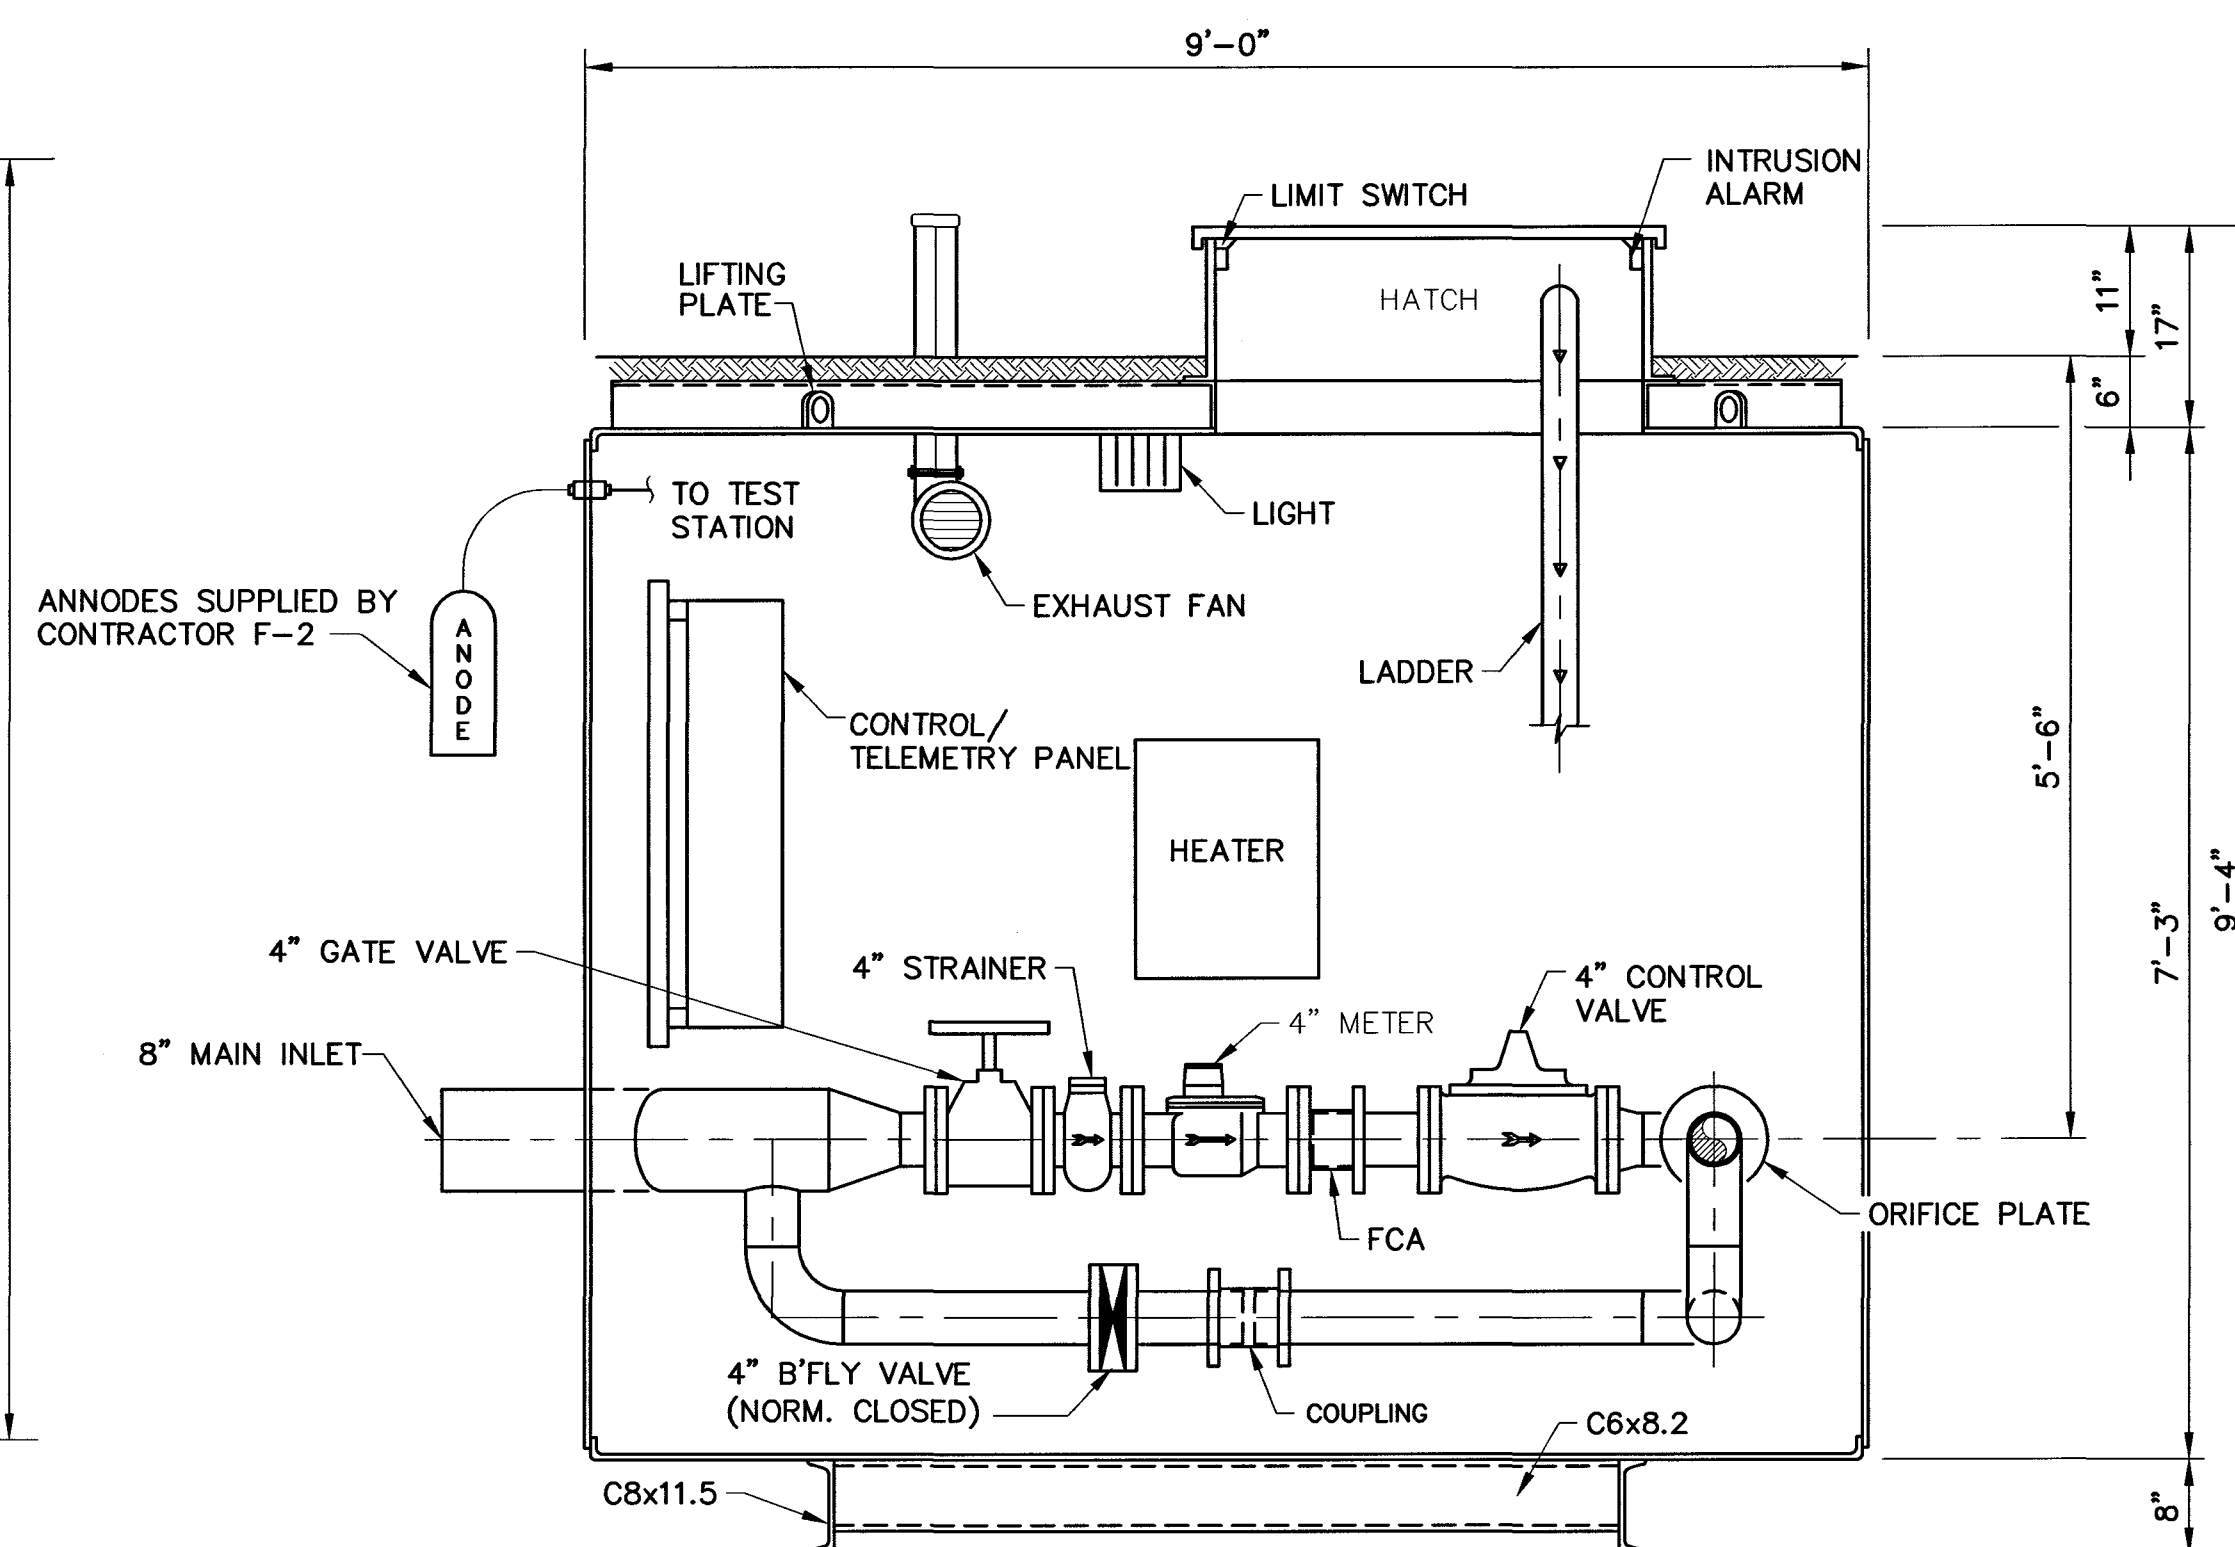


SECTION A-A

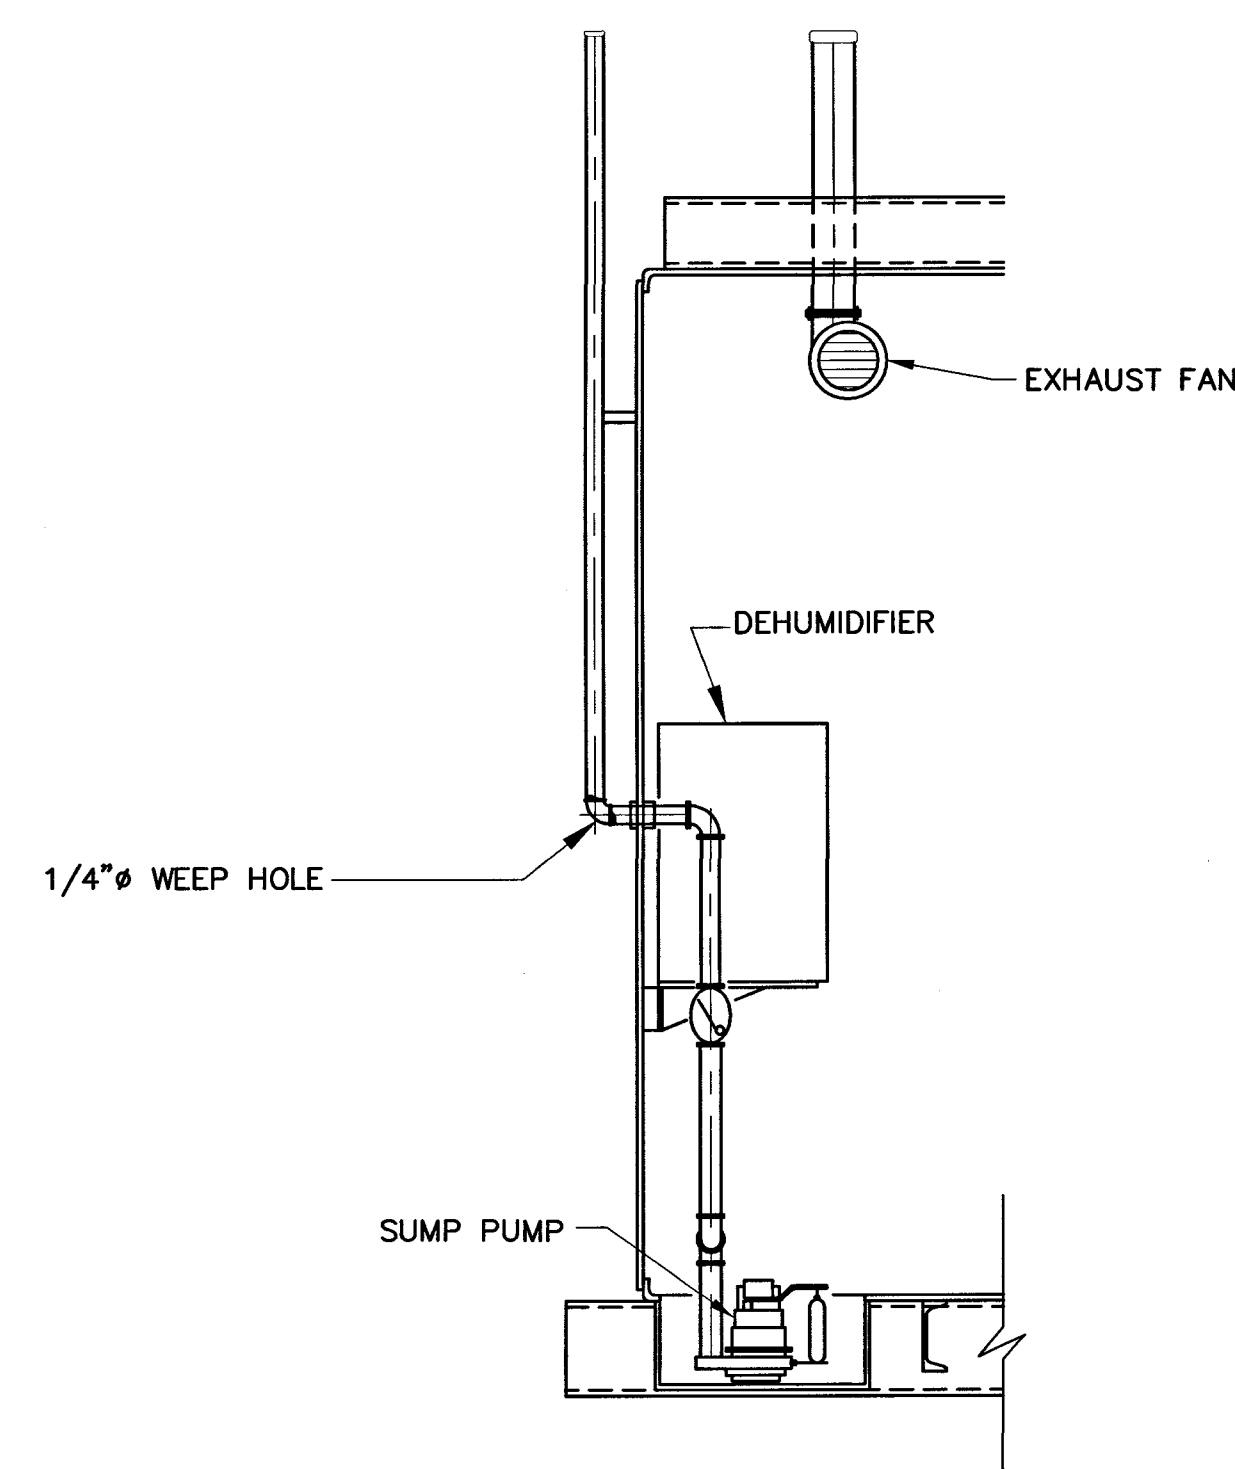

SECTION B-B

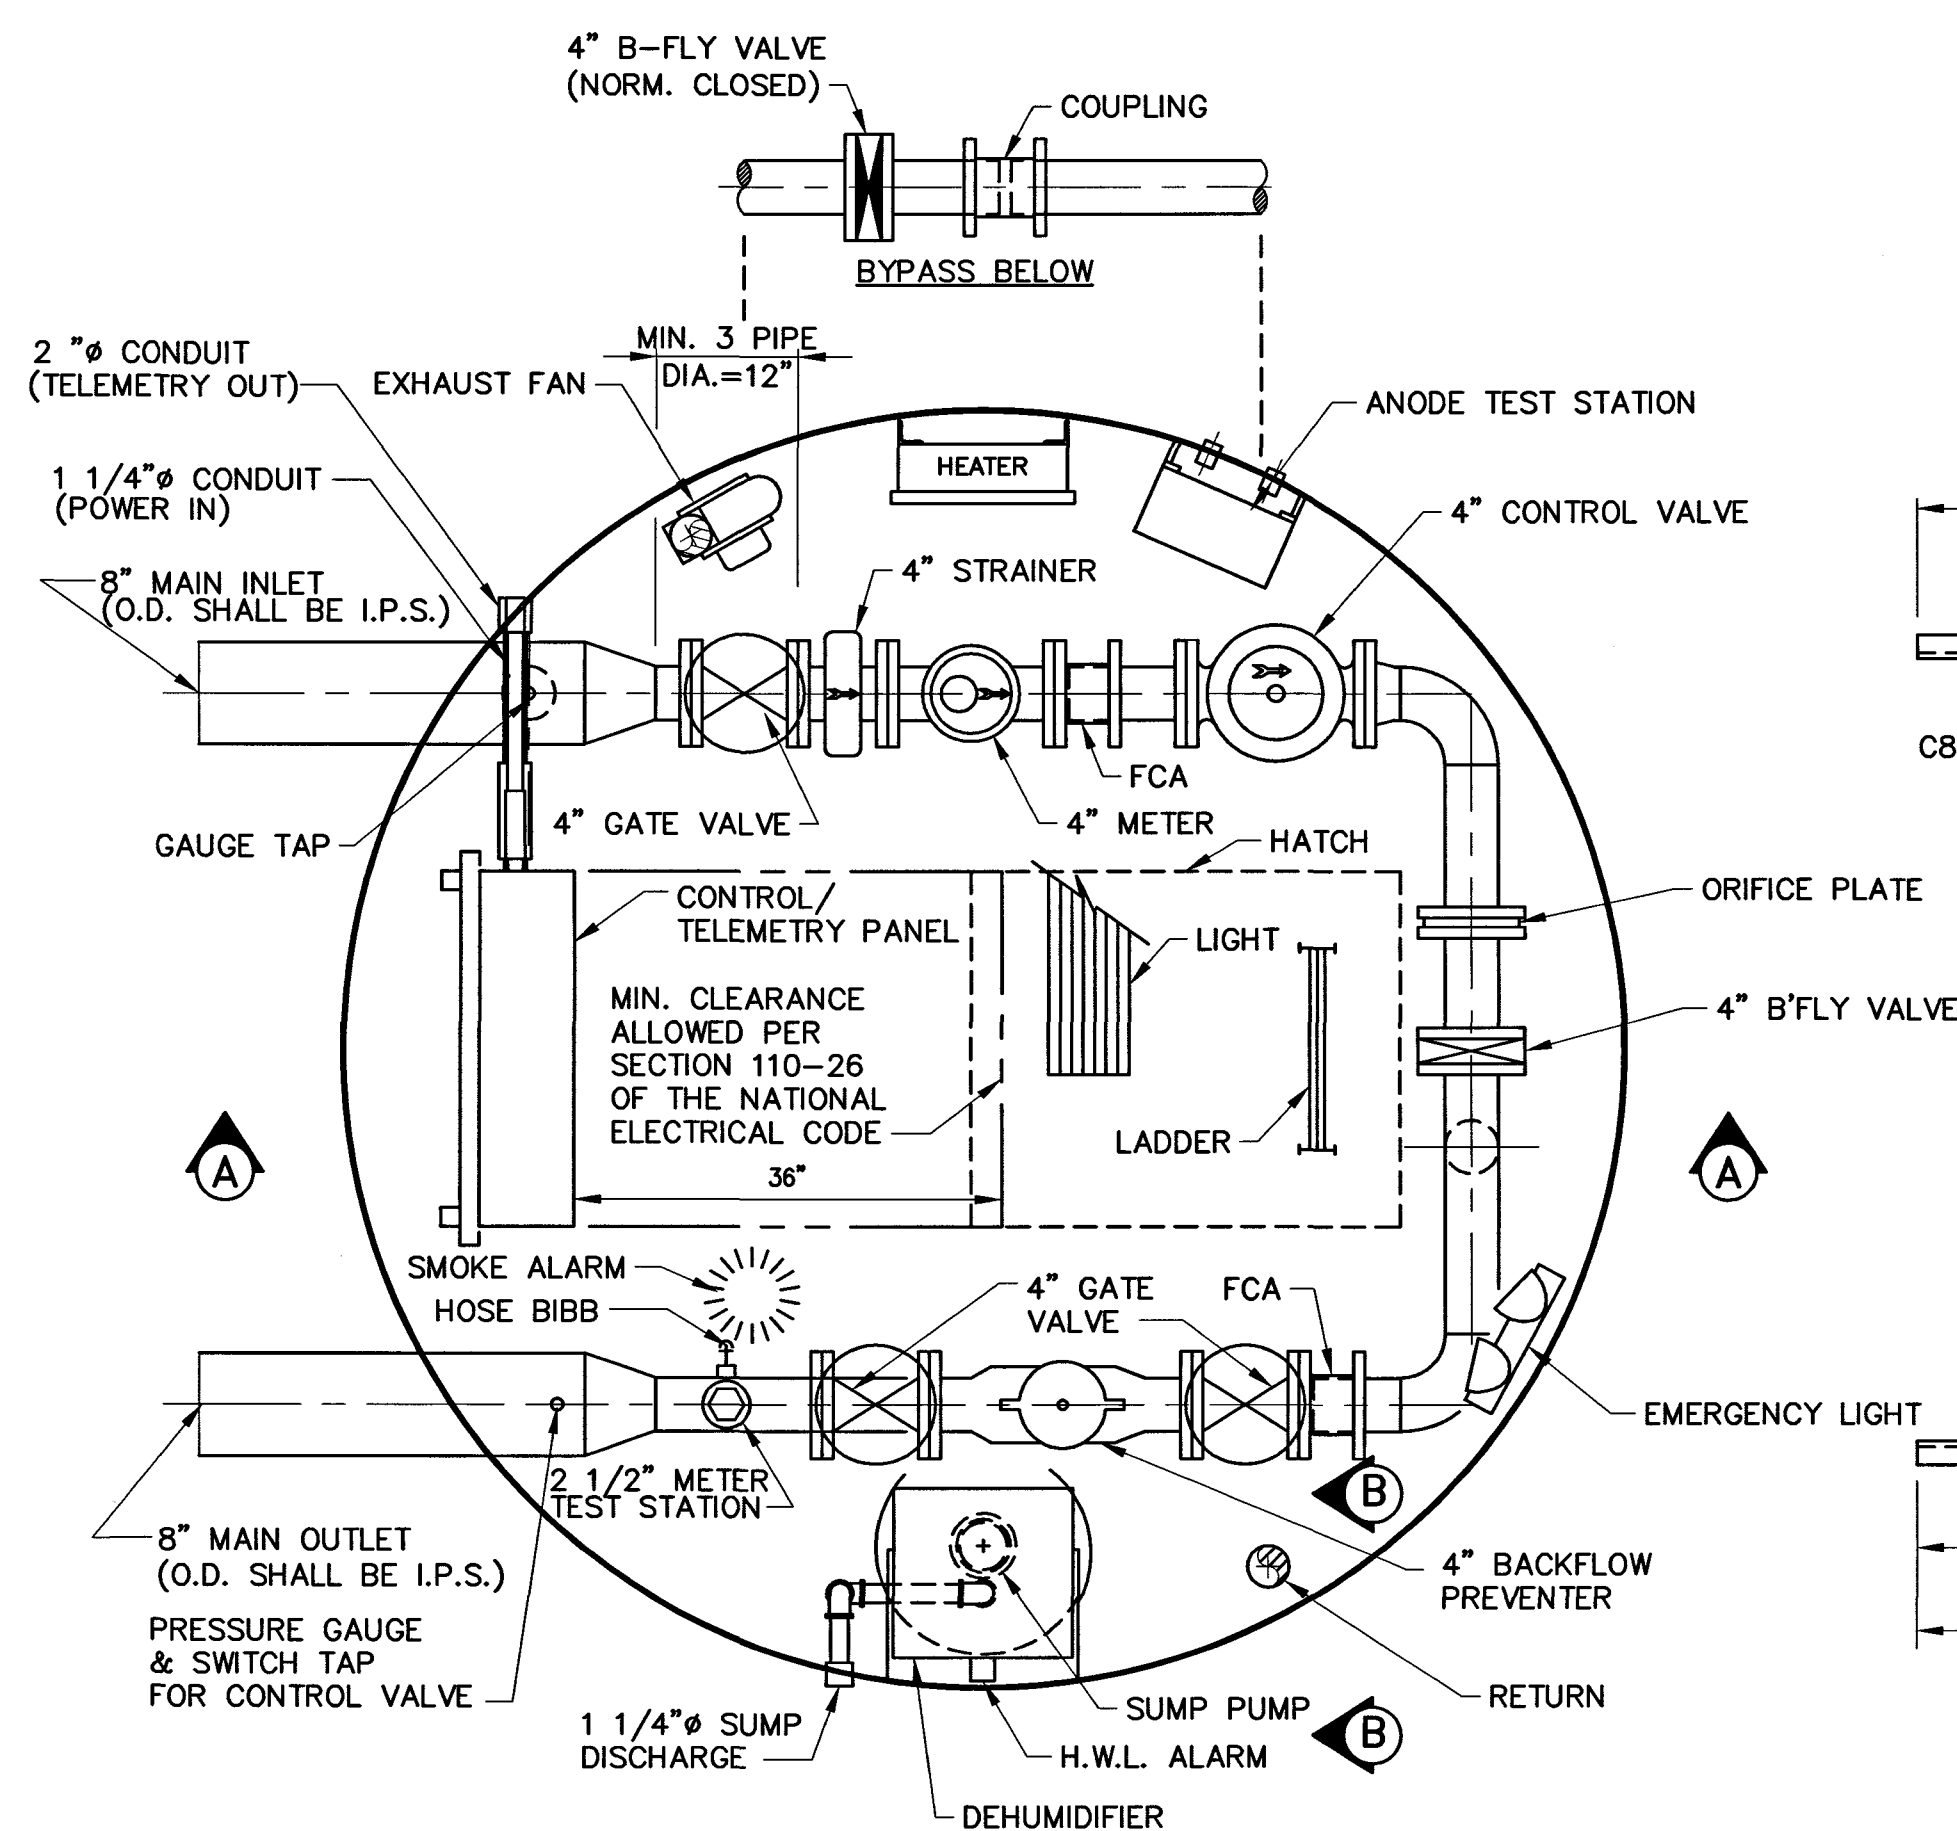


INTERIOR PLAN

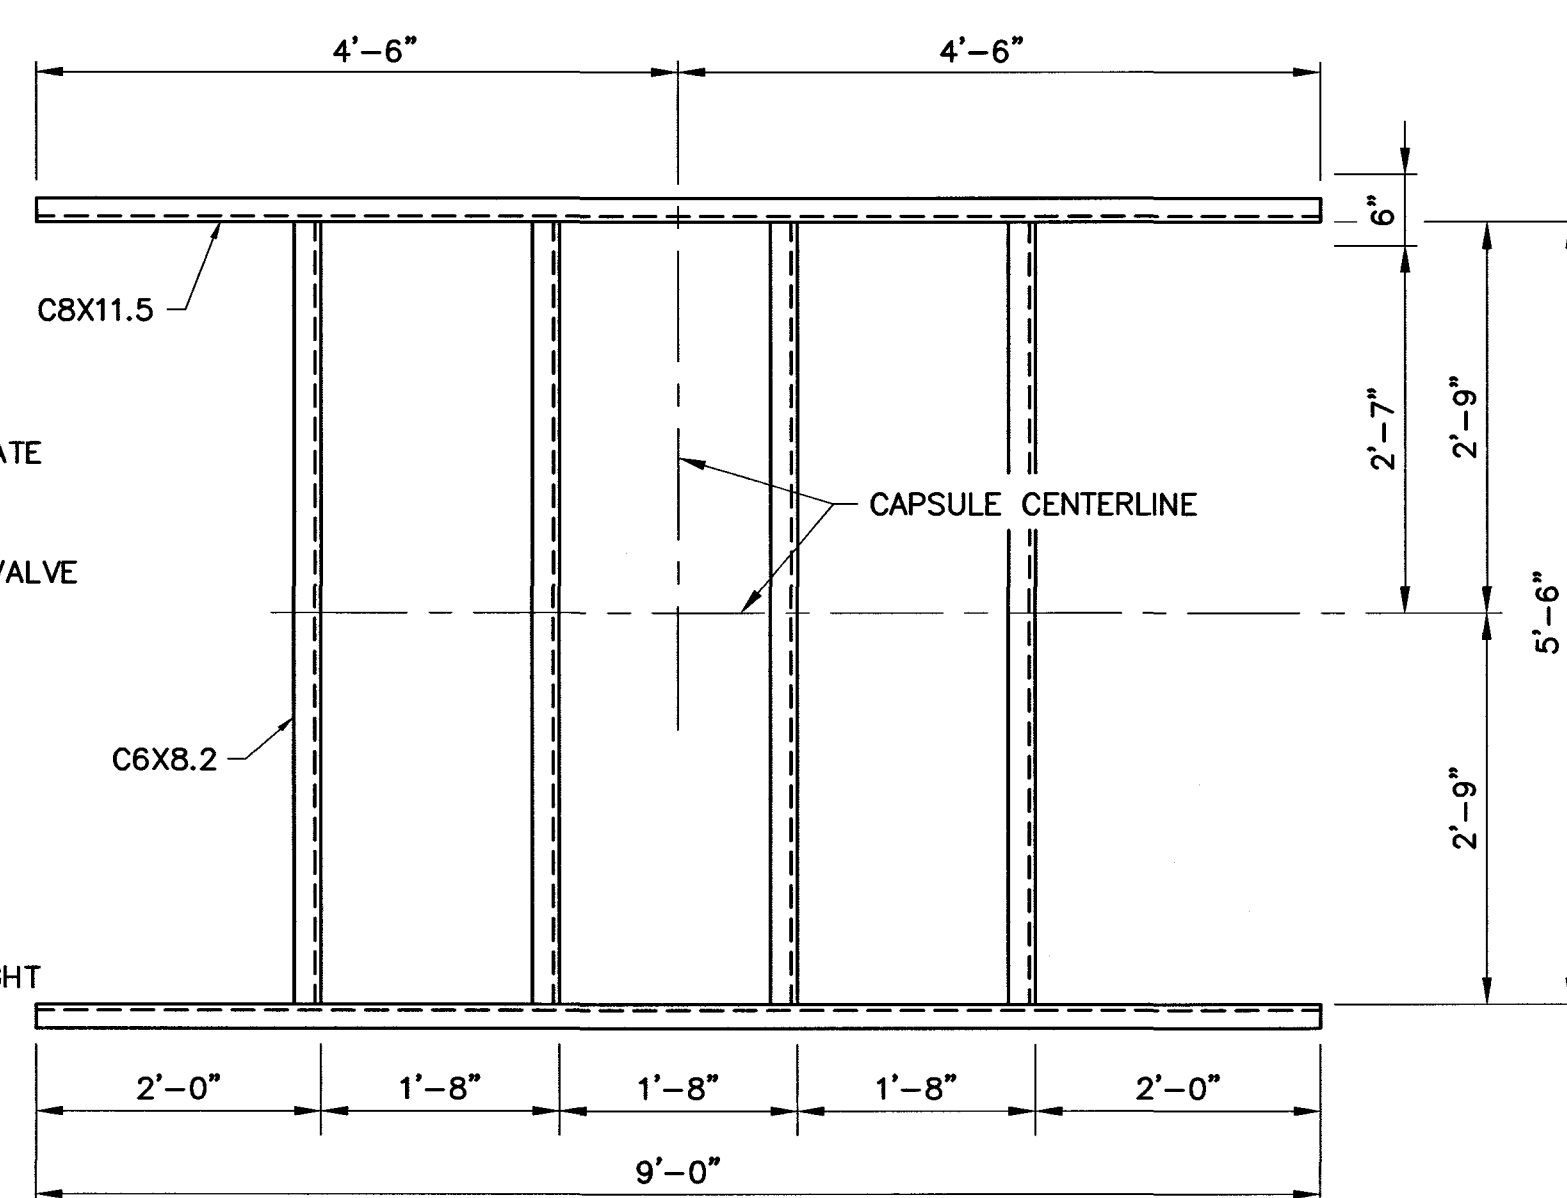


SKID PLAN

RECORD DRAWING
This drawing has been revised from the original contract drawings to show minor/major changes made during construction. This drawing is not warranted to be complete and accurate in all respects.
GRW Engineers, Inc.
Date: 5/2004 By: MSB

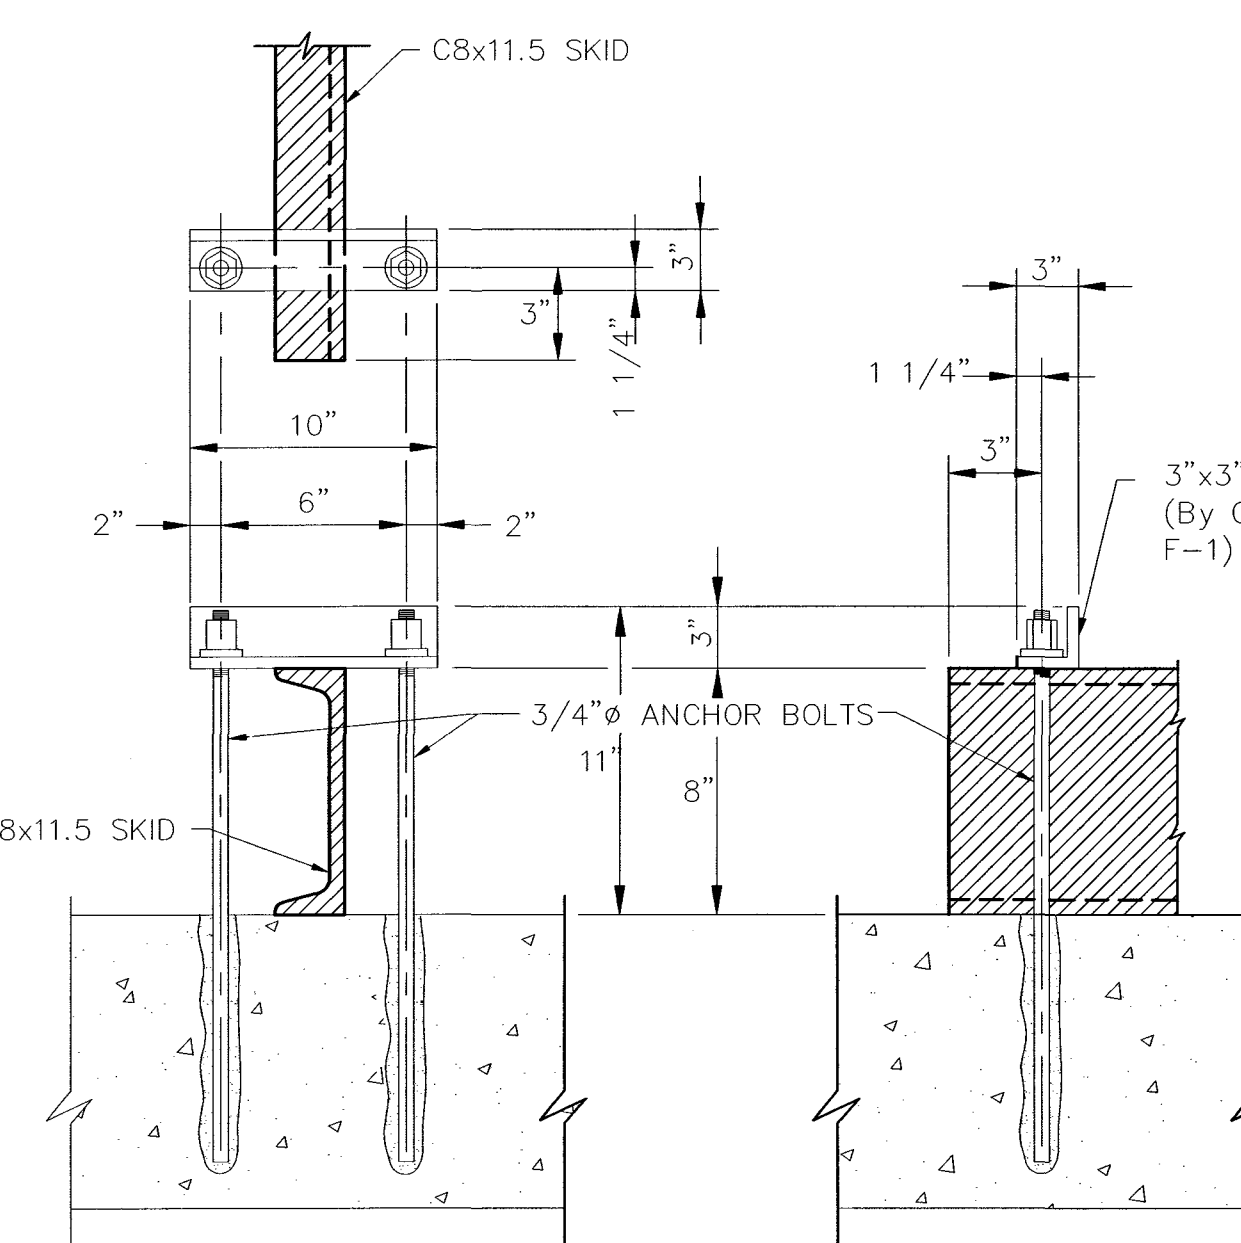

TYPICAL ANCHOR DETAIL

NOTE: ANCHOR ANGLES, ANCHOR BOLTS AND NUTS BY CONTRACTOR F-1

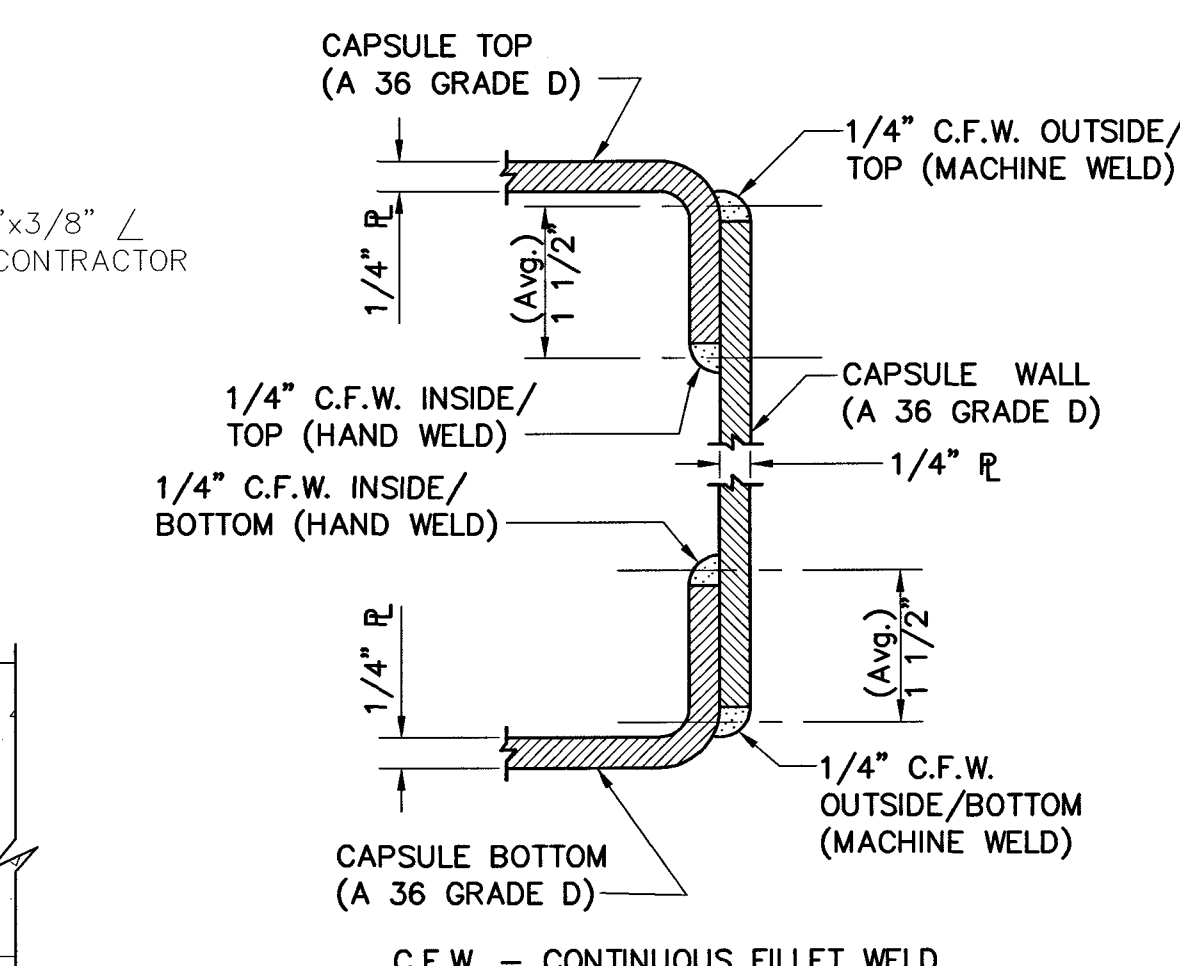

LAP JOINT CONNECTION OF CAPSULE WALL PLATE WITH FLANGE TOP AND BOTTOM

C.F.W. - CONTINUOUS FILLET WELD

NOTES:

LEGEND:
FCA - FLANGED COUPLING ADAPTER
RFA - RESTRAINED FLANGE ADAPTER
EPC - ELASTOMER PIPE CONNECTOR

NO.	DESCRIPTION	DATE	BY
1	AS-BUILT REVISION	5/2004	MSB
REVISIONS			

HOOSIER HILLS REGIONAL
WATER DISTRICT
DIVISION "F" WATERWORKS SYSTEM IMPROVEMENTS
CONTRACT F-2
MILAN MASTER METER VAULT PLAN AND DETAILS
GRW PROJECT NO. 2745-04

GREGORY A. WRIGHT
REGISTERED
No. 19300607
STATE OF INDIANA
PROFESSIONAL ENGINEER

GRW Engineers, Inc.
Engineers, Architects, Planners
INDIANAPOLIS, INDIANA
LOUISVILLE & LEWISBURG, KENTUCKY
CINCINNATI, OHIO
NASHVILLE, TENNESSEE
ARLINGTON, TEXAS

DRAWN: BJD
FILE NAME: SHEET579.DWG
CHECKED:
APPROVED:
DATE: JULY 2002
SCALE: NONE
SHEET NO. 579