

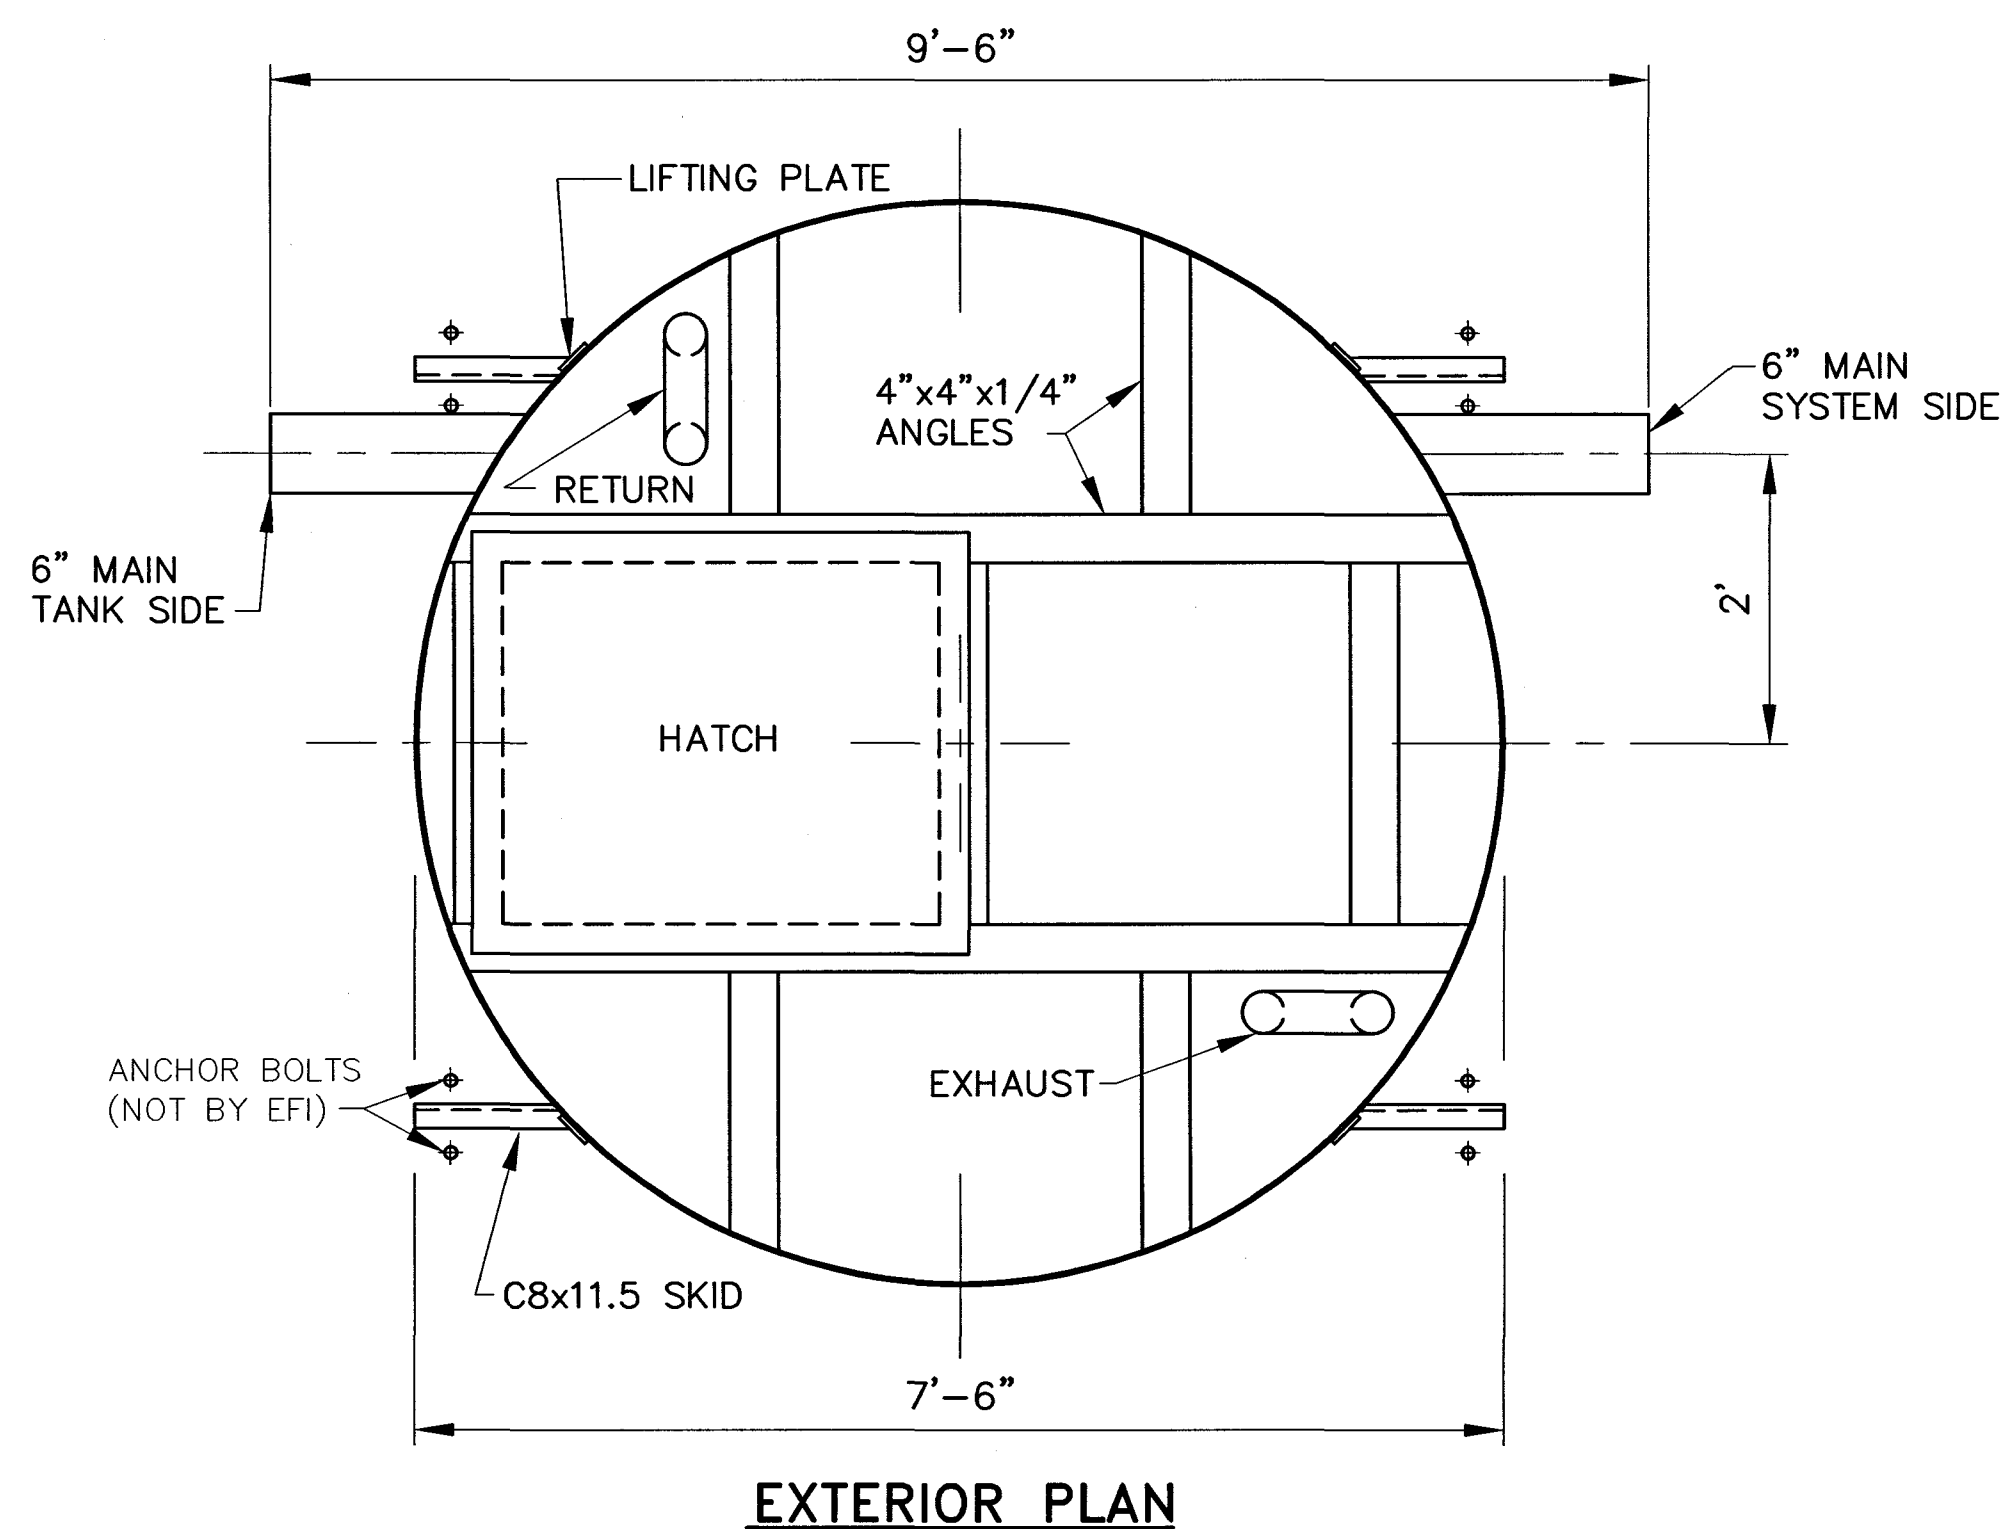
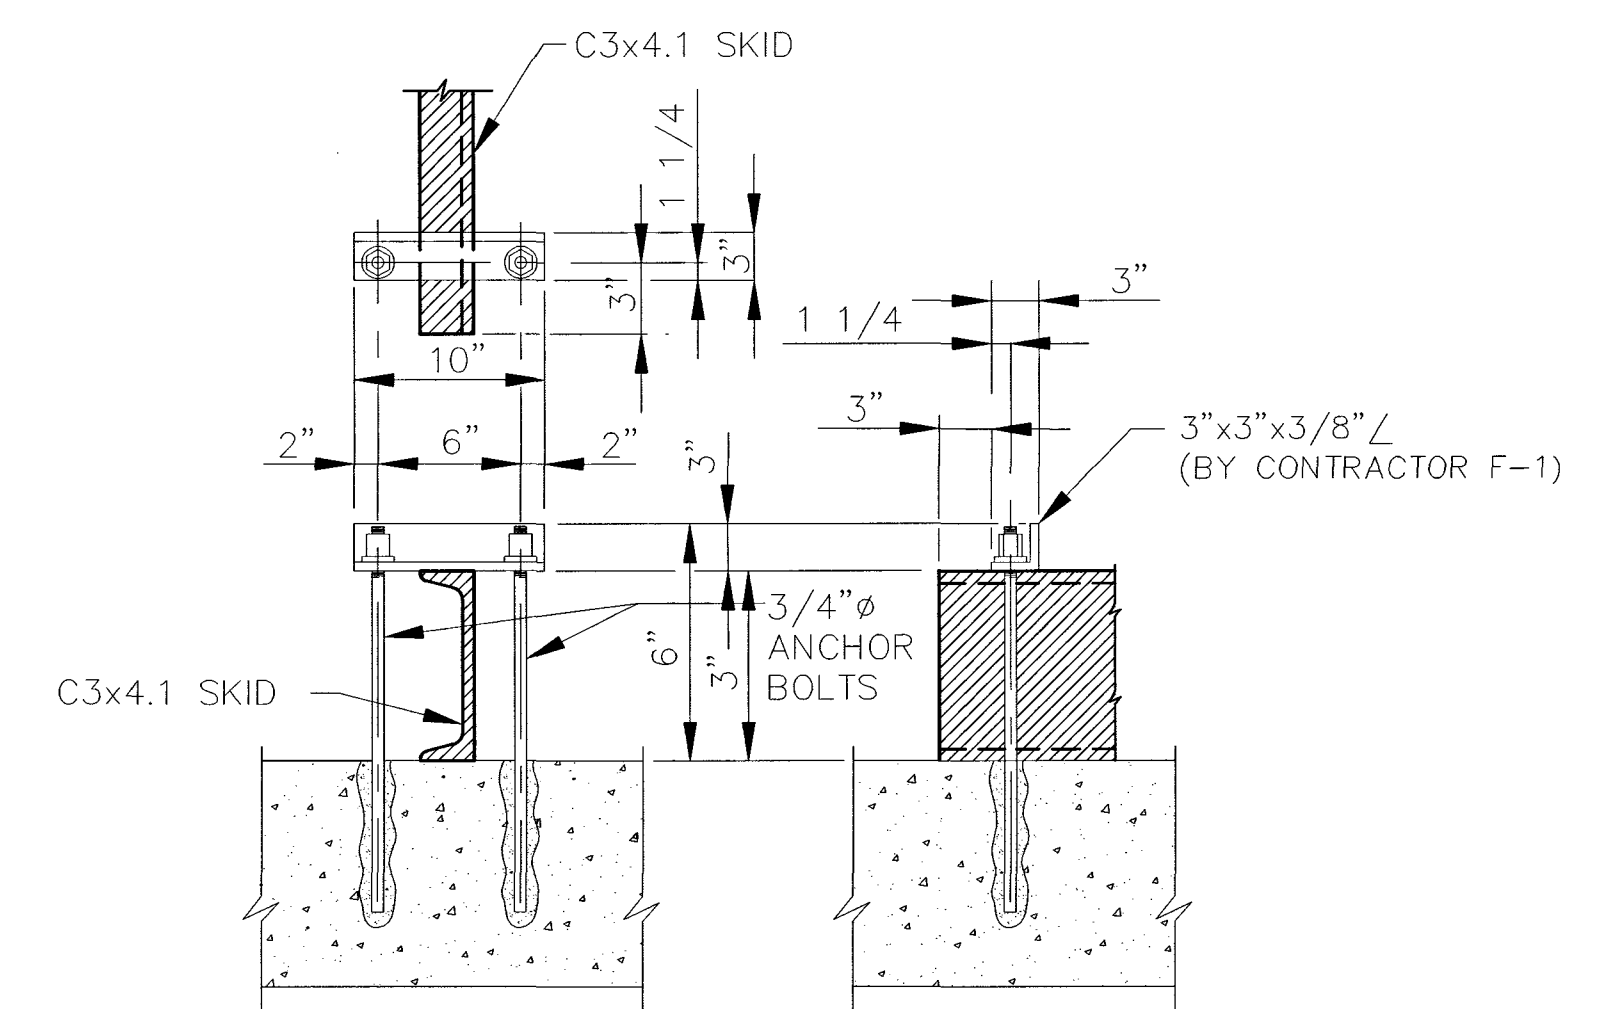
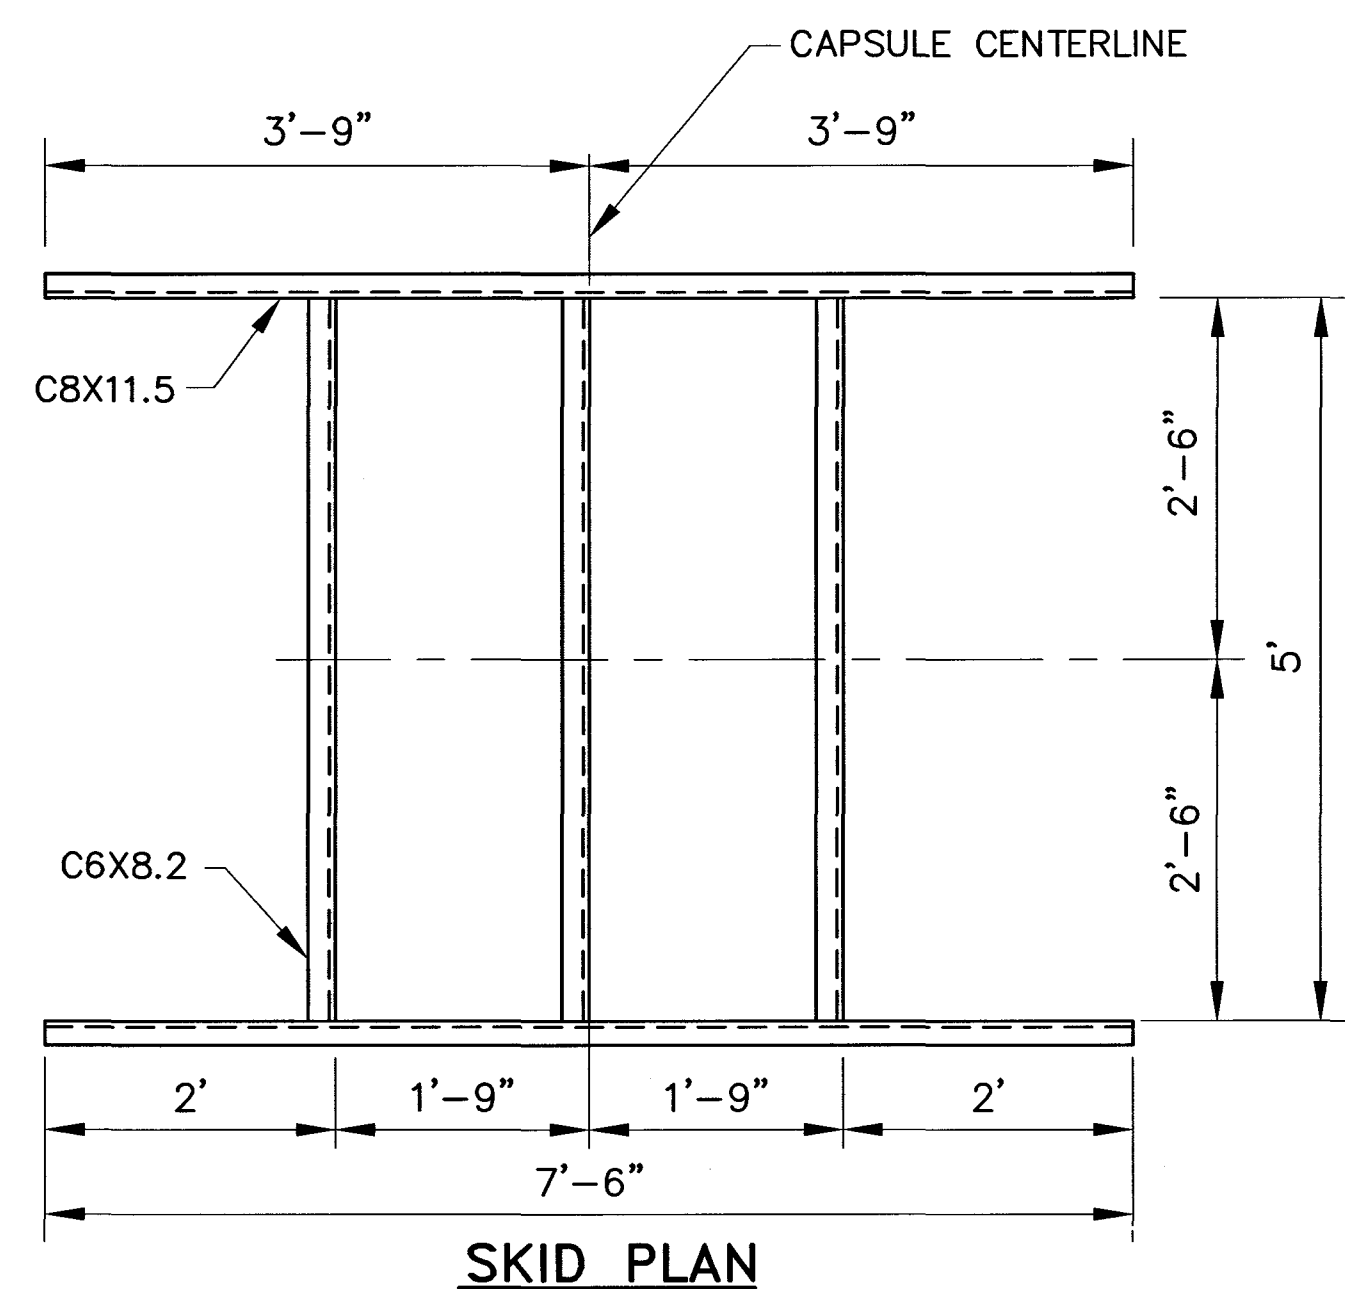
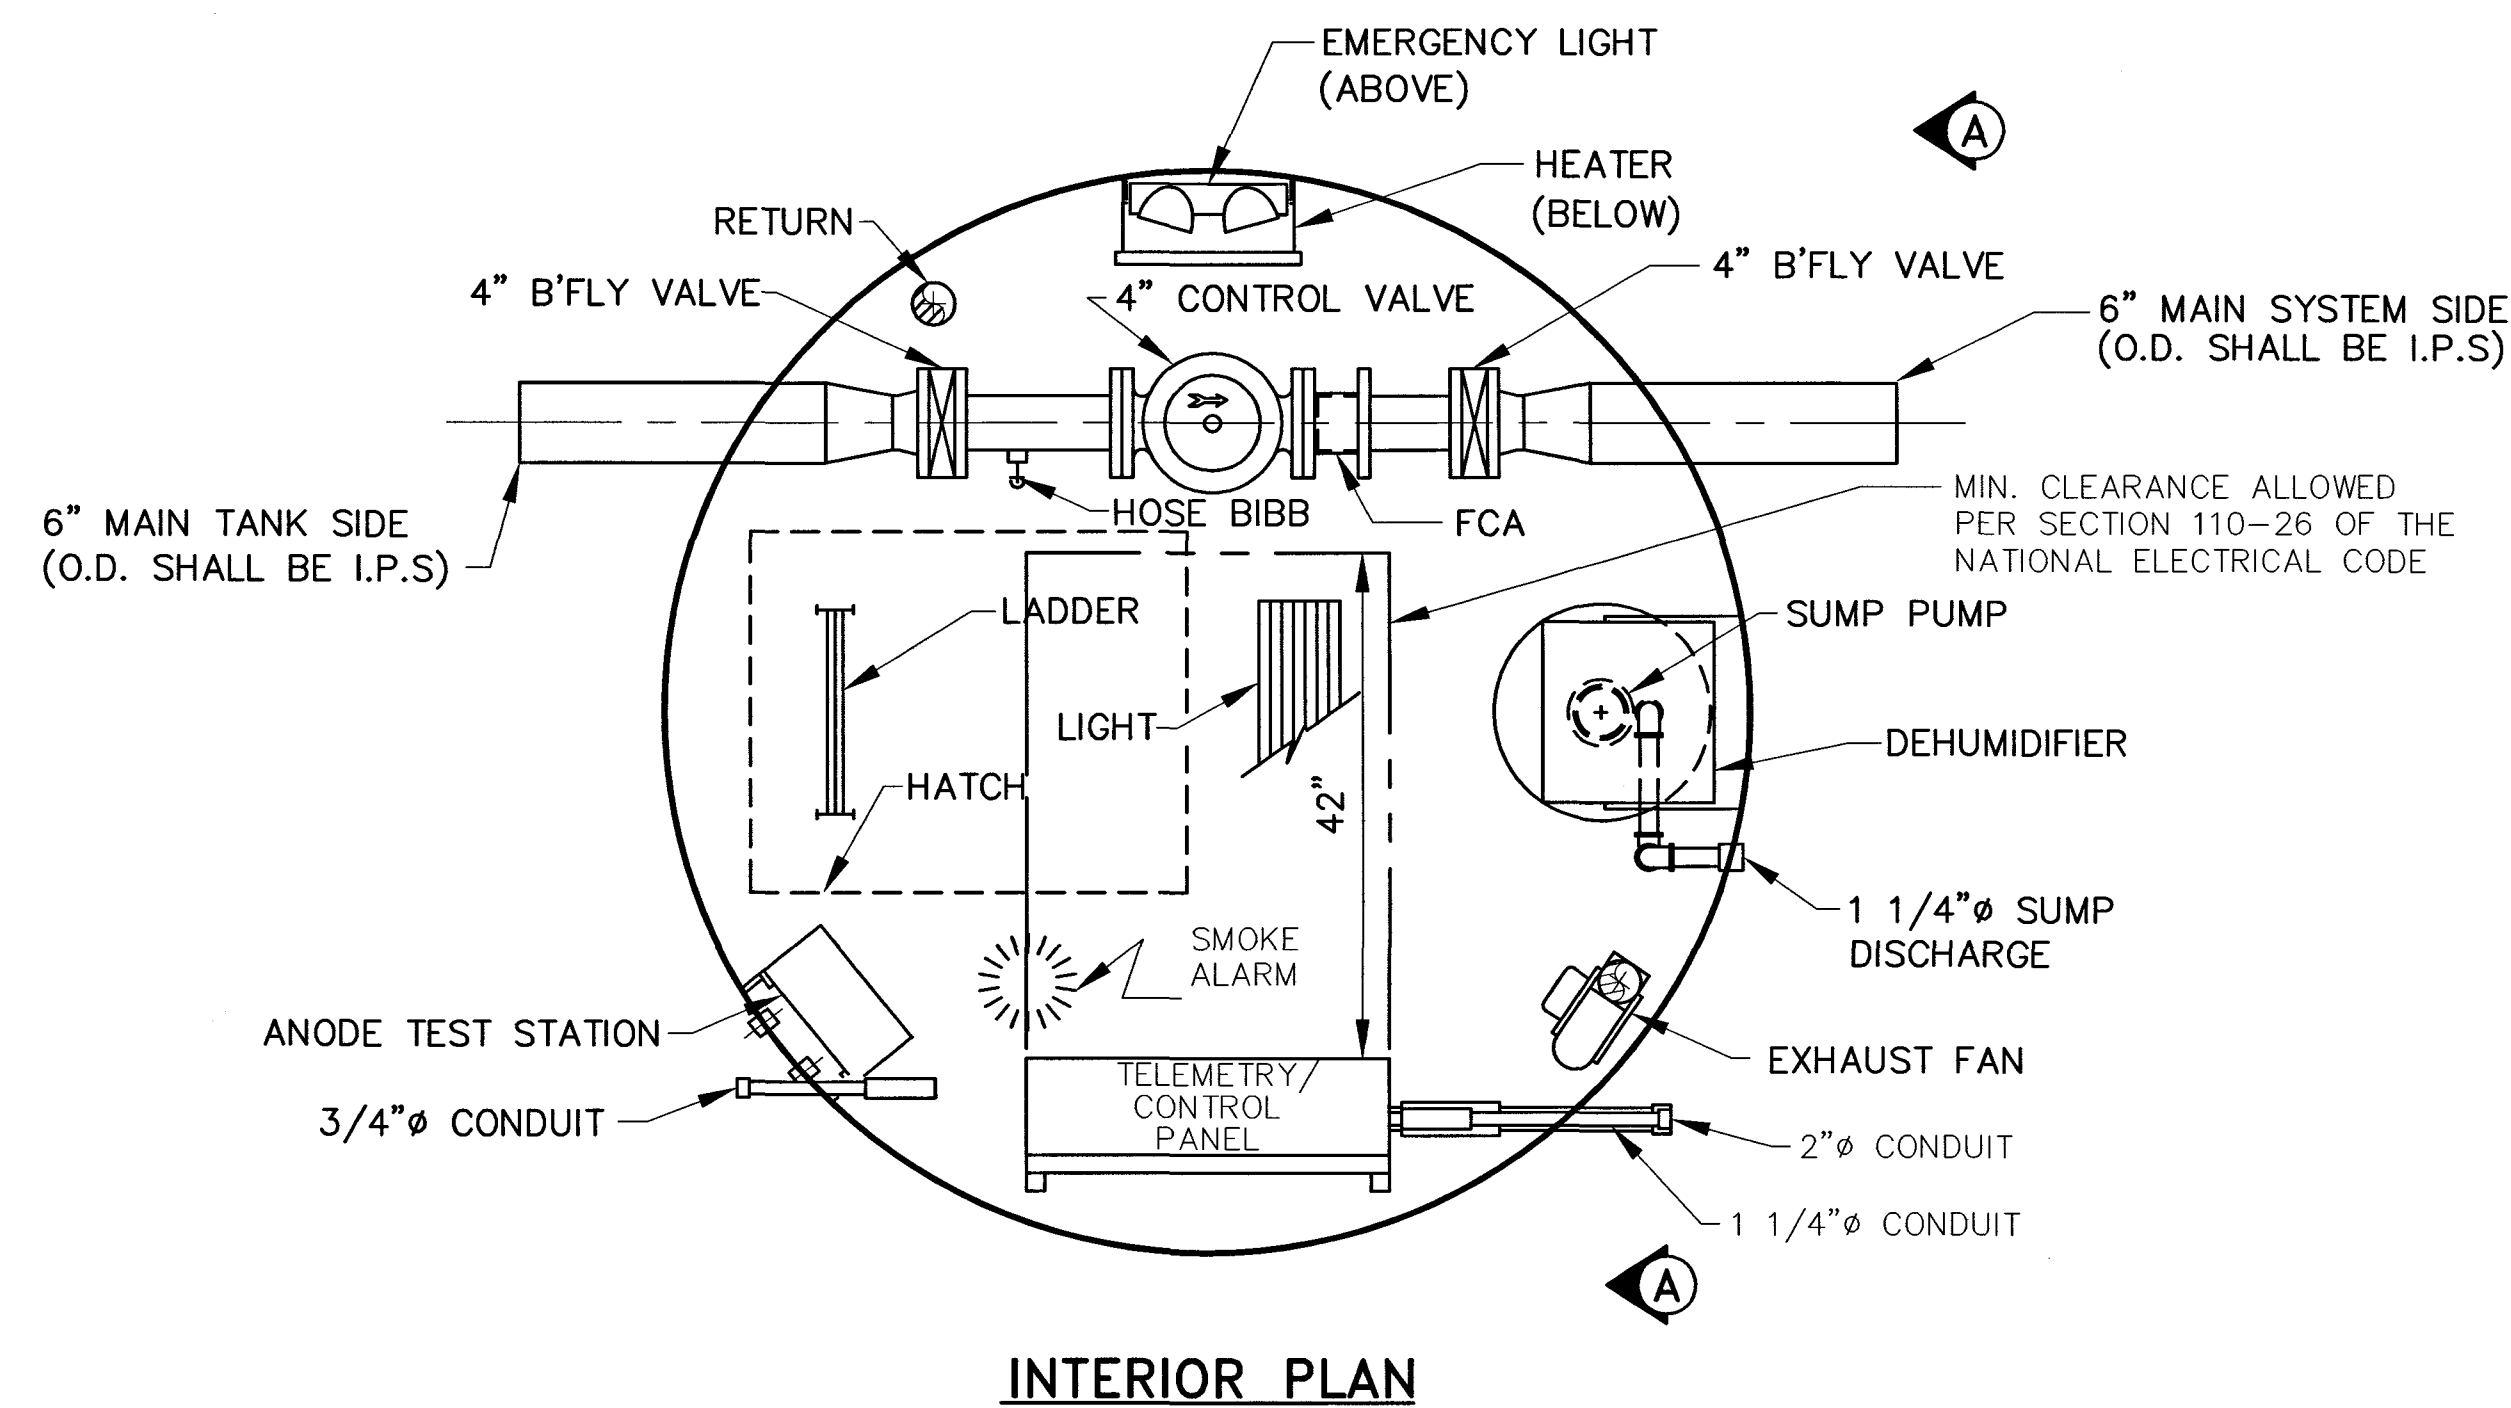


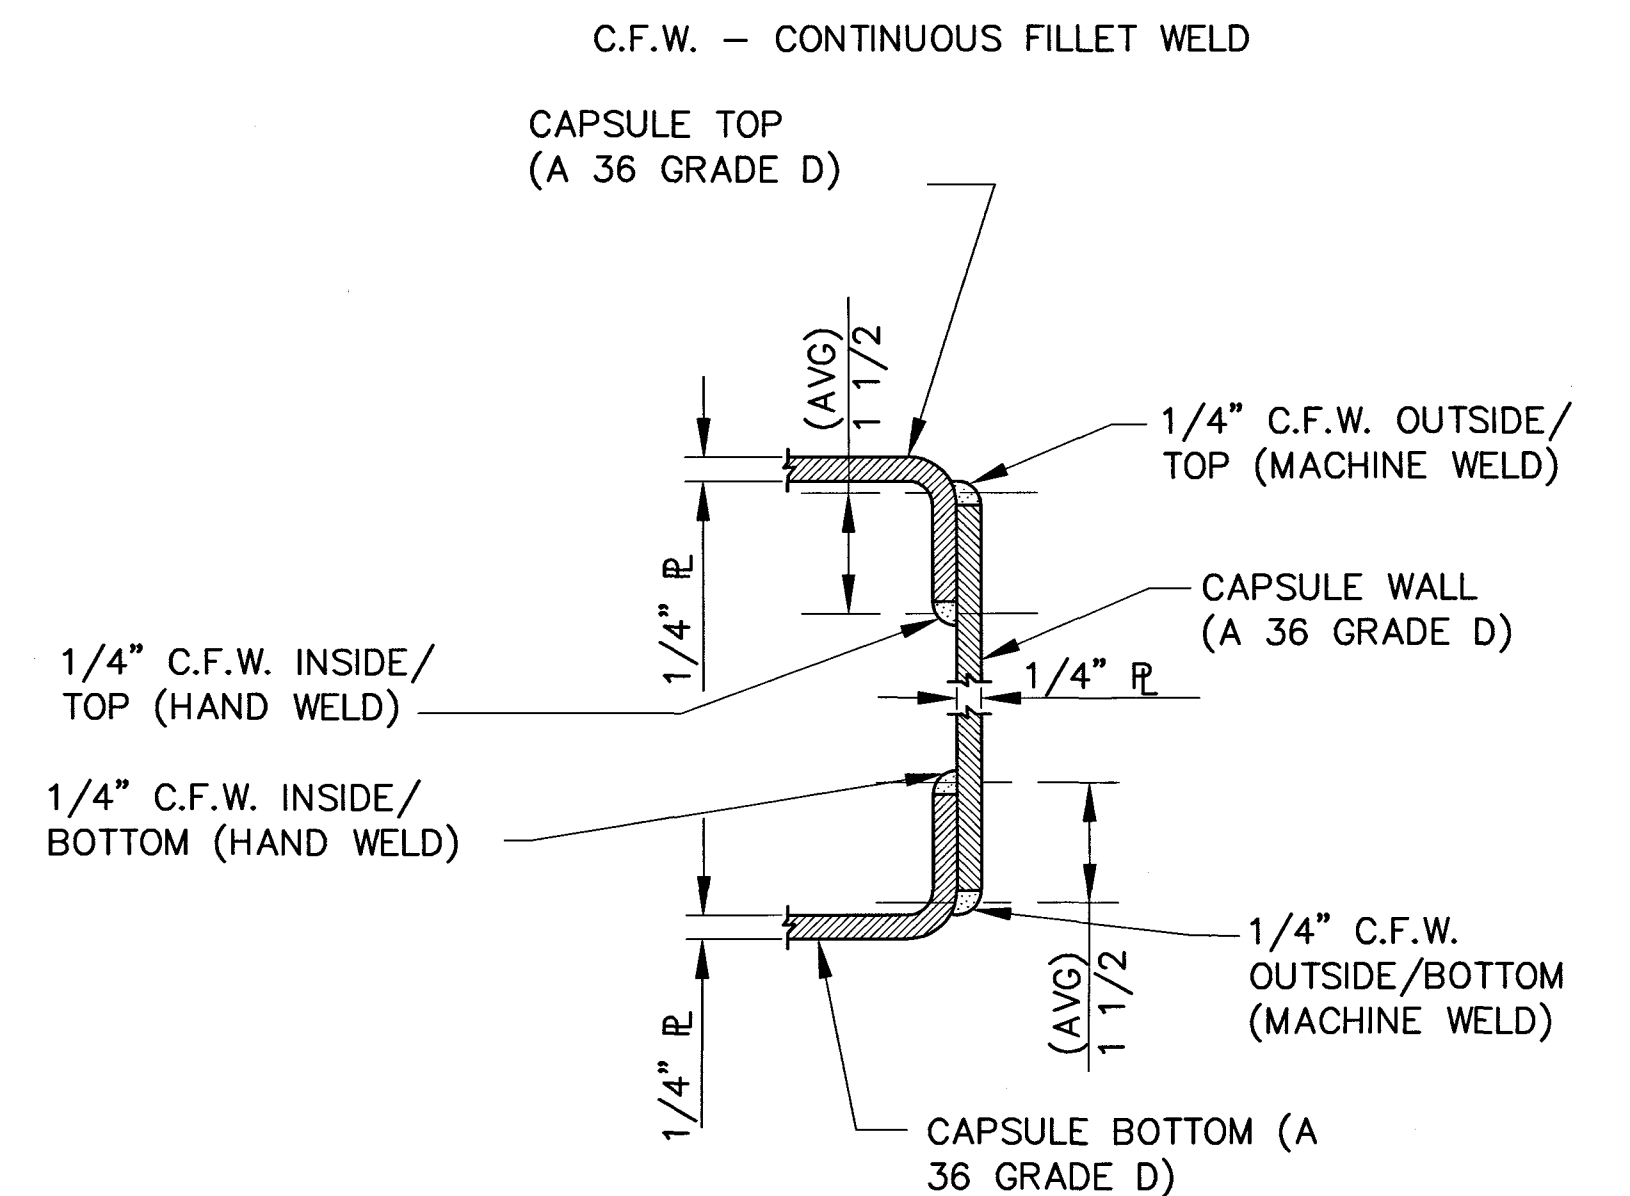

ANODES SUPPLIED BY
STATION MANUFACTURER
WIRING & INSTALLATION
OF ANODES BY
CONTRACTOR F-1

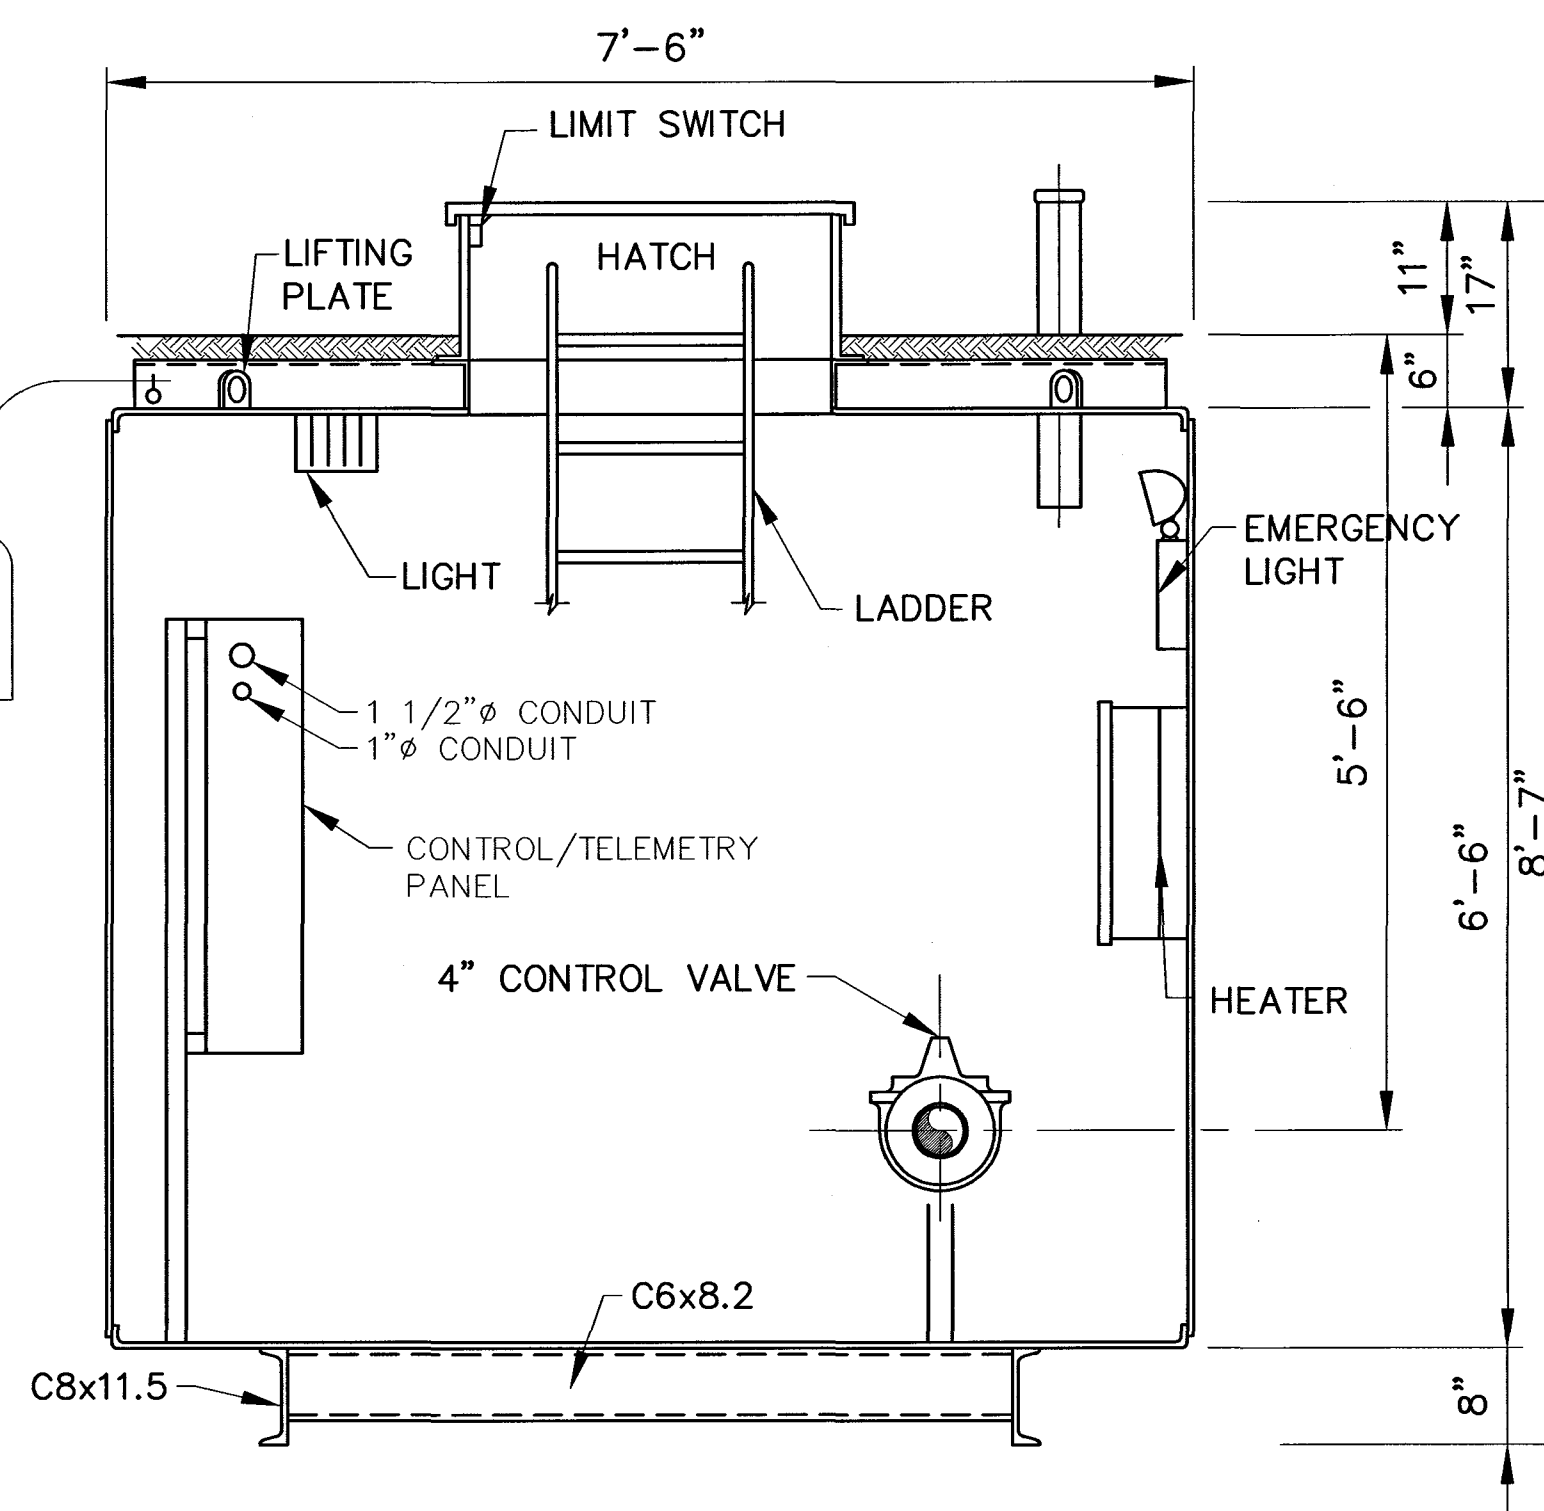

NOTE: ANCHOR CLIPS, ANCHOR BOLTS AND NUTS BY CONTRACTOR F-1

RECORD DRAWING

This drawing has been reduced from the original drawing. The original drawing is the master drawing. This drawing is not to be used for construction. The original drawing is the master drawing. This drawing is not to be used for construction.

GRW Engineers, Inc.

Date: 5/2004 By: GCR

NOTES:

LEGEND:

FCA - FLANGED COUPLING ADAPTER

RFA - RESTRAINED FLANGE ADAPTER

EPC - ELASTOMER PIPE CONNECTOR

NO.	DESCRIPTION	DATE	BY
1	AS-BUILT REVISIONS	5/2004	MSB
REVISIONS			

HOOSIER HILLS REGIONAL
WATER DISTRICT
DIVISION "F" WATERWORKS SYSTEM IMPROVEMENTS
CONTRACT F-2
ELROD ALTITUDE VALVE STATION

GRW PROJECT NO. 2745-04

GREGORY A. WRIGHT
REGISTERED
No. 19300607
STATE OF OHIO
PROFESSIONAL ENGINEER

GRW Engineers, Inc.
Engineers, Architects, Planners
INDIANAPOLIS, INDIANA
LOUISVILLE & LEVINGTON, KENTUCKY
CINCINNATI, OHIO
NASHVILLE, TENNESSEE
ARLINGTON, TEXAS

DRAWN: BJD
FILE NAME: SHEETS80.DWG
CHECKED:
APPROVED:

DATE: JULY 2002
SCALE: NONE
SHEET NO. 580