



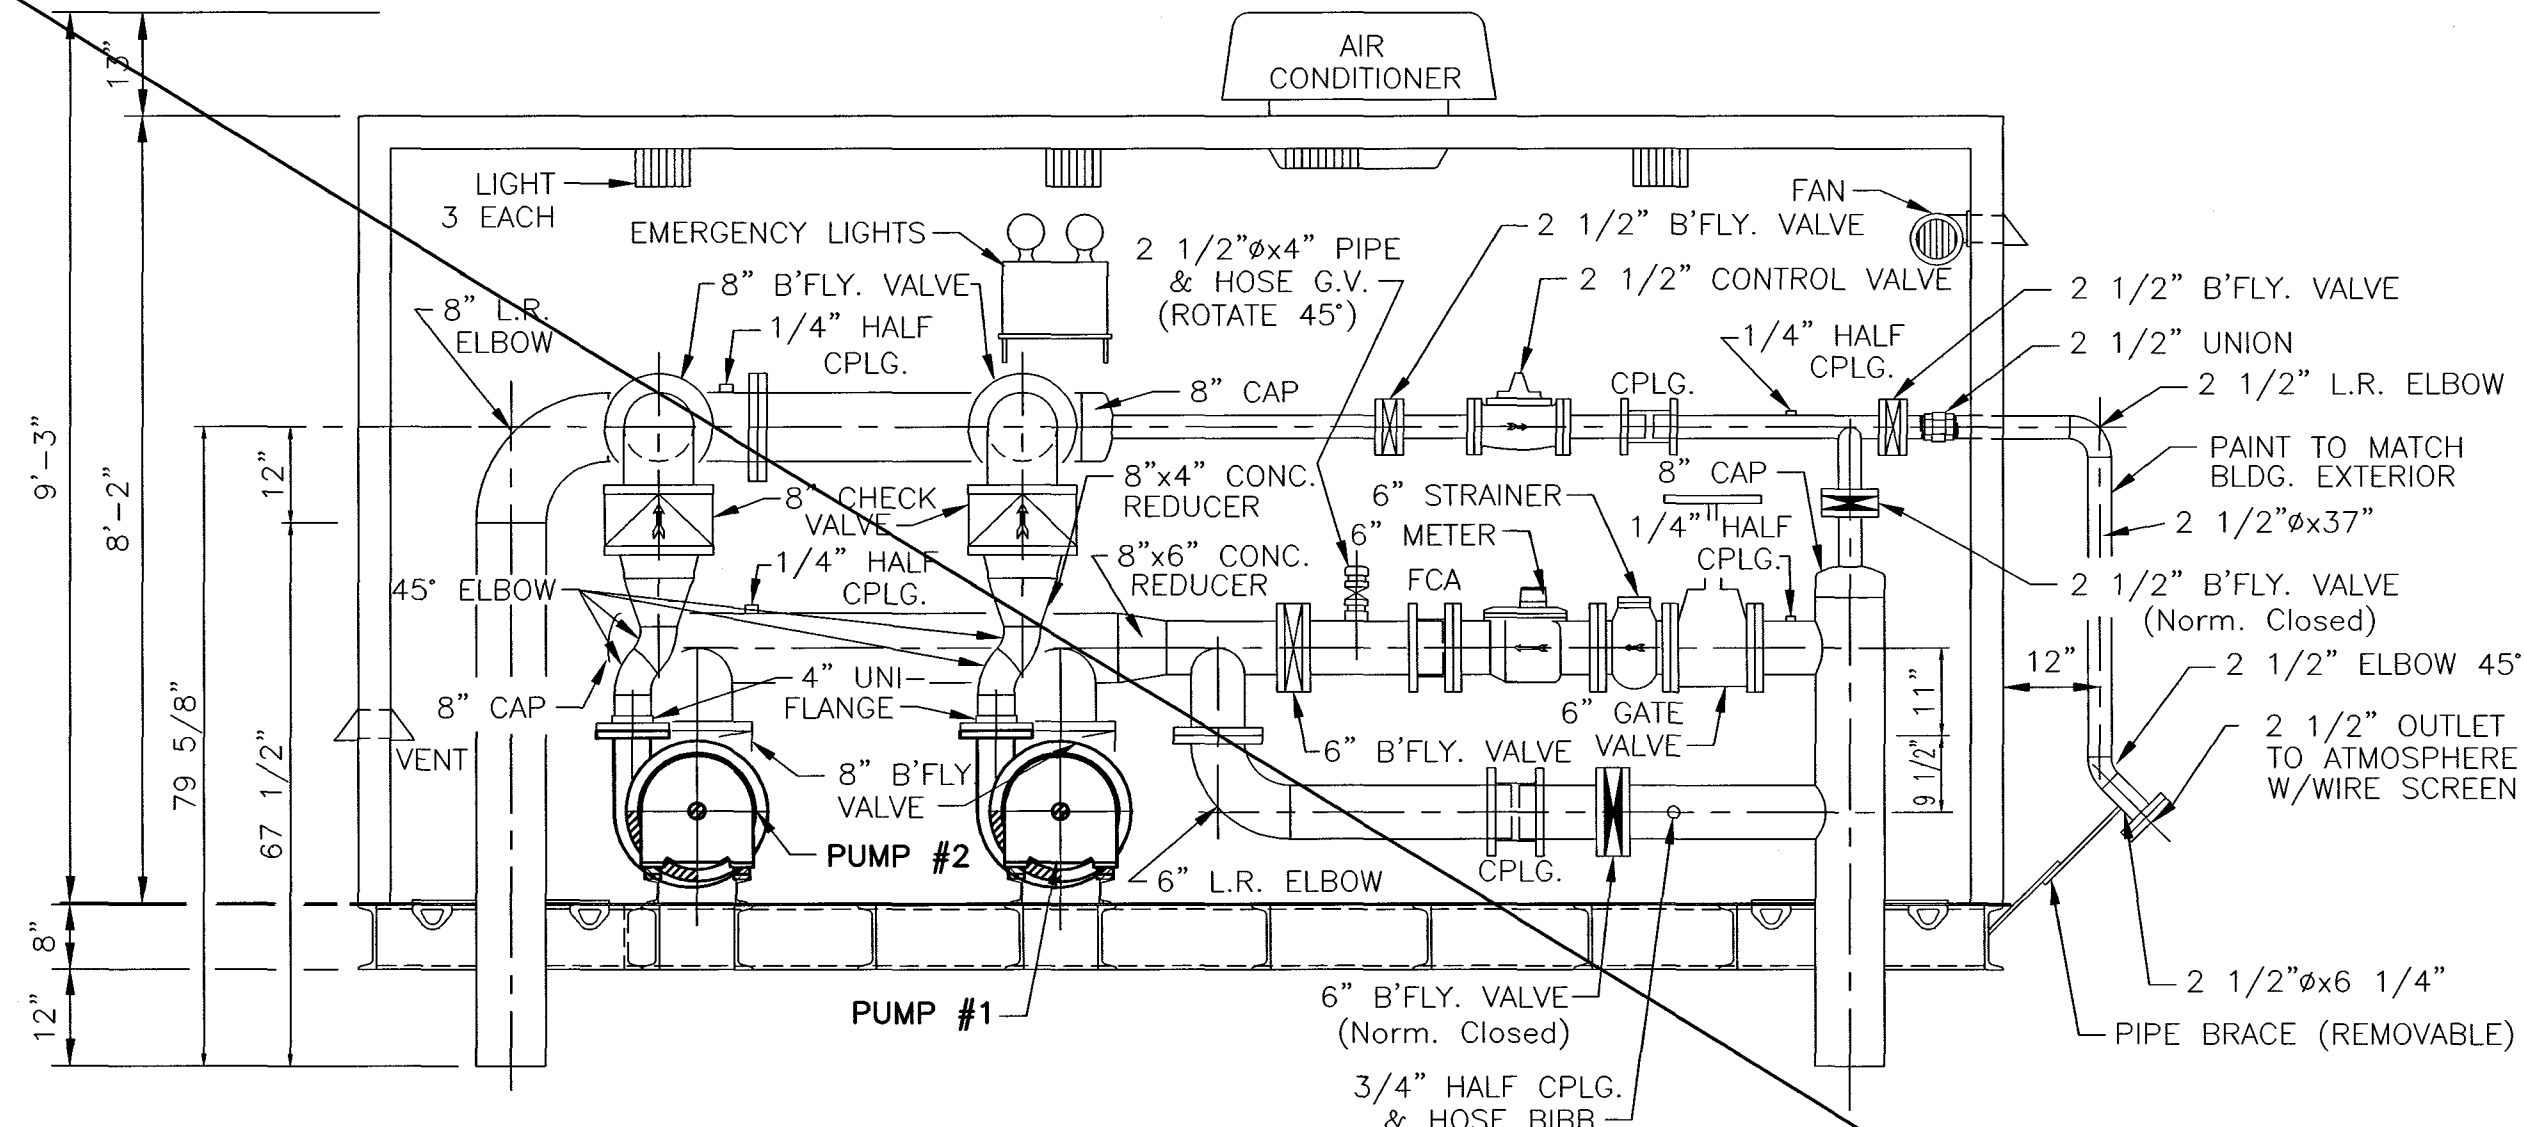


SECTION B-B

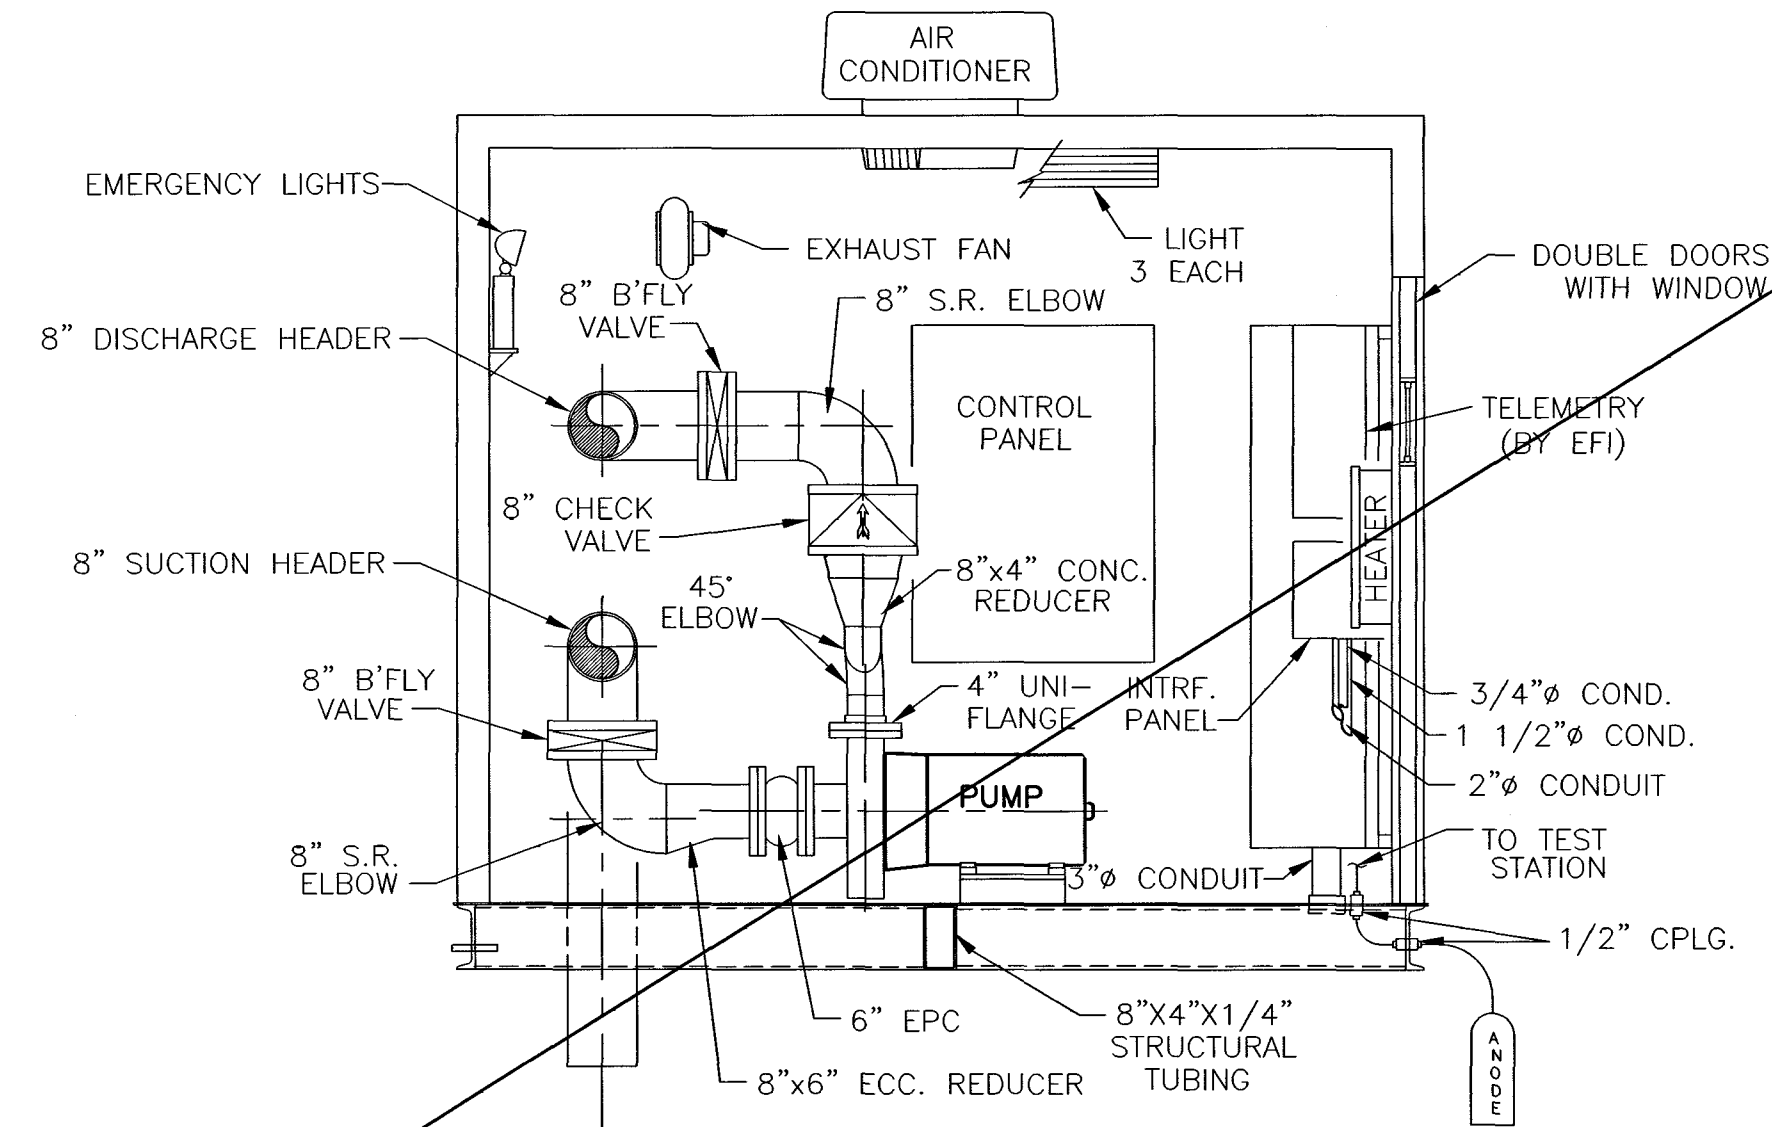

SECTION A-A

DELETED

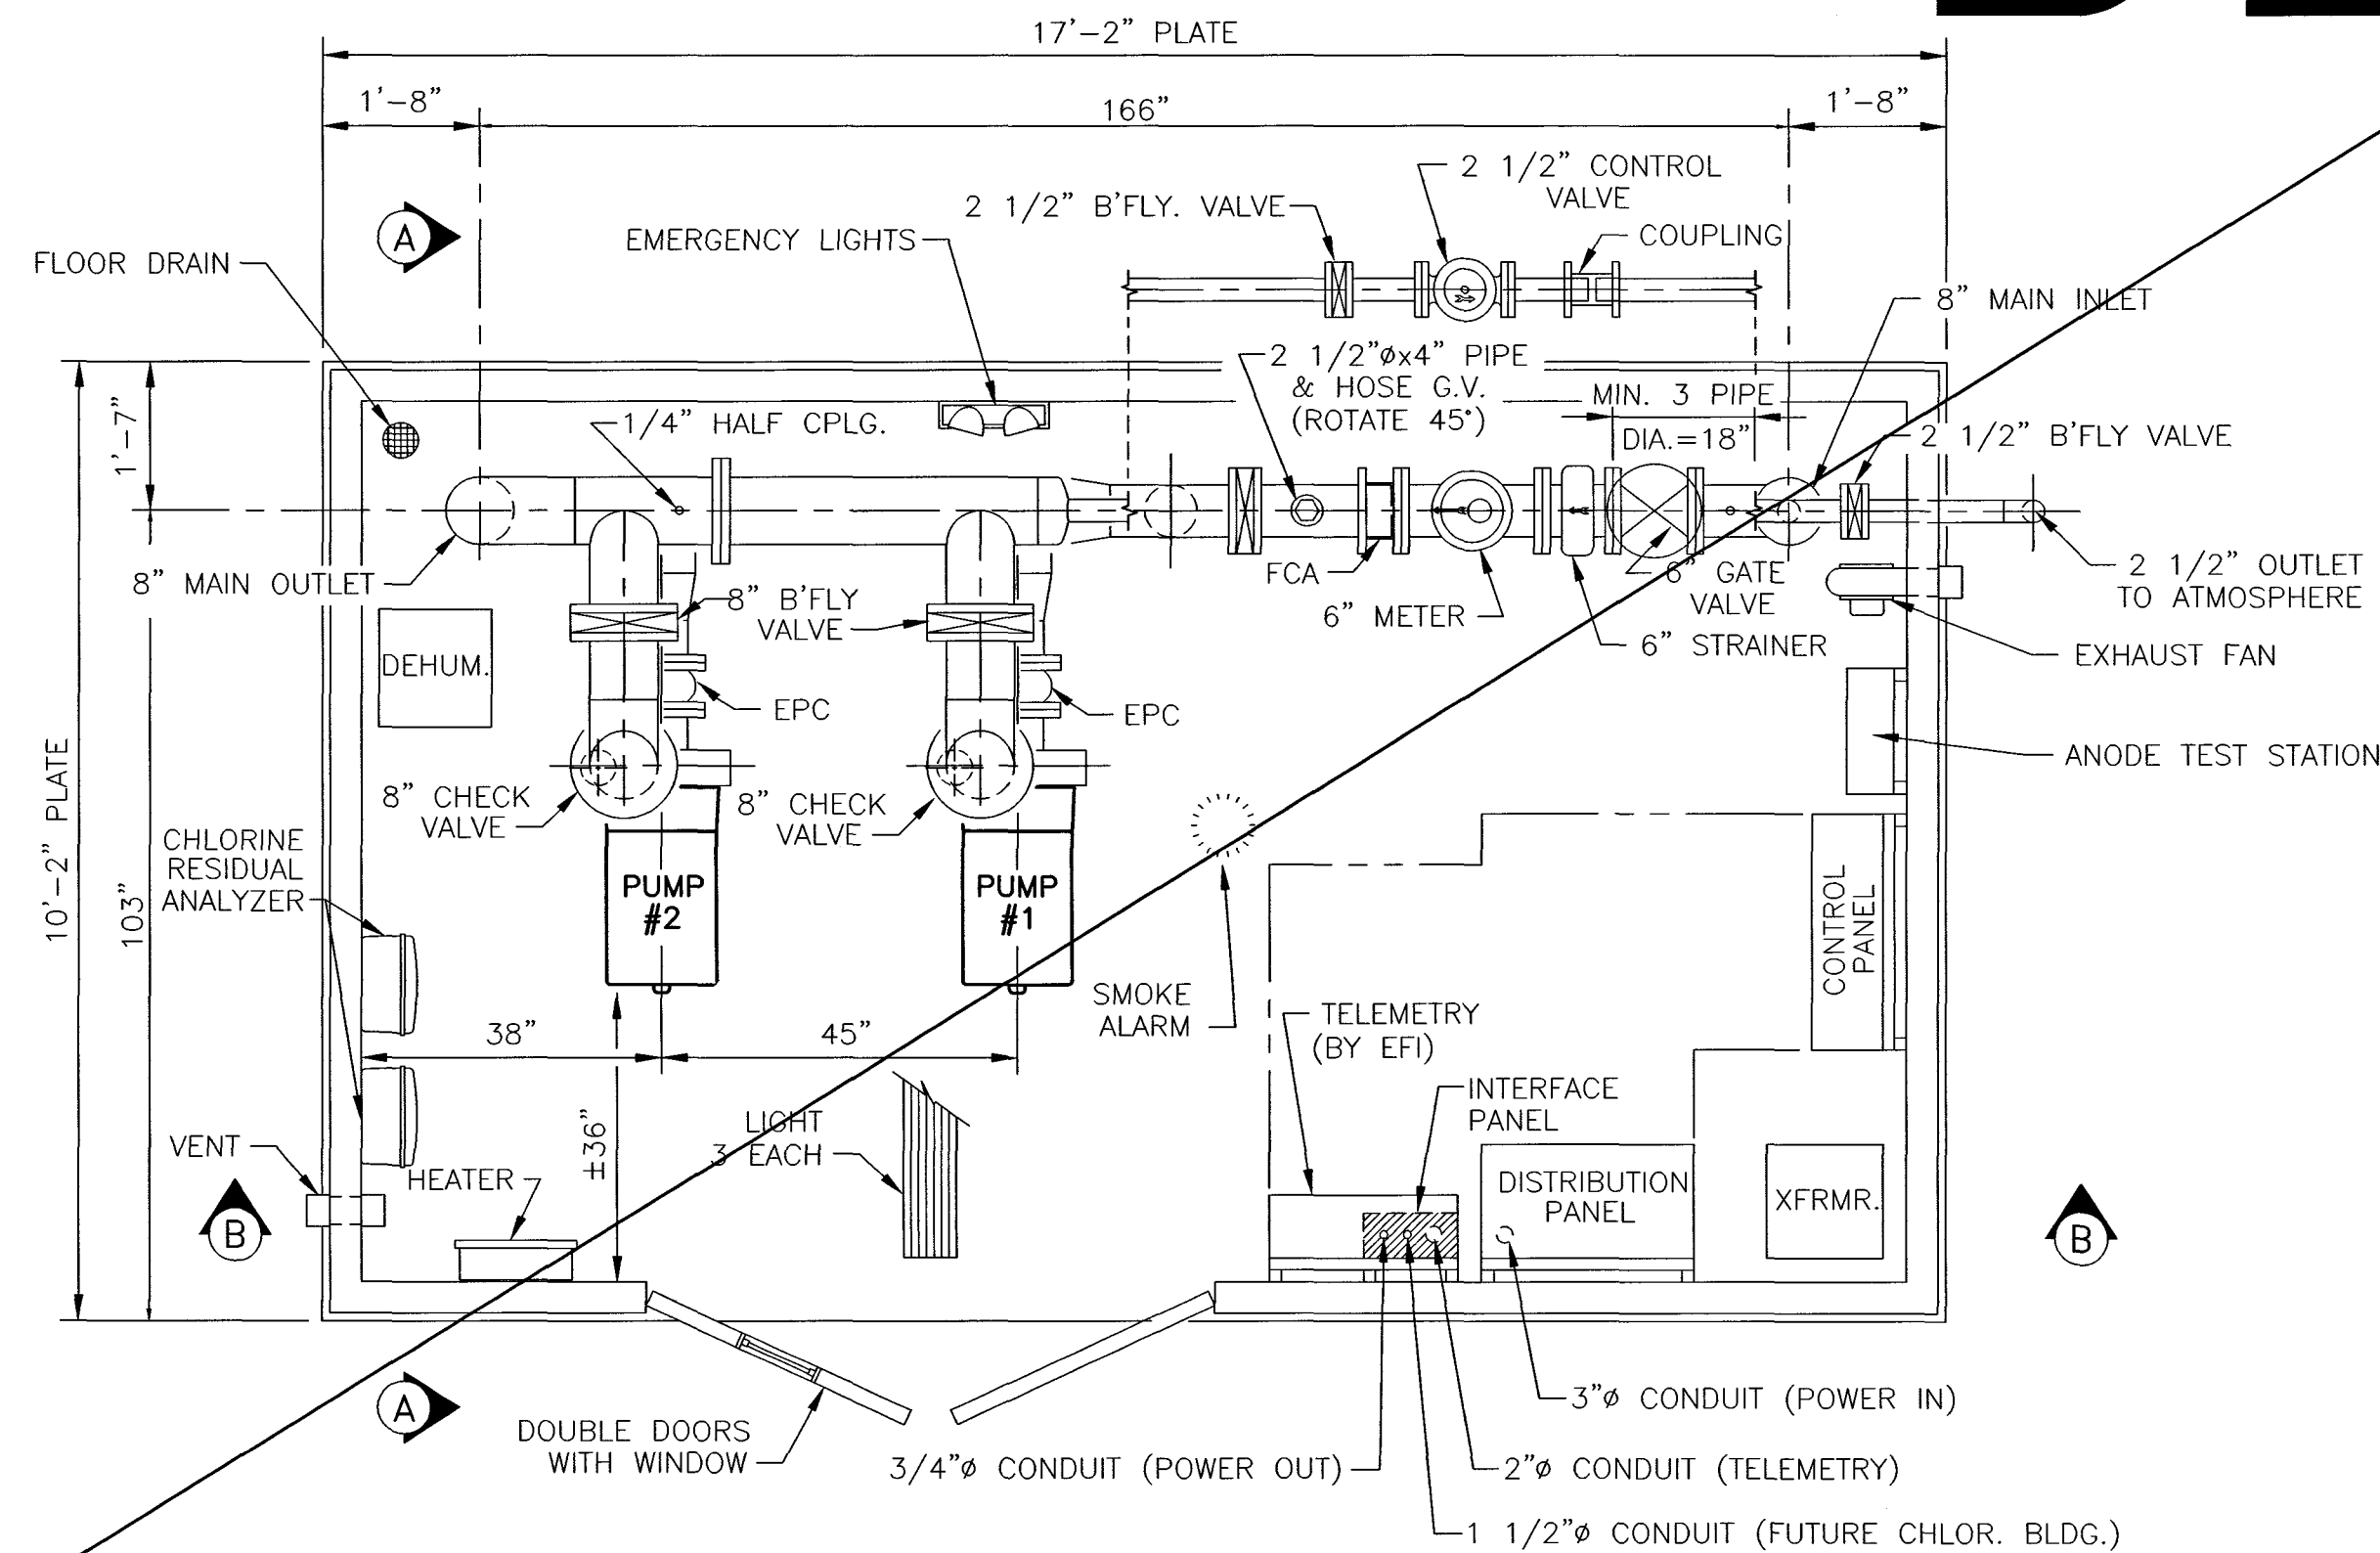

PLAN

DESIGN CRITERIA

Controls: TELEMETRY
Power Service: 480 Volts, 3 Phase, 60 Cycle


PUMP DATA

Type: HORIZ. CLOSE CPLD., END SUCTION
Pump: 1 & 2 REHAB
Capacity: 850 G.P.M. AT 93 FEET T.D.H.
Size: 4" X 6" X 12"
Motor: 30 H.P., 1800 R.P.M.

NOTES:

NO.	DESCRIPTION	DATE	BY
1	AS-BUILT	5/2004	MSB
REVISIONS			

HOOSIER HILLS REGIONAL
WATER DISTRICT
DIVISION "F" WATERWORKS SYSTEM IMPROVEMENTS
CONTRACT F-2
SPADES ROAD PUMP STATION REHAB
GRW PROJECT NO. 2745-04

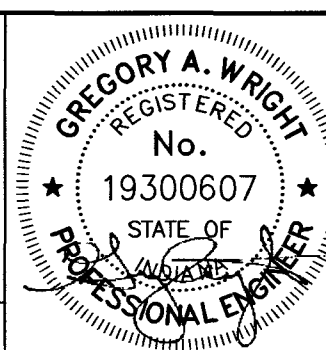

GRW Engineers, Inc.
Engineers, Architects, Planners
INDIANAPOLIS, INDIANA
LOUISVILLE & LEXINGTON, KENTUCKY
CINCINNATI, OHIO
NASHVILLE, TENNESSEE
ARLINGTON, TEXAS

DRAWN: BJD	DATE: JULY 2002
FILE NAME: SHEET581.DWG	SCALE: none
CHECKED:	SHEET NO.
APPROVED:	581