


I:\2745\dwg\sim - IDEM Elec Submittal\FINAL SET NO-3 July 3, 2002 Set of Dwg and Specs\FINAL F2 ELEC DWG\SCADA\Drawings\F2-1-Overall SCADA_REVISED.dwg, 11/15/2004 11:18:50 AM

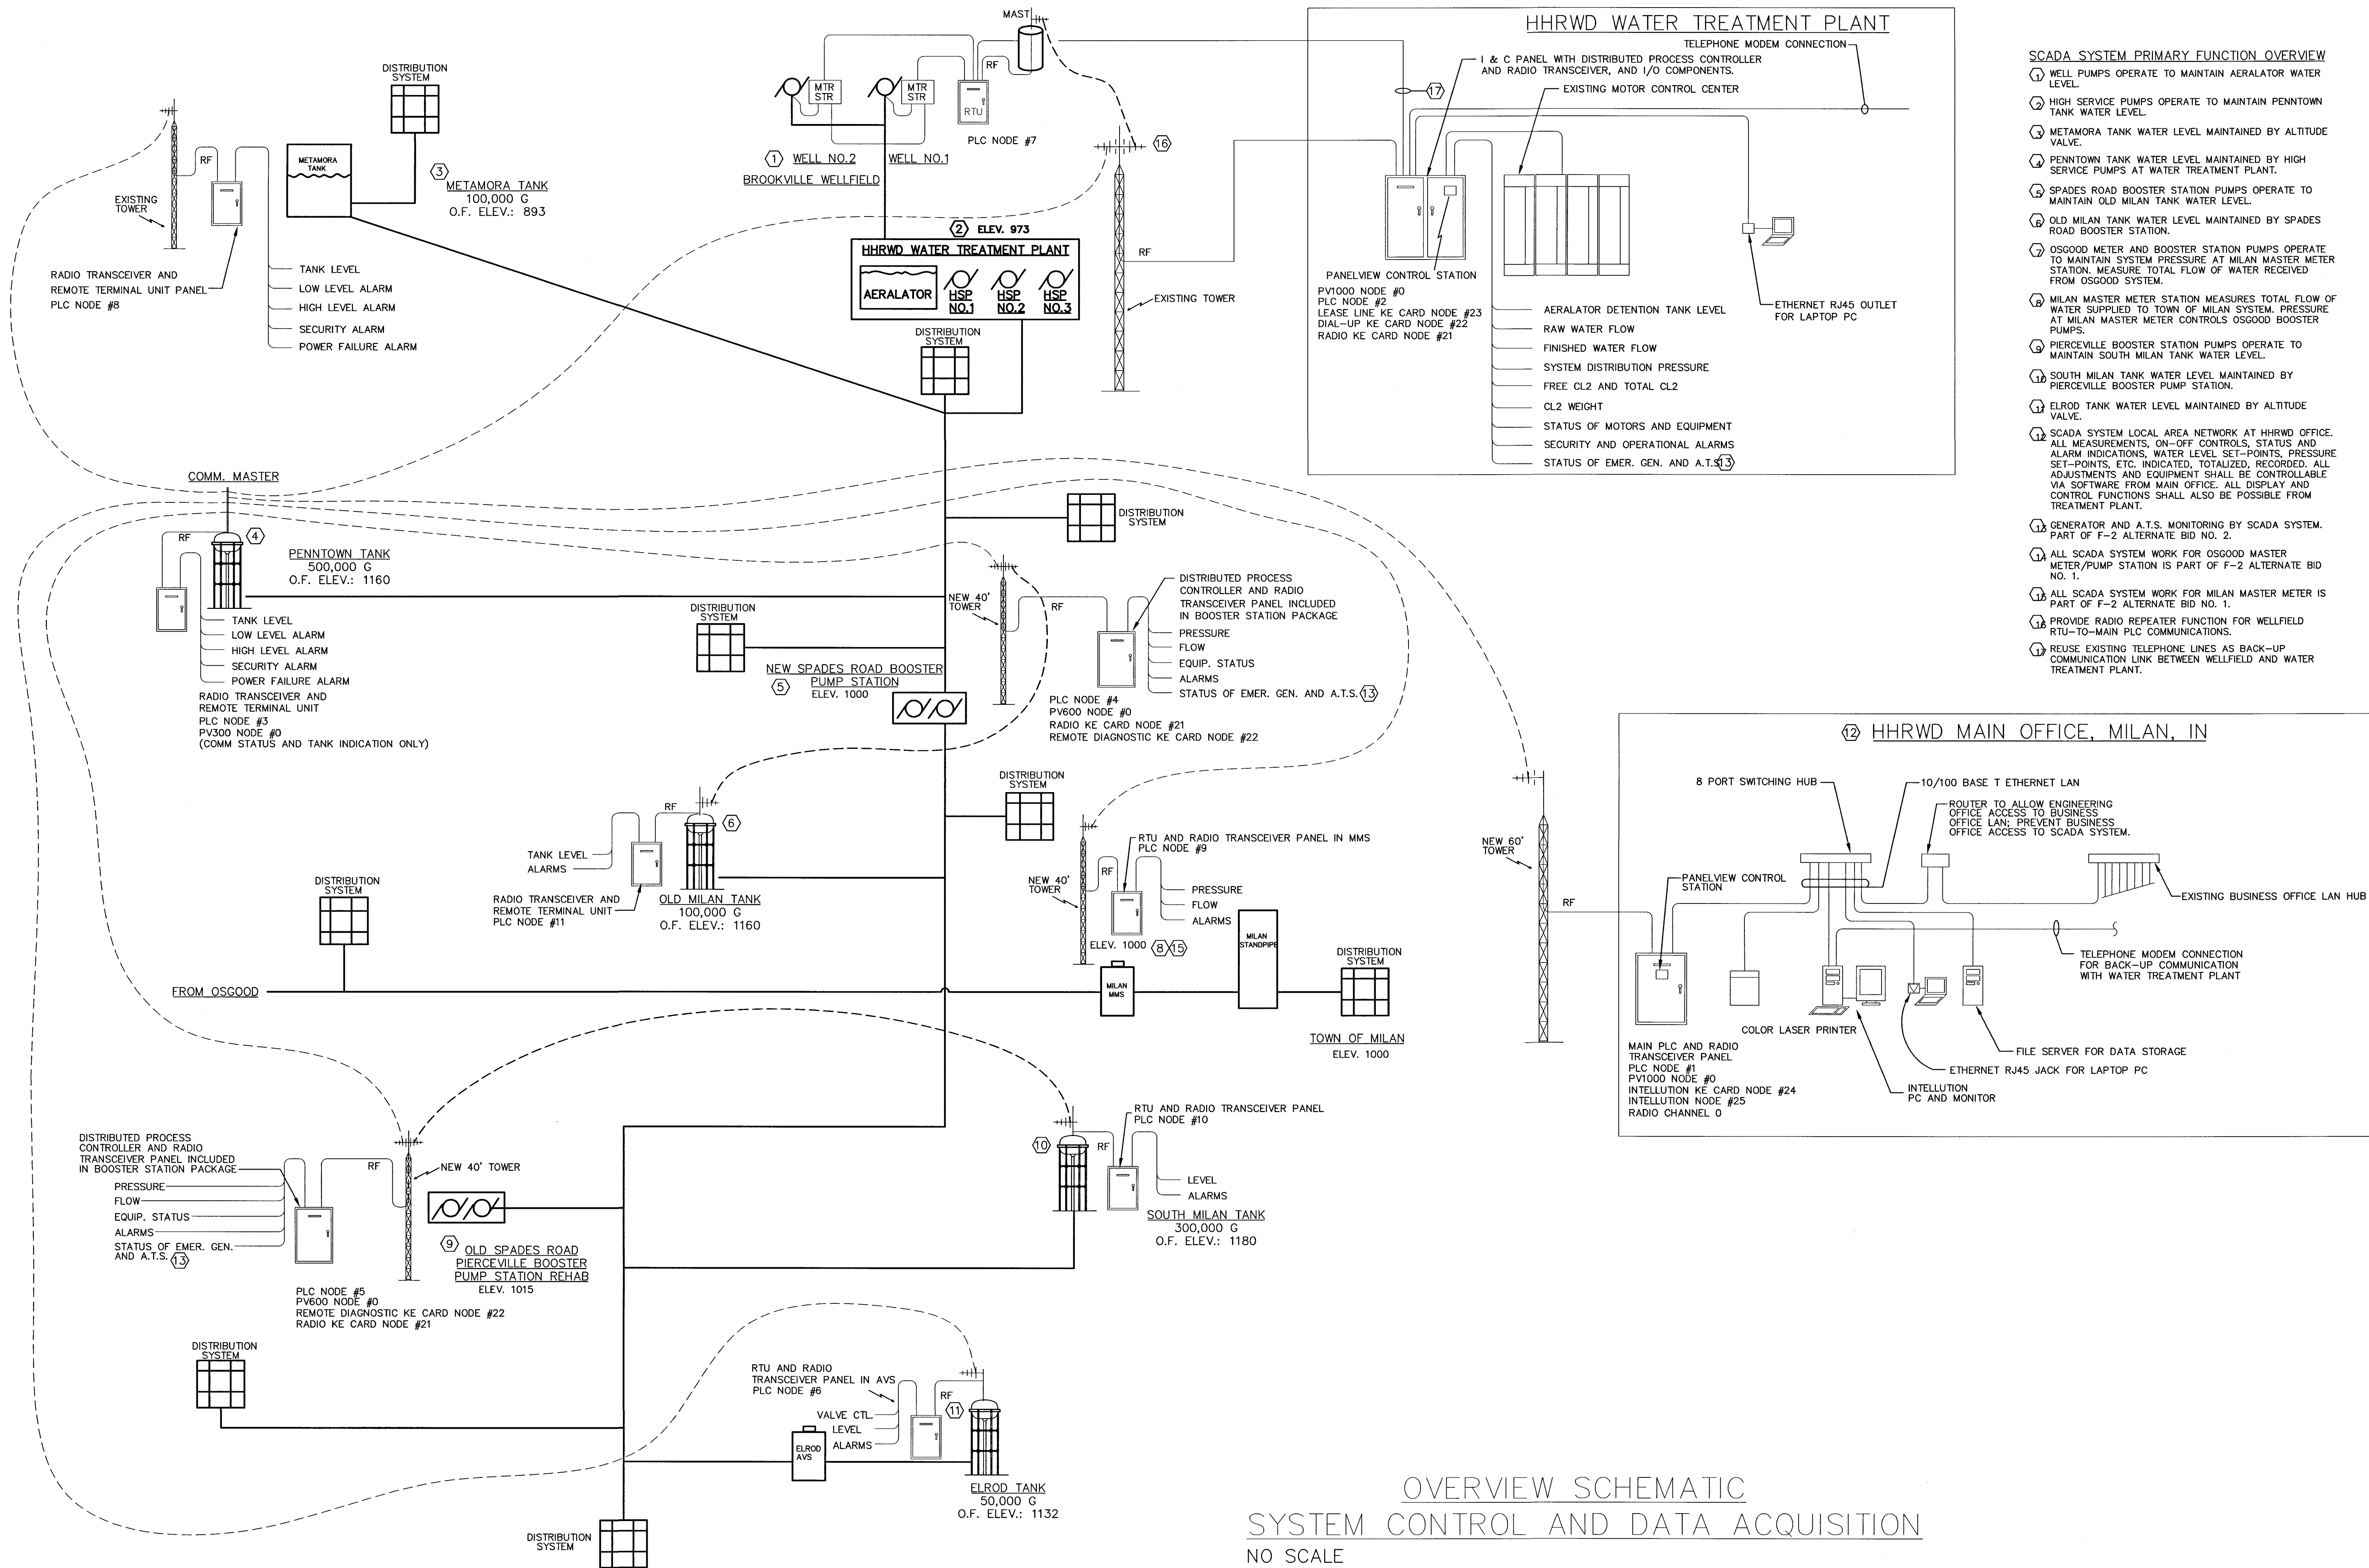


OVERVIEW SCHEMATIC
SYSTEM CONTROL AND DATA ACQUISITION
NO SCALE

NOTES:

J. W. SIMS & ASSOCIATES
ENGINEERING COMPANY
1545 COUNTRY CLUB ROAD
INDIANAPOLIS, INDIANA 46234
(317) 209-4035 (FAX) 209-403

NO.	DESCRIPTION	DATE	BY
1	AS-BUILT REVISION	5/2004	GCR
REVISIONS			

HOOSIER HILLS REGIONAL WATER DISTRICT DIVISION "F" WATERWORKS SYSTEM IMPROVEMENTS CONTRACT F-2	
SCADA SYSTEM OVERVIEW	
GRW PROJECT NO. 2745	JWSA PROJECT NO. 2001-05

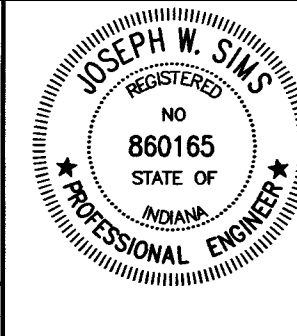

GRW Engineers, Inc.
Engineers, Architects, Planners
INDIANAPOLIS, INDIANA
LOUISVILLE & LEXINGTON, KENTUCKY
CINCINNATI, OHIO
NASHVILLE, TENNESSEE
ARLINGTON, TEXAS

DRAWN: JWS	DATE: NOVEMBER, 2001
FILE NAME: F2-E1_REVISED.DWG	SCALE: AS NOTED
CHECKED: JWS	SHEET NO.
APPROVED: JWS	E1/582