




ELEVATED WATER STORAGE TANK
SCALE: N.T.S.

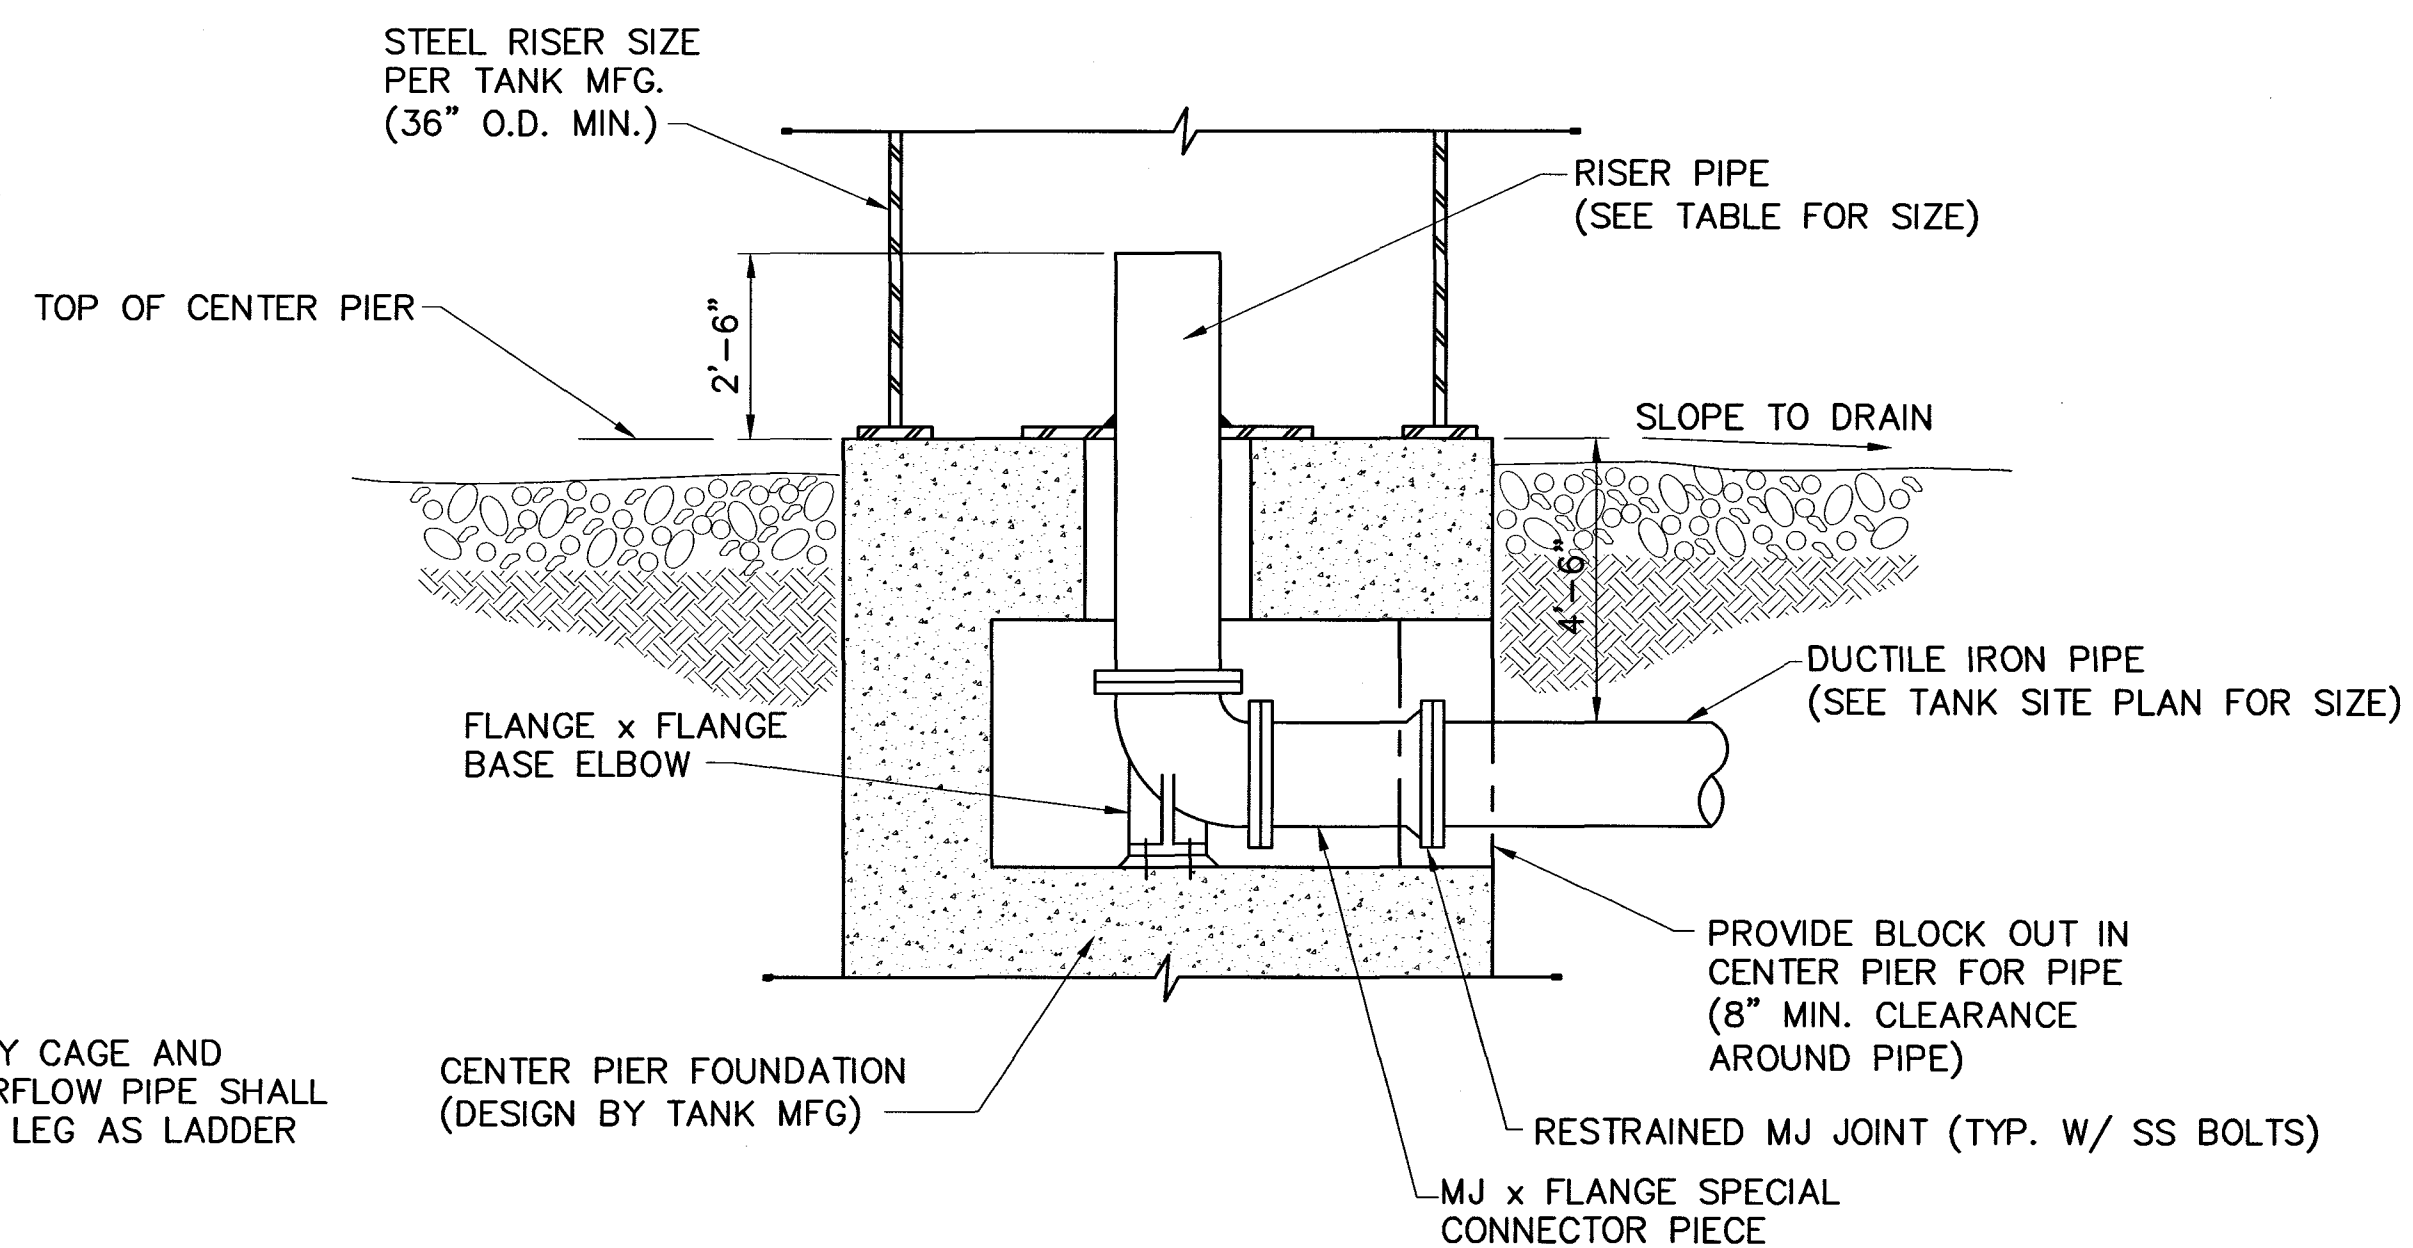


CENTER PIER AND INFLUENT PIPING DETAIL
SCALE: N.T.S.

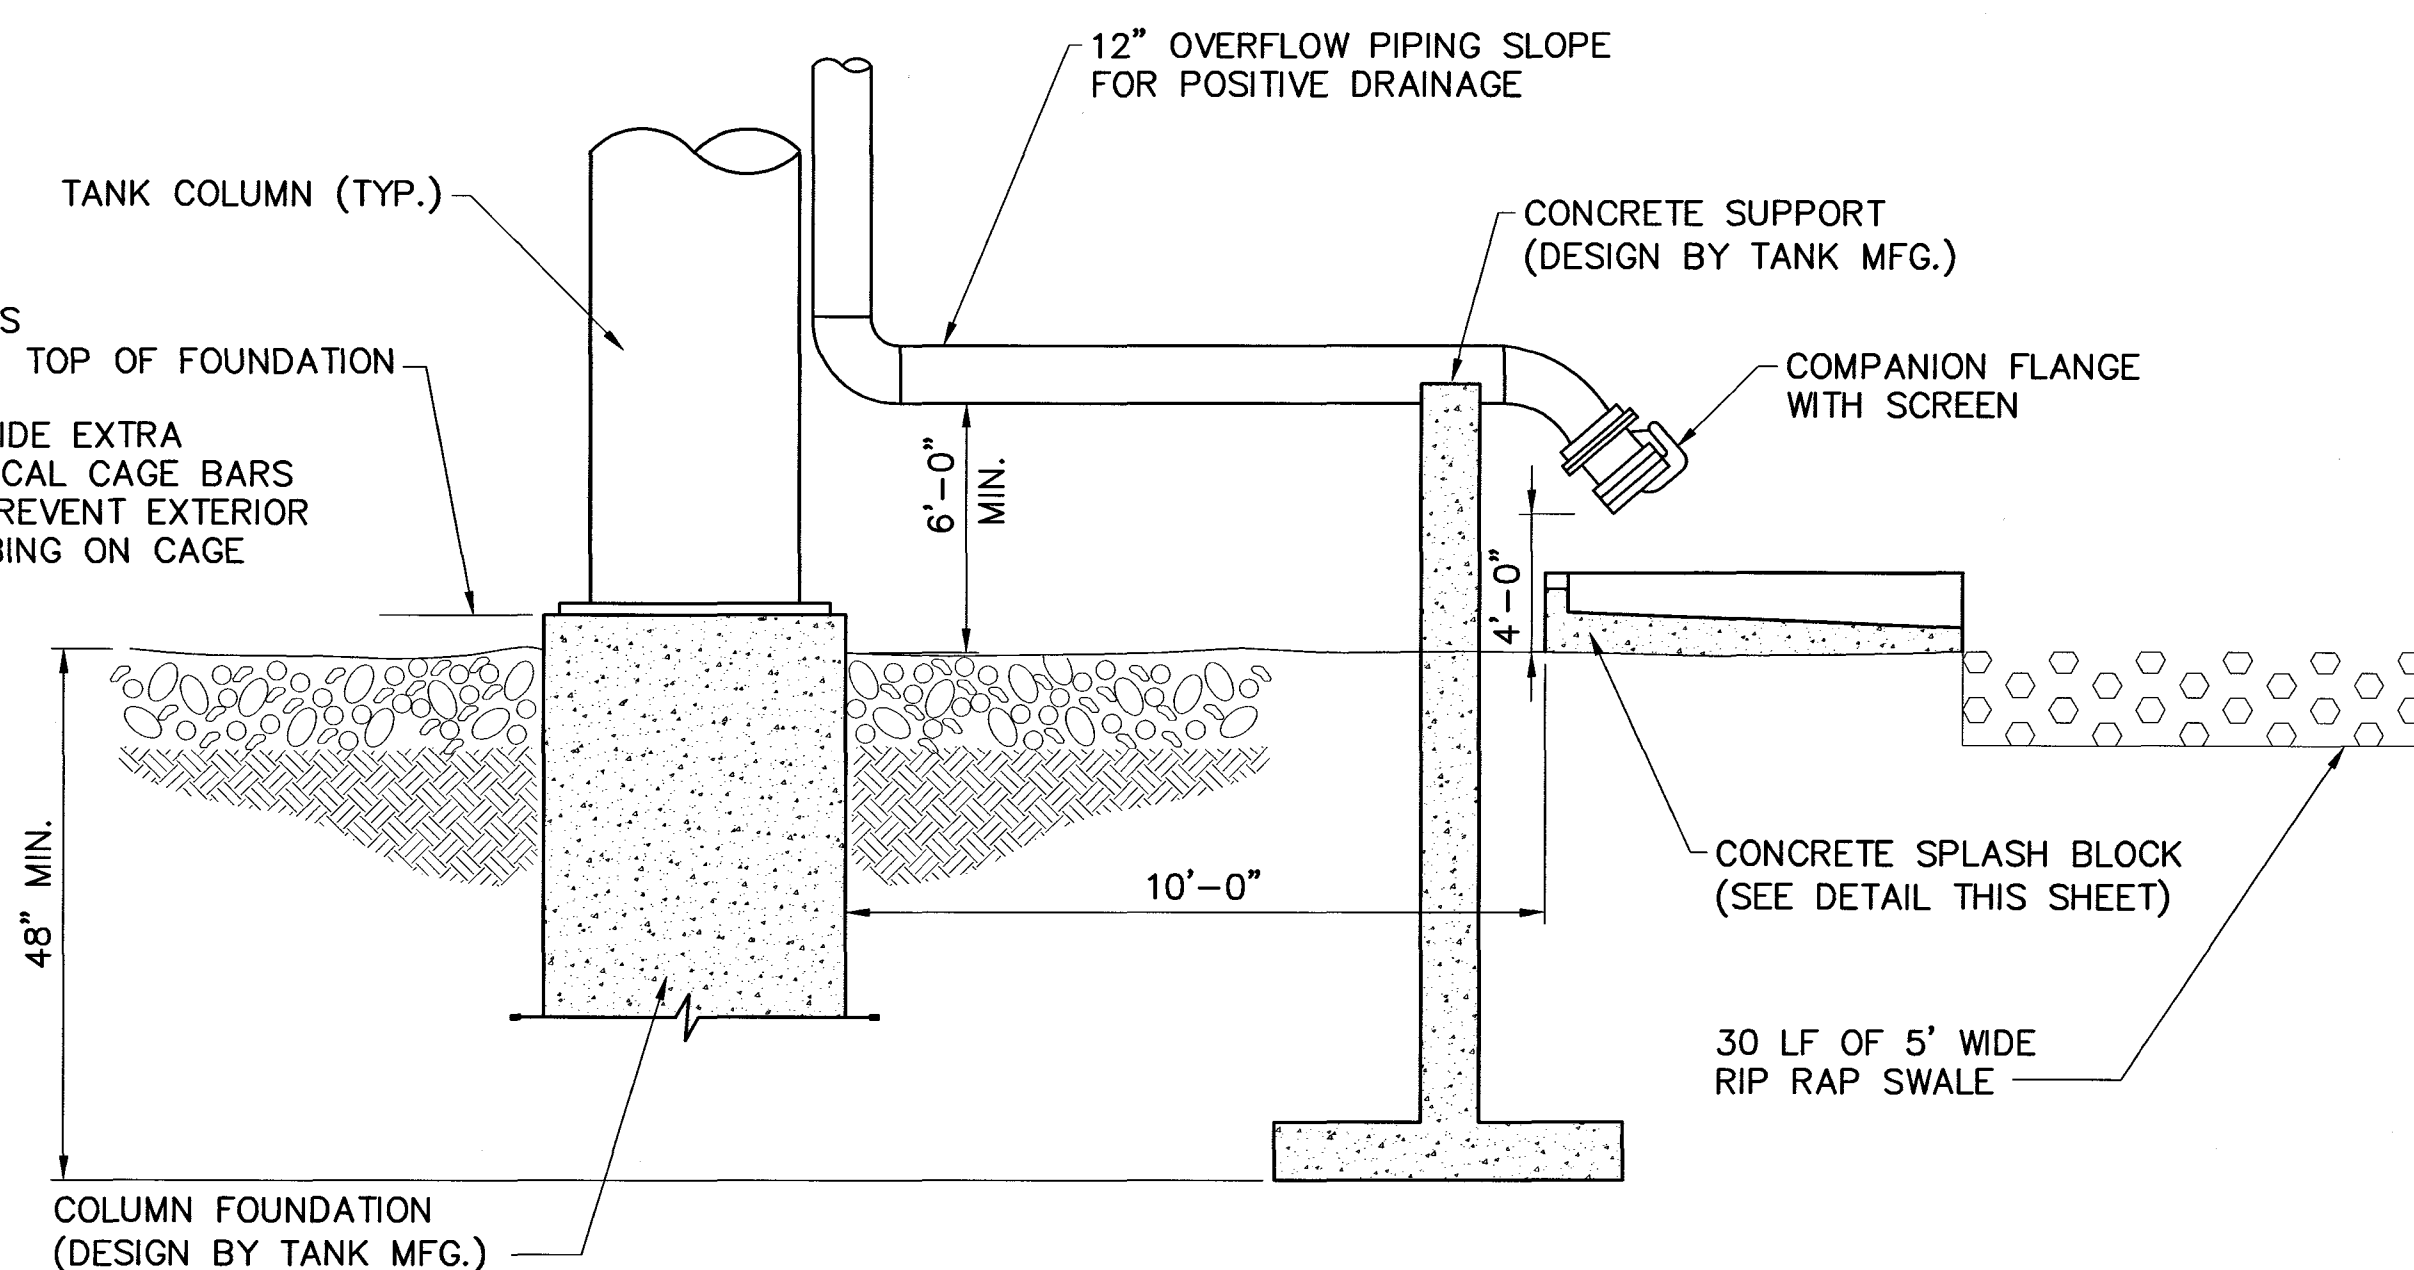

COLUMN FOUNDATION AND OVERFLOW DETAIL
SCALE: N.T.S.

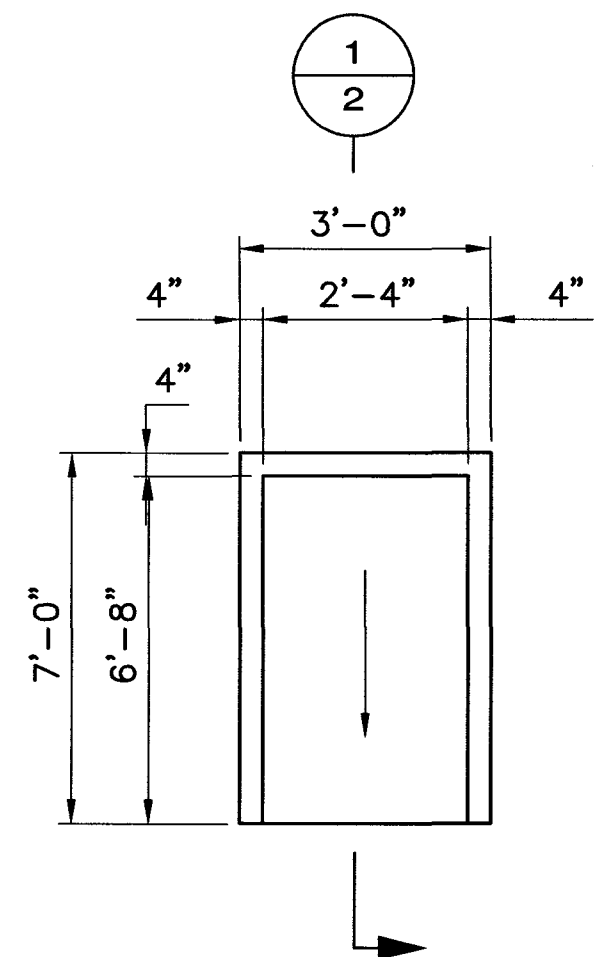

CONC. SPLASH BLOCK - PLAN
SCALE: N.T.S.

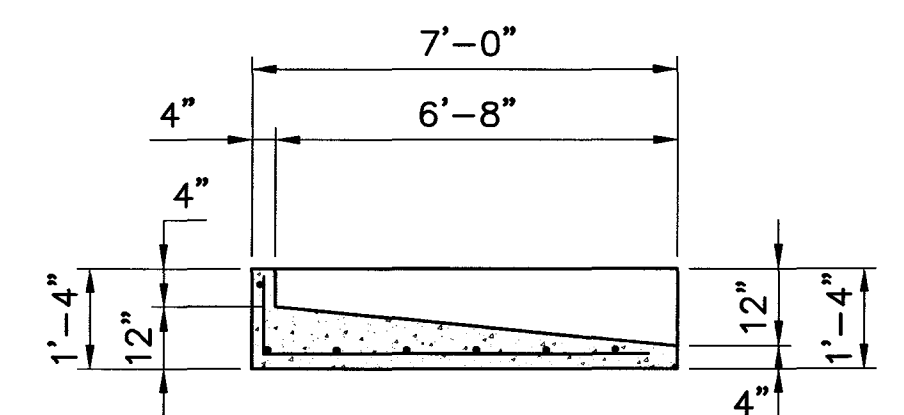

SECTION
SCALE: N.T.S.

TANK INFORMATION	
GALLONS	300,000
TANK DIAMETER	43'-0"
HIGH WATER LEVEL H.W.L.	1180.00
ELEV. @ TOP OF FDN.	981.00
HEAD RANGE	30'-0"
TOP OF FDN. TO H.W.L.	199'-0"
TOP OF FDN. TO L.W.L.	169'-0"
RISER PIPE SIZE	12"

RECORD DRAWING

This drawing has been revised from the original contract drawing to show minor design changes made during construction. This drawing is not intended to be complete and accurate to all respects.

GRW Engineers, Inc.

Date: 5/2004 By: MB

NOTES:


NO.	DESCRIPTION	DATE	BY
1	AS-BUILT REVISIONS	5/2004	MSB
REVISIONS			

HOOSIER HILLS REGIONAL
WATER DISTRICT

DIVISION "F" WATERWORKS SYSTEM IMPROVEMENTS
CONTRACT F-3

SOUTH MILAN TANK DETAILS

GRW PROJECT NO. 2745-04

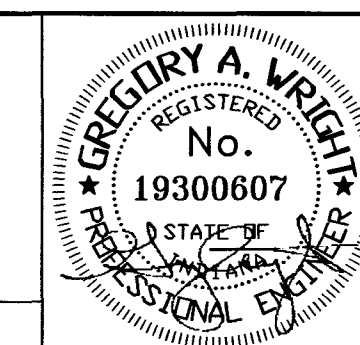

GRW Engineers, Inc.
Engineers, Architects, Planners

INDIANAPOLIS, INDIANA
LOUISVILLE & LEXINGTON, KENTUCKY
CINCINNATI, OHIO
NASHVILLE, TENNESSEE
ARLINGTON, TEXAS

DRAWN: BJD
FILE NAME: SHT.597
CHECKED:
APPROVED:

DATE: JULY 2002
SCALE: N.T.S.
SHEET NO. 597