

HOOSIER HILLS REGIONAL WATER DISTRICT

DIVISION "G" WATERWORKS SYSTEM IMPROVEMENTS



CONTRACT G-1: WELLFIELD AND WATER TREATMENT PLANT IMPROVEMENTS
CONTRACT G-5: NEW CLEARWELL

RECORD DRAWINGS

HOOSIER HILLS REGIONAL WATER DISTRICT BOARD OF DIRECTORS

GREGORY DOLE – PRESIDENT
RANDY SCUDDER – VICE PRESIDENT
CHARLES HYNES – SECRETARY
ANDREW WEISENBACH – TREASURER
JOHN AMBERGER – ASST. TREASURER
TED MEER – BOARD MEMBER
ROY B. MEYER – BOARD MEMBER
RUSSELL MORTARA – BOARD MEMBER
ANTHONY CLARK – BOARD MEMBER
SCOTT STIRN – GENERAL MANAGER




| CONTRACT G-1 | CONTRACT G-5 |
|---|---|
| <small>THIS RECORD DOCUMENT HAS BEEN PREPARED BASED ON INFORMATION PROVIDED BY THE CONSTRUCTION CONTRACTOR. GRW ENGINEERS, INC. HAS ATTEMPTED TO VERIFY THE ACCURACY AND/OR COMPLETENESS OF THIS INFORMATION BUT SHALL NOT BE RESPONSIBLE FOR ANY ERRORS OR OMISSIONS WHICH MAY BE INCORPORATED HEREIN AS A RESULT.</small> | <small>THIS RECORD DOCUMENT HAS BEEN PREPARED BASED ON INFORMATION PROVIDED BY THE CONSTRUCTION CONTRACTOR. GRW ENGINEERS, INC. HAS ATTEMPTED TO VERIFY THE ACCURACY AND/OR COMPLETENESS OF THIS INFORMATION BUT SHALL NOT BE RESPONSIBLE FOR ANY ERRORS OR OMISSIONS WHICH MAY BE INCORPORATED HEREIN AS A RESULT.</small> |
|  engineering architecture geospatial |  engineering architecture geospatial |
| ENGINEER/ARCHITECT: <u>DARREN S. WELLS</u> | ENGINEER/ARCHITECT: <u>DARREN S. WELLS</u> |
| CONSTRUCTION COMPANY: <u>Mitchell & Stark Const. Co., Inc.</u> | CONSTRUCTION COMPANY: <u>NATGUN CORPORATION</u> |
| DATE: <u>FEBRUARY 2014</u> | DATE: <u>FEBRUARY 2014</u> |

This document, originally issued, sealed, and signed by Darren S. Wells, Indiana Professional Engineer, No. 10100200, on March 26, 2012, shall not be used in lieu of a certified document.

DARREN S. WELLS, P.E.
INDIANA REG. NO. 10100200

DATE: 3-26-12

MARCH 2012

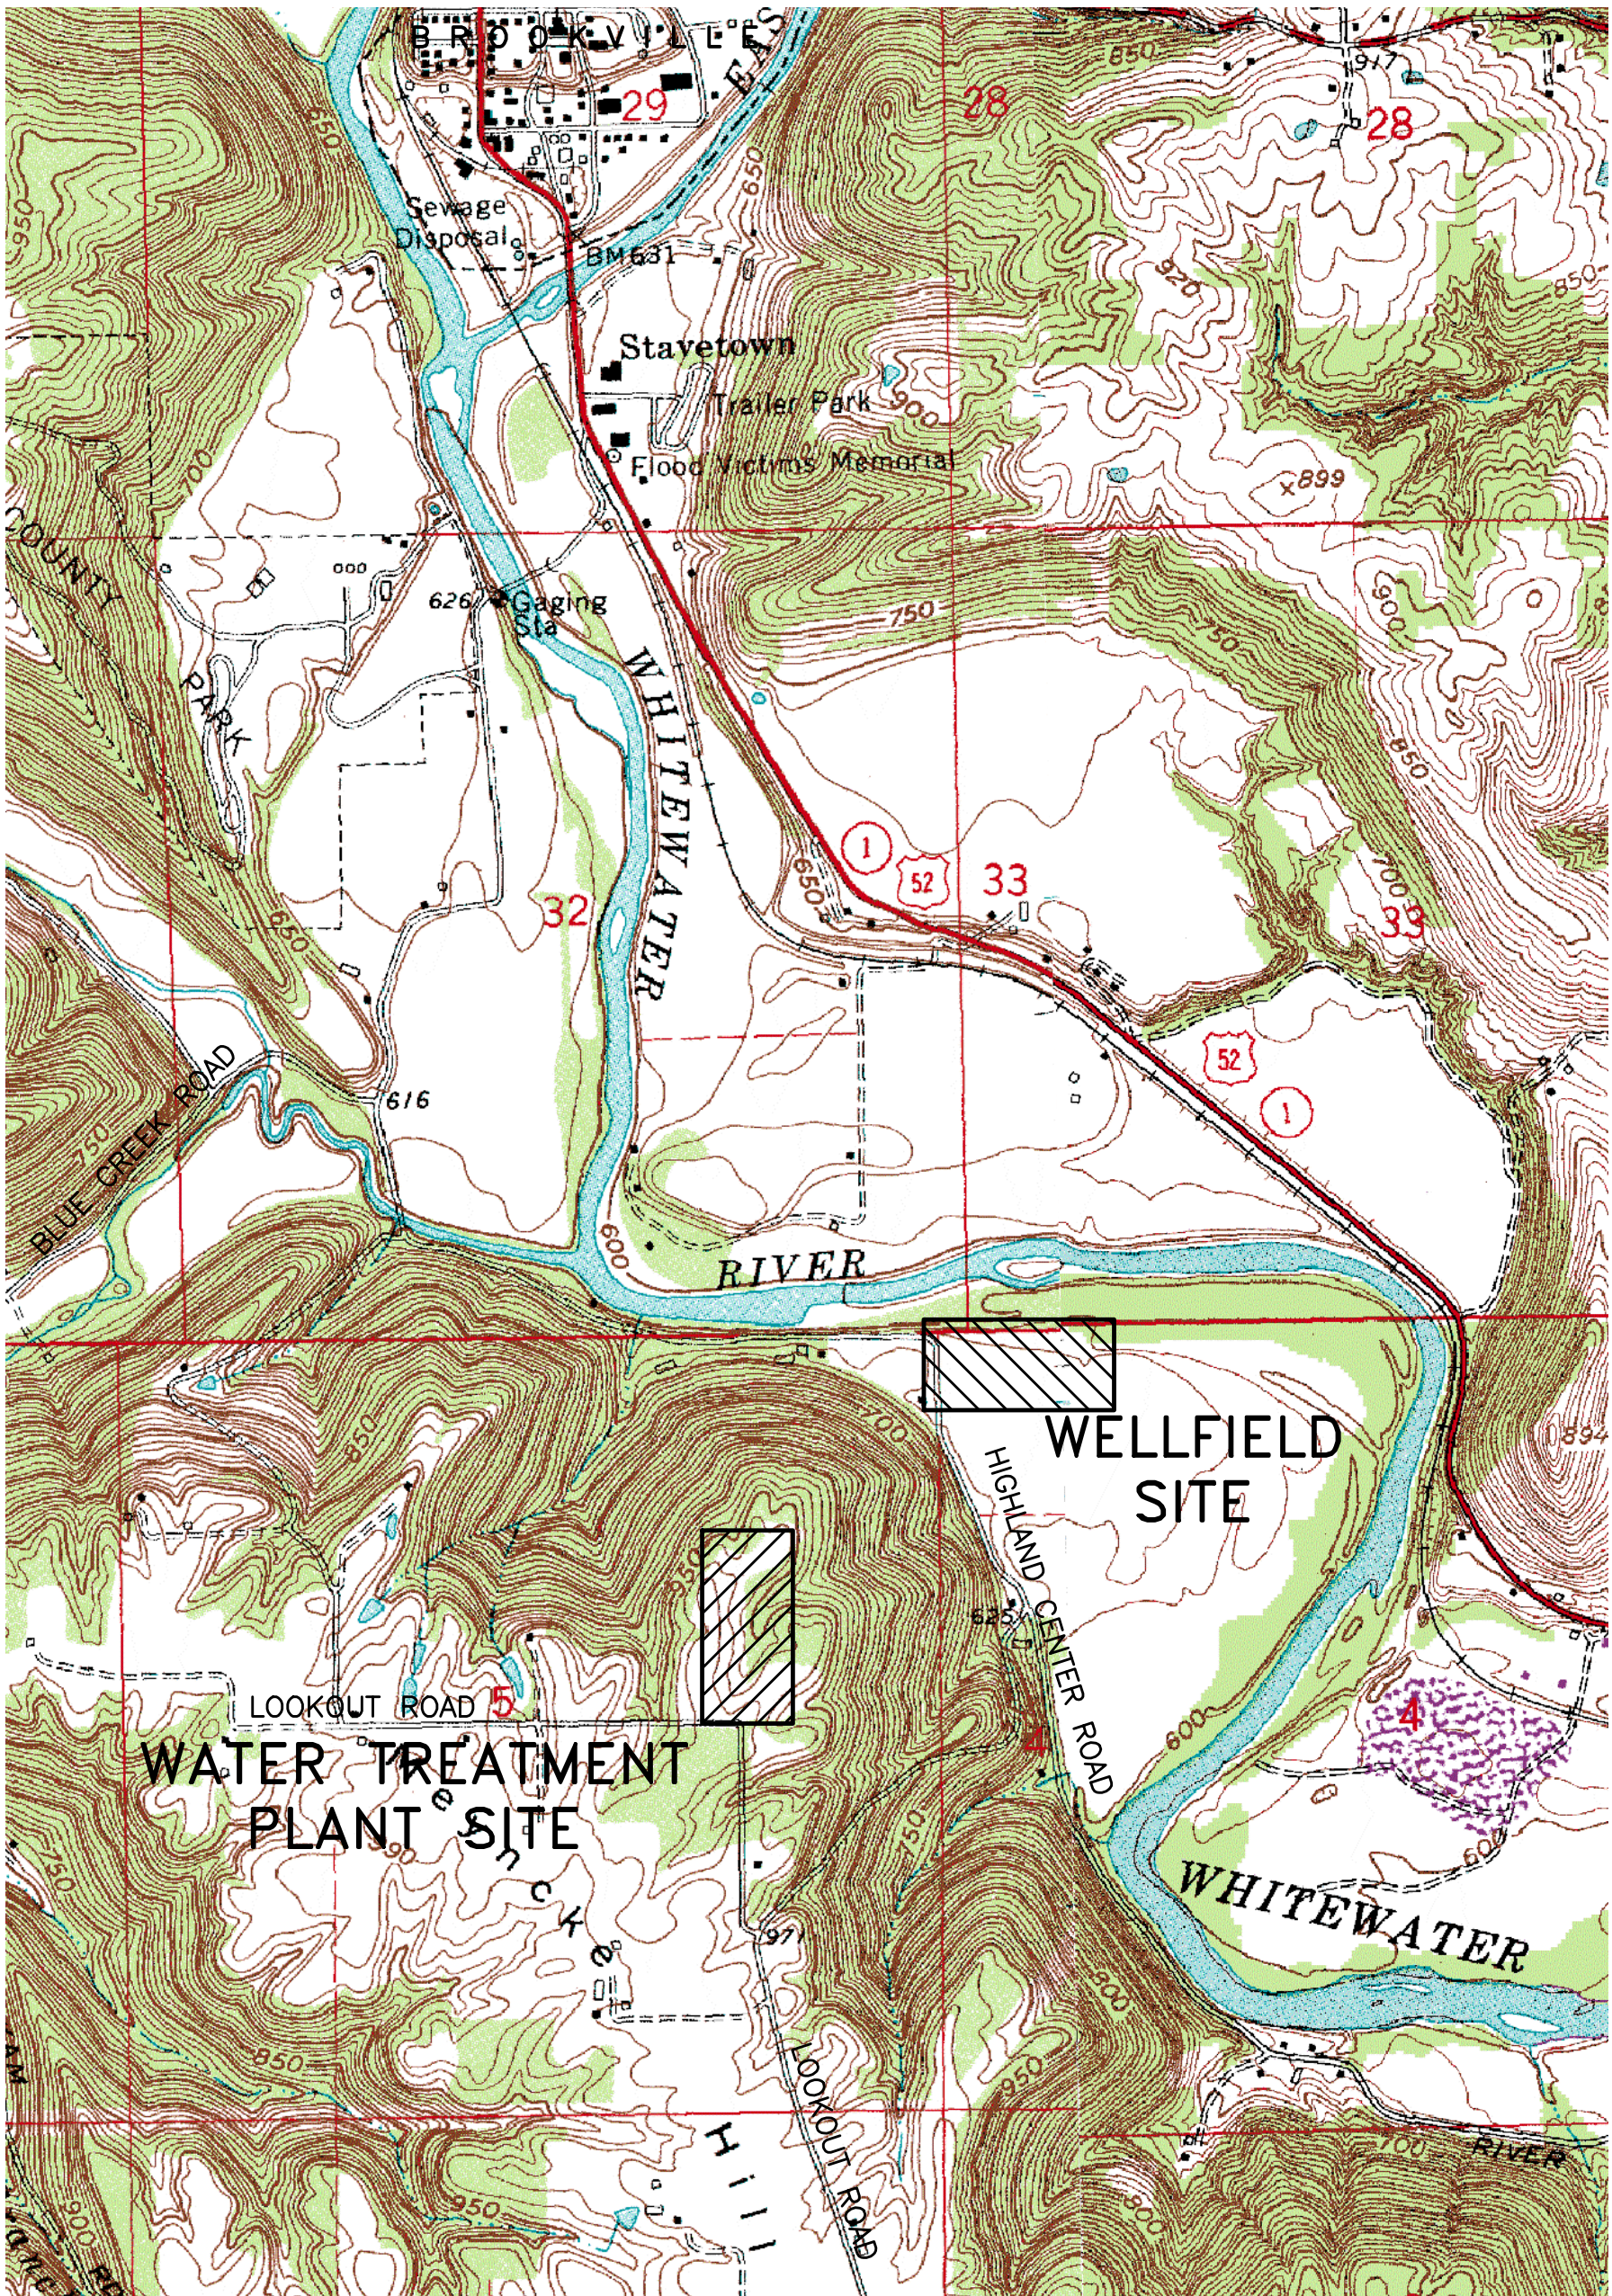

GRW PROJECT NO. 3235-04