

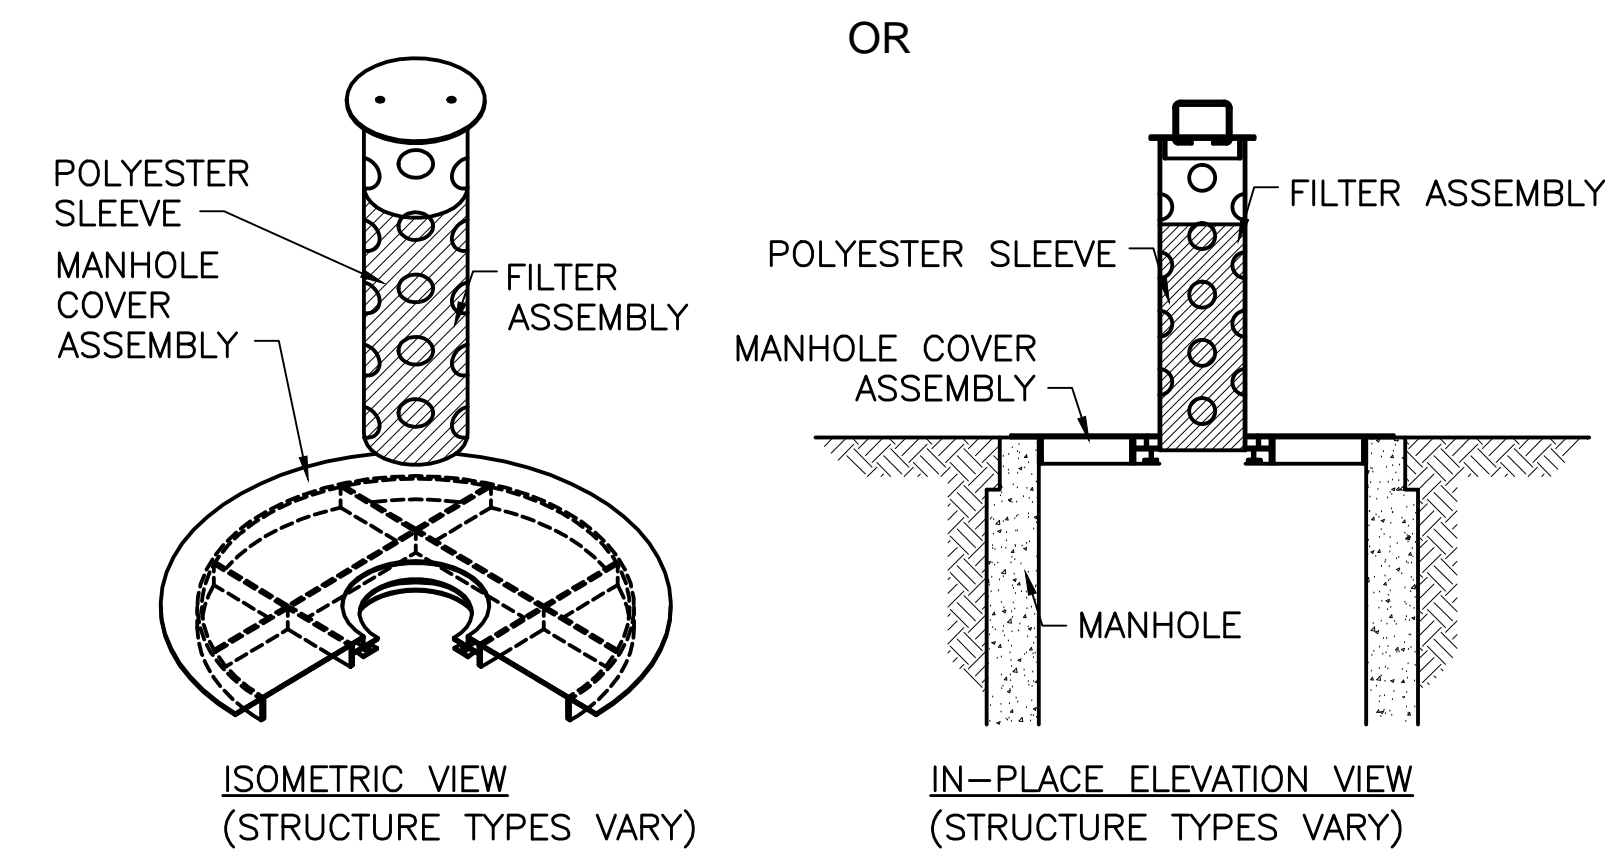


PRINTED: 2/25/2014 @ 9:57AM

FILE NAME: I:\3235 - HHRWD - Division G\Drawn\Design\G-1\Drawn\3235-G-1-C-06.dwg

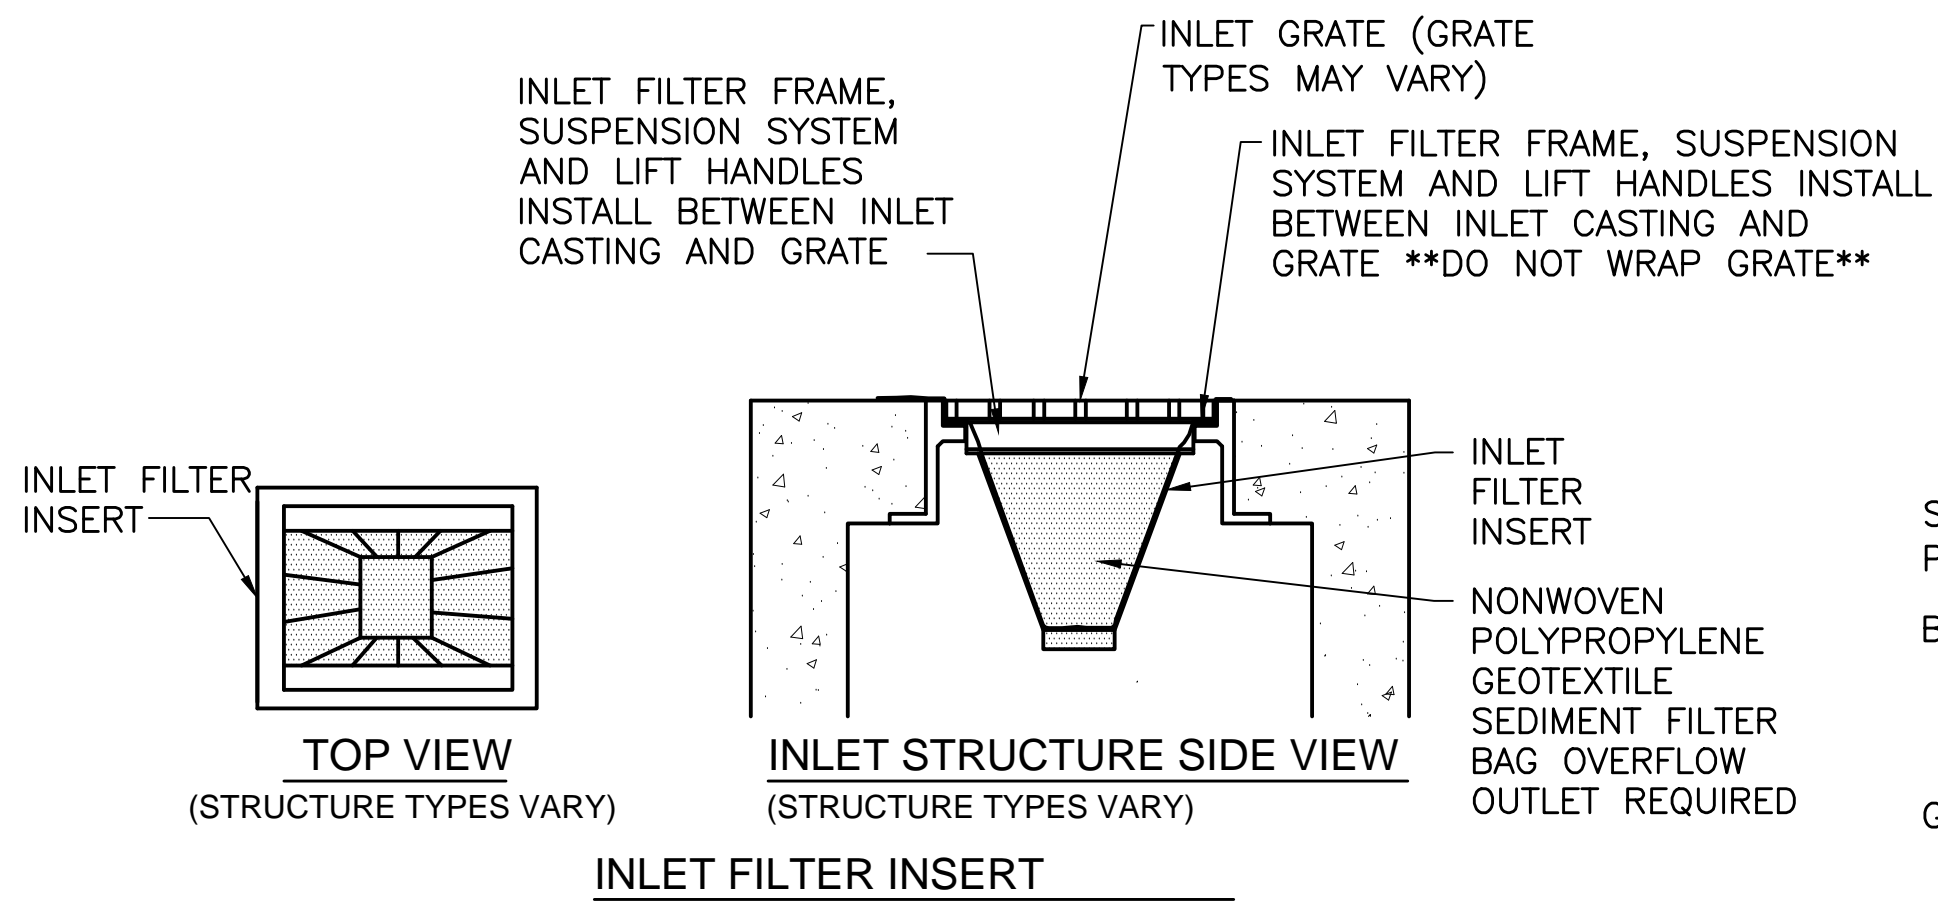


ROAD DRAIN TOP SLAB INLET PROTECTION

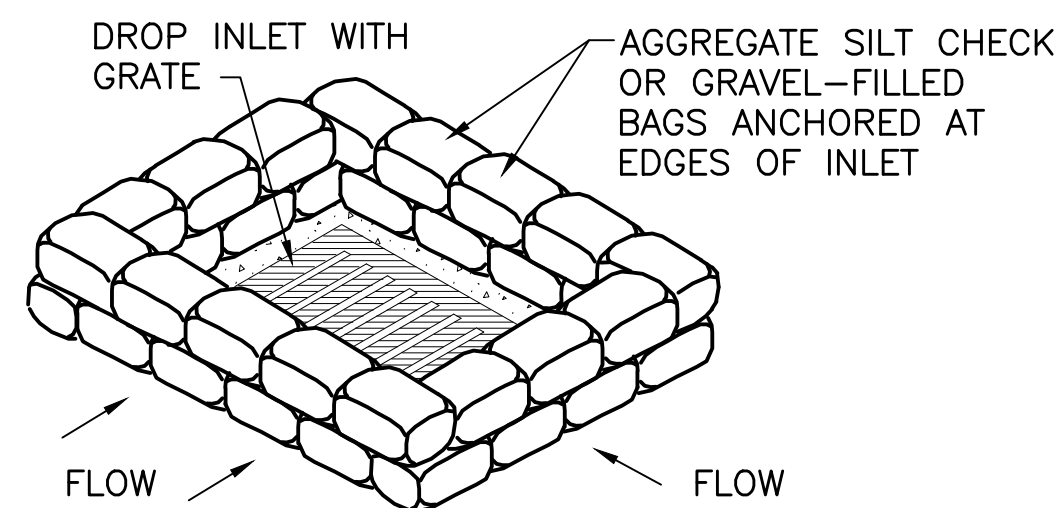

DROP INLET SEDIMENT FILTER


INLET PROTECTION DETAILS

SCALE: NTS

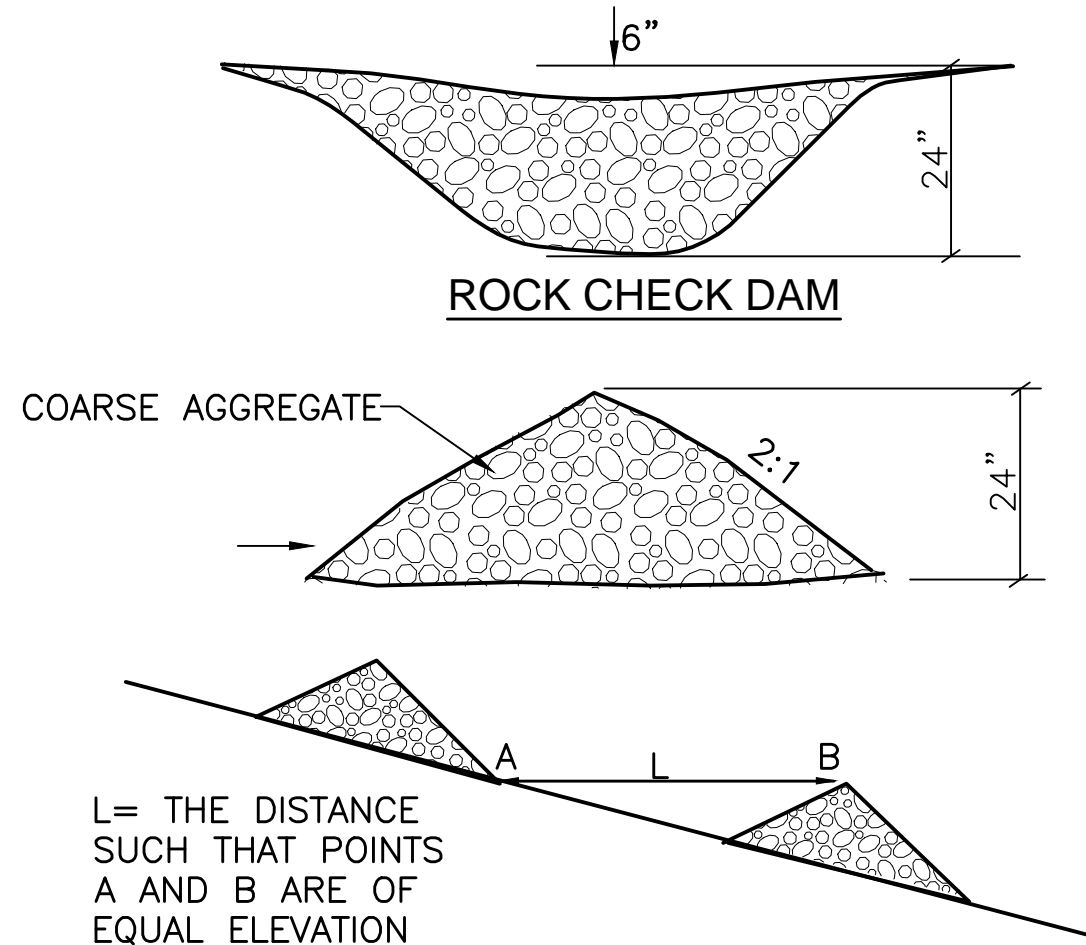


CHECK DAM DETAILS

SCALE: NTS

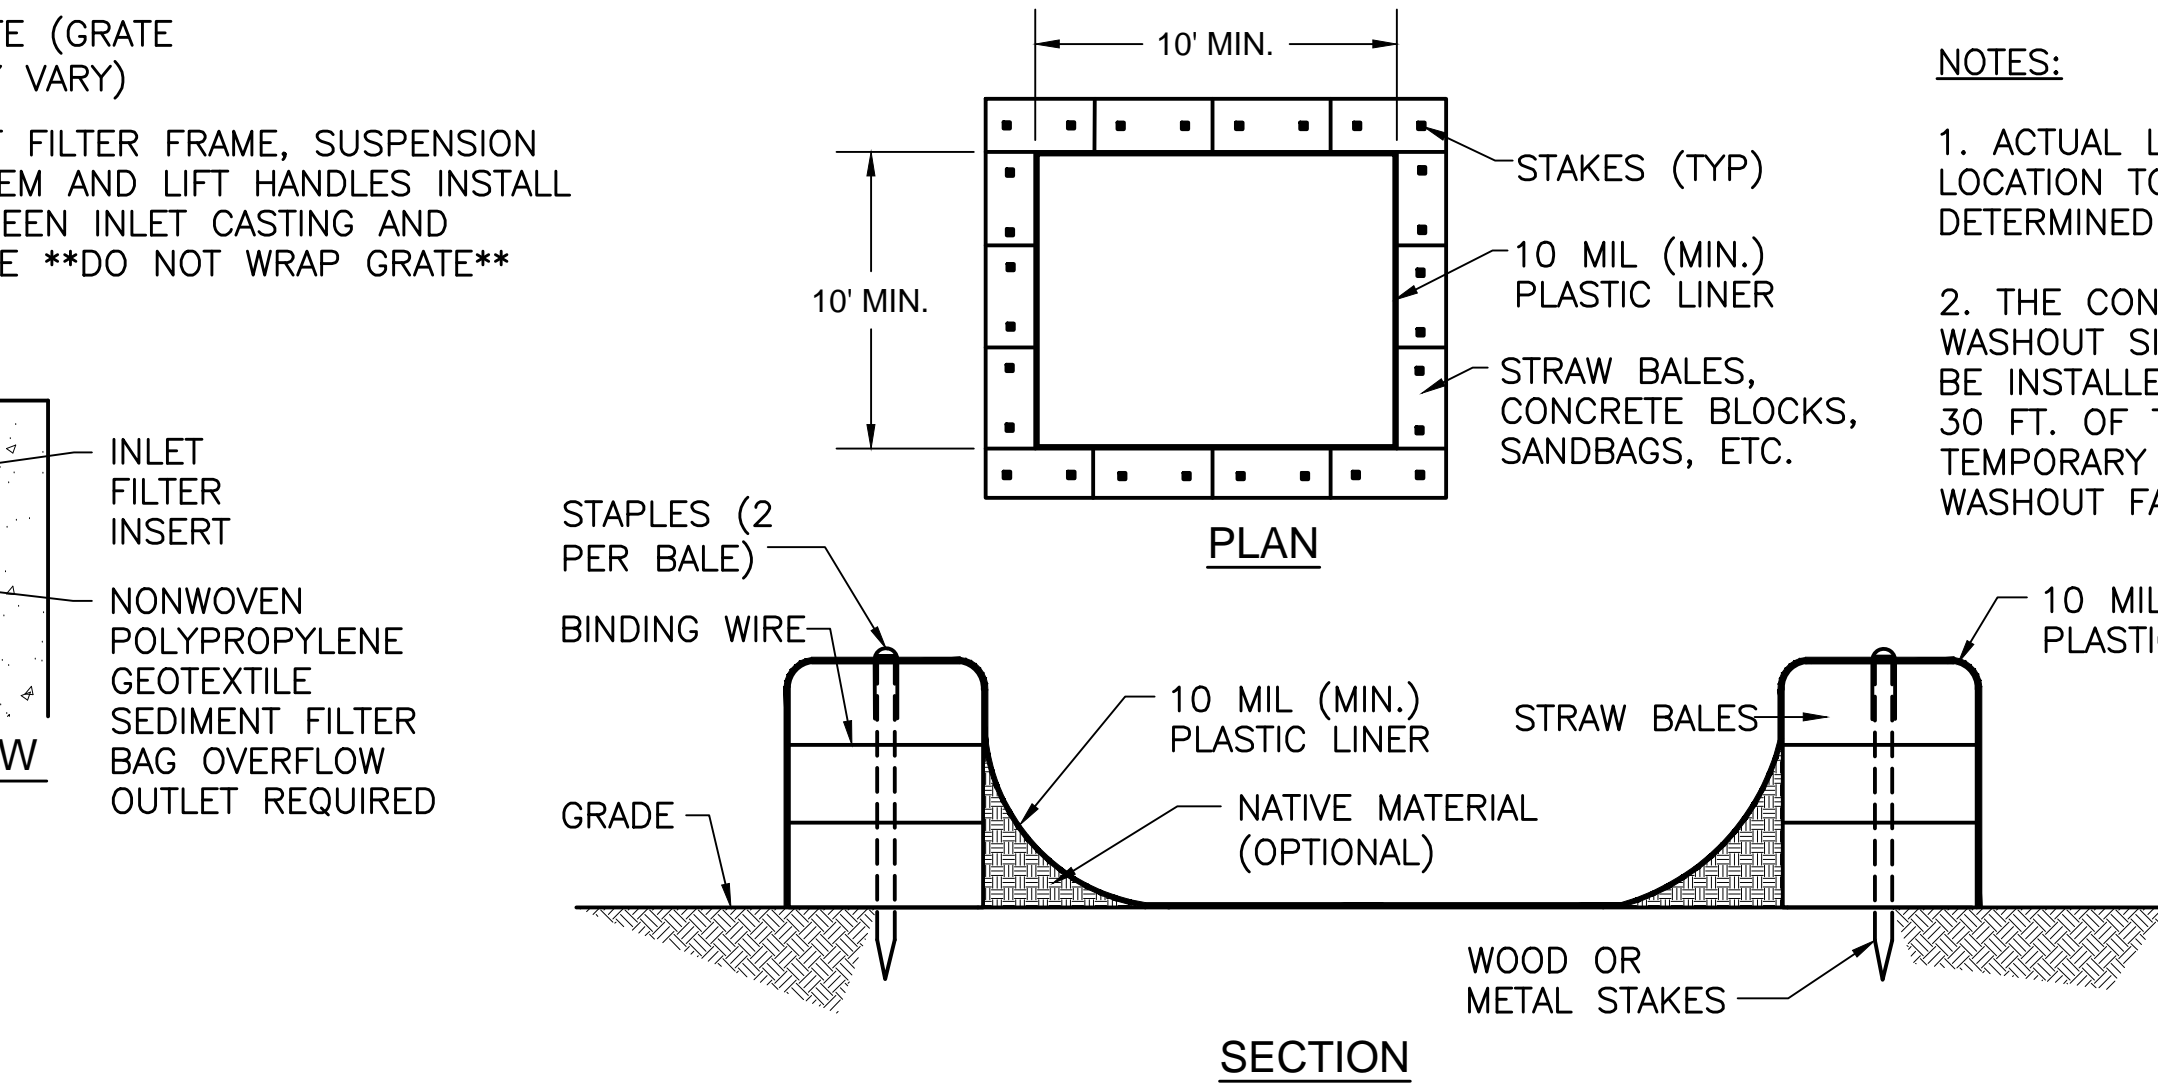


CONCRETE WASHOUT DETAILS

SCALE: NTS

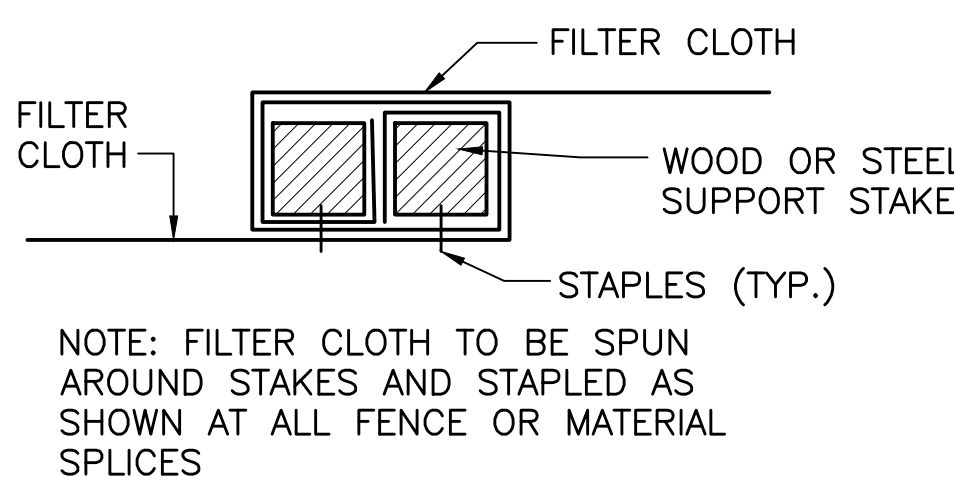


JOINING FENCE SECTIONS

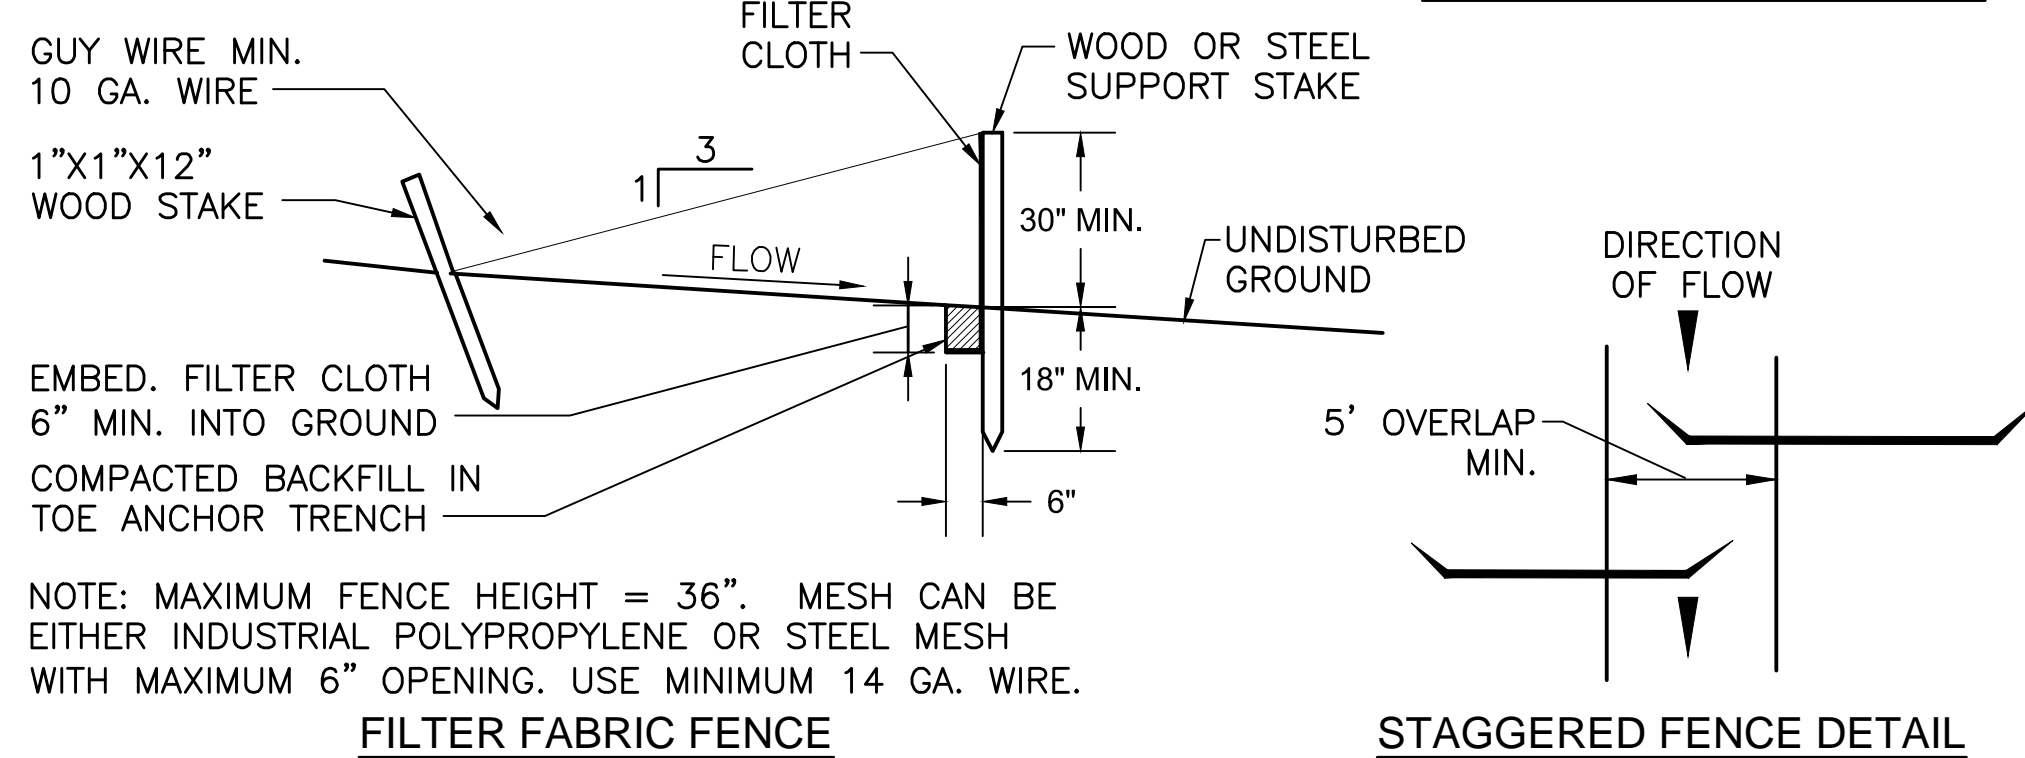


FILTER FABRIC FENCE DETAILS

SCALE: NTS

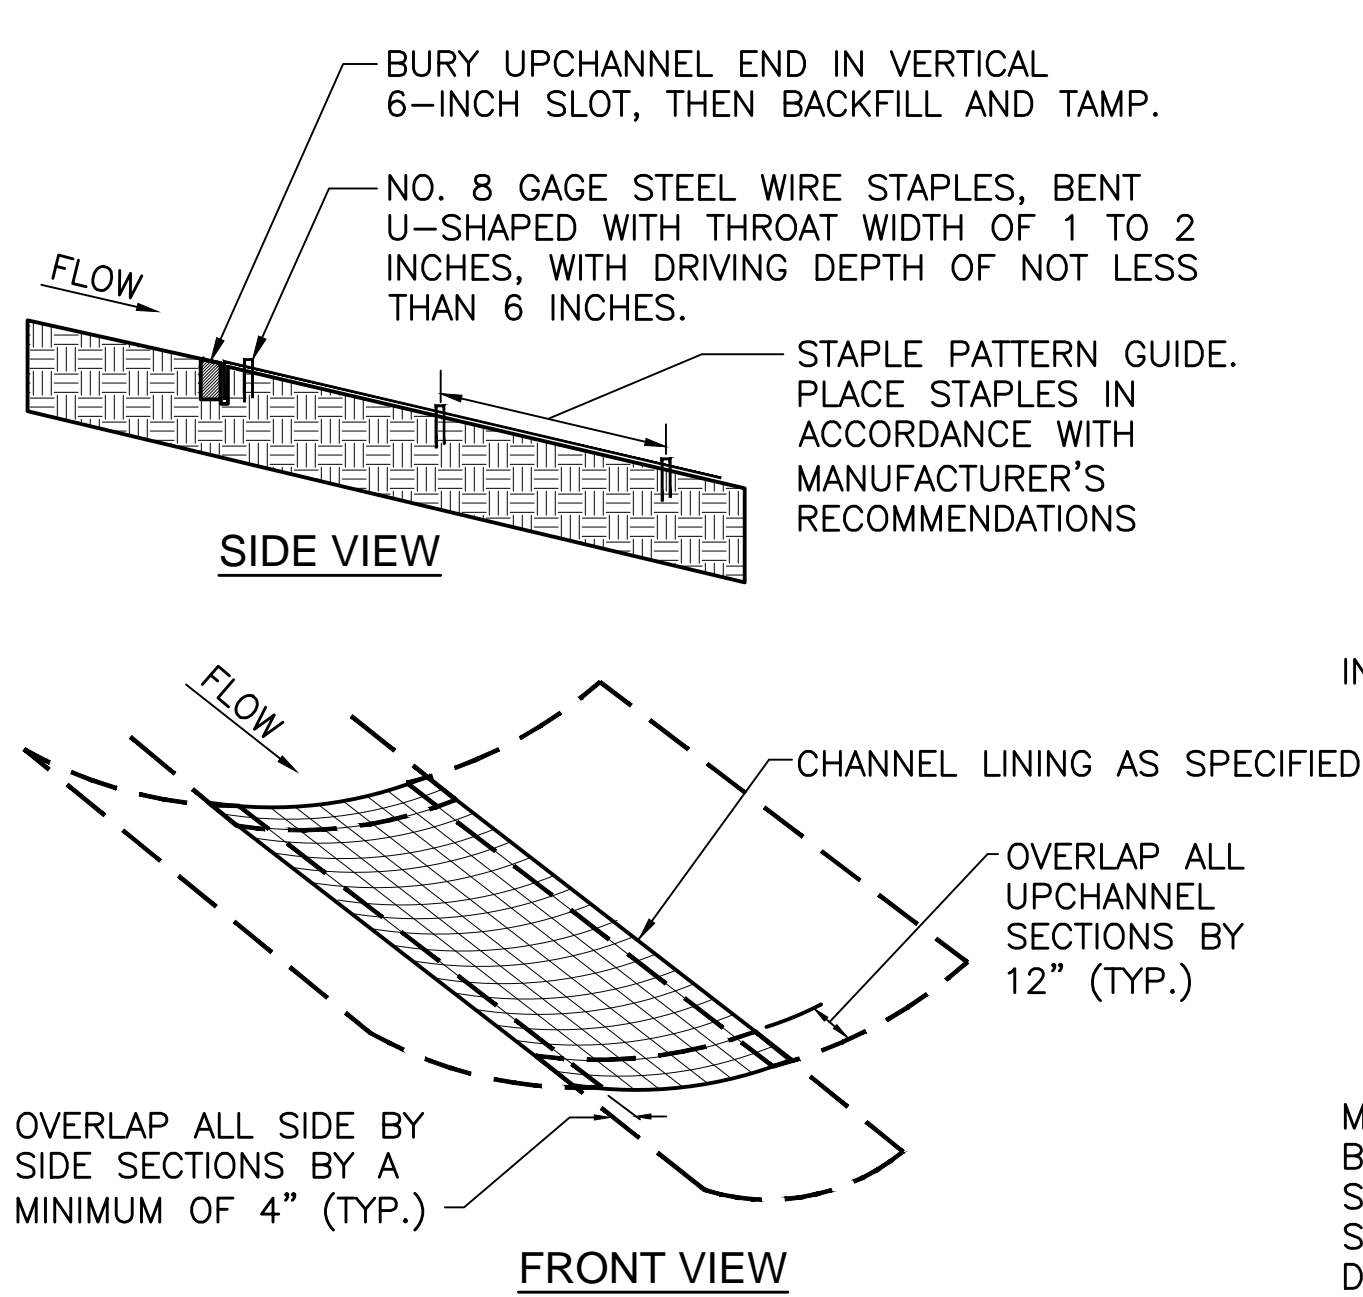

EROSION CONTROL BLANKET INSTALLATION DETAIL

SCALE: NTS

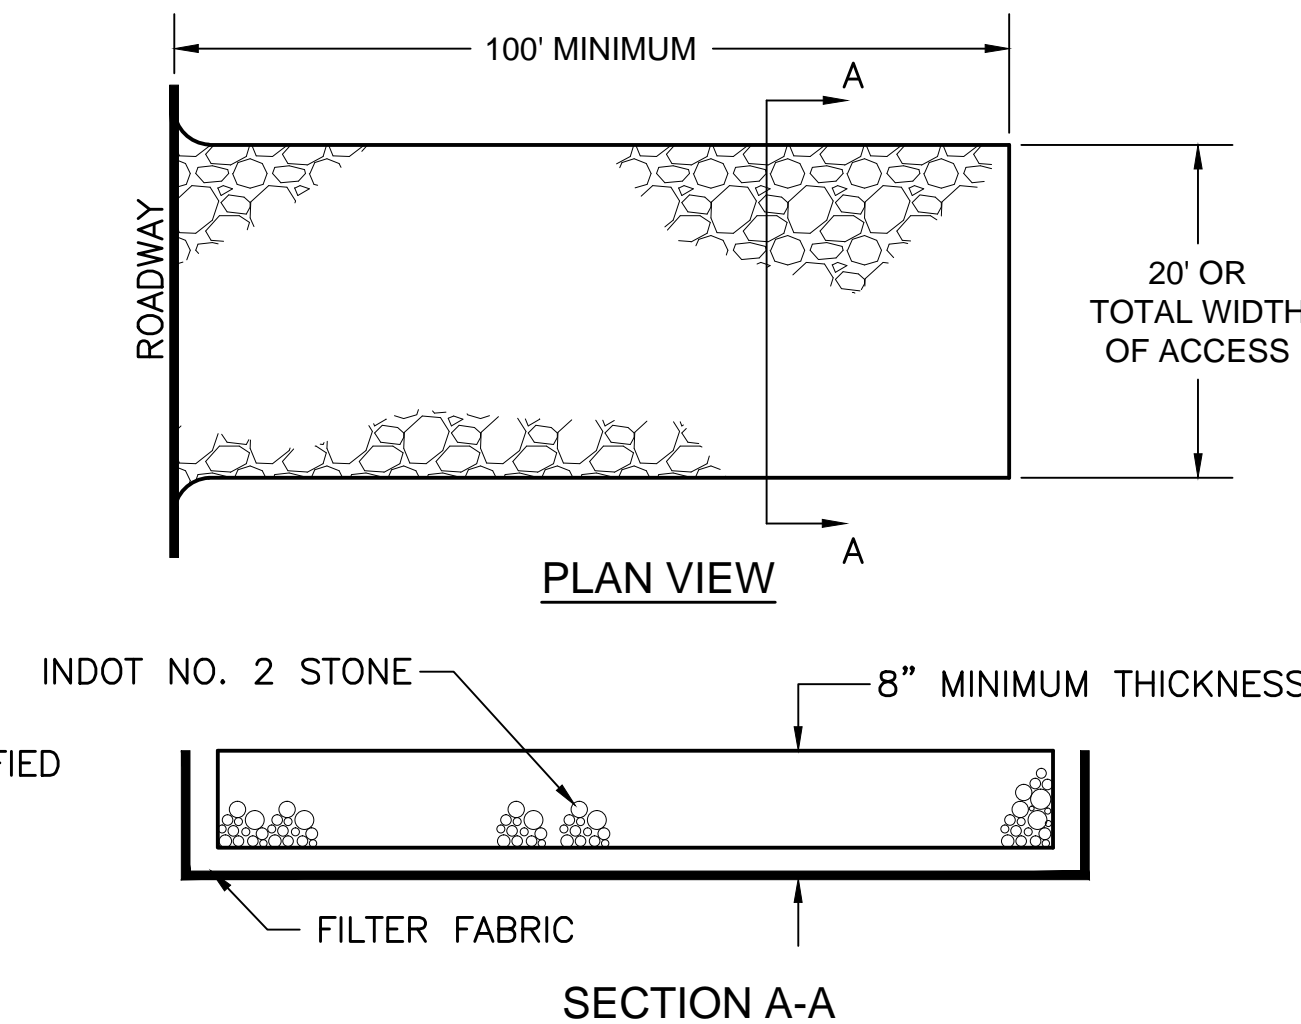



MAINTENANCE: THE STABILIZED CONSTRUCTION ENTRANCE SHALL BE INSTALLED WHERE SHOWN ON THE PLAN. THE ENTRANCE SHALL BE INSPECTED WEEKLY AND ADDITIONAL INDOT NO. 2 STONE SHALL BE KEPT ON SITE SO THAT THE MINIMUM DIMENSIONS CAN BE MAINTAINED THROUGHOUT THE PROJECT. SEDIMENT TRACKED ONTO A PUBLIC ROADWAY SHALL BE REMOVED AT THE END OF EACH CONSTRUCTION DAY AND PLACED ON THE TOPSOIL STOCKPILE. NO OTHER ENTRANCE SHALL BE USED TO GAIN ACCESS TO THE SITE BY ANY CONSTRUCTION, PERSONAL OR DELIVERY VEHICLES.

ROCK CONSTRUCTION ENTRANCE

SCALE: NTS

NOTES:

1. ACTUAL LAYOUT AND LOCATION TO BE DETERMINED IN FIELD.
2. THE CONCRETE WASHOUT SIGN SHALL BE INSTALLED WITHIN 30 FT. OF THE TEMPORARY CONCRETE WASHOUT FACILITY.

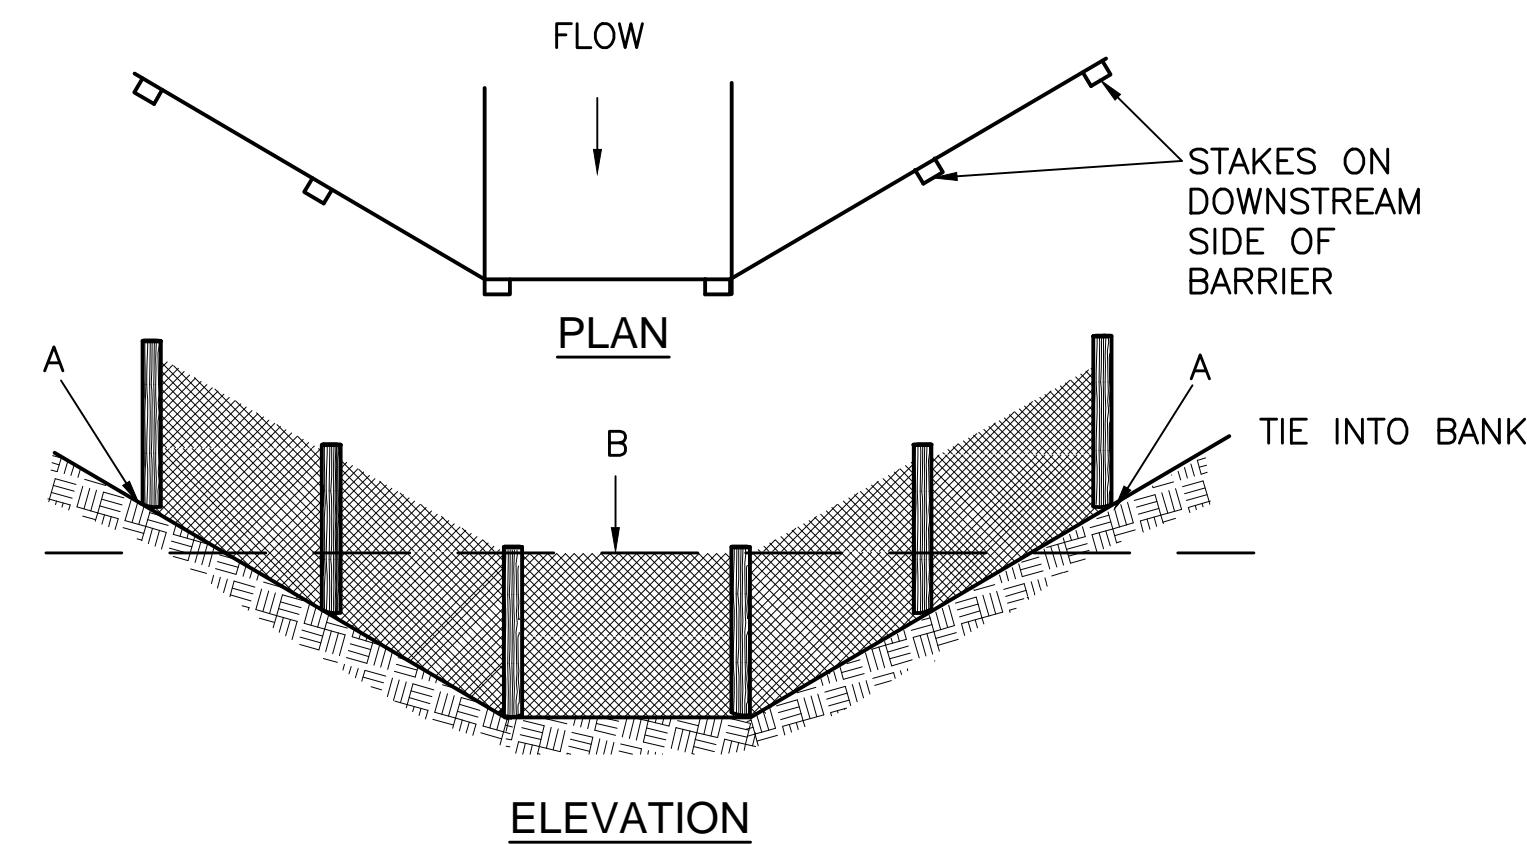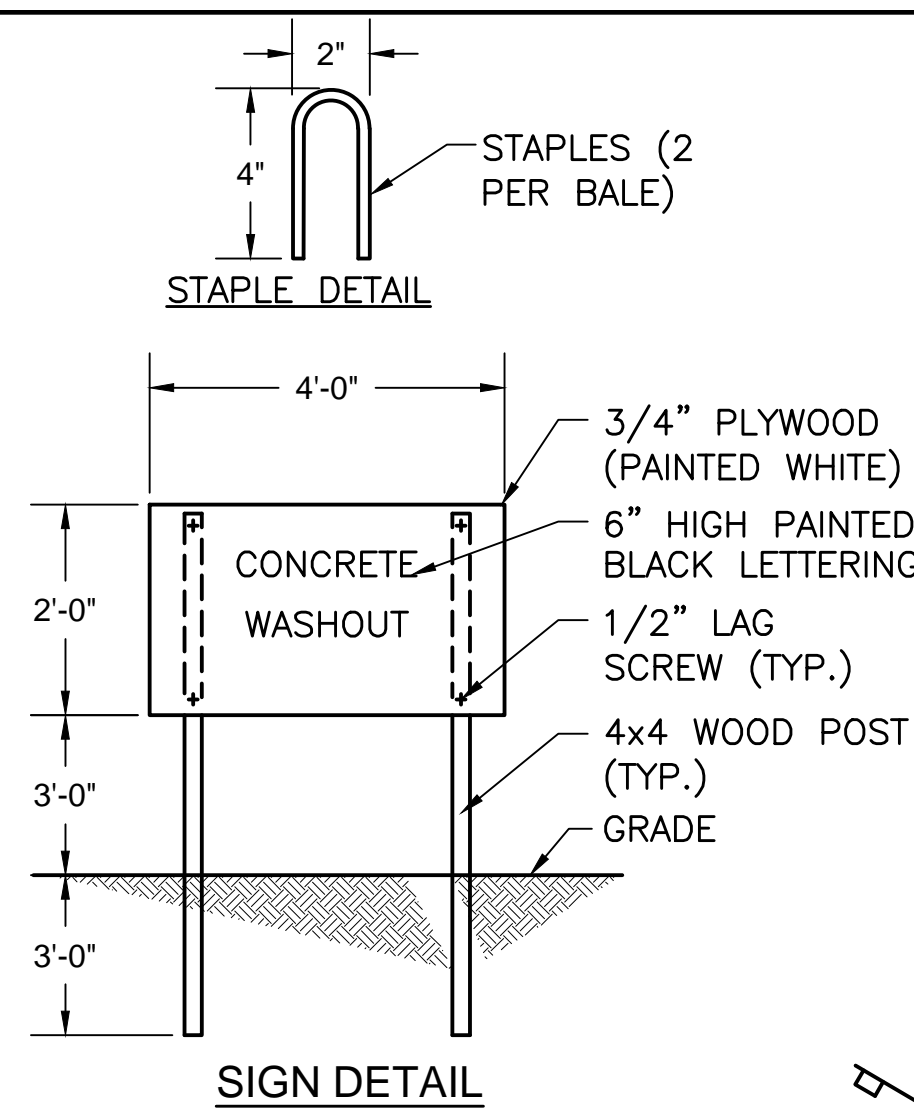

NOTE: FIBER ROLLS OR COMMERCIAL SILT CHECK PRODUCTS MAY BE USED. INSTALL IN SIMILAR MANNER. TIE EDGES INTO SIDES AND TOP OF BANK.

FILTER FABRIC INSTALLATION IN LOW-VELOCITY SWALE


SCALE: NTS

STABILIZATION PRACTICE	JAN.	FEB.	MAR.	APR.	MAY	JUN.	JUL.	AUG.	SEP.	OCT.	NOV.	DEC.
PERMANENT SEEDING				A		*/////////*						
DORMANT SEEDING	B											B
TEMPORARY SEEDING				C					D			
SODDING				E**		*/////////*						
MULCHING	F											

- A = INDOT SEED MIXTURE TYPE "R" - 170 LBS/ACRE PLUS 2 TONS STRAW MULCH/ACRE.
- B = KENTUCKY BLUEGRASS 60 LBS/ACRE; CREEPING RED FESCUE 60 LBS/ACRE; PLUS 2 TONS STRAW MULCH/ACRE, OR ADD ANNUAL RYEGRASS 30 LBS/ACRE.
- C = INDOT SEED MIXTURE TYPE "T" SPRING OATS - 150 LBS/ACRE
- D = INDOT SEE MIXTURE TYPE "T" WINTER WHEAT - 150 LBS/ACRE
- E = SOD
- F = STRAW MULCH 2 TONS/ACRE
- */i/* IRRIGATION NEEDED DURING JUNE, JULY, AND/OR AUGUST.
- ** IRRIGATION NEEDED FOR 2 TO 3 WEEKS AFTER APPLYING SOD.

SEASONAL SOIL PROTECTION CHART

SCALE: NTS

EROSION CONTROL DETAILS				CLIENT CONTRACT NO. G-1/G-5				GRW PROJECT NO. 3235-04					
HOOSIER HILLS REGIONAL WATER DISTRICT CONTRACTS G-1 & G-5								DRAWING SCALE CHECK: <div><div></div></div> THIS MARK SHOULD MEASURE EXACTLY 1" WHEN PLOTTED					
								ALL RIGHTS RESERVED: THIS DOCUMENT IS THE PROPERTY OF GRW, INC. AND SHALL NOT BE REPRODUCED IN WHOLE OR IN PART OR USED FOR CONSTRUCTION OF OTHER THAN THIS SPECIFIC PROJECT WITHOUT WRITTEN PERMISSION OF GRW, INC.					
 engineering architecture geospatial										DESIGNED: DSW		DATE: FEBRUARY 2012	
										DRAWN: JAJ		SCALE: N.T.S.	
				1 AS-BUILTS		2/14		JAJ		REVIEWED: DRC		SHEET NO.	
				NO.		DESCRIPTION		DATE		BY		APPROVED: DSW	
						REVISIONS						C-06	