
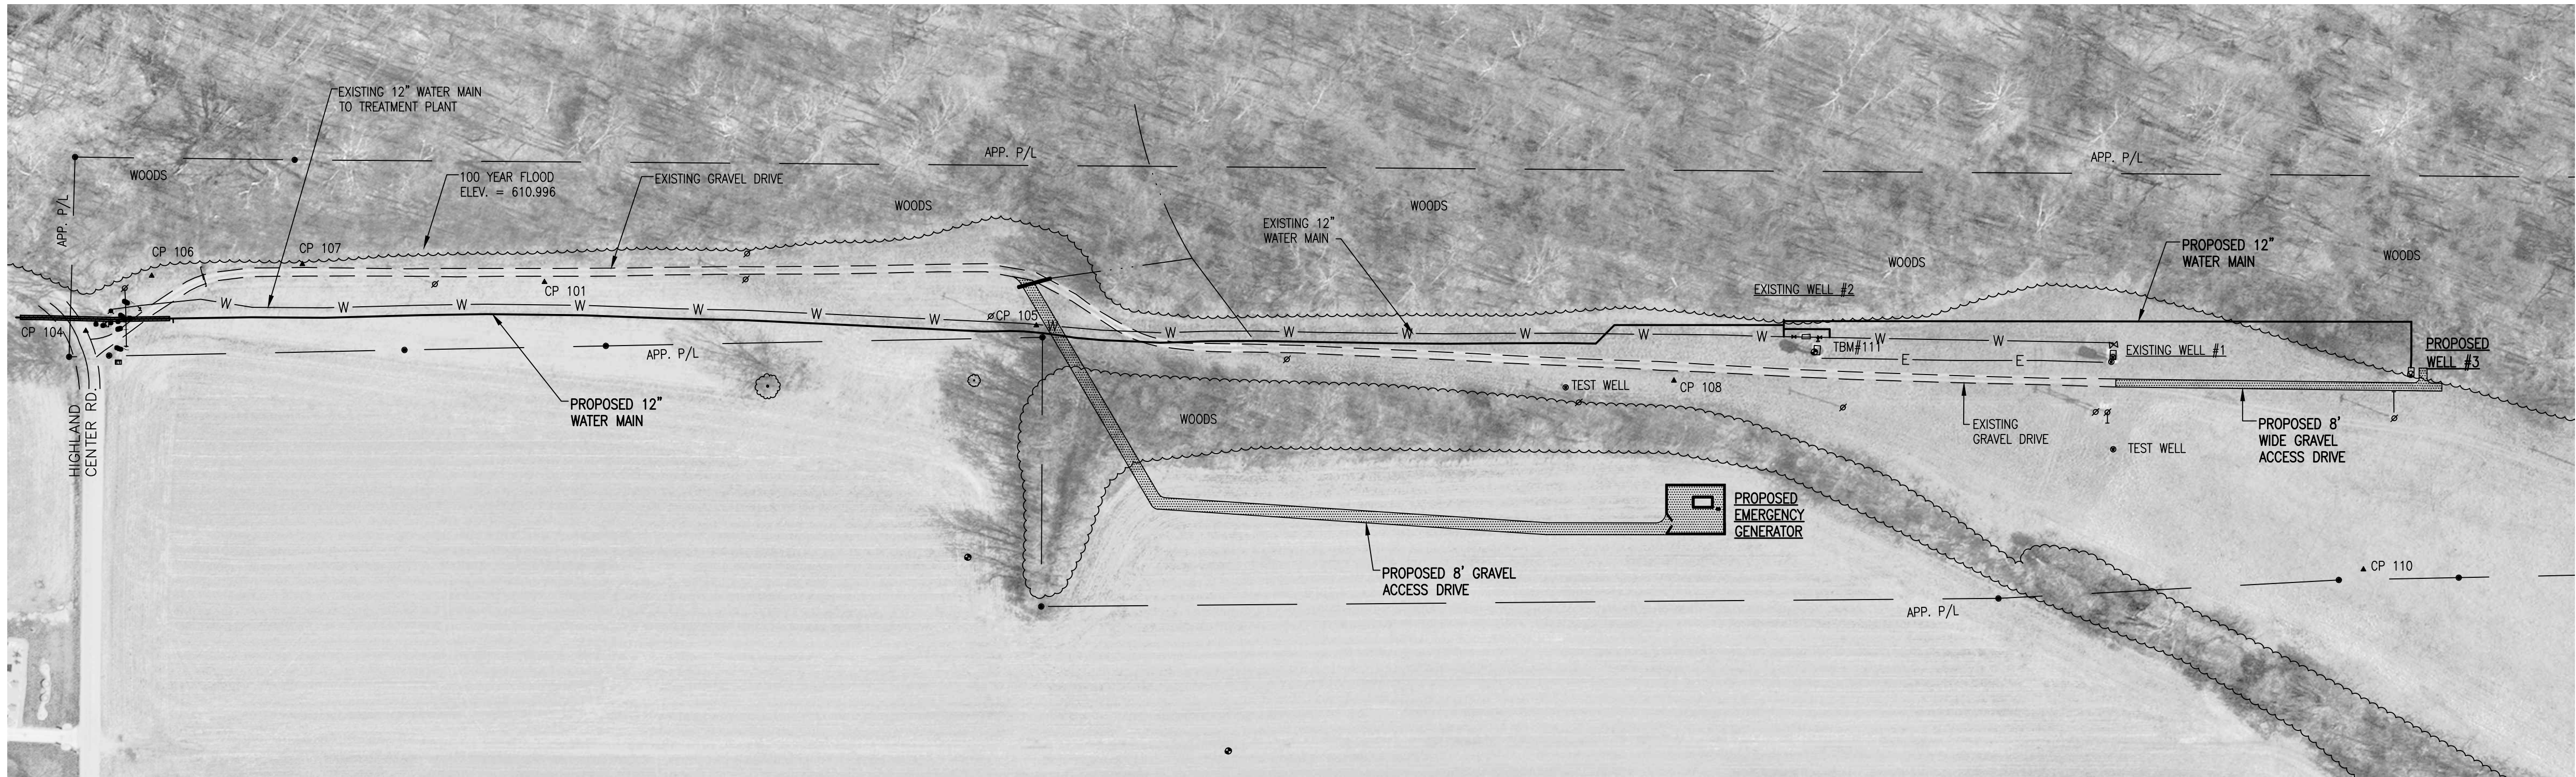
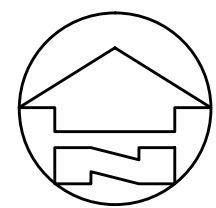


WELLFIELD - SURVEY CONTROL

SCALE: 1" = 100'-0"

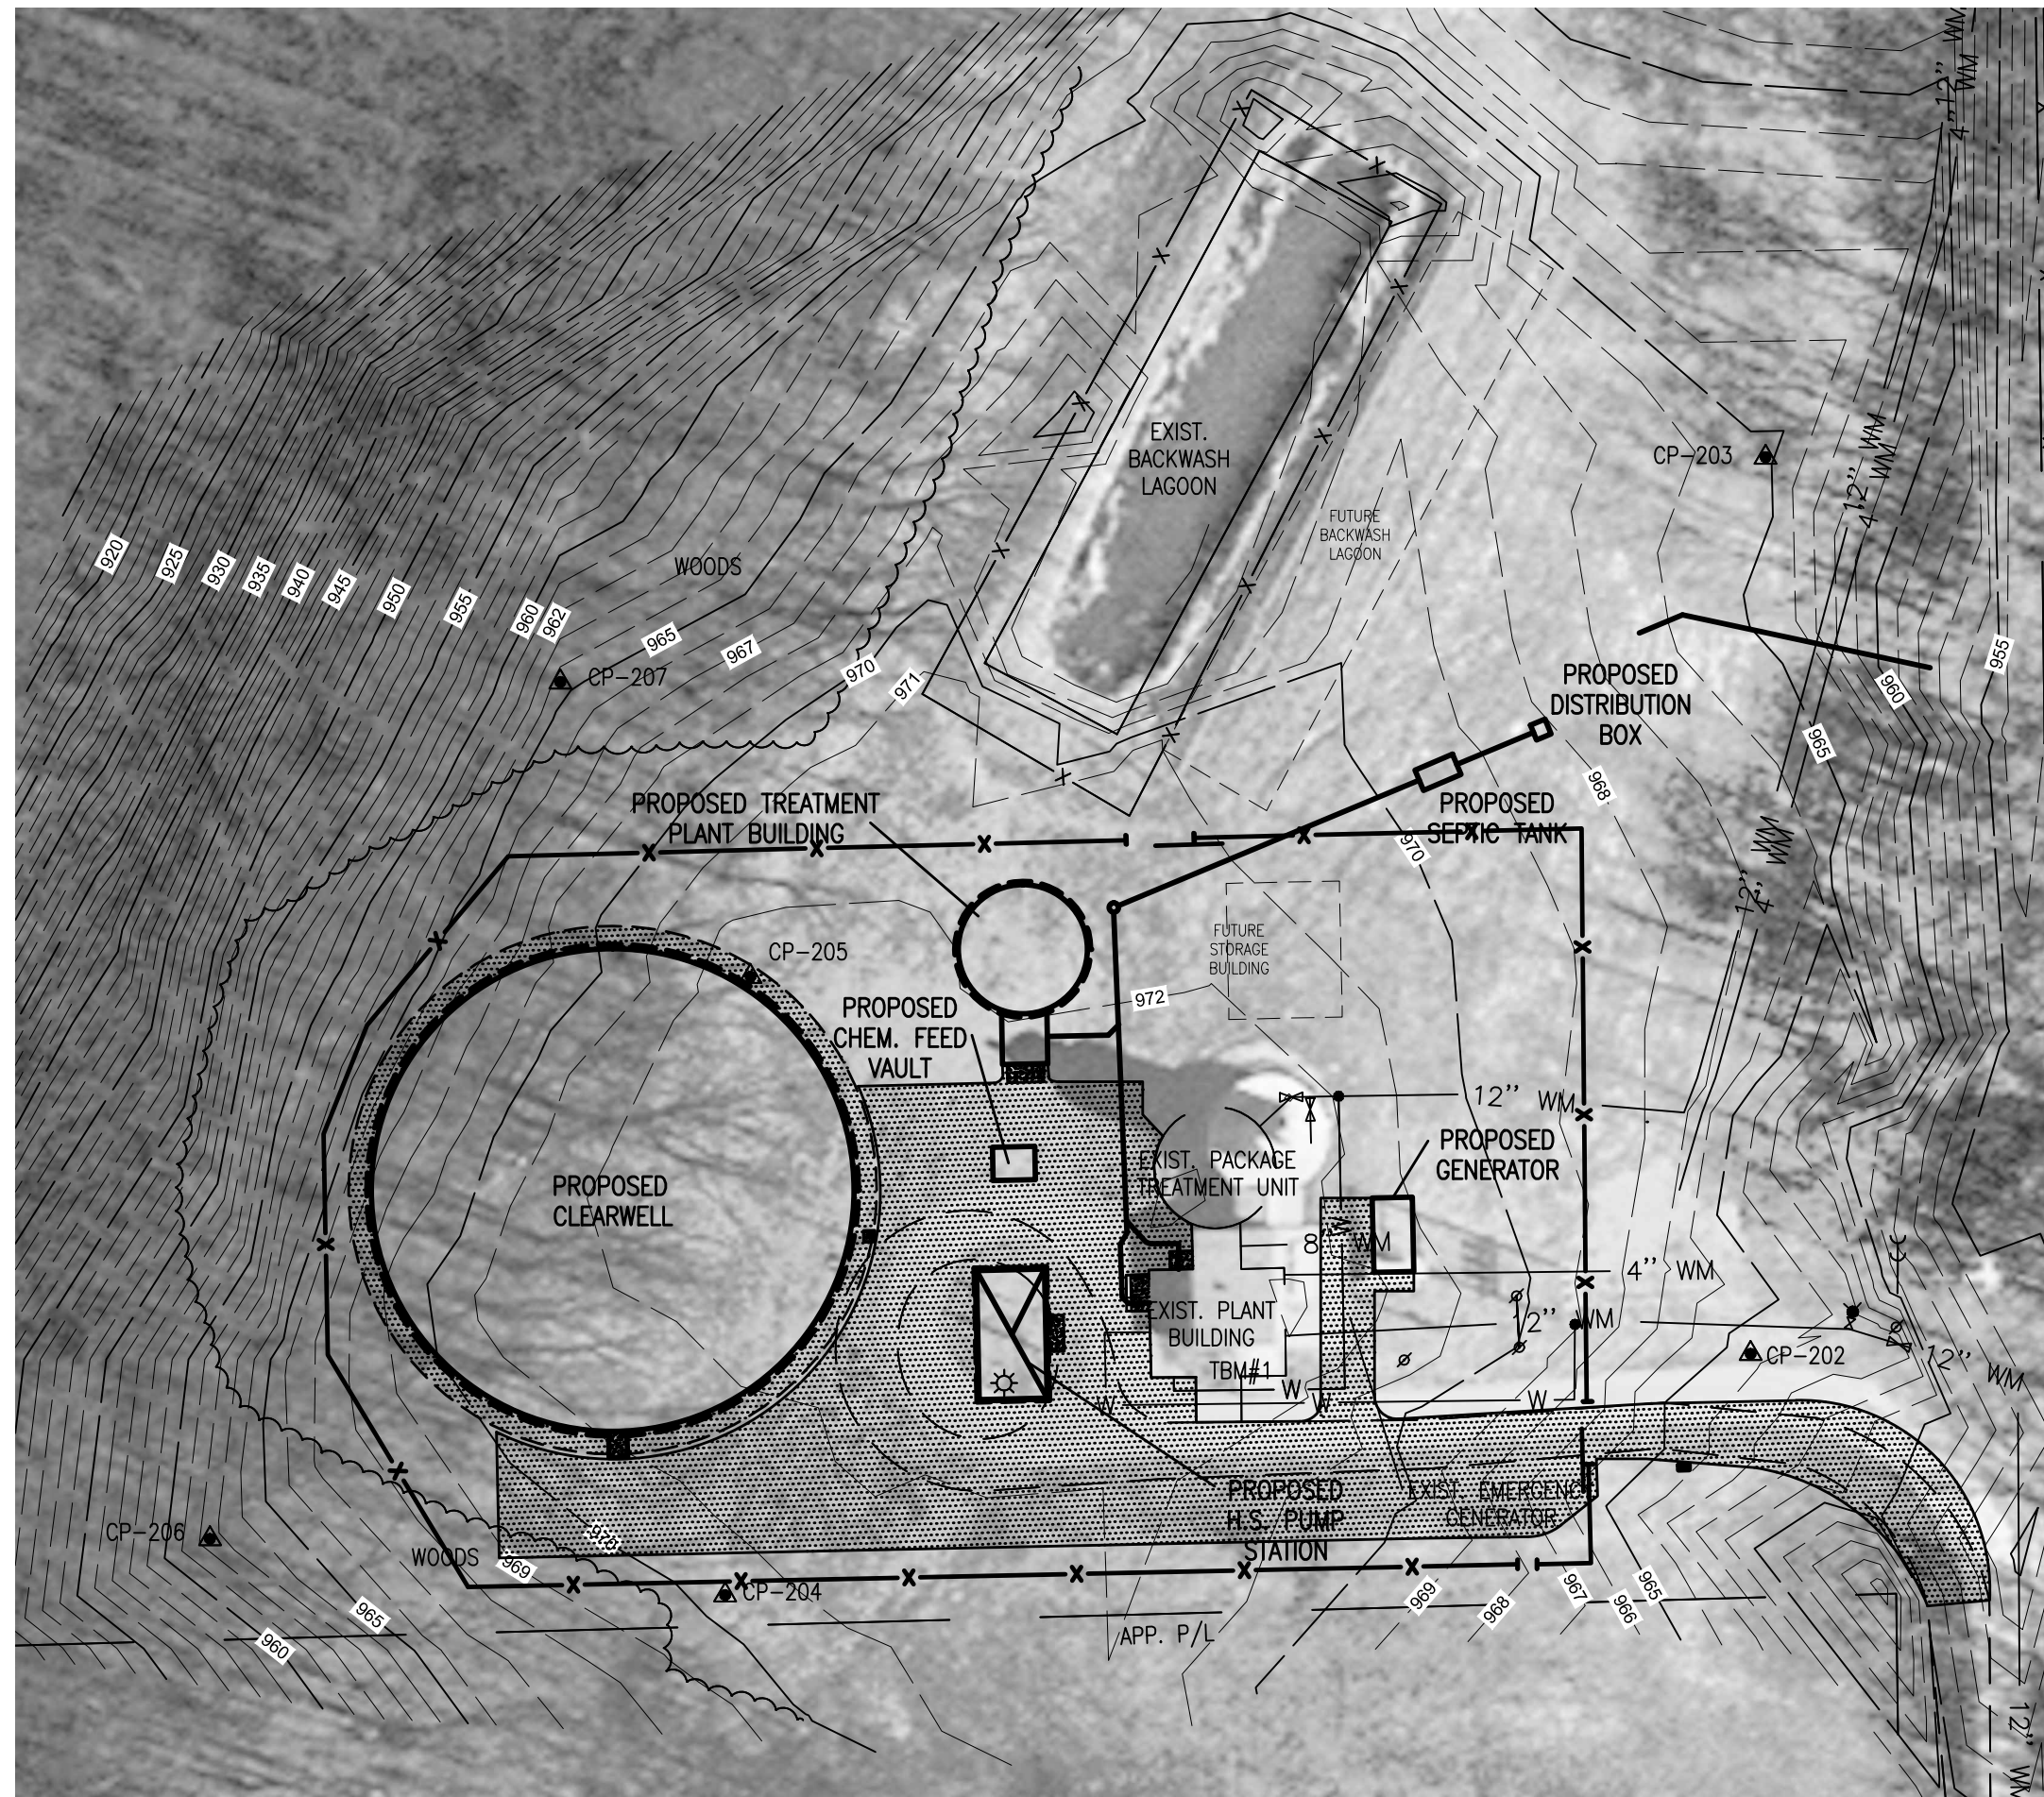

WTP SITE - SURVEY CONTROL

SCALE: 1" = 40'-0"

THIS RECORD DOCUMENT HAS BEEN PREPARED BASED ON INFORMATION PROVIDED BY THE CONSTRUCTION CONTRACTOR. GRW ENGINEERS, INC. HAS ATTEMPTED TO VERIFY THE ACCURACY AND/OR COMPLETENESS OF THIS INFORMATION BUT SHALL NOT BE RESPONSIBLE FOR ANY ERRORS OR OMISSIONS WHICH MAY BE INCORPORATED HEREIN AS A RESULT.

GRW
engineering | architecture | geospatial

ENGINEER/ARCHITECT: Darren S. Wells













CONSTRUCTION COMPANY: Mitchell & Stark Const. Co., Inc.

DATE: FEBRUARY 2014

NOTE:
ALL ELEVATIONS ON THESE PLANS BASED ON NAVD 88
UNLESS NOTED OTHERWISE.

T.B.M. #1: FINISHED FLOOR OF EXISTING PLANT BUILDING
AT MAIN ENTRY DOOR (EL. 972.490 NAVD 88)

T.B.M. #111: SOUTHWEST CORNER OF CONCRETE SLAB AT
WELL NO. 2 (EL. 601.700 NAVD 88, 602.304 NGVD 29)

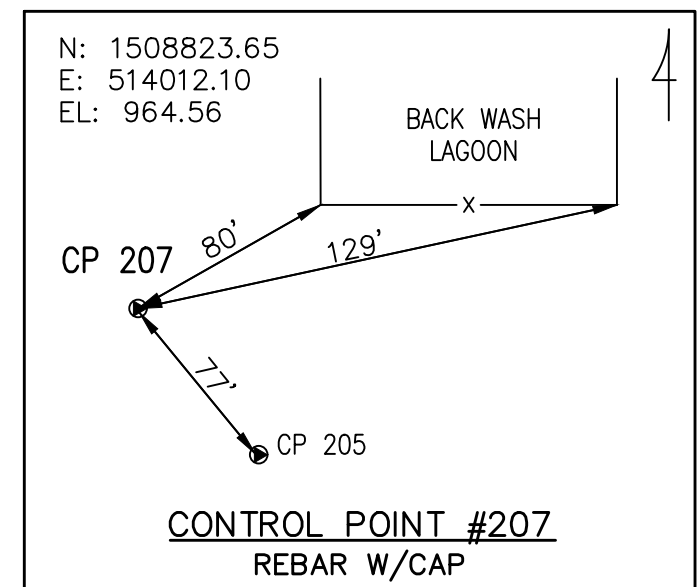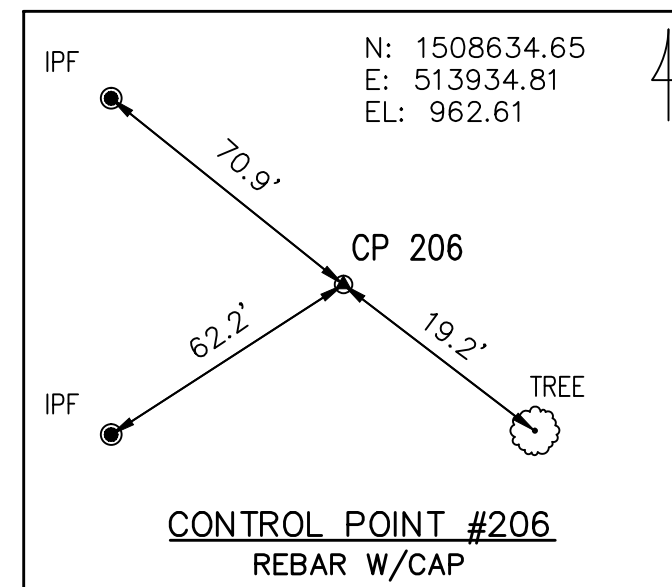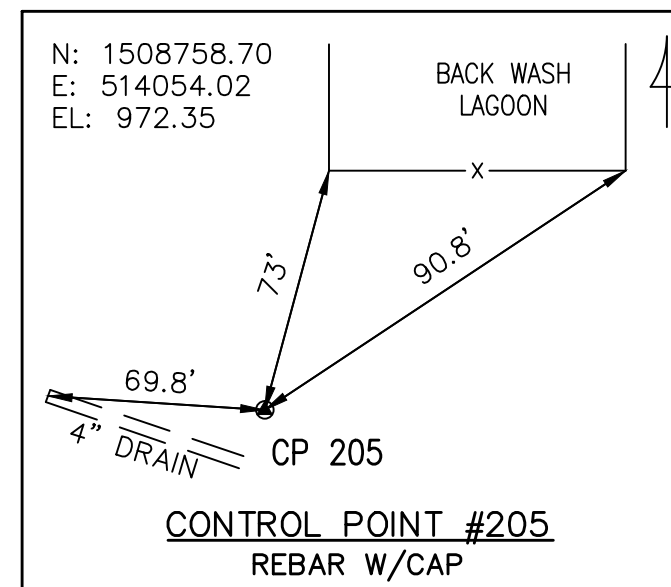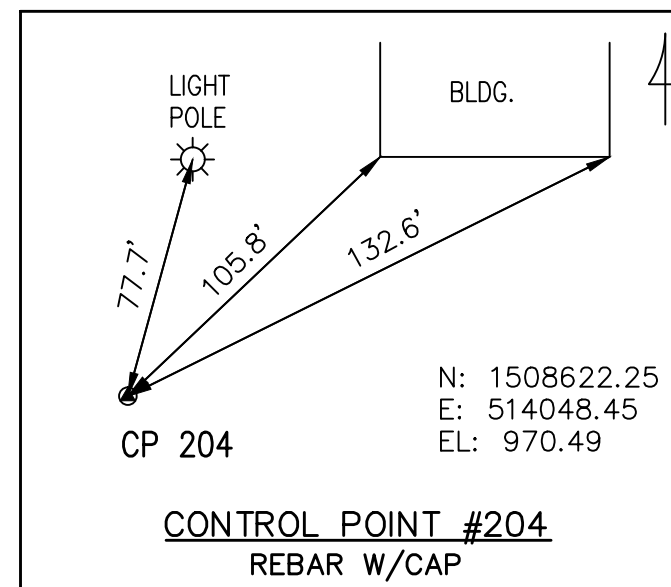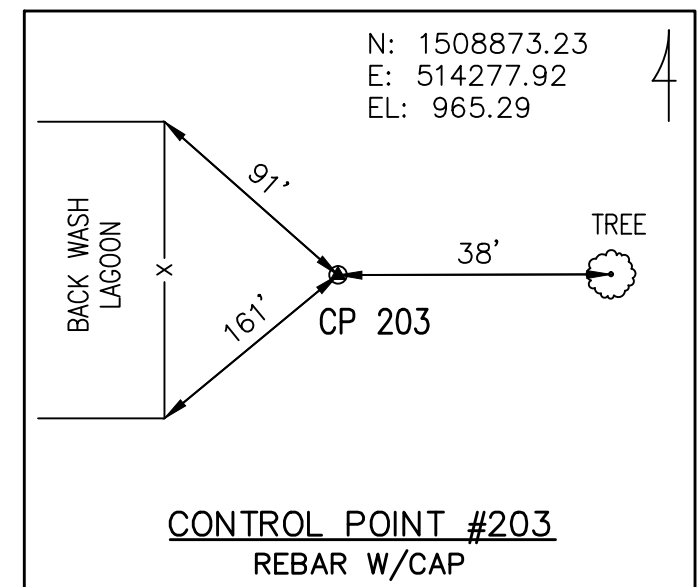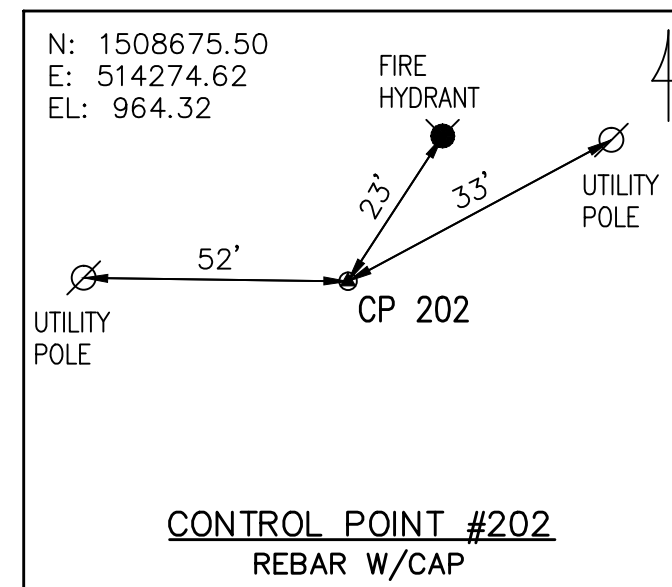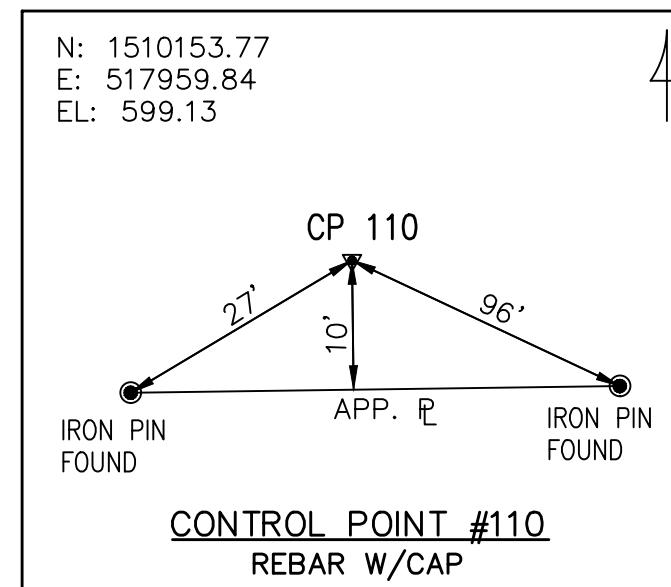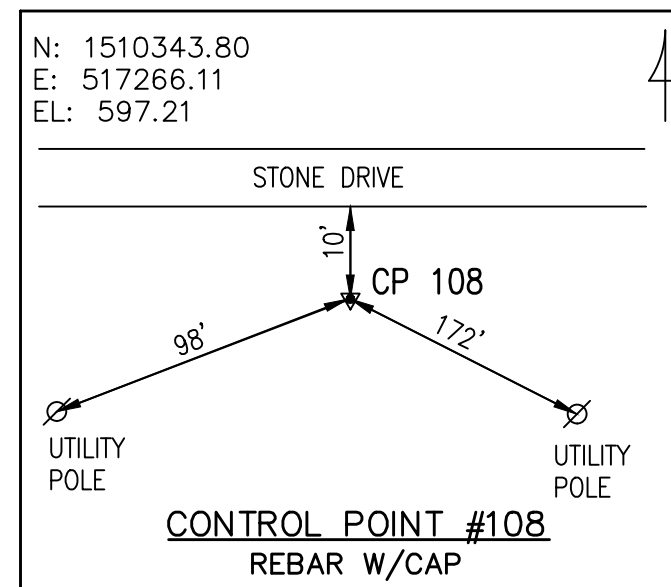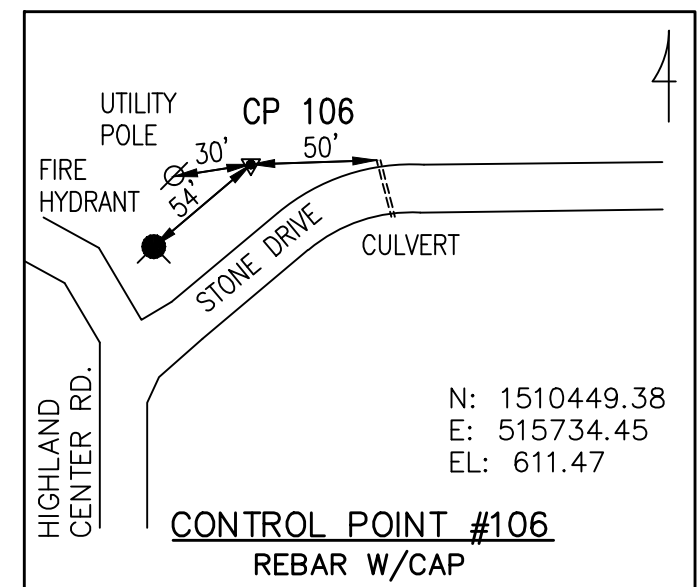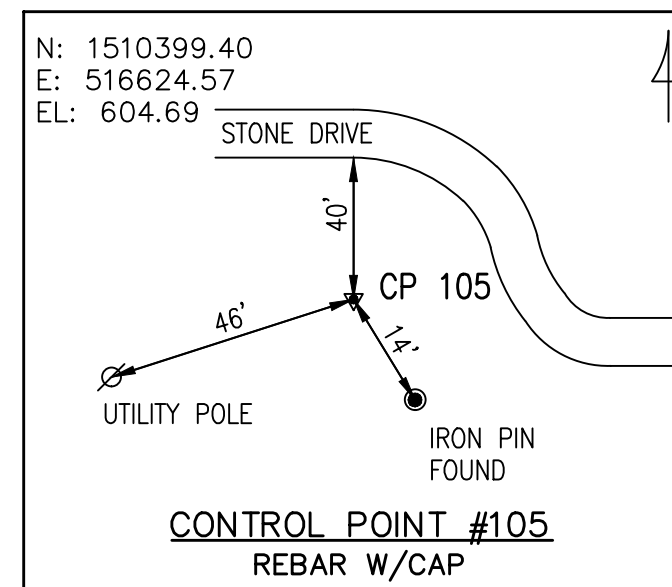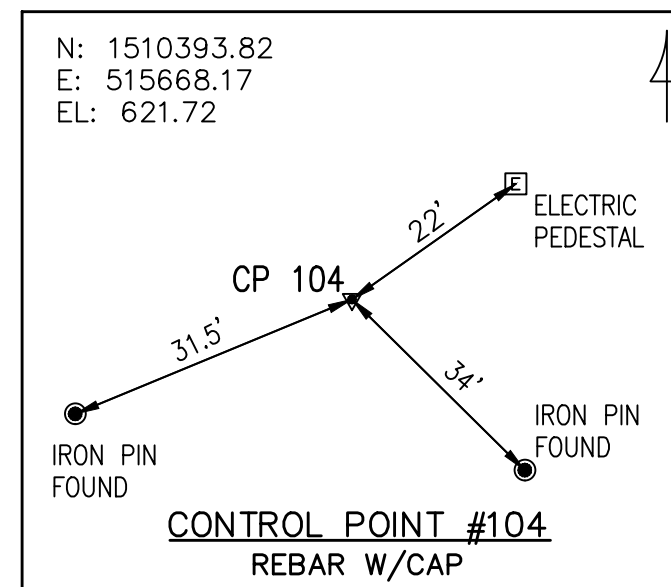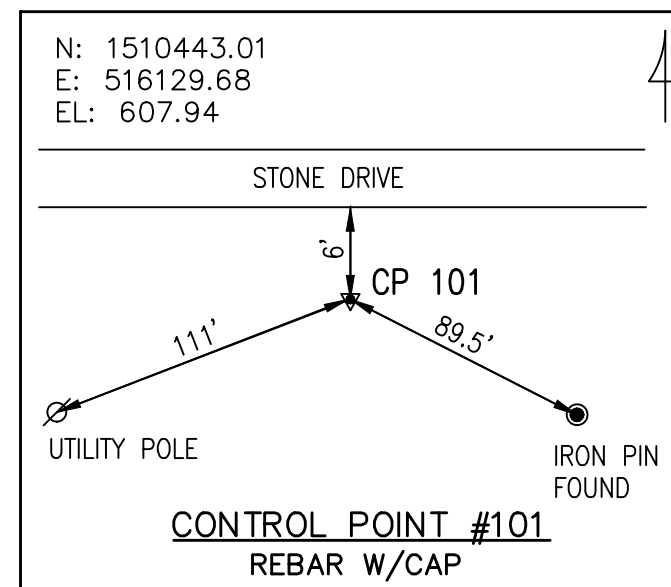

SURVEY CONTROL				CLIENT CONTRACT NO. G-1/G-5				GRW PROJECT NO. 3235-04			
HOOSIER HILLS REGIONAL WATER DISTRICT CONTRACTS G-1 & G-5				DRAWING SCALE CHECK: THIS MARK SHOULD MEASURE EXACTLY 1" WHEN PLOTTED							
				ALL RIGHTS RESERVED: THIS DOCUMENT IS THE PROPERTY OF GRW, INC. AND SHALL NOT BE REPRODUCED IN WHOLE OR IN PART OR USED FOR CONSTRUCTION OF OTHER THAN THIS SPECIFIC PROJECT WITHOUT WRITTEN PERMISSION OF GRW, INC.							
 engineering architecture geospatial								This document, originally issued, sealed, and signed by Darren S. Wells, Indiana Professional Engineer, No. 10100200, on March 26, 2012, shall not be used in lieu of a certified document.	DESIGNED: CJF	DATE: FEBRUARY 2012	
									DRAWN: JAJ	SCALE: AS SHOWN	
				1	AS-BUILTS	2/14	JAJ		REVIEWED: DRC	SHEET NO.	
				NO.	DESCRIPTION	DATE	BY		APPROVED: DSW	G-02	
				REVISIONS							