
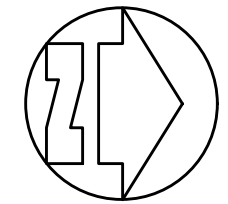



PRINTED: 2/25/2014 @ 9:58AM

FILE NAME: I:\3235 - HHRW - Division G\Draw Design\G-5\3235-G-5-M-10.dwg

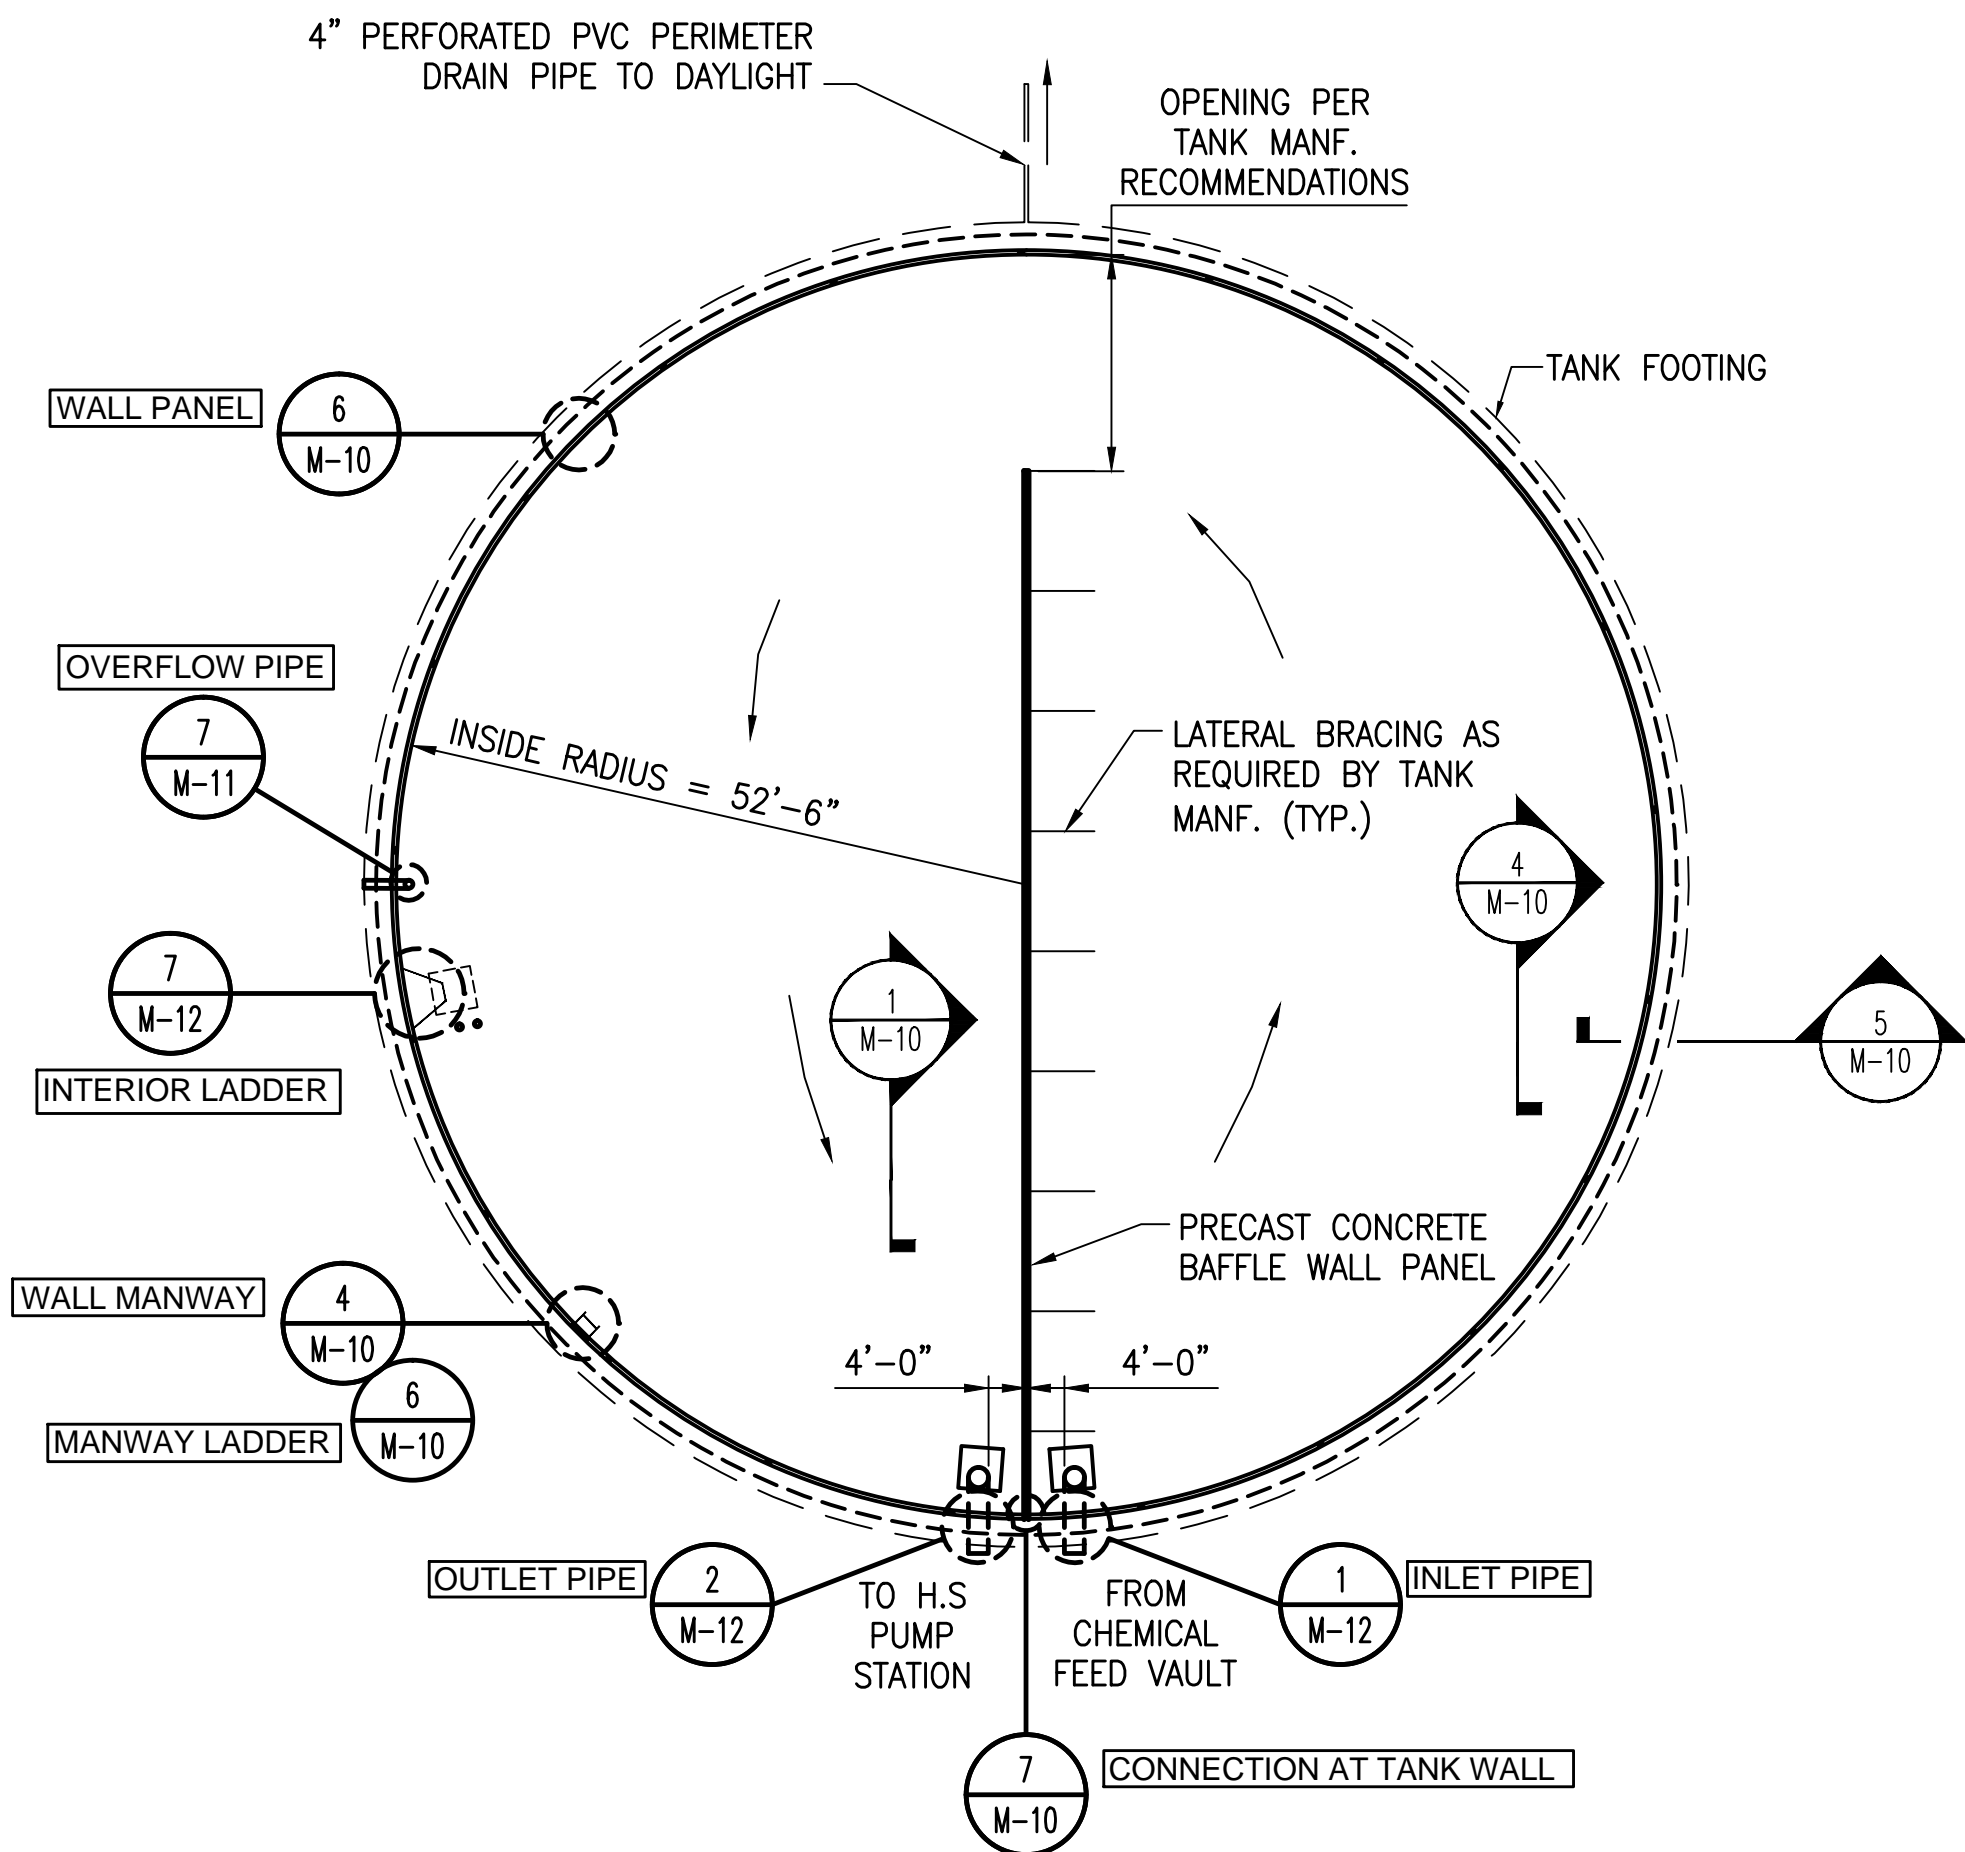

CLEARWELL - FLOOR PLAN

SCALE: 1/16"=1'-0"

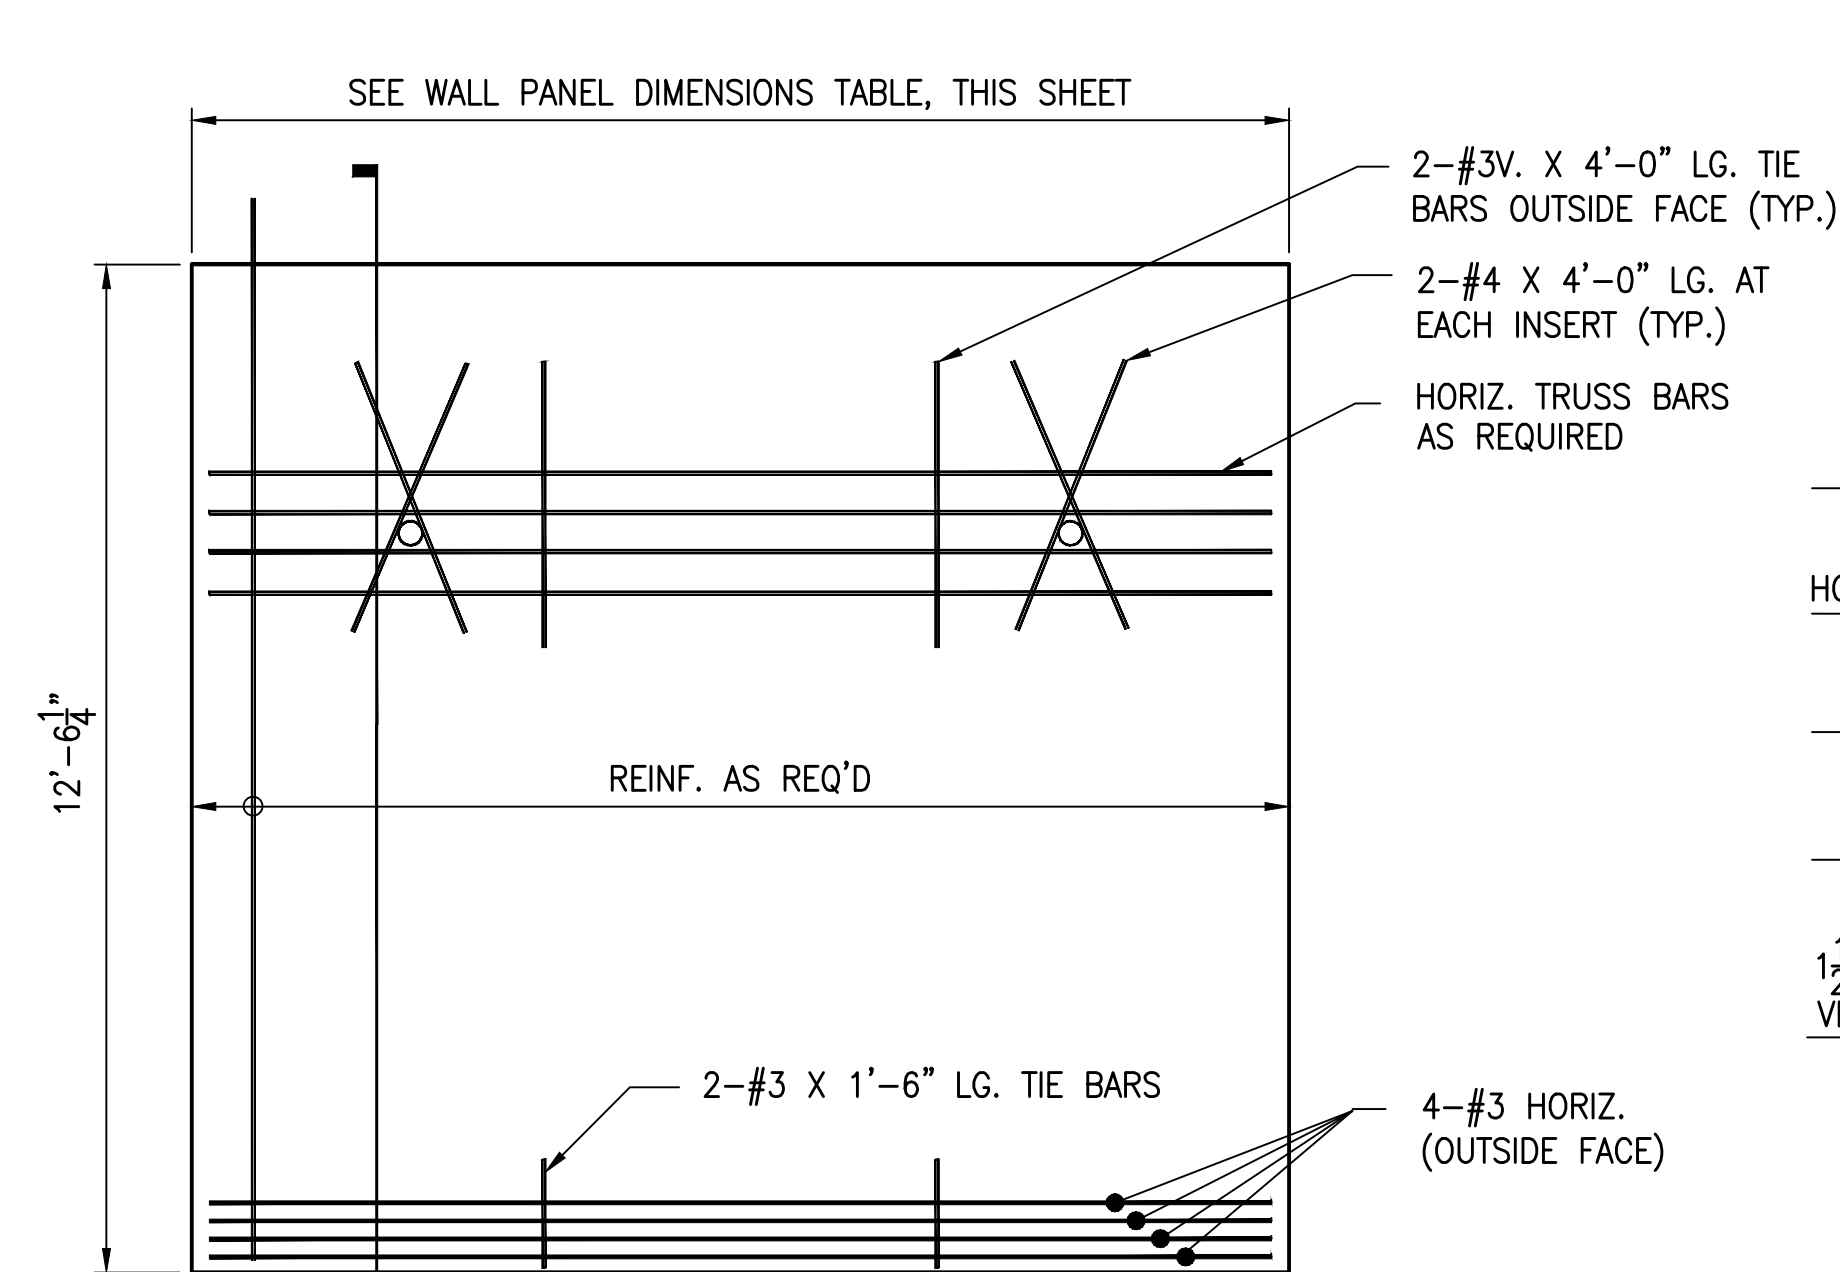

NOTE:
WALL PANELS SHALL RECEIVE A HORIZONTAL
RAKE FINISH FOR THE BOTTOM 1'-0" OF
THE PANEL AND A HORIZONTAL LIGHT BROOM
FINISH FOR THE REST OF THE PANEL.

DETAIL
SCALE: NTS


4
M-10

PRECAST EXTERIOR WALL PANEL

SECTION
SCALE: NTS

5
M-10

PRECAST EXTERIOR WALL PANEL

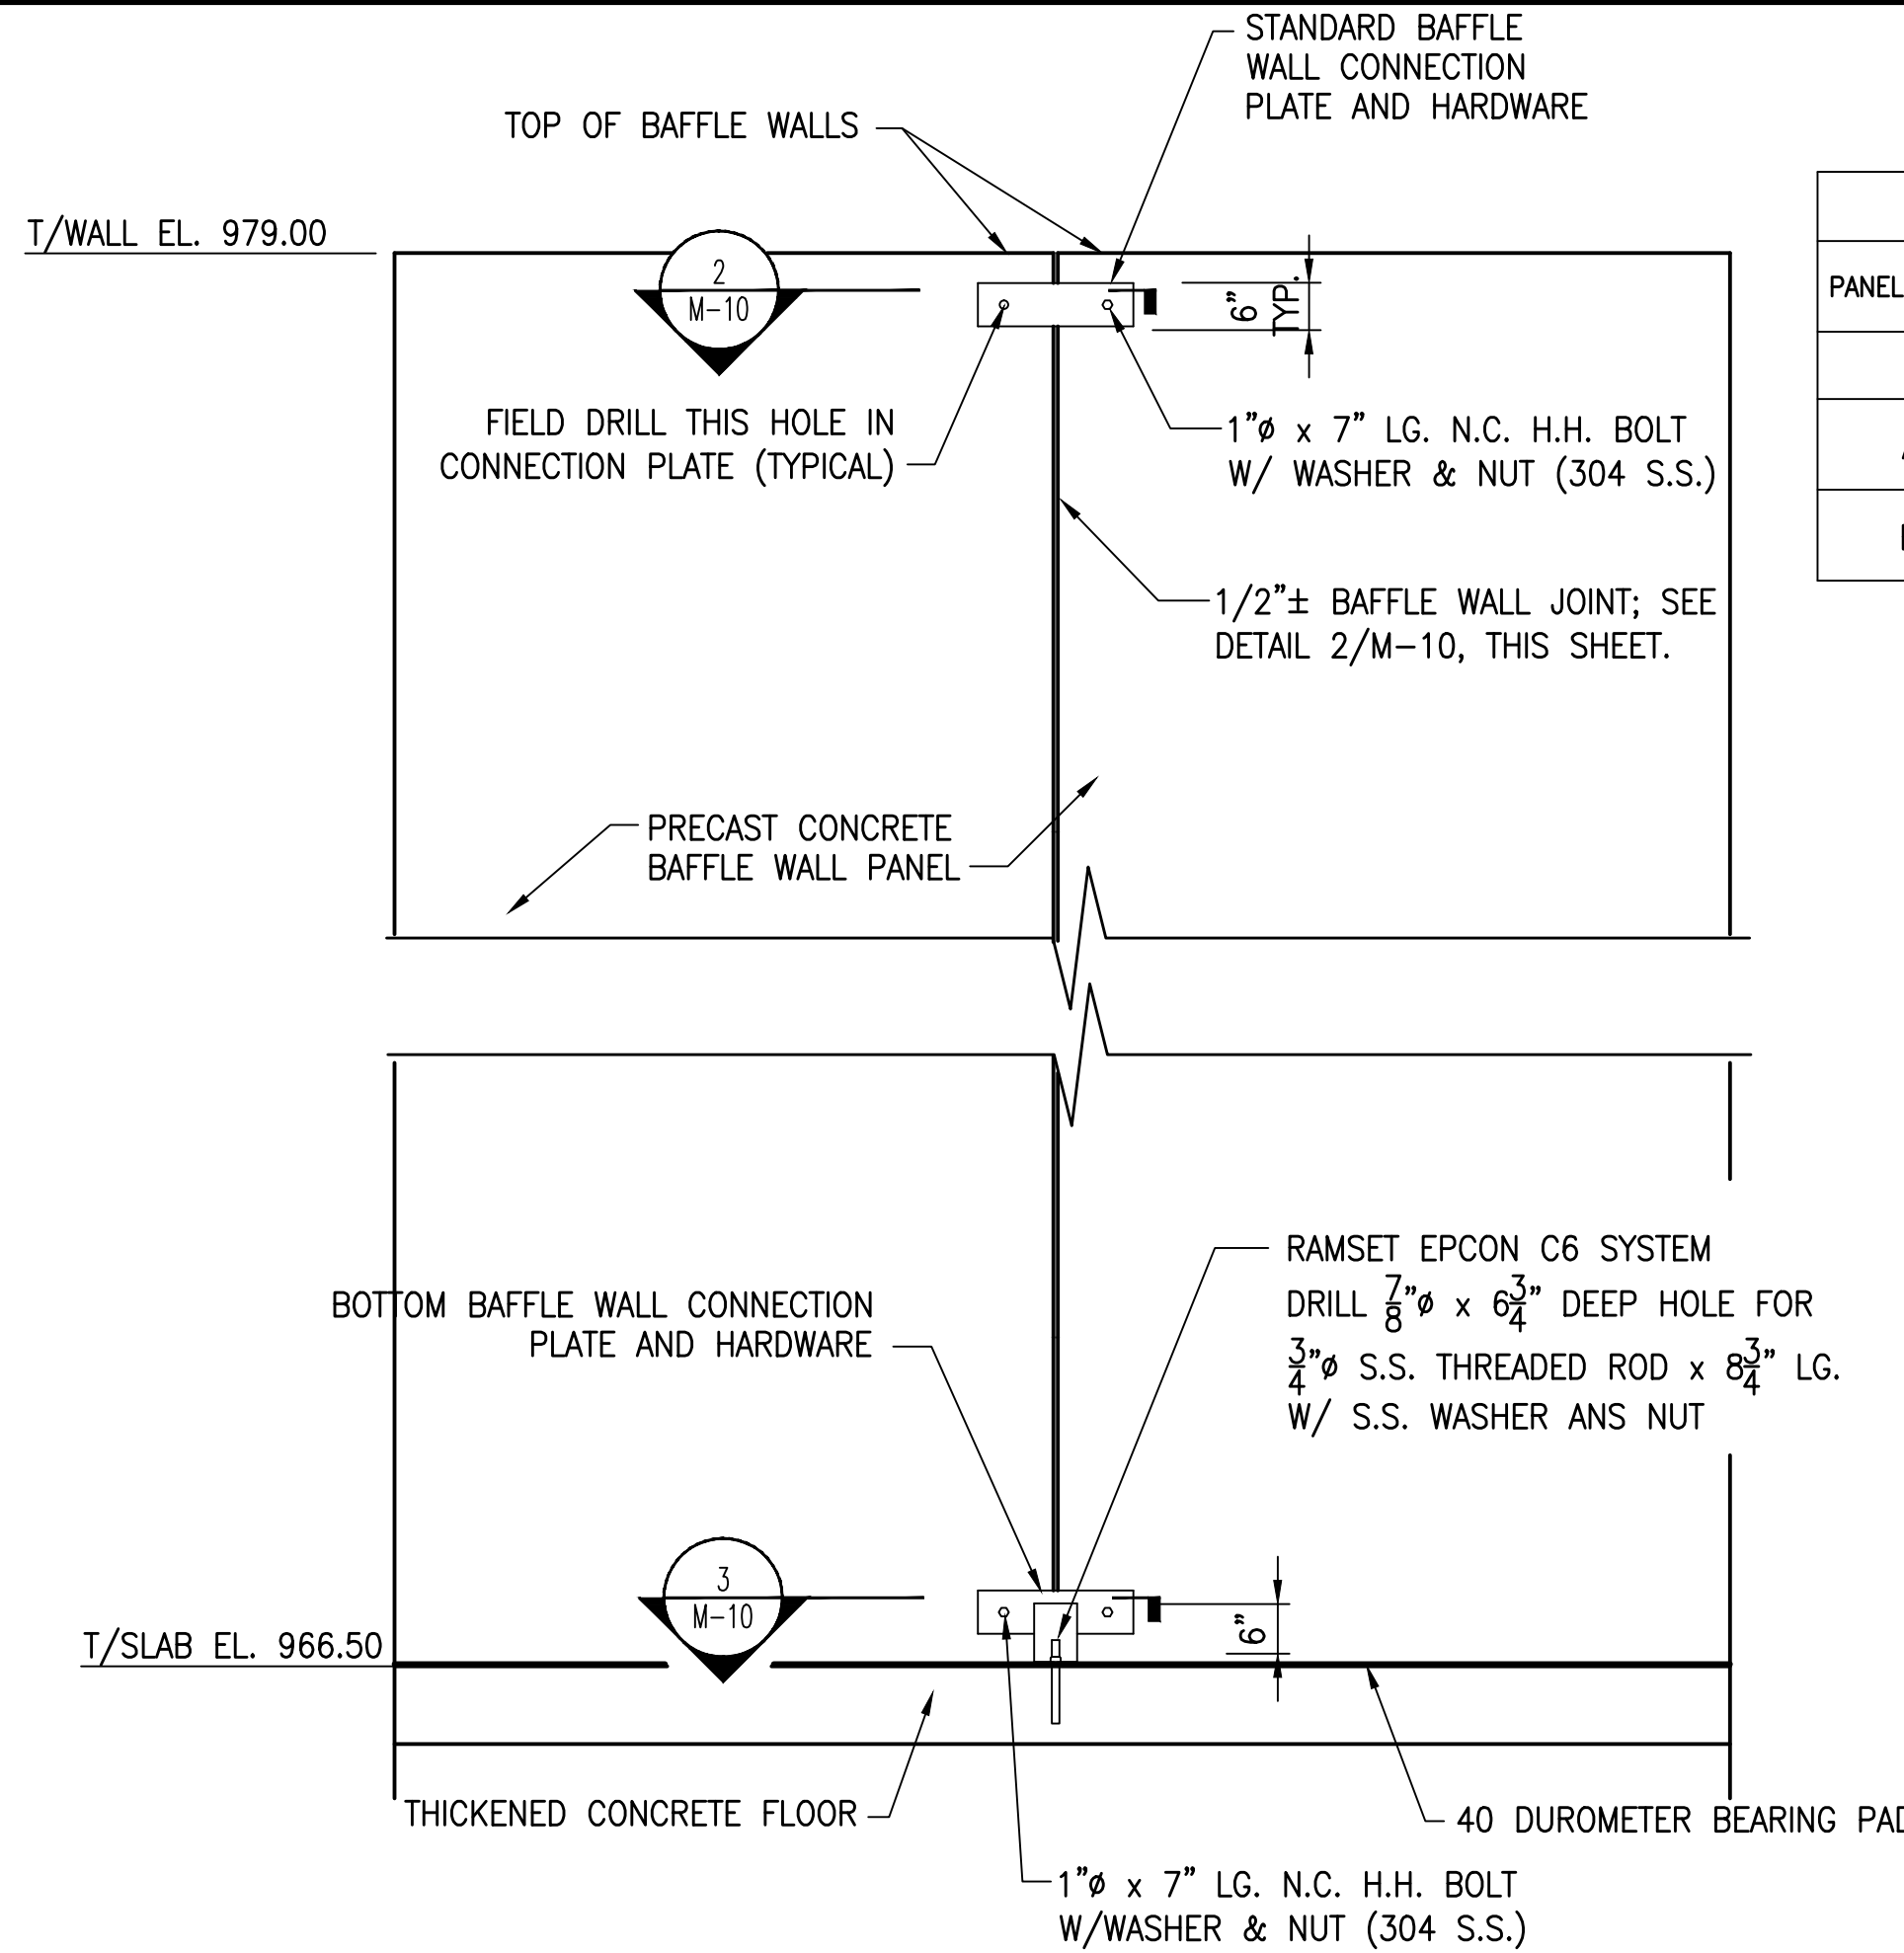


NOTE:
ANCHORING SYSTEM PER TANK
MANF. RECOMMENDATIONS

SECTION

SCALE: 1/2" = 1'-0"

1
M-10


PRECAST BAFFLE WALL PANEL

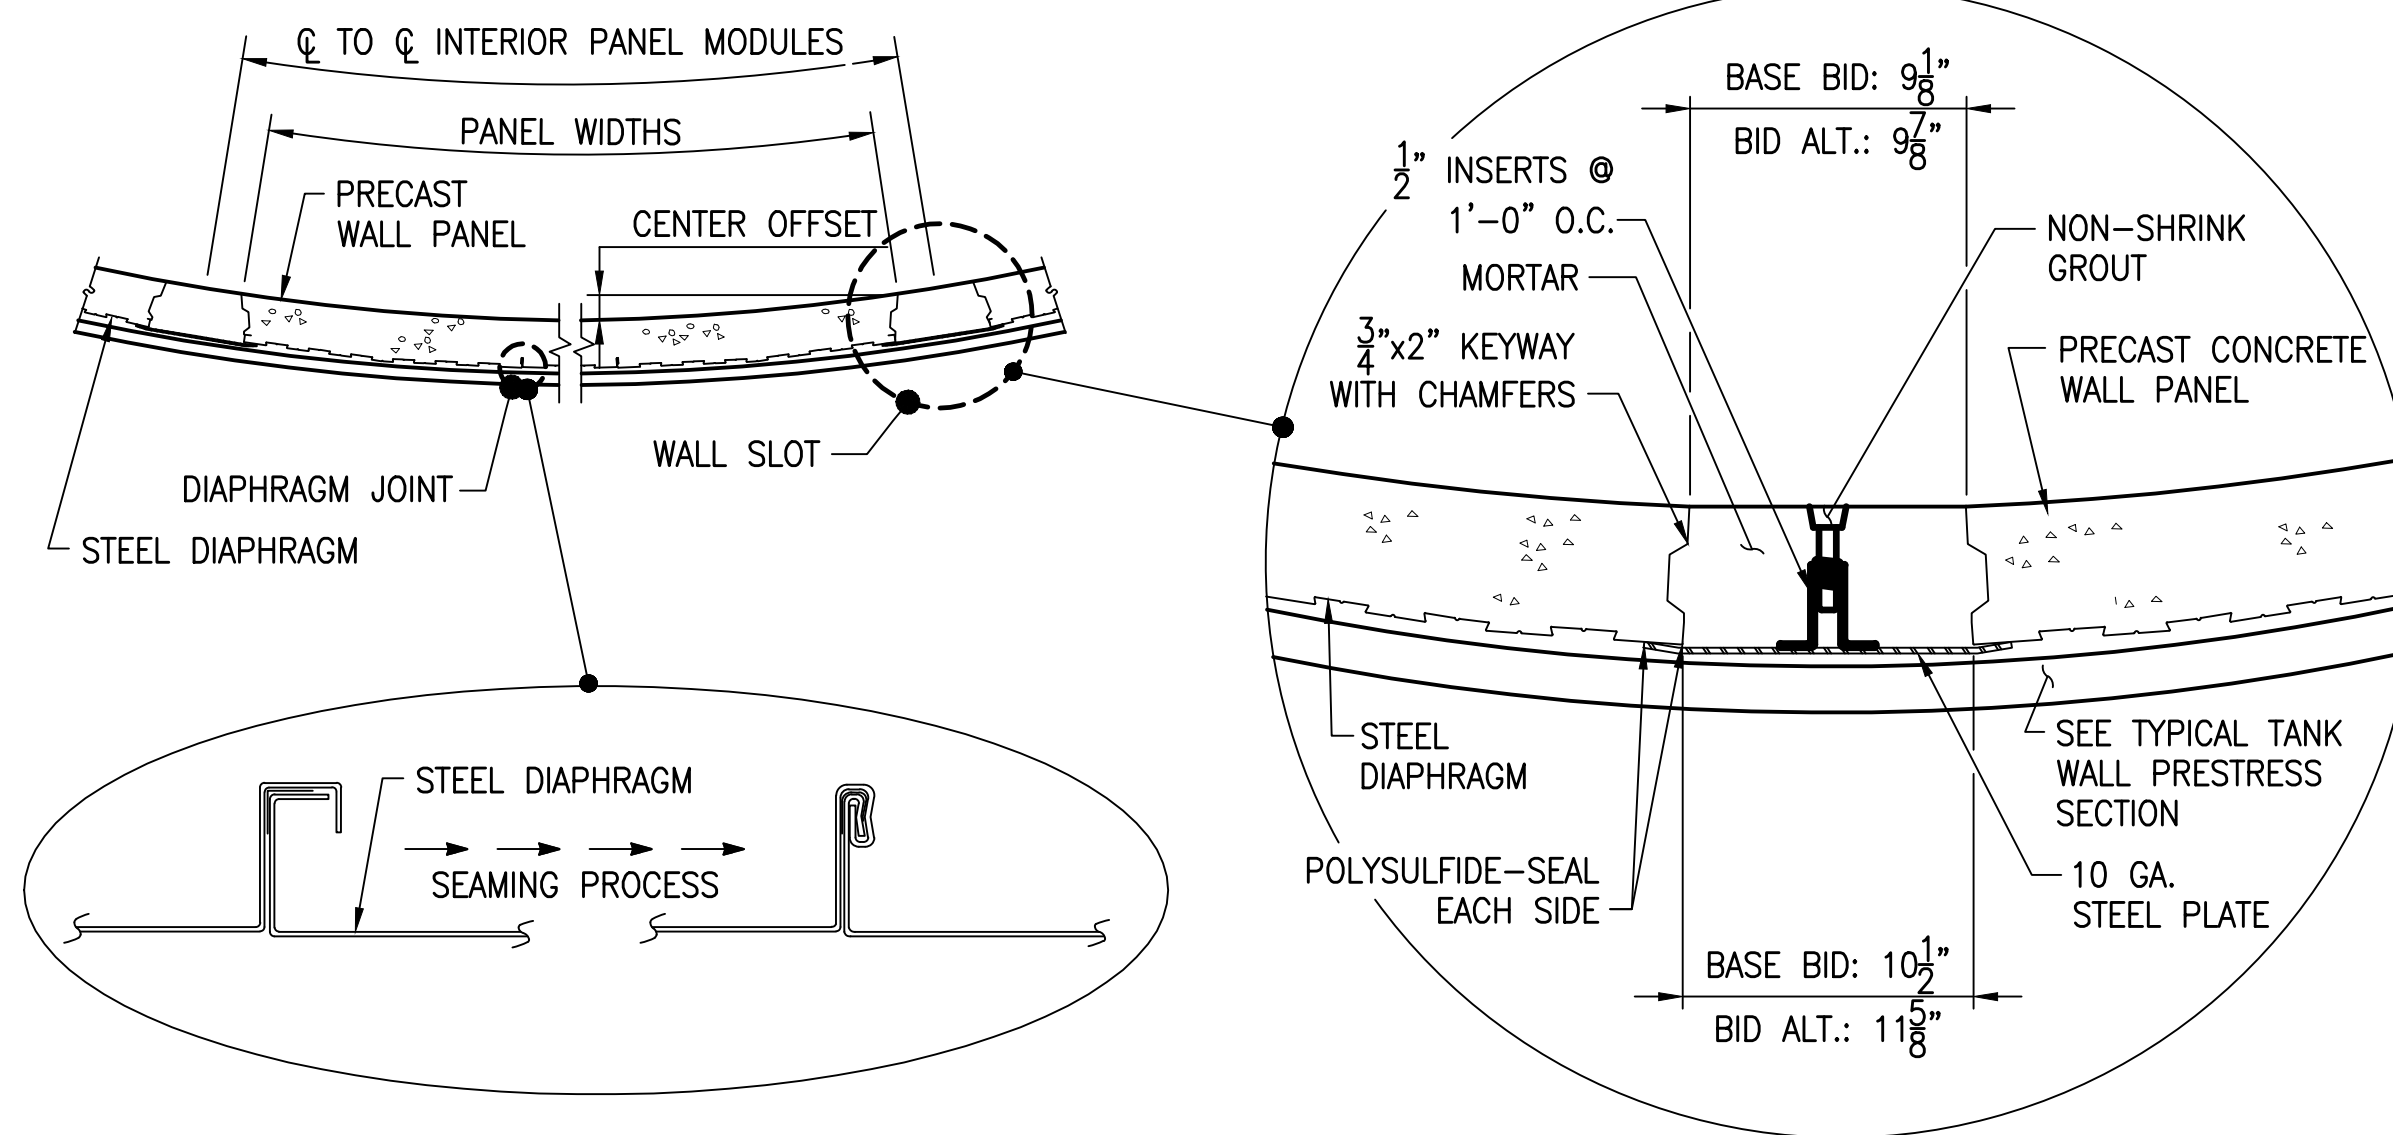

DETAIL
SCALE: NTS

6
M-10

WALL PANEL AND JOINT

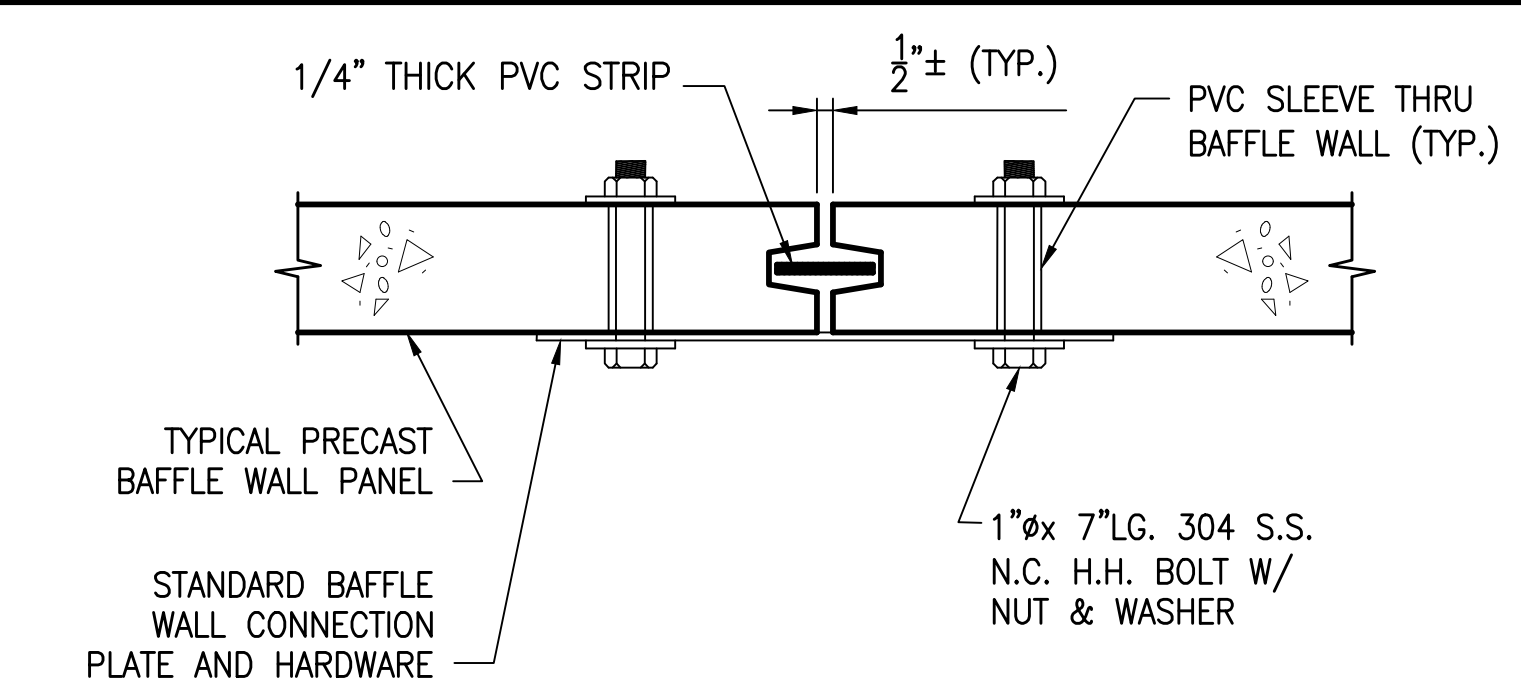

NOTE:
THIS CONNECTION IS REQUIRED AT THE
TOP OF THE BAFFLE WALL PANELS.


NOTE:
ANCHORING SYSTEM PER TANK
MANF. RECOMMENDATIONS

DETAIL

SCALE: NTS

2
M-10

TYPICAL JOINT CONNECTION

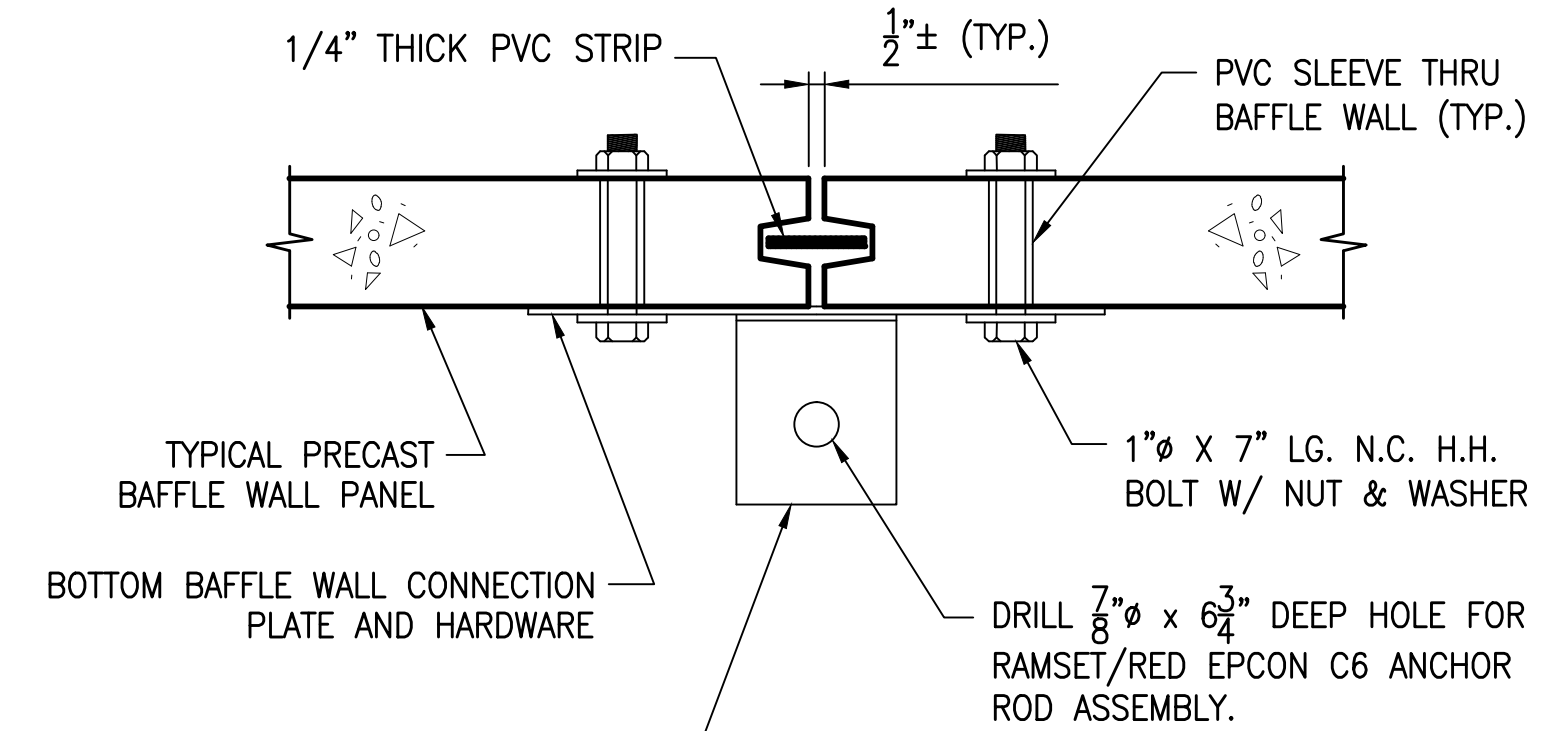

NOTE:
THIS CONNECTION IS REQUIRED AT THE
BOTTOM OF THE BAFFLE WALL PANELS


NOTE:
ANCHORING SYSTEM PER TANK
MANF. RECOMMENDATIONS

DETAIL

SCALE: NTS

3
M-10

TYPICAL JOINT CONNECTION

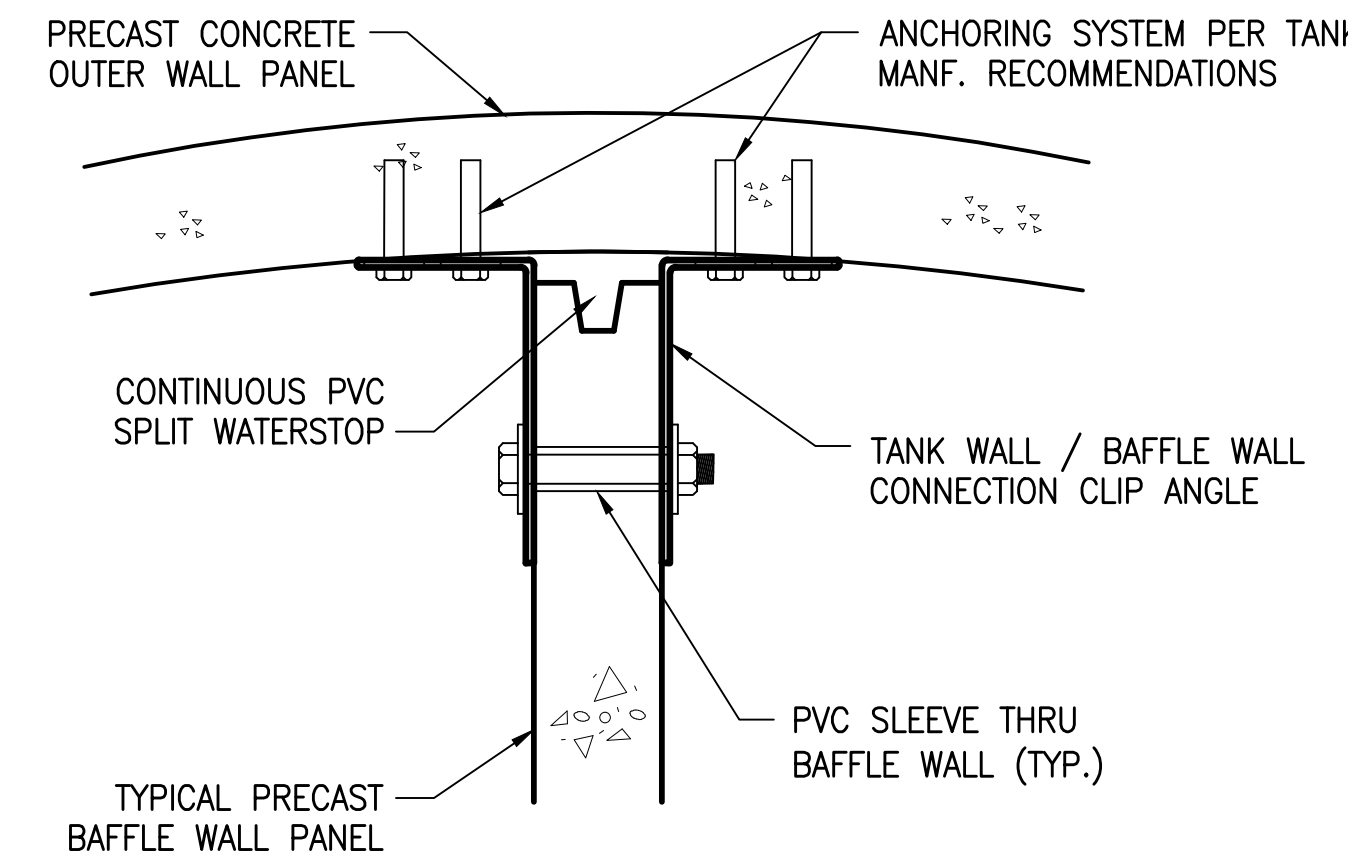

NOTE:
THIS CONNECTION IS REQUIRED AT THE TOP
AND BOTTOM OF THE BAFFLE WALL PANEL
WHERE IT ABUTTS INTO THE OUTER WALL.

DETAIL

SCALE: NTS

7
M-10

CONNECTION AT TANK WALL

NOTE: REFER TO MANUFACTURER'S AS-BUILTS FOR MORE INFORMATION.

THIS RECORD DOCUMENT HAS BEEN PREPARED BASED ON
INFORMATION PROVIDED BY THE CONSTRUCTION CONTRACTOR.
GRW ENGINEERS, INC. HAS ATTEMPTED TO VERIFY THE
ACCURACY AND/OR COMPLETENESS OF THIS INFORMATION BUT
SHALL NOT BE RESPONSIBLE FOR ANY ERRORS OR OMISSIONS
WHICH MAY BE INCORPORATED HEREIN AS A RESULT.

GRW
engineering | architecture | geospatial
ENGINEER/ARCHITECT: **Darren S. Wells**
CONSTRUCTION COMPANY: **NATGUN CORPORATION**
DATE: **FEBRUARY 2014**

NEW CLEARWELL FLOOR PLAN &
WALL SECTIONS & DETAILS
HOOSIER HILLS REGIONAL WATER DISTRICT
CONTRACTS G-1 & G-5



engineering | architecture | geospatial

CLIENT CONTRACT NO. G-1/G-5				GRW PROJECT NO. 3235-04			
DRAWING SCALE CHECK: <input type="checkbox"/>				THIS MARK SHOULD MEASURE EXACTLY 1" WHEN PLOTTED			
ALL RIGHTS RESERVED: THIS DOCUMENT IS THE PROPERTY OF GRW, INC. AND SHALL NOT BE REPRODUCED IN WHOLE OR IN PART OR USED FOR CONSTRUCTION OF OTHER THAN THIS SPECIFIC PROJECT WITHOUT WRITTEN PERMISSION OF GRW, INC.				This document, originally issued, sealed, and signed by Darren S. Wells, Indiana Professional Engineer, No. 10100200, on March 26, 2012, shall not be used in lieu of a certified document.			
DESIGNED: DSW		DATE: FEBRUARY 2012		DRAWN: JAJ		SCALE: AS SHOWN	
REVIEWED: DRC		DATE: 2/14		BY: JAJ		SHEET NO. M-10	
APPROVED: DSW		DATE: 2/14		BY: JAJ			