


BASE BID

BID ALT.

- NOTES:
1. SPLICE CIRCUMFERENTIAL JOINT REINFORCING BETWEEN RADIAL JOINTS.
 2. RADIAL DIMENSIONS ARE HORIZONTAL PROJECTIONS.
 3. DOME PANELS, DOME RING, AND DOME SLOTS SHALL RECEIVE A LIGHT BROOM FINISH.


DETAIL 1 DOME SECTOR
SCALE: NTS

DETAIL 2 DOME REINFORCING
SCALE: NTS

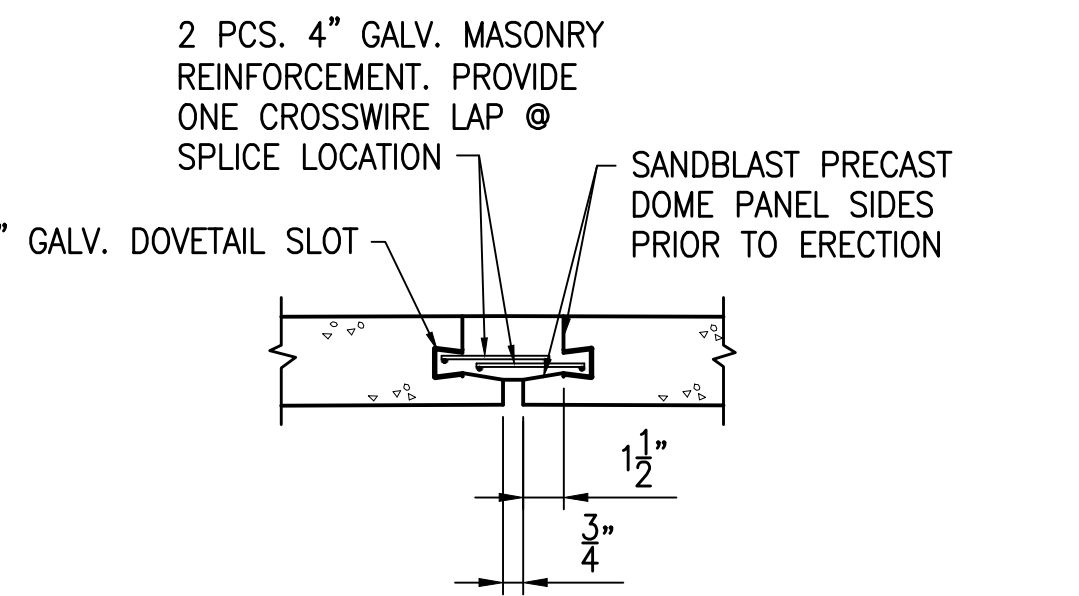


DETAIL 3 DOME REINFORCING
SCALE: NTS

- NOTES:
1. ALL ALUMINUM SHALL BE ISOLATED FROM CONCRETE BY A NEOPRENE GASKET.
 2. HATCH TO BE SECURED TO CURB WITH S.S. WEDGE ANCHORS EA. SIDE.
 3. PADLOCK AND KEY TO BE FURNISHED BY OWNER.
 4. HATCH TO BE FURNISHED WITH RIGID SAFETY GRATE.

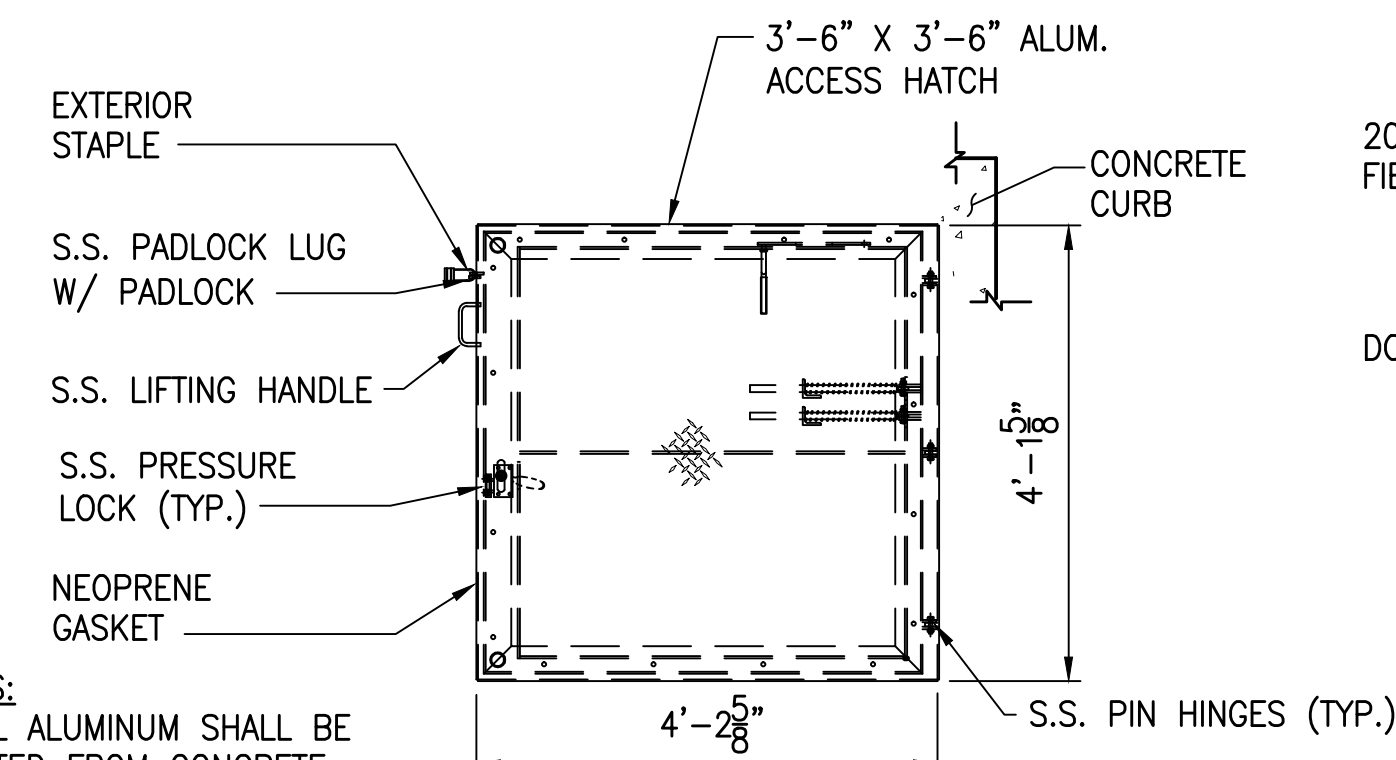


PLAN

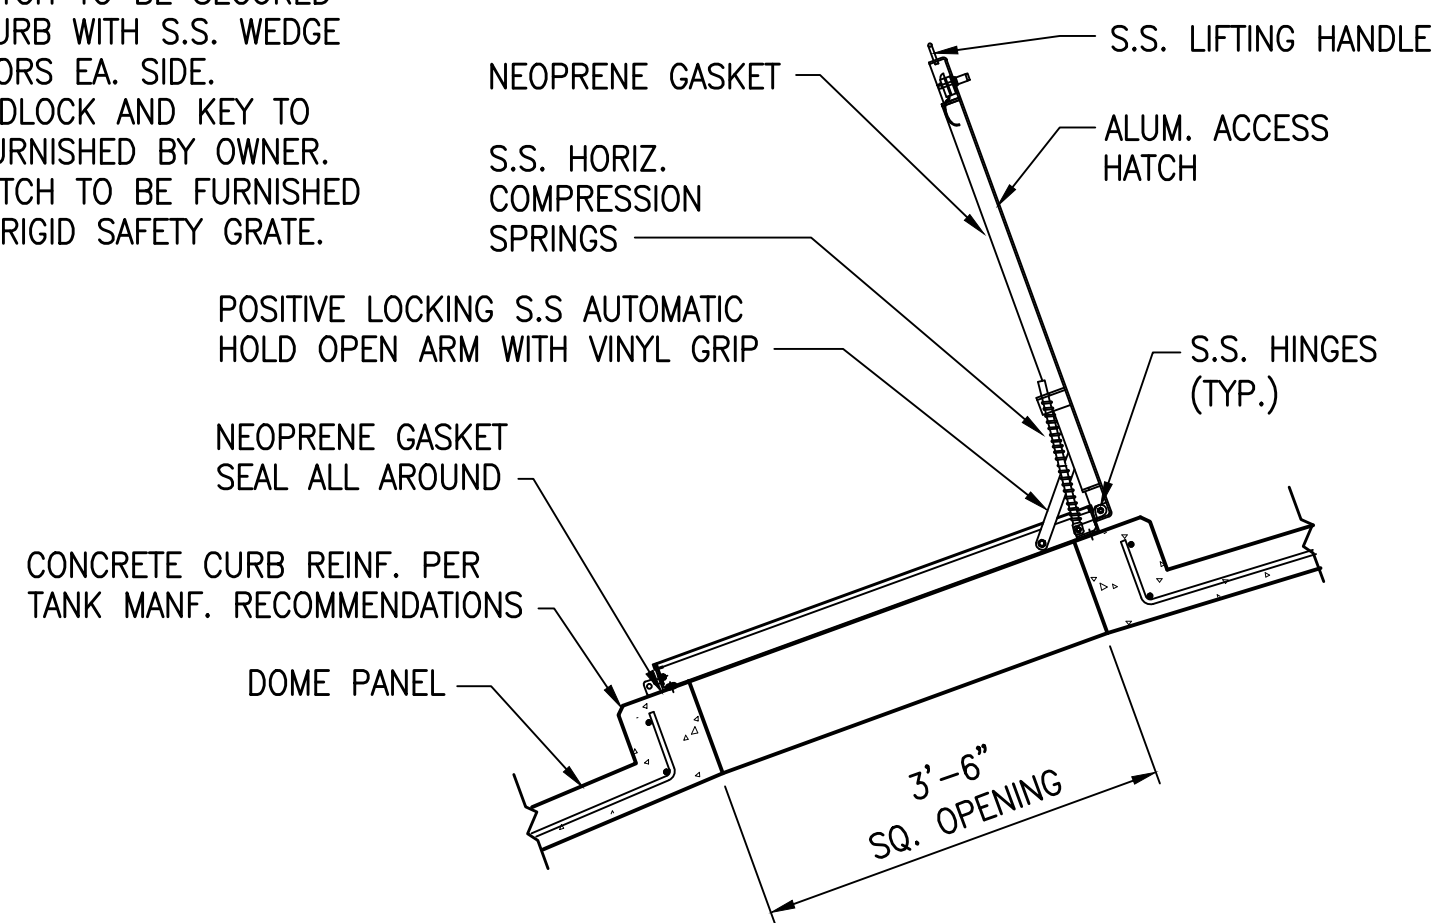


SECTION

DETAIL 4 DOME HATCH (TYP. OF 3)
SCALE: NTS

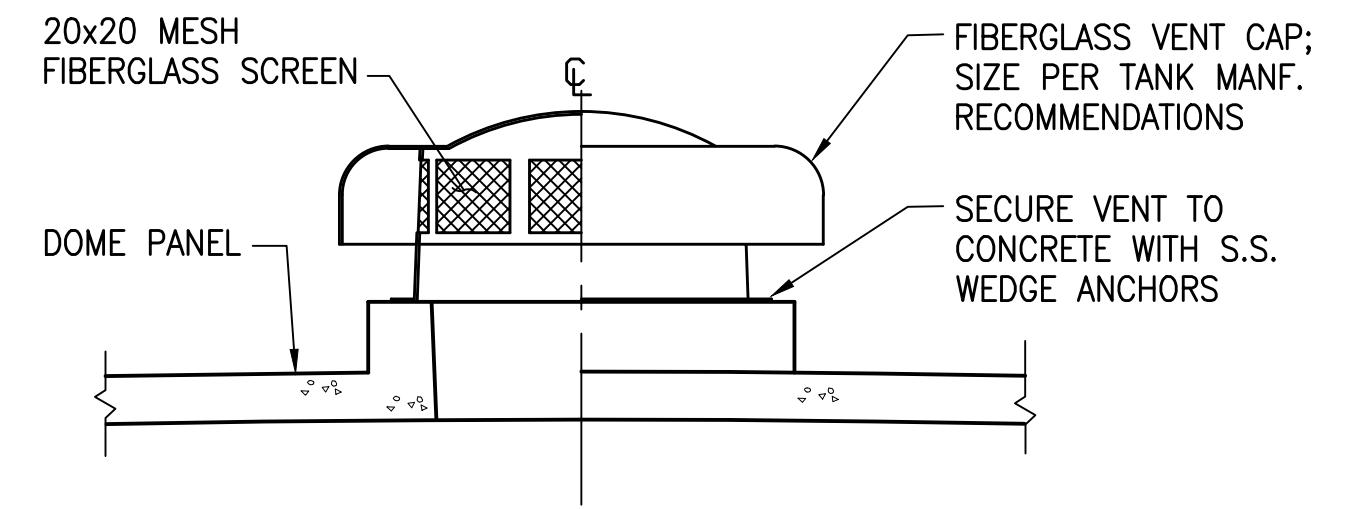


SECTION ELEVATION

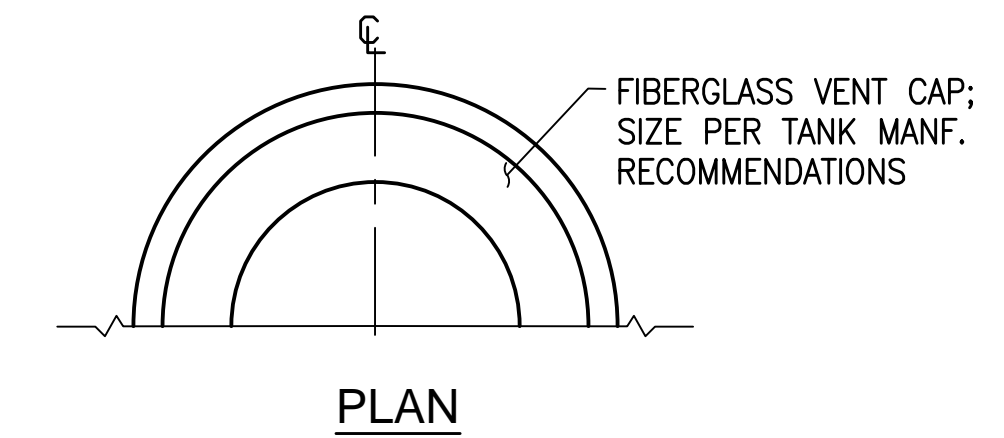


PLAN


DETAIL 5 DOME VENT
SCALE: NTS

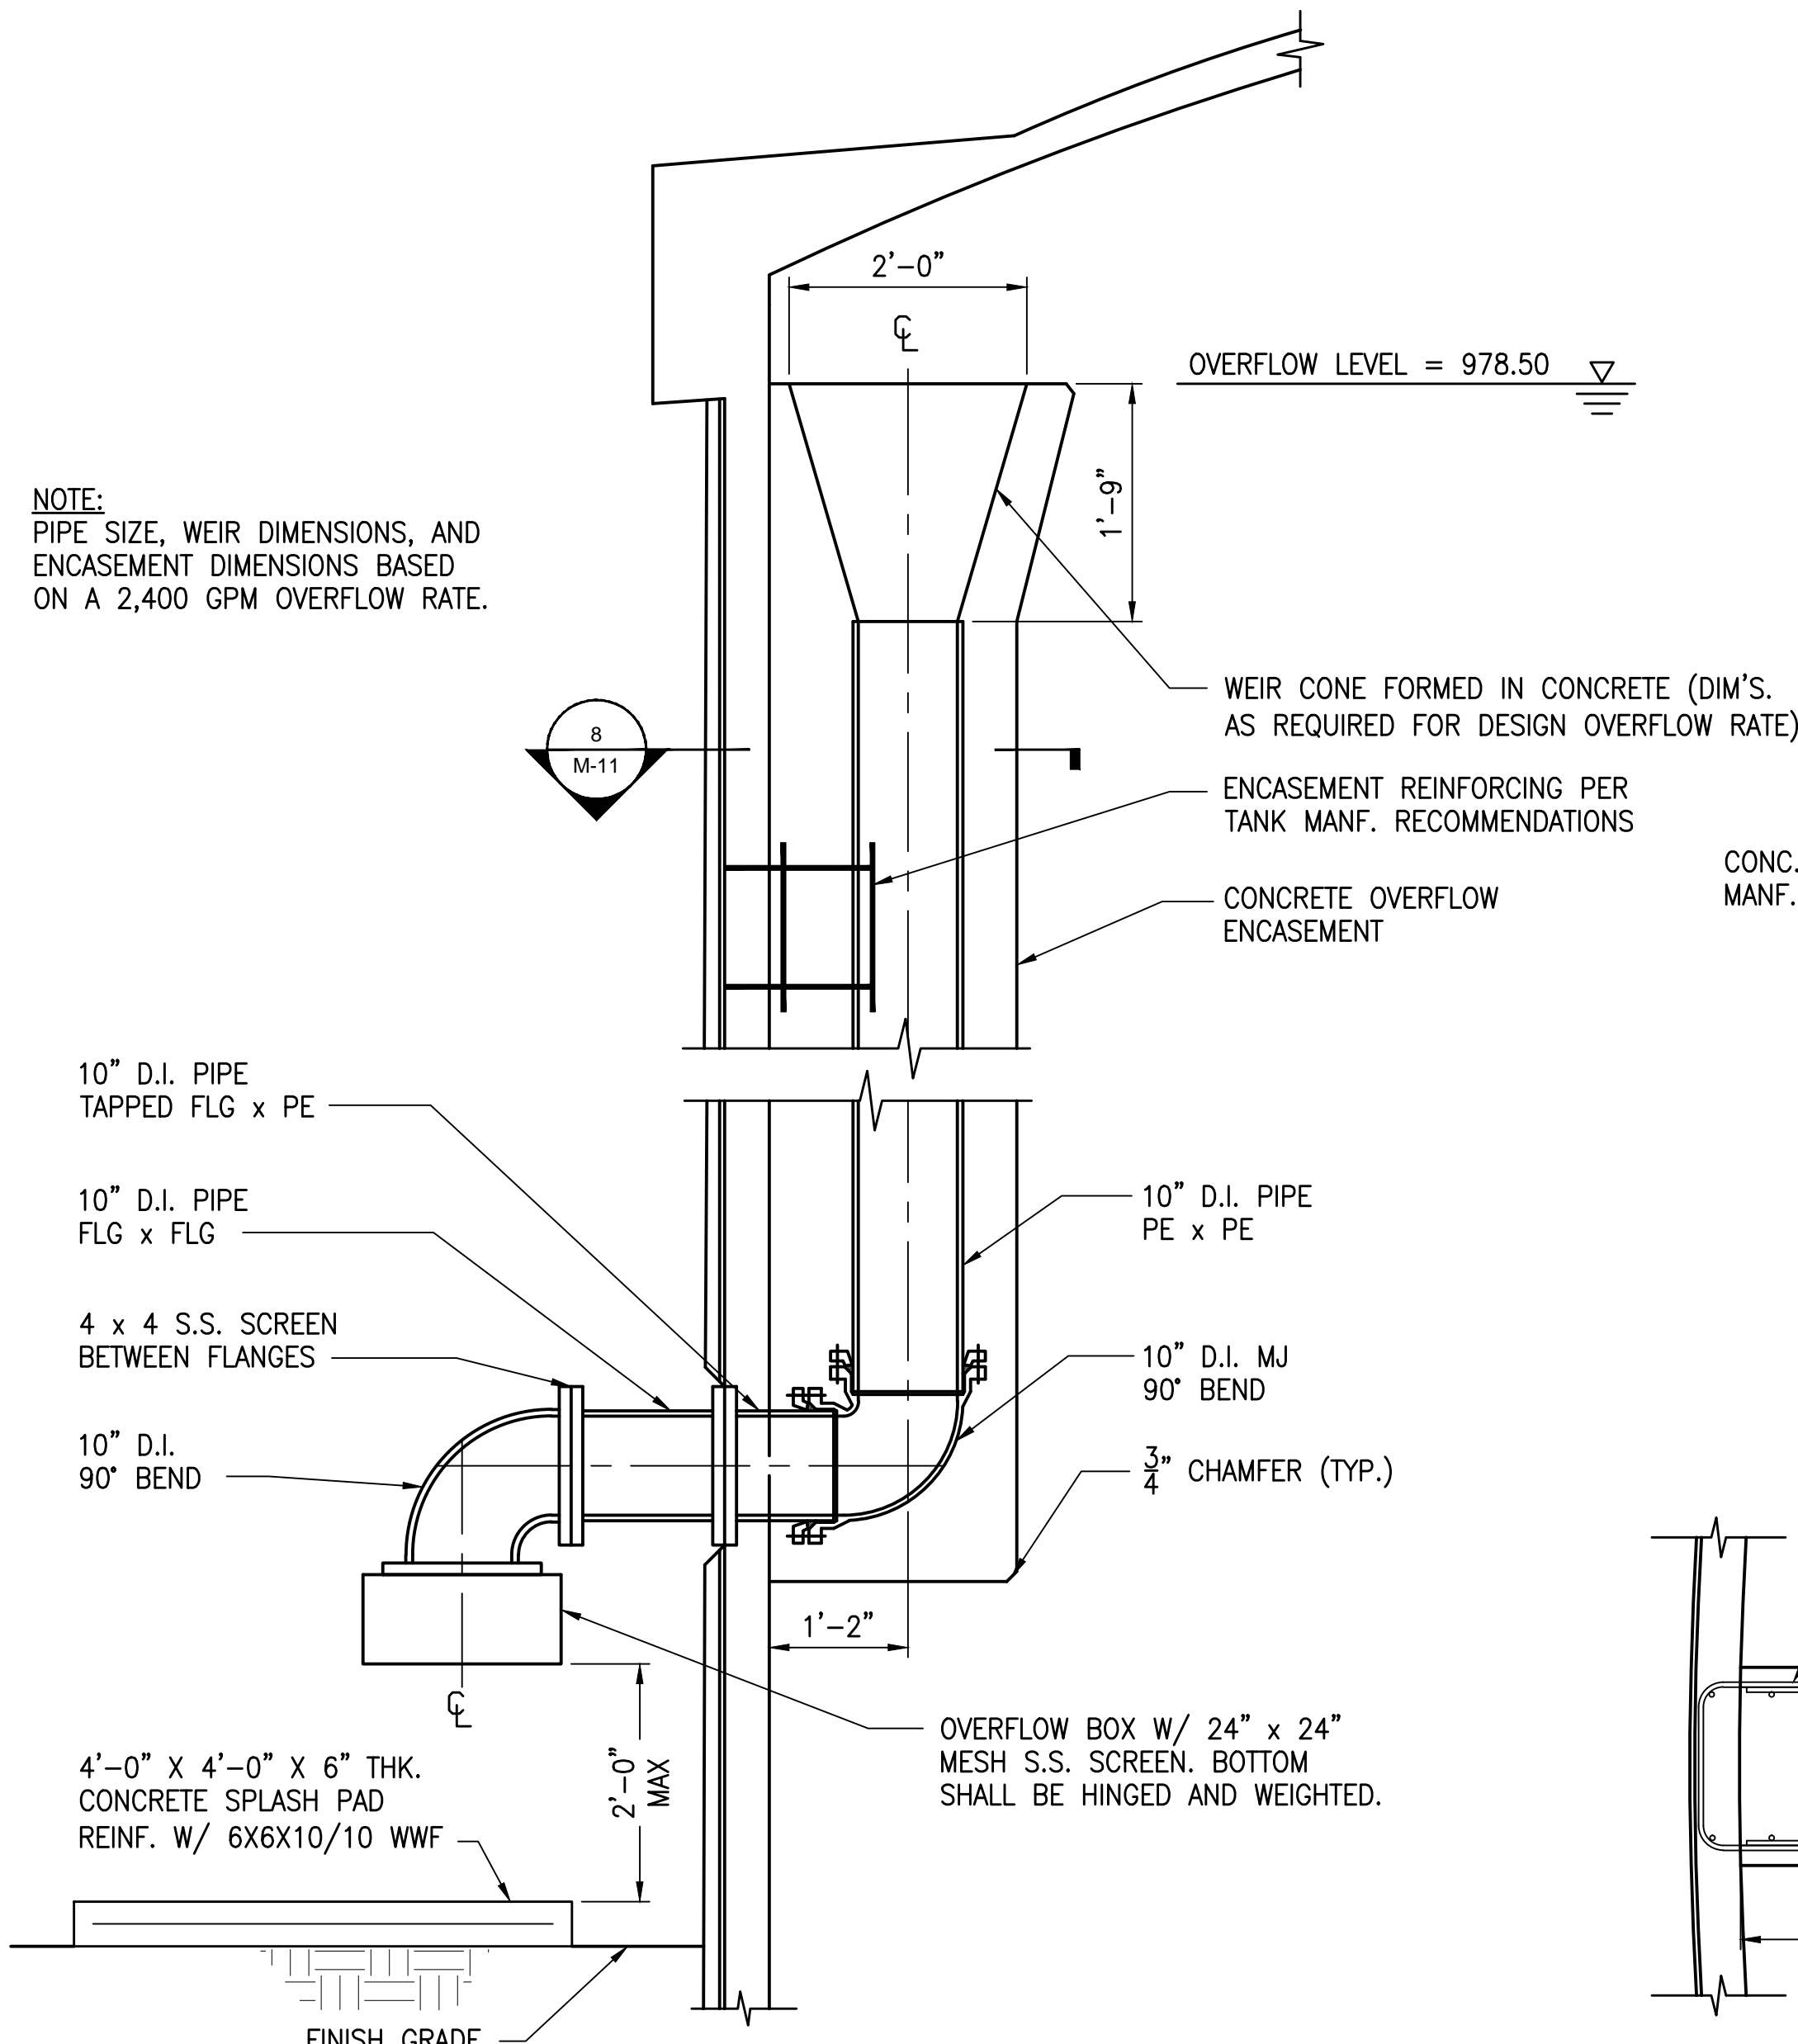


DETAIL 7 OVERFLOW PIPE
SCALE: NTS

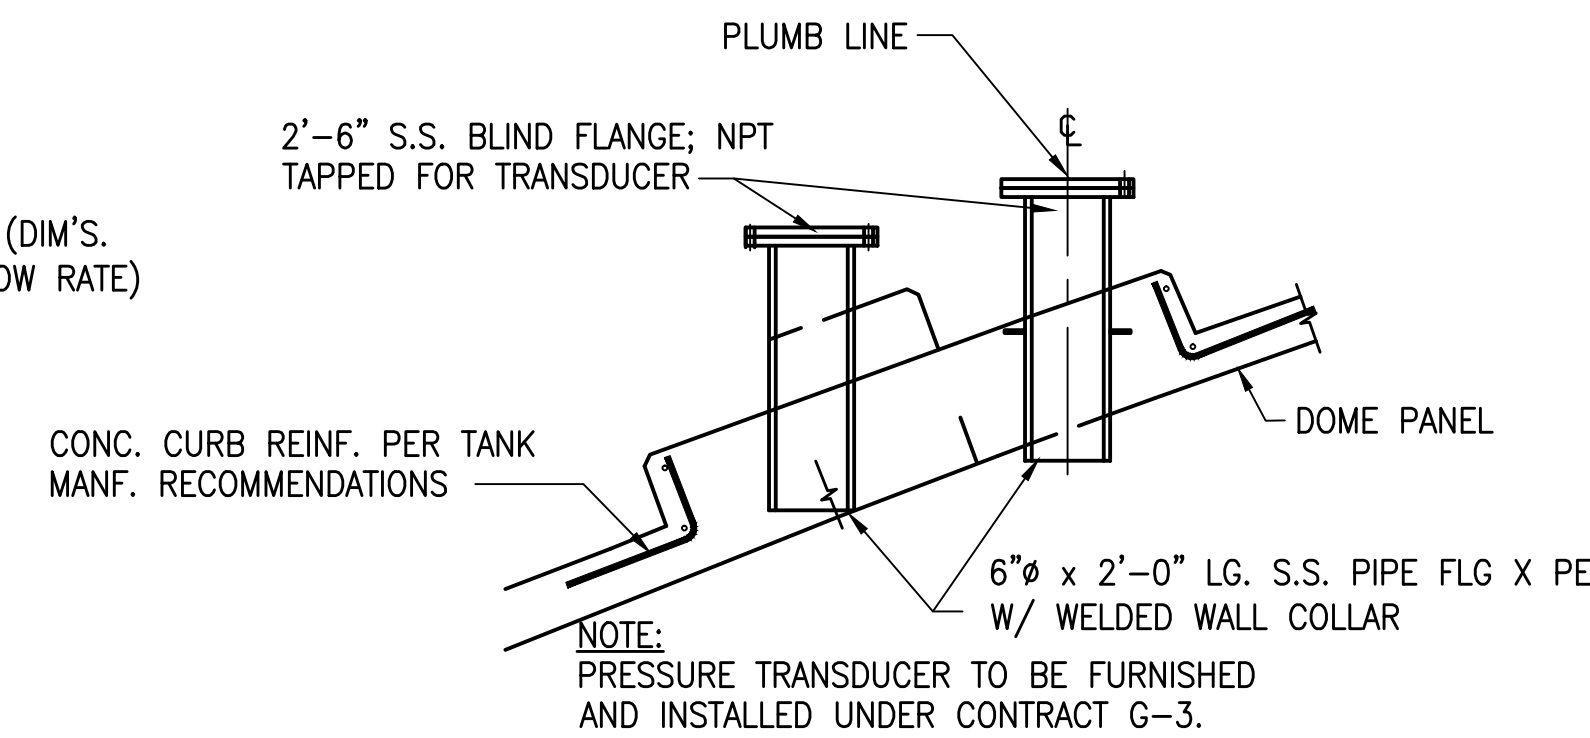

DETAIL 6 DOME PIPE SLEEVE (TYP. OF 2)
SCALE: NTS

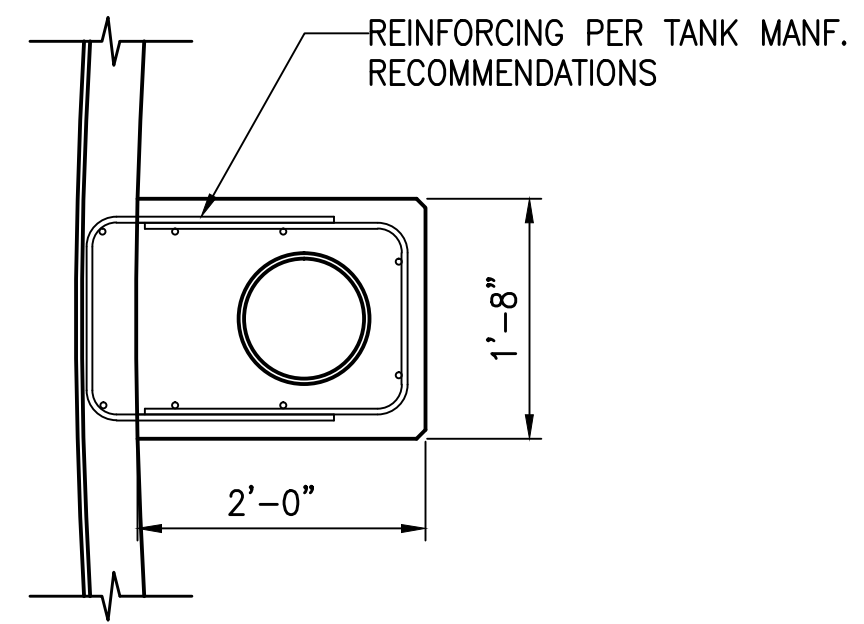

SECTION 8 OVERFLOW PIPE
SCALE: NTS

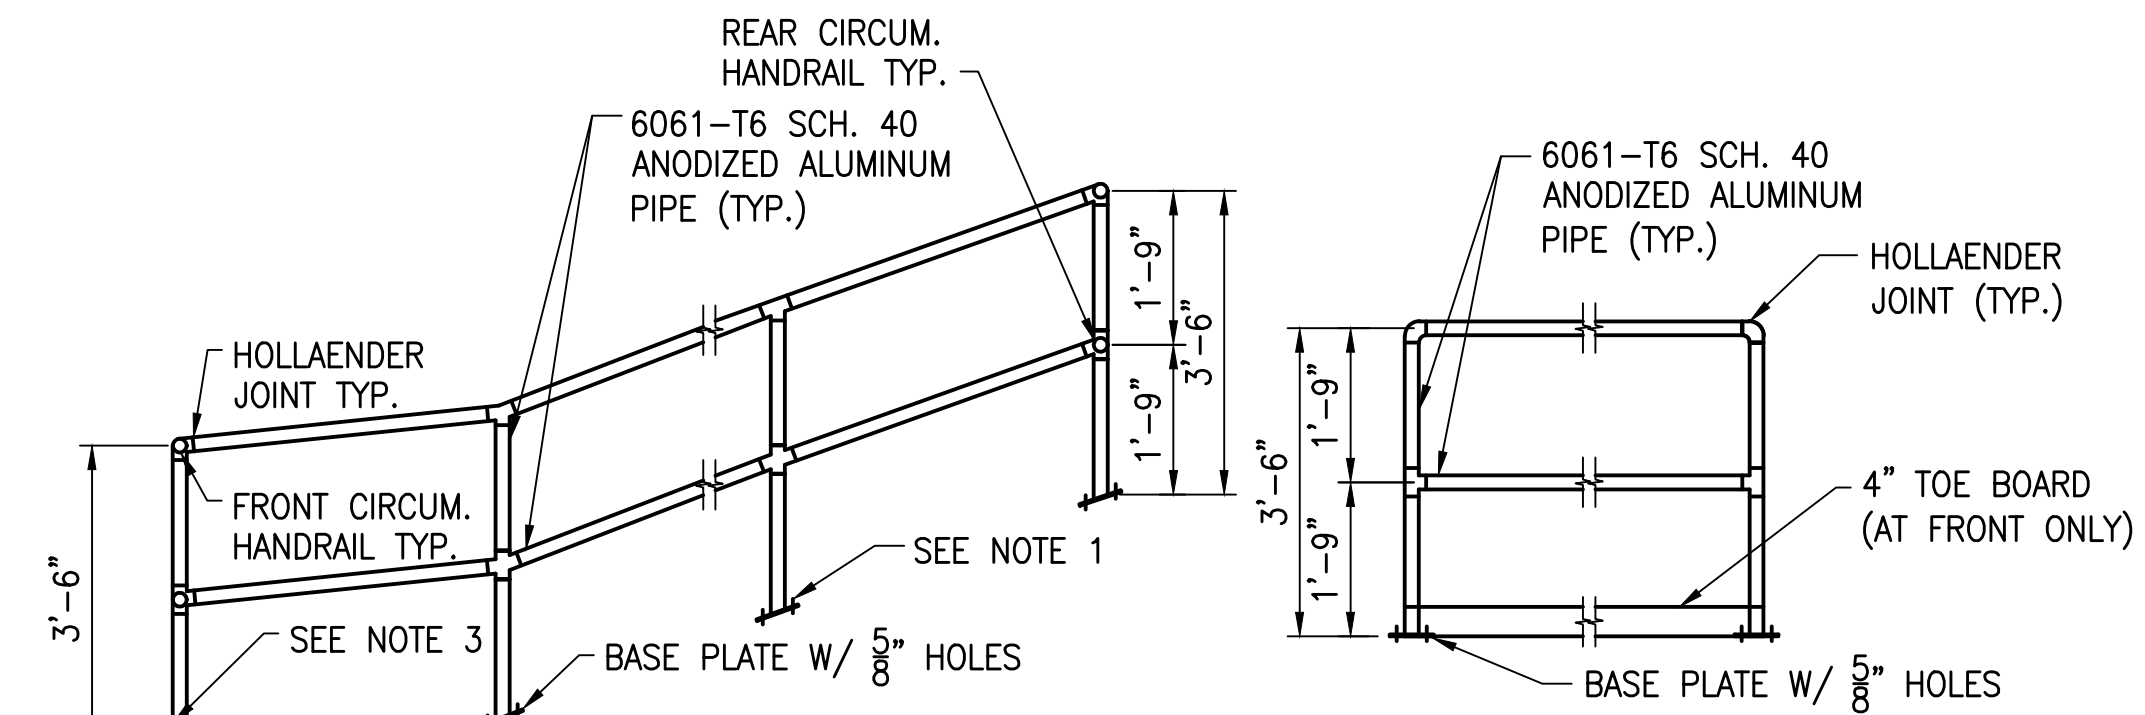

SIDE RAIL

FRONT AND REAR RAIL

- NOTES:
1. S.S. WEDGE ANCHORS TO BE USED AT EACH HANDRAIL/TANK CONNECTION.
 2. ALL ALUMINUM TO BE ISOLATED FROM CONCRETE USING NEOPRENE GASKETS.
 3. FOUR INCH TOE BOARD TO BE PROVIDED ON FRONT CIRCUMFERENTIAL HANDRAIL.

DETAIL 9 DOME HANDRAIL
SCALE: NTS

NOTE: REFER TO MANUFACTURER'S AS-BUILTS FOR MORE INFORMATION.

NEW CLEARWELL DETAILS				CLIENT CONTRACT NO. G-1/G-5		GRW PROJECT NO. 3235-04	
HOOSIER HILLS REGIONAL WATER DISTRICT				DRAWING SCALE CHECK: THIS MARK SHOULD MEASURE EXACTLY 1" WHEN PLOTTED		ALL RIGHTS RESERVED: THIS DOCUMENT IS THE PROPERTY OF GRW, INC. AND SHALL NOT BE REPRODUCED IN WHOLE OR IN PART OR USED FOR CONSTRUCTION OF OTHER THAN THIS SPECIFIC PROJECT WITHOUT WRITTEN PERMISSION OF GRW, INC.	
CONTRACTS G-1 & G-5				This document, originally issued, sealed, and signed by Darren S. Wells, Indiana Professional Engineer, No. 10100200, on March 26, 2012, shall not be used in lieu of a certified document.		DESIGNED: DSW DATE: FEBRUARY 2012 DRAWN: JAJ SCALE: N.T.S. REVIEWED: DRC SHEET NO. M-11	
1 AS-BUILTS				2/14 JAJ		APPROVED: DSW	
NO. DESCRIPTION				DATE BY			
REVISIONS							