



HOOSIER HILLS REGIONAL WATER DISTRICT DIVISION "G" WATERWORKS SYSTEM IMPROVEMENTS

CONTRACT G-2 - ELEVATED WATER STORAGE TANK RECORD DRAWINGS

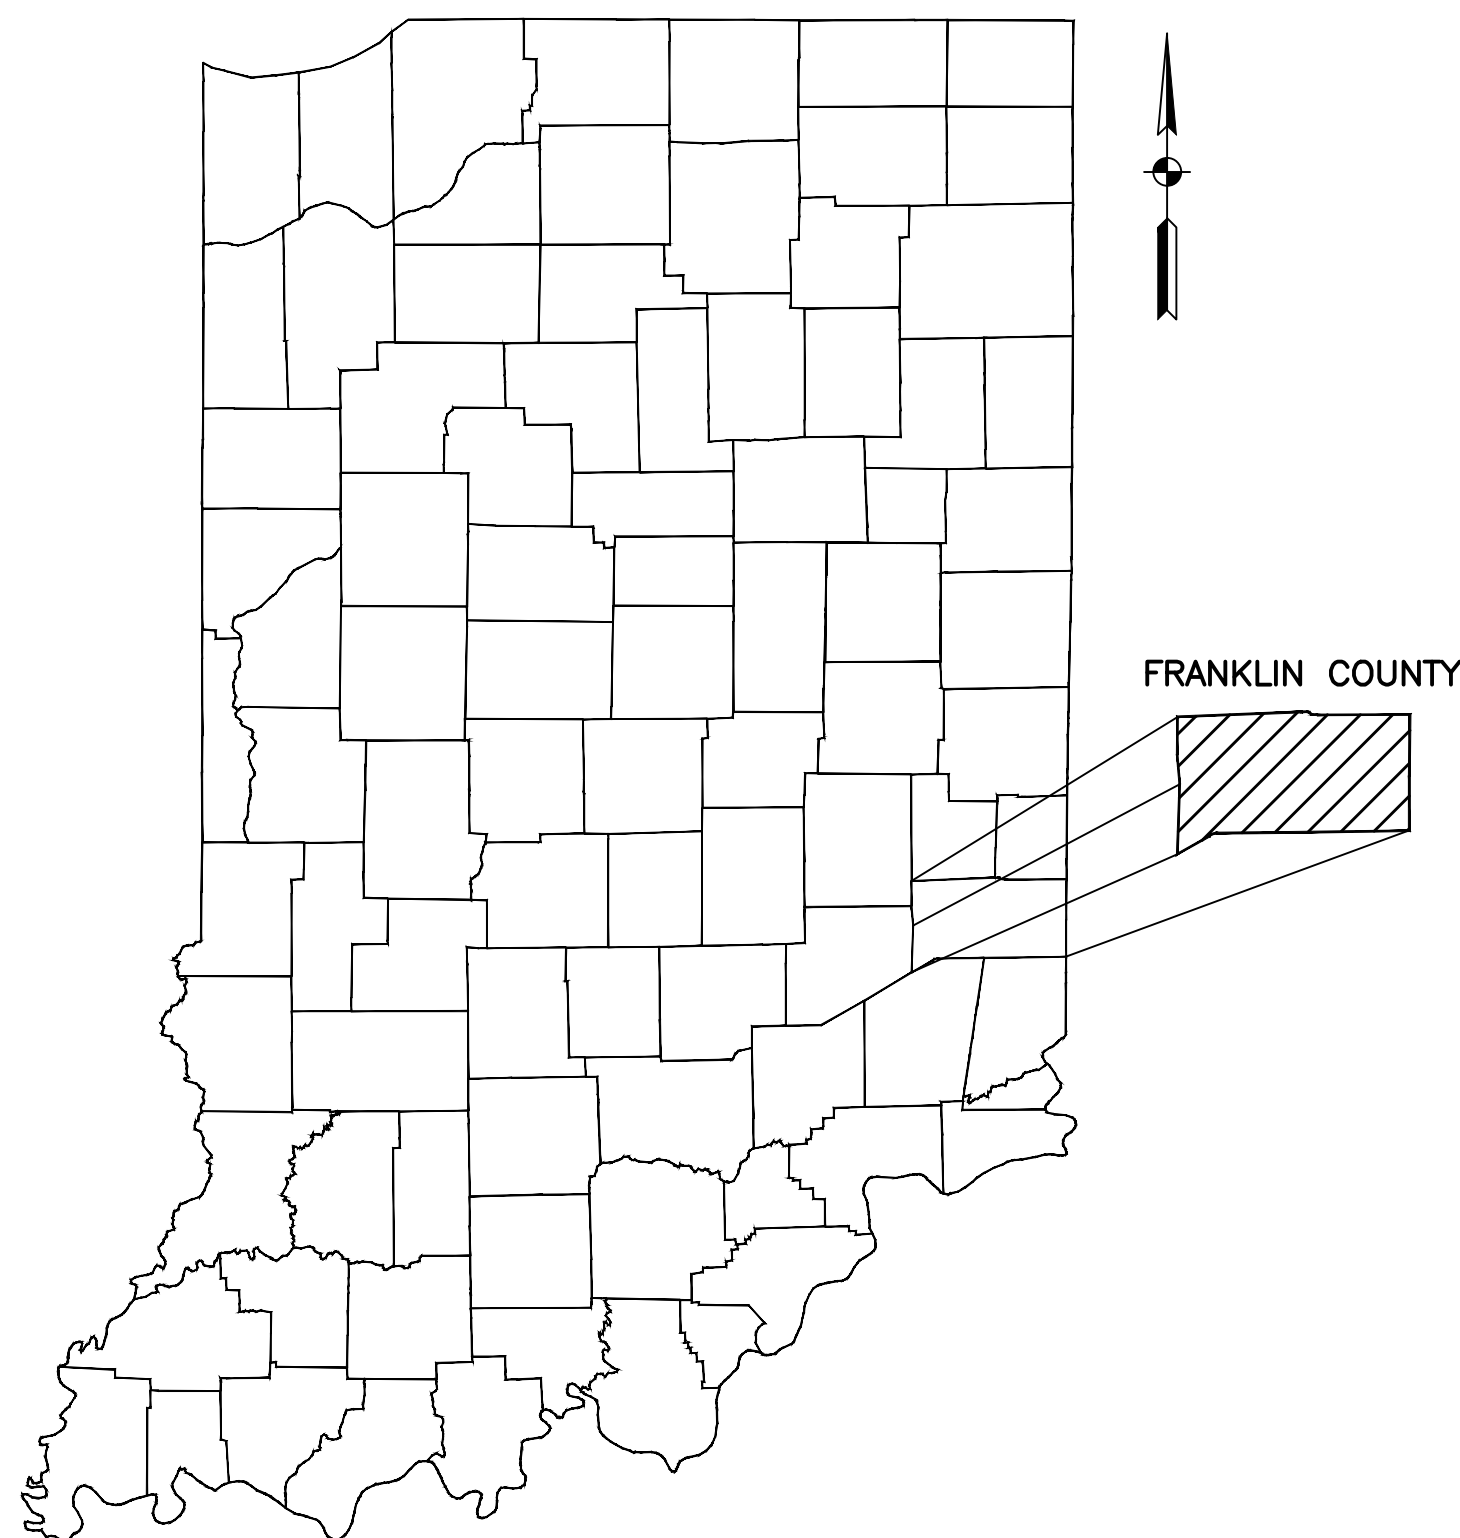

HOOSIER HILLS REGIONAL WATER DISTRICT BOARD OF DIRECTORS
GREGORY DOLE – PRESIDENT
RANDY SCUDDER – VICE PRESIDENT
CHARLES HYNES – SECRETARY
ANDREW WEISENBACH – TREASURER
JOHN AMBERGER – ASST. TREASURER
TED MEER – BOARD MEMBER
ROY B. MEYER – BOARD MEMBER
RUSSELL MORTARA – BOARD MEMBER
ANTHONY CLARK – BOARD MEMBER
SCOTT STIRN – GENERAL MANAGER

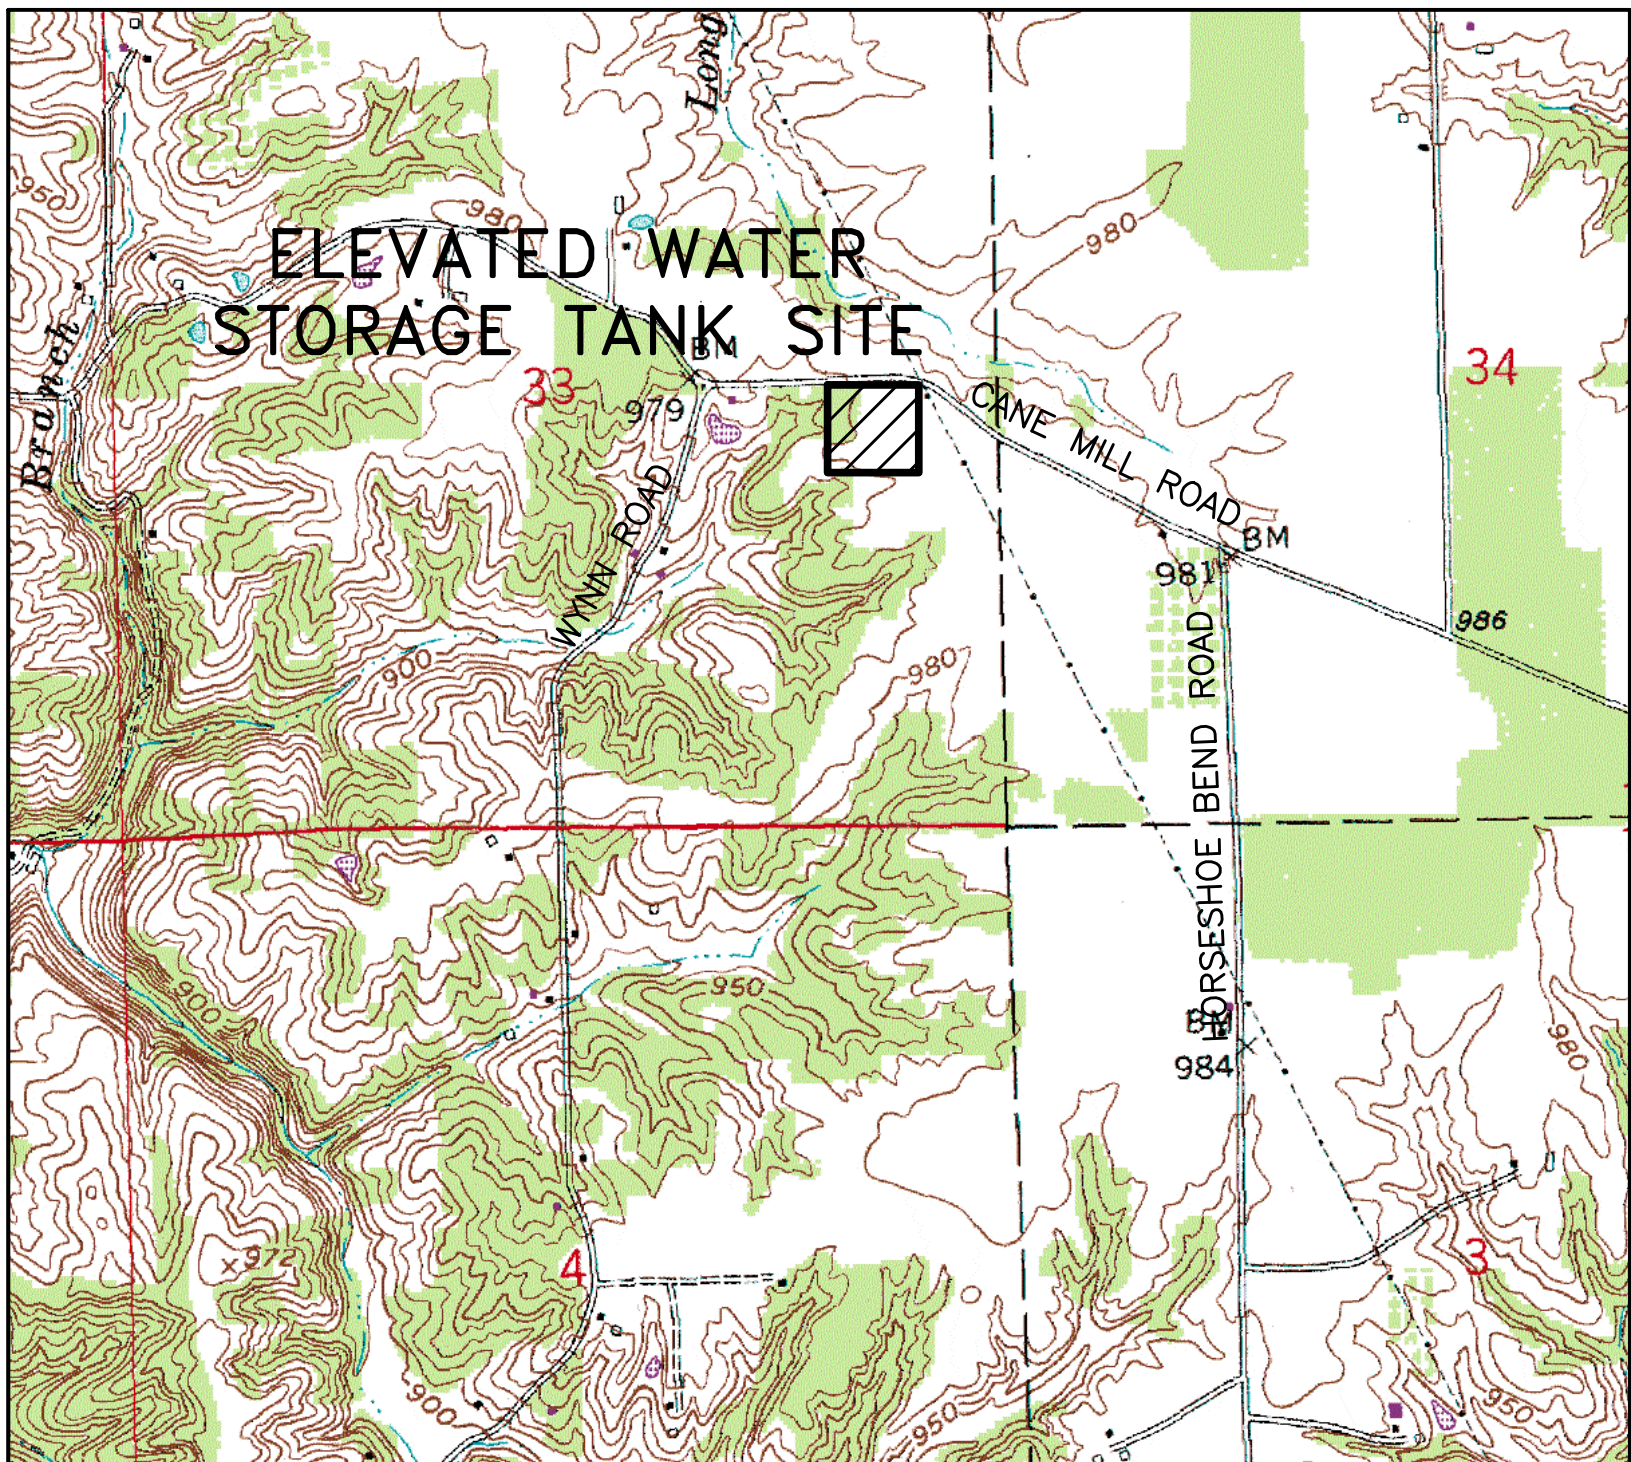

This document, originally issued, sealed, and signed by Alex White, Indiana Professional Engineer, No. 11100292, on March 26, 2012 shall not be used in lieu of a certified document.

THIS RECORD DOCUMENT HAS BEEN PREPARED BASED ON INFORMATION PROVIDED BY THE CONSTRUCTION CONTRACTOR. GRW ENGINEERS, INC. HAS ATTEMPTED TO VERIFY THE ACCURACY AND/OR COMPLETENESS OF THIS INFORMATION BUT SHALL NOT BE RESPONSIBLE FOR ANY ERRORS OR OMISSIONS WHICH MAY BE INCORPORATED HEREIN AS A RESULT.

GRW
ENGINEERS - ARCHITECTS - PLANNERS
www.grwinc.com

ENGINEER/ARCHITECT: ALEX L. WHITE
CONSTRUCTION COMPANY: CALDWELL TANKS, INC.
DATE: JANUARY 2014

ALEX L. WHITE
INDIANA REG. NO. 11100292

DATE: MARCH 26, 2012

MARCH 2012

NOTE: REFER TO MANUFACTURER'S AS-BUILTS FOR MORE INFORMATION.

GRW PROJECT NO. 3235-04