


COMPOSITE WATER STORAGE TANK — DETAIL SCALE: N.T.S.

NOTES: 1. CONTRACTOR SHALL INSTALL FROST PROOF SPIGOT ON RISER PIPE FOR ALL TYPES OF TANKS.

TANK INFORMATION						
	BASE BID					
STYLE	CONCRETE COMPOSITE TANK					
GALLONS	1,000,000					
TANK DIAMETER	74'					
HIGH WATER LEVEL H.W.L.	1160.00					
ELEV. @ TOP OF FDN./FINISHED GRADE	979.33/980.50					
HEAD RANGE	35					
TOP OF FDN./FINISHED GRADE TO H.W.L.	180'-8"					
TOP OF FDN. TO L.W.L.	145'-8"					
INLET/OUTLET PIPE SIZE	20"					

## NOTE: REFER TO MANUFACTURER'S AS-BUILTS FOR MORE INFORMATION.

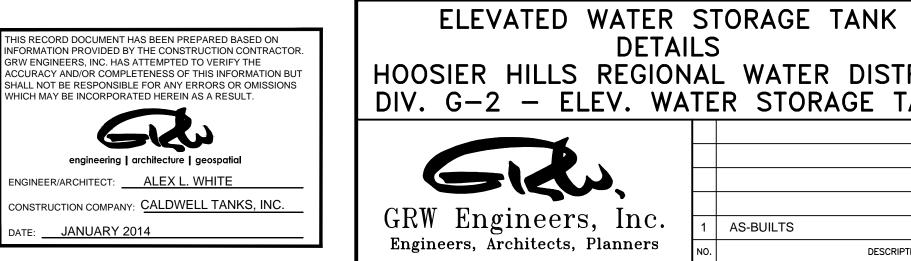

DETAILS HOOSIER HILLS REGIONAL WATER DISTRICT DIV. G-2 - ELEV. WATER STORAGE TANK			DRAWING SCALE CHECK:   THIS MARK SHOULD MEASURE EXACTLY 1" WHEN PLOTTED  ALL RIGHTS RESERVED: THIS DOCUMENT IS THE PROPERTY OF GRW, INC. AND SHALL NOT BE REPRODUCED IN WHOLE OR IN PART OR USED FOR CONSTRUCTION OF OTHER THAN THIS SPECIFIC PROJECT WITHOUT WRITTEN PERMISSION OF GRW, INC.					
						This document, originally issued,	DESIGNED: ALW	DATE: MARCH 2012
						sealed, and signed by Alex L. White, Indiana Professional Engineer,	DRAWN: GCR	scale: AS SHOWN
GRW Engineers, Inc.	1	AS-BUILTS		2/14	MAA			SHEET NO.
Engineers, Architects, Planners	NO.	DESCRIPTION		DATE	BY	,,,,,,,,,,,,,,,,,,,,,,,,,,,,,,,,,,,,,,,	UKC APPROVED:	$\cap$
LEXINGTON LOUISVILLE NASHVILLE INDIANAPOLIS		REVISIONS				or a certified	Λ1 \ <i>M</i>	0 02

CLIENT CONTRACT NO. G-2

GRW PROJECT NO. 3235