



HOOSIER HILLS REGIONAL WATER DISTRICT DIVISION "G" WATERWORKS SYSTEM IMPROVEMENTS

CONTRACT G-3 - PUMP STATIONS AND TELEMETRY IMPROVEMENTS

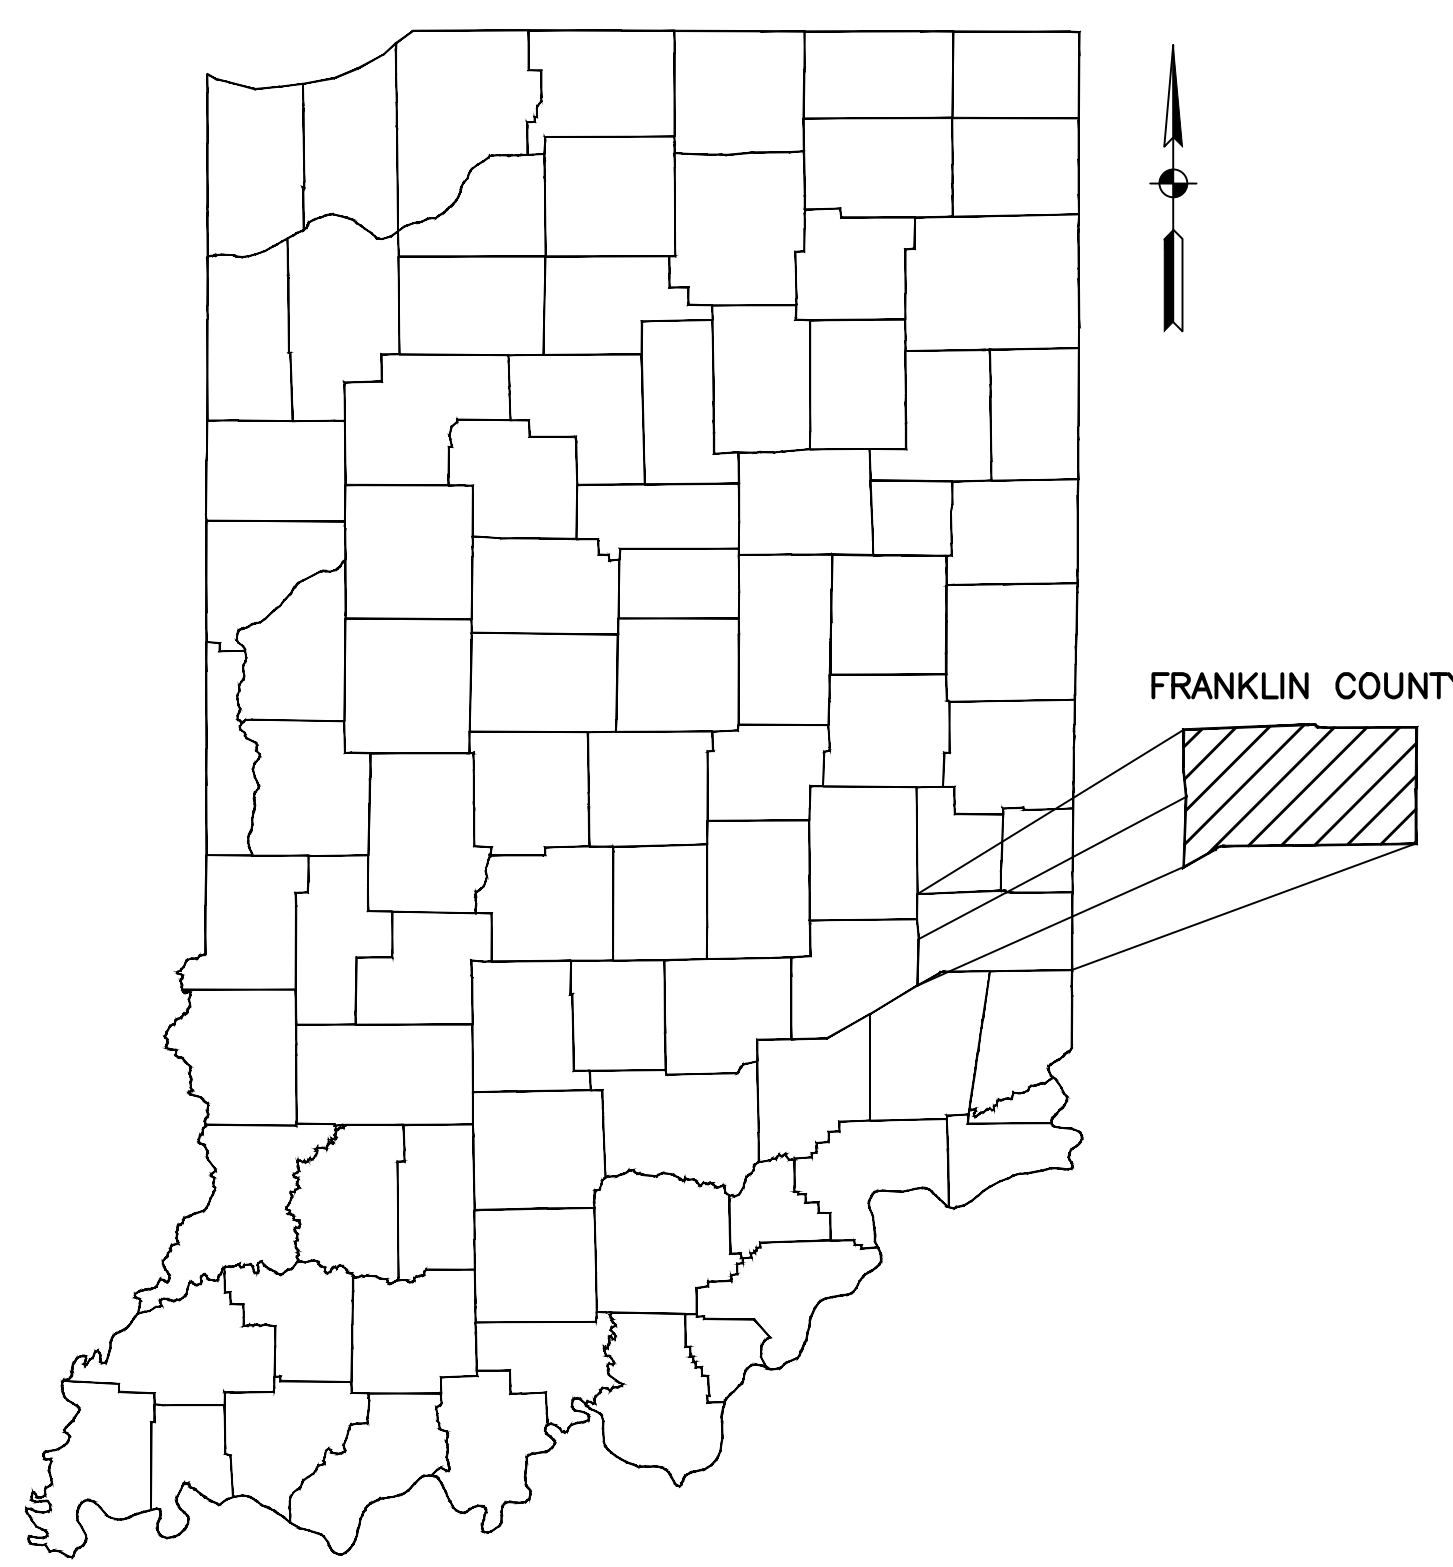

HOOSIER HILLS REGIONAL WATER DISTRICT BOARD OF DIRECTORS
GREGORY DOLE – PRESIDENT
RANDY SCUDDER – VICE PRESIDENT
CHARLES HYNES – SECRETARY
ANDREW WEISENBACH – TREASURER
JOHN AMBERGER – ASST. TREASURER
TED MEER – BOARD MEMBER
ROY B. MEYER – BOARD MEMBER
RUSSELL MORTARA – BOARD MEMBER
ANTHONY CLARK – BOARD MEMBER
SCOTT STIRN – GENERAL MANAGER

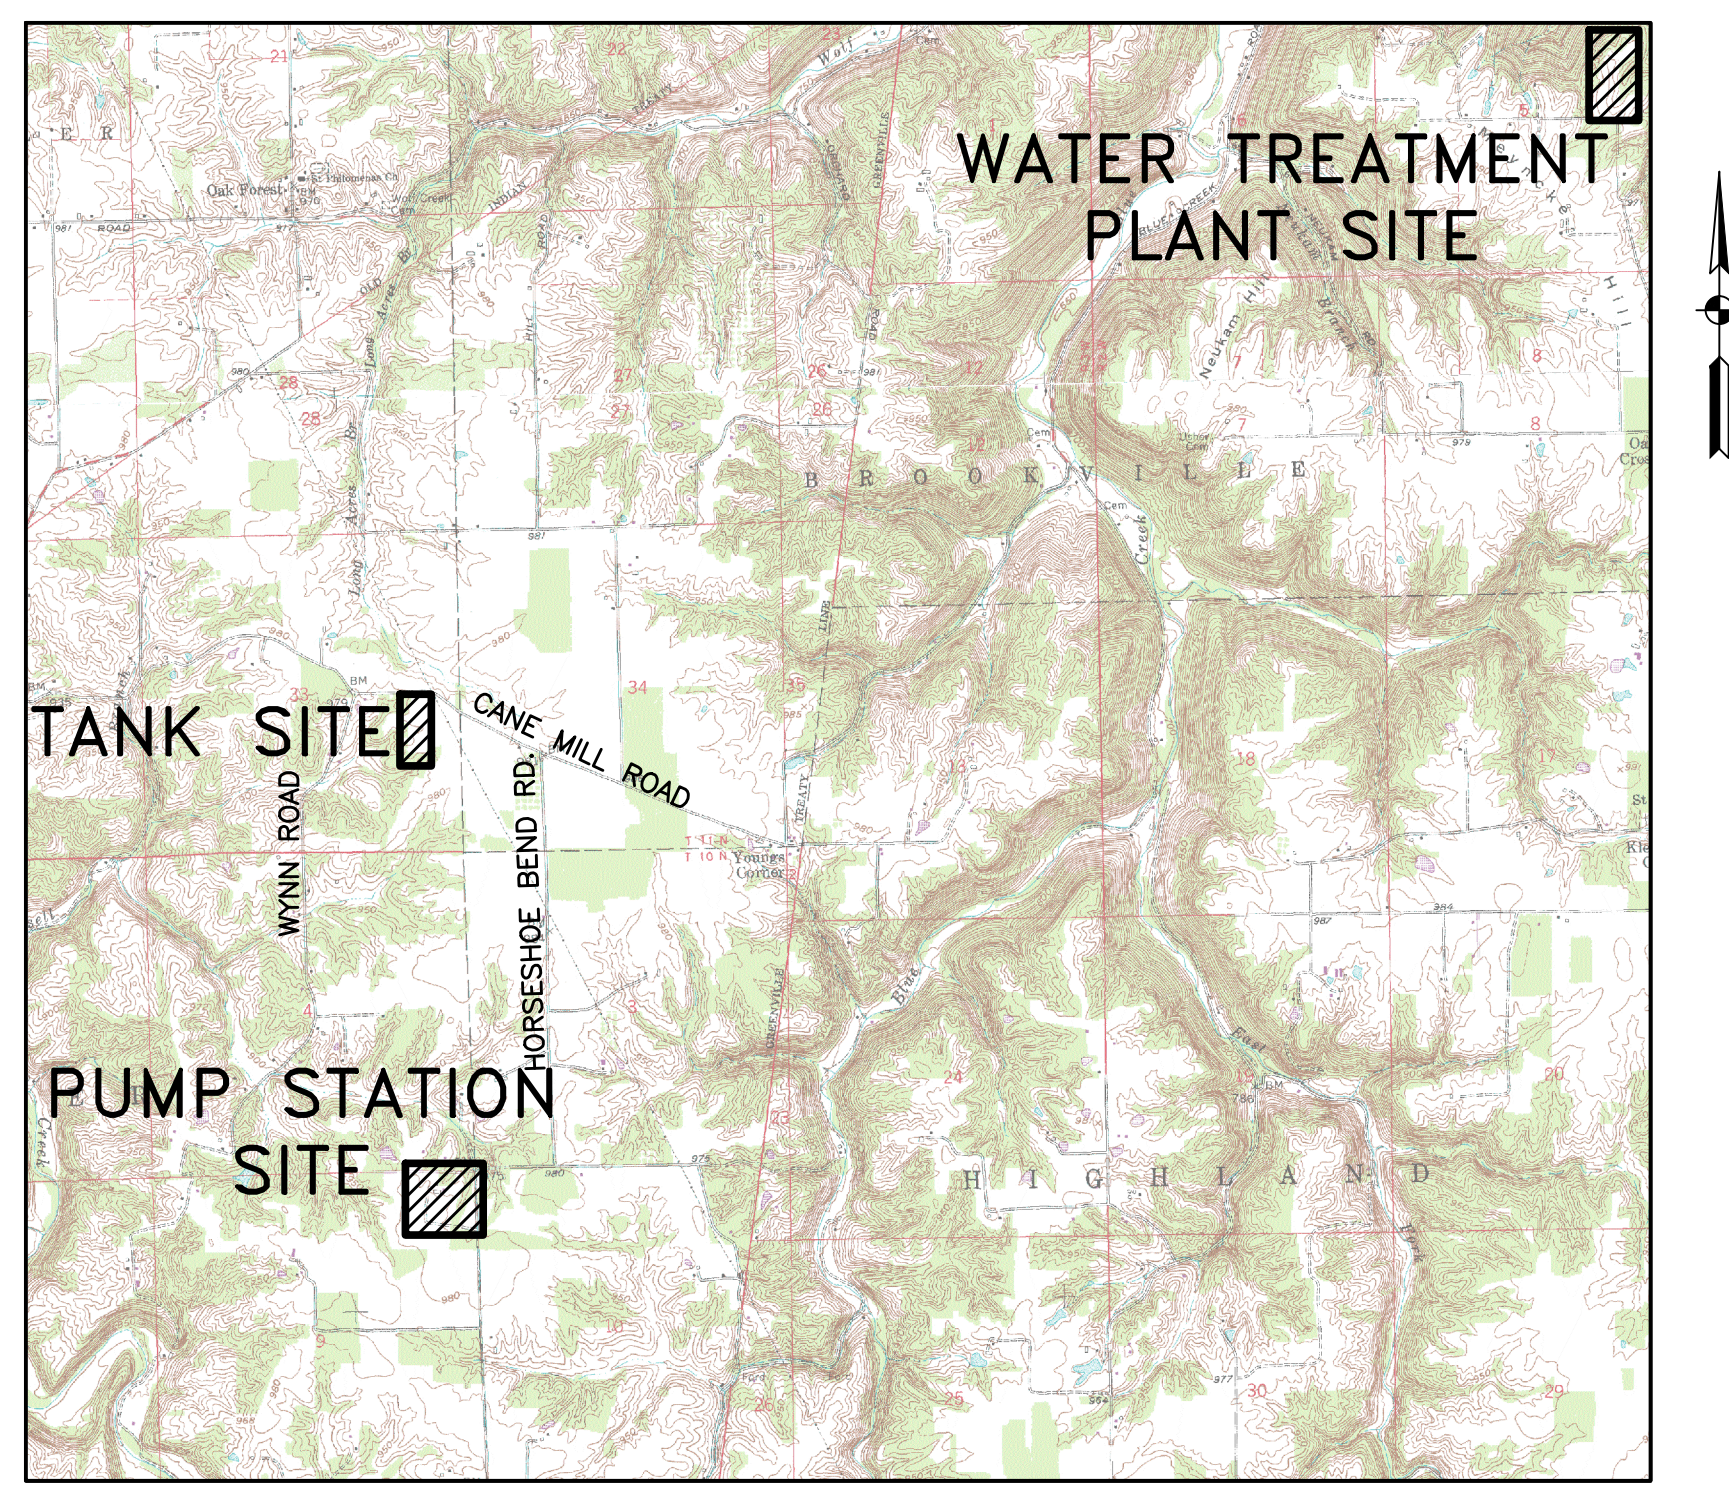

This document, originally issued, sealed, and signed by Alex L. White, Indiana Professional Engineer, No. 11100292, on March 26, 2012, shall not be used in lieu of a certified document.

THIS RECORD DOCUMENT HAS BEEN PREPARED BASED ON INFORMATION PROVIDED BY THE CONSTRUCTION CONTRACTOR. GRW ENGINEERS, INC. HAS ATTEMPTED TO VERIFY THE ACCURACY AND/OR COMPLETENESS OF THIS INFORMATION BUT SHALL NOT BE RESPONSIBLE FOR ANY ERRORS OR OMISSIONS WHICH MAY BE INCORPORATED HEREIN AS A RESULT.

GRW
engineering | architecture | geospatial
ENGINEER/ARCHITECT: ALEX L. WHITE
CONSTRUCTION COMPANY: ENGINEERED FLUID, INC.
DATE: FEBRUARY 2014

ALEX L. WHITE, P.E.
INDIANA REG. NO. 11100292

DATE: 3-26-2012

MARCH 2012

RECORD DRAWINGS
GRW PROJECT NO. 3235-04

FILE NAME: I:\3235 - HHRWD - Division G\Draw Design\G-3\Land\Draw\3235-G3-G-00.dwg