



NOTE:
1. FOR GATE SIZES, SEE SITE PLAN.
2. GATES SHALL BE FURNISHED WITH HASP, PADLOCK AND ADDITIONAL RELATED HARDWARE.

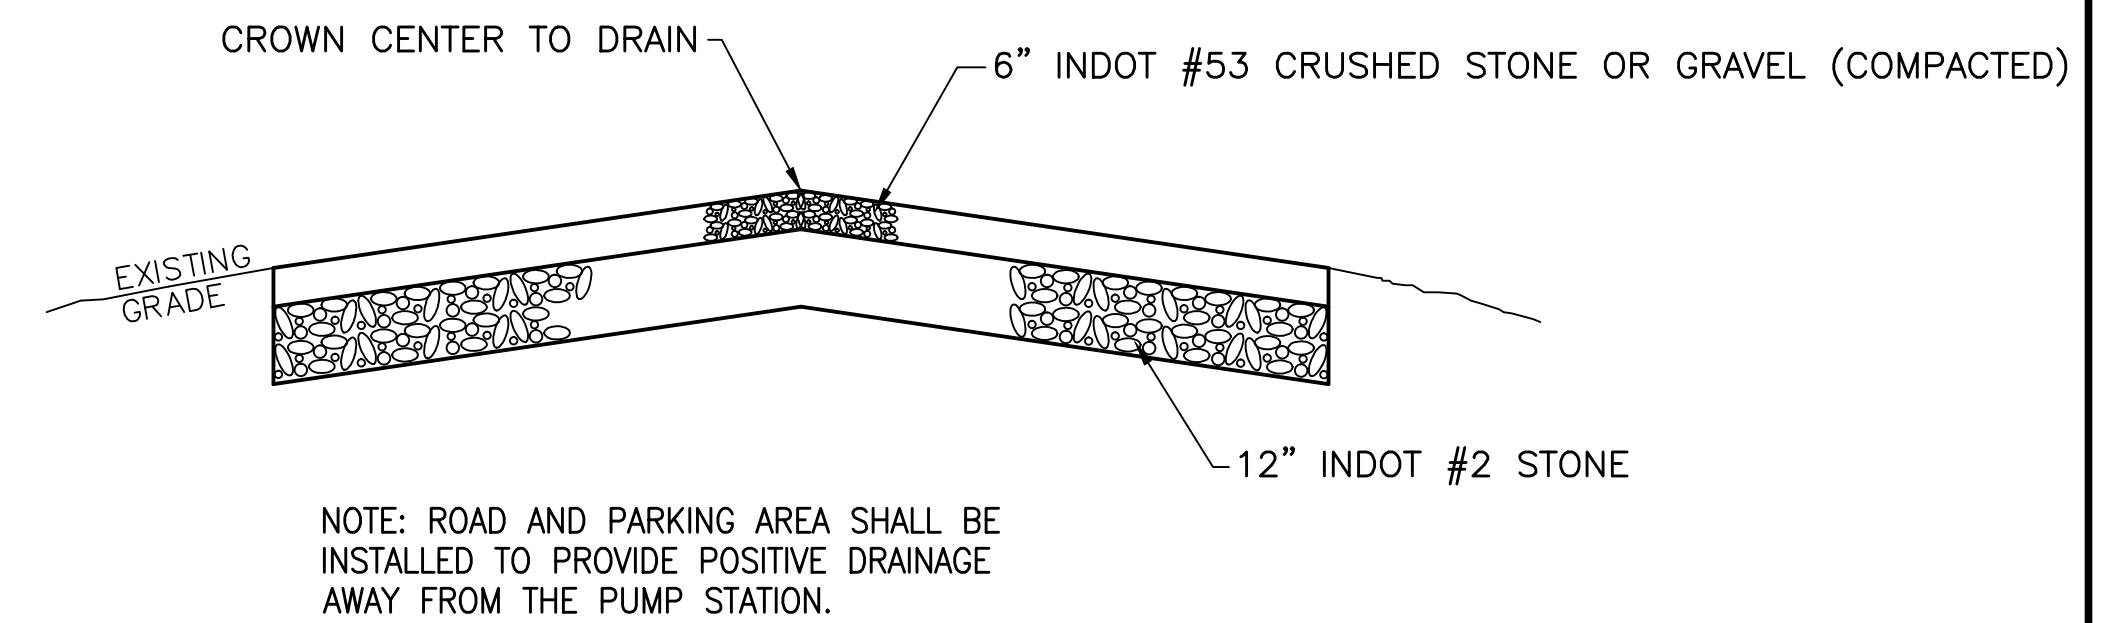

CHAIN LINK SECURITY FENCE & GATE - DETAIL
SCALE: N.T.S.

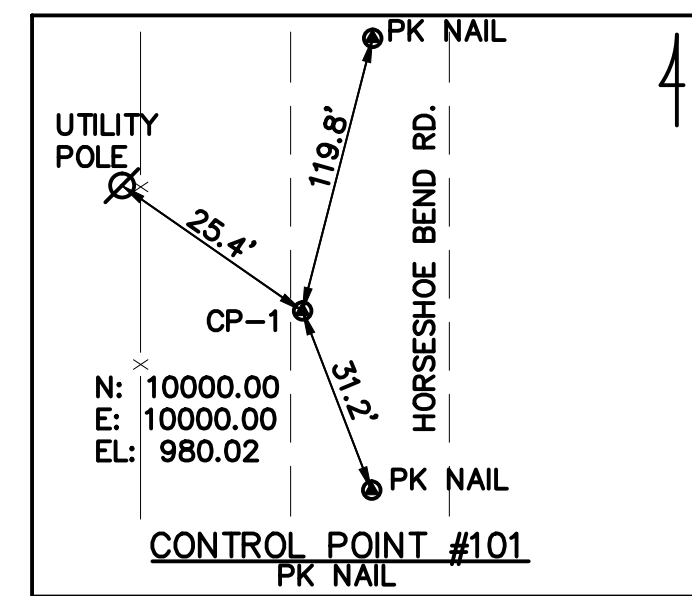

ACCESS DRIVE & PARKING AREA - DETAIL
SCALE: N.T.S.



LOCATION COORDINATES				
DESCRIPTION	NORTHING (N)	EASTING (E)	ELEVATION	LOCATION
CP-1	10000.00	10000.00	980.02	PK NAIL IN ROAD

HORSESHOE BEND RD PUMP STATION SITE PLAN HOOSIER HILLS REGIONAL WATER DISTRICT DIV. G-3 – P.S. & TELEMTRY IMPROVEMENTS				CLIENT CONTRACT NO. G-3		GRW PROJECT NO. 3235																					
 engineering architecture geospatial www.grwinc.com				DRAWING SCALE CHECK:  THIS MARK SHOULD MEASURE EXACTLY 1" WHEN PLOTTED																							
				ALL RIGHTS RESERVED: THIS DOCUMENT IS THE PROPERTY OF GRW, INC. AND SHALL NOT BE REPRODUCED IN WHOLE OR IN PART OR USED FOR CONSTRUCTION OF OTHER THAN THIS SPECIFIC PROJECT WITHOUT WRITTEN PERMISSION OF GRW, INC.																							
<div>1 AS-BUILTS</div> <table><thead><tr><th>NO.</th><th>DESCRIPTION</th><th>DATE</th><th>BY</th></tr></thead><tbody><tr><td colspan="4">REVISIONS</td></tr></tbody></table>				NO.	DESCRIPTION	DATE	BY	REVISIONS				<div>This document, originally issued, sealed, and signed by Alex L. White, Indiana Professional Engineer, No. 11100292, on March 26, 2012, shall not be used in lieu of a certified document.</div> <table><tbody><tr><td>DESIGNED:</td><td>ALW</td><td>DATE:</td><td>MARCH 2012</td></tr><tr><td>DRAWN:</td><td>GCR</td><td>SCALE:</td><td>AS SHOWN</td></tr><tr><td>REVIEWED:</td><td>DRC</td><td>SHEET NO.</td><td rowspan="2">C-01</td></tr><tr><td>APPROVED:</td><td>ALW</td></tr></tbody></table>		DESIGNED:	ALW	DATE:	MARCH 2012	DRAWN:	GCR	SCALE:	AS SHOWN	REVIEWED:	DRC	SHEET NO.	C-01	APPROVED:	ALW
				NO.	DESCRIPTION	DATE	BY																				
				REVISIONS																							
				DESIGNED:	ALW	DATE:	MARCH 2012																				
				DRAWN:	GCR	SCALE:	AS SHOWN																				
REVIEWED:	DRC	SHEET NO.	C-01																								
APPROVED:	ALW																										