
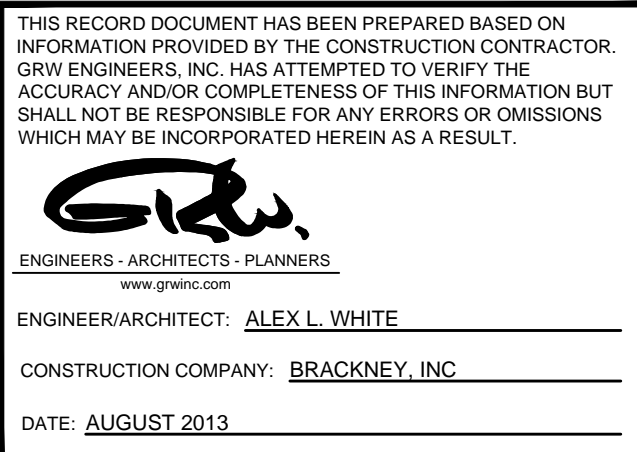


HOOSIER HILLS REGIONAL WATER DISTRICT DIVISION "G" WATERWORKS SYSTEM IMPROVEMENTS

CONTRACT G-4 - WATER MAIN IMPROVEMENTS

RECORD DRAWINGS

HOOSIER HILLS REGIONAL WATER DISTRICT BOARD OF DIRECTORS
GREGORY DOLE – PRESIDENT
RANDY SCUDDER – VICE PRESIDENT
CHARLES HYNES – SECRETARY
ANDREW WEISENBACH – TREASURER
JOHN AMBERGER – ASST. TREASURER
TED MEER – BOARD MEMBER
ROY B. MEYER – BOARD MEMBER
RUSSELL MORTARA – BOARD MEMBER
ANTHONY CLARK – BOARD MEMBER
SCOTT STIRN – GENERAL MANAGER

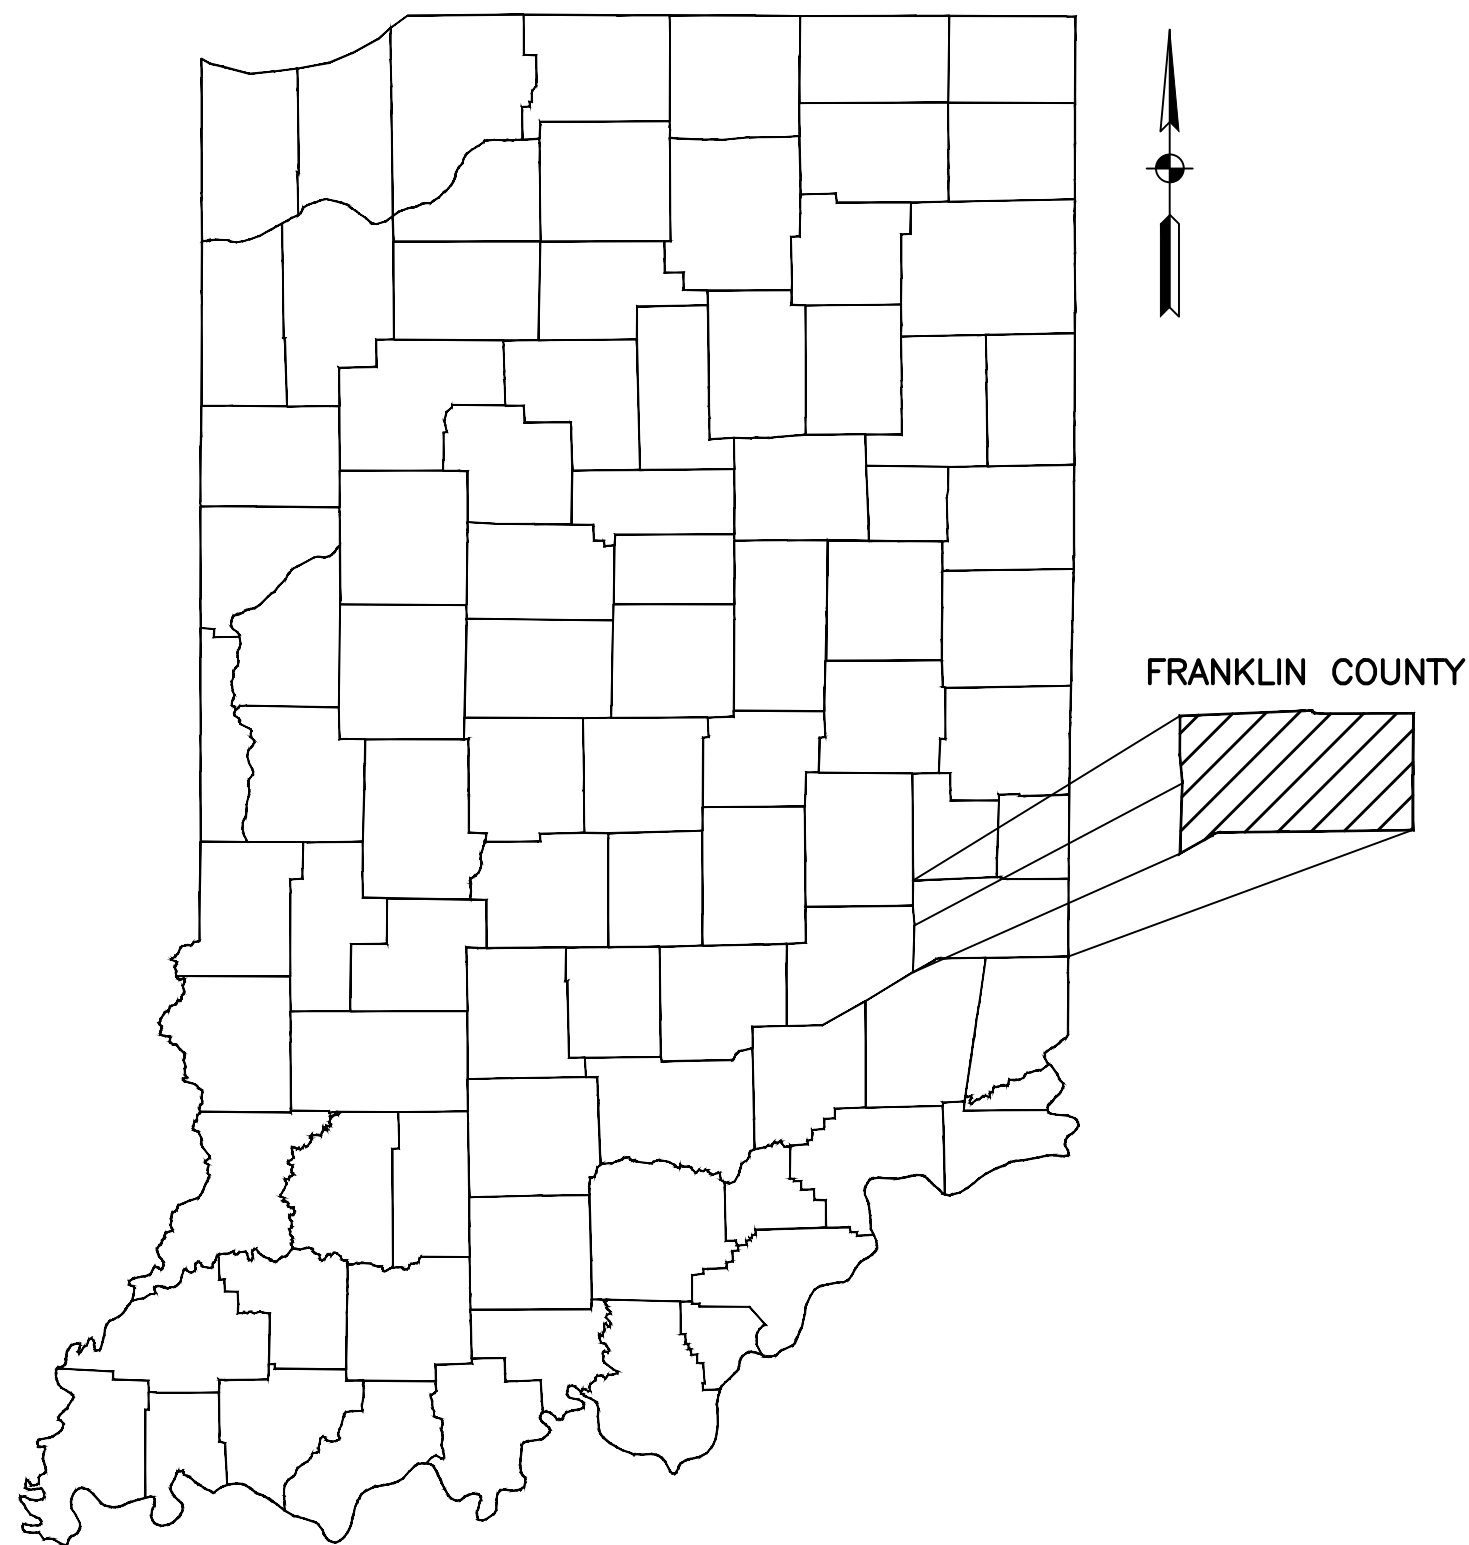


This document, originally issued, sealed, and signed by Alex L. White, Indiana Professional Engineer, No. 11100292, on March 26, 2012, shall not be used in lieu of a certified document.

ALEX L. WHITE, P.E.
INDIANA REG. NO. 11100292

DATE: 3-26-2012

MARCH 2012

SITE LOCATION MAP

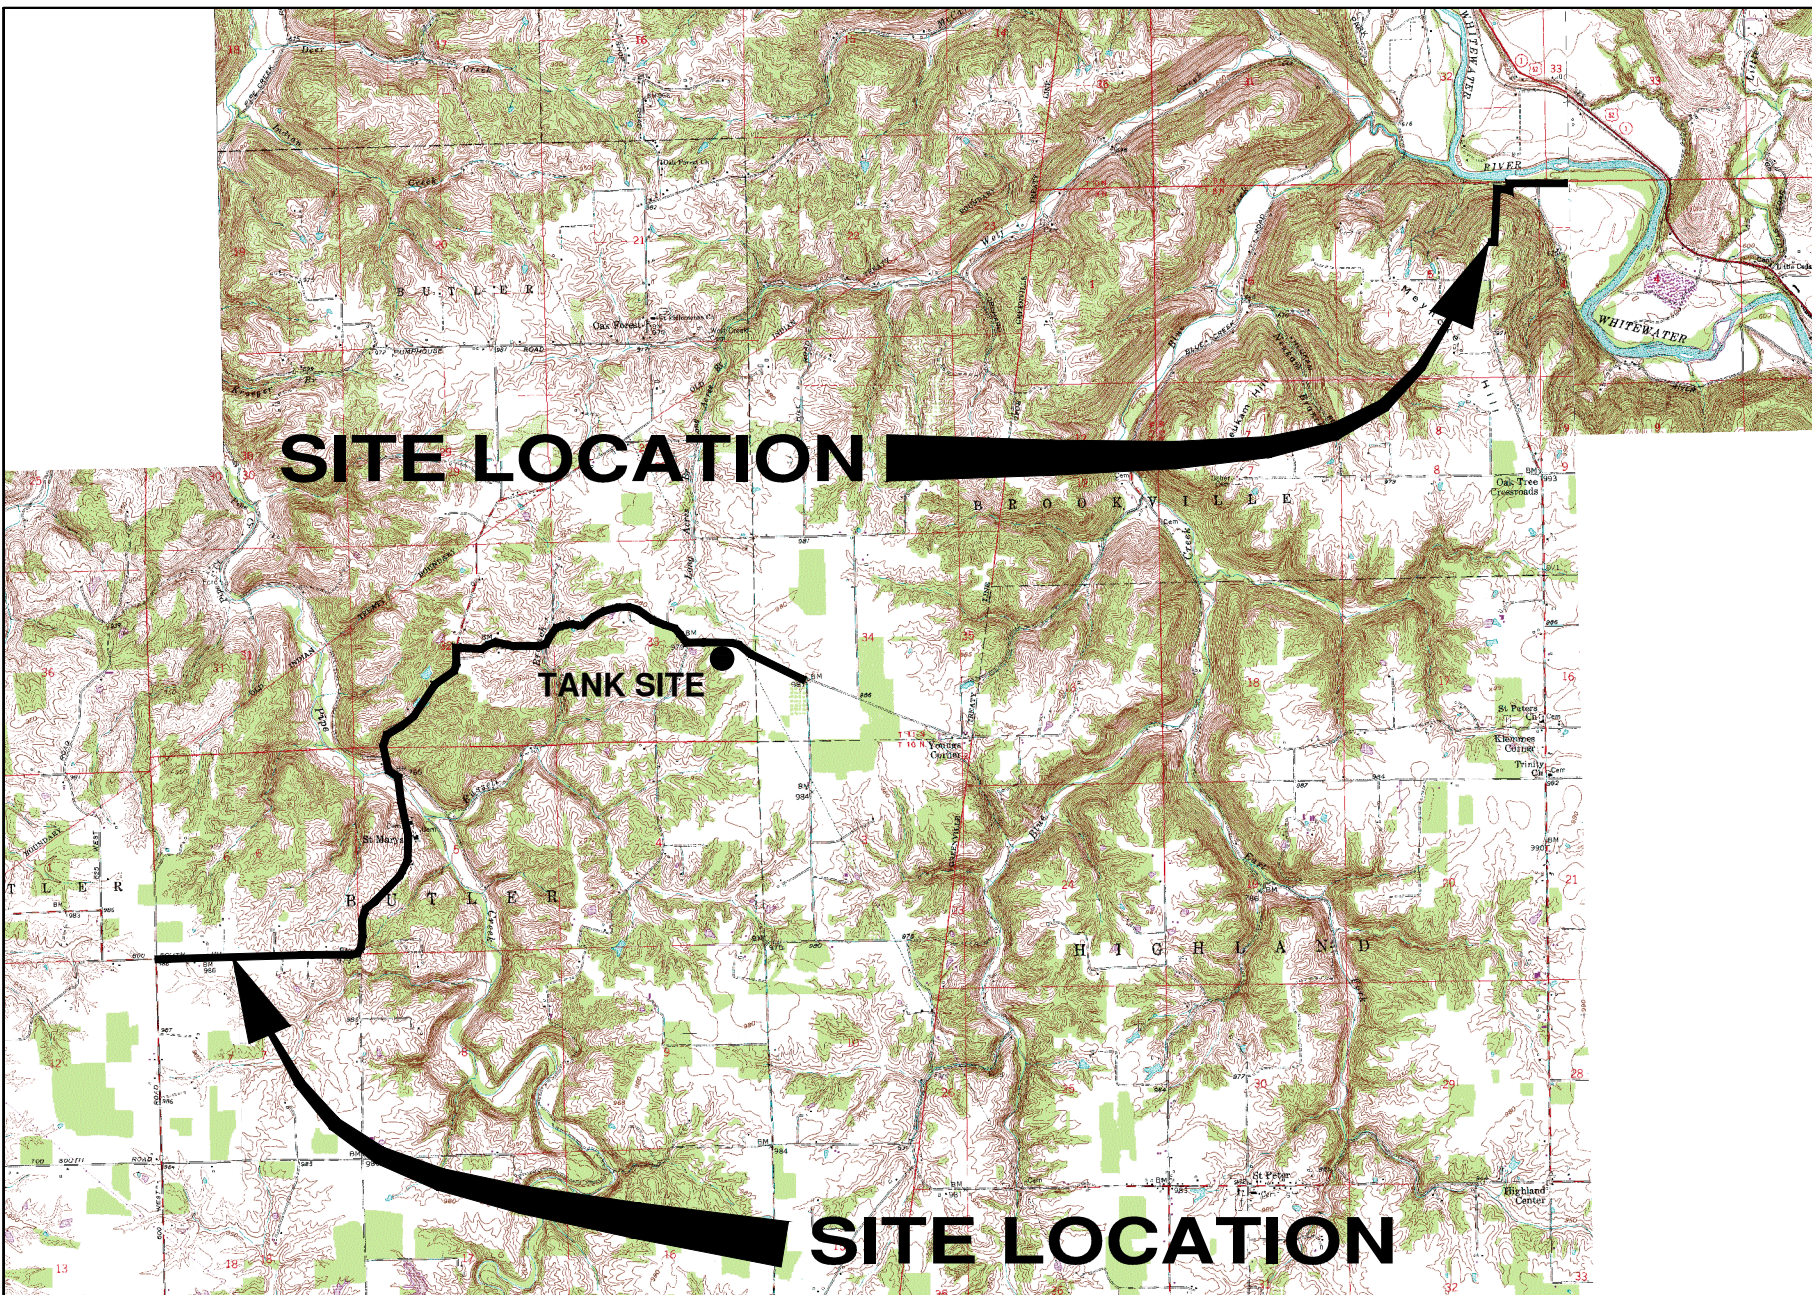

INDEX OF DRAWINGS	
NO.	DRAWING TITLE
GENERAL	
G-00	COVER SHEET
G-01	INDEX OF DRAWINGS AND GENERAL NOTES
G-02	SURVEY CONTROL
CIVIL	
714	SAINT MARY'S ROAD (ALTERNATE BID 1)
715	SAINT MARY'S ROAD (ALTERNATE BID 1)
716	SAINT MARY'S ROAD (ALTERNATE BID 1)
717	SAINT MARY'S ROAD (ALTERNATE BID 1)
718	SAINT MARY'S ROAD AND CANE MILL ROAD (ALTERNATE BID 1)
719	CANE MILL ROAD (ALTERNATE BID 1)
720	CANE MILL ROAD (ALTERNATE BID 1)
721	CANE MILL ROAD (BASE BID & ALTERNATE BID 1)
722	HIGHLAND CENTER ROAD (BASE BID)
723	WATER TREATMENT PLANT CONNECTION (BASE BID)
WD-1	WATER LINE STANDARD DETAILS
EC-1	EROSION CONTROL STANDARD DETAILS

GRW PROJECT NO. 3235-04