


PRINTED: 2/26/2014 @ 1:23PM

FILE NAME: I:\3235 - HHRWD - Division G\Draw Design\G-4\3235\_G4\_SHT\_718.dwg



ADDITIVE BID ALTERNATE 2

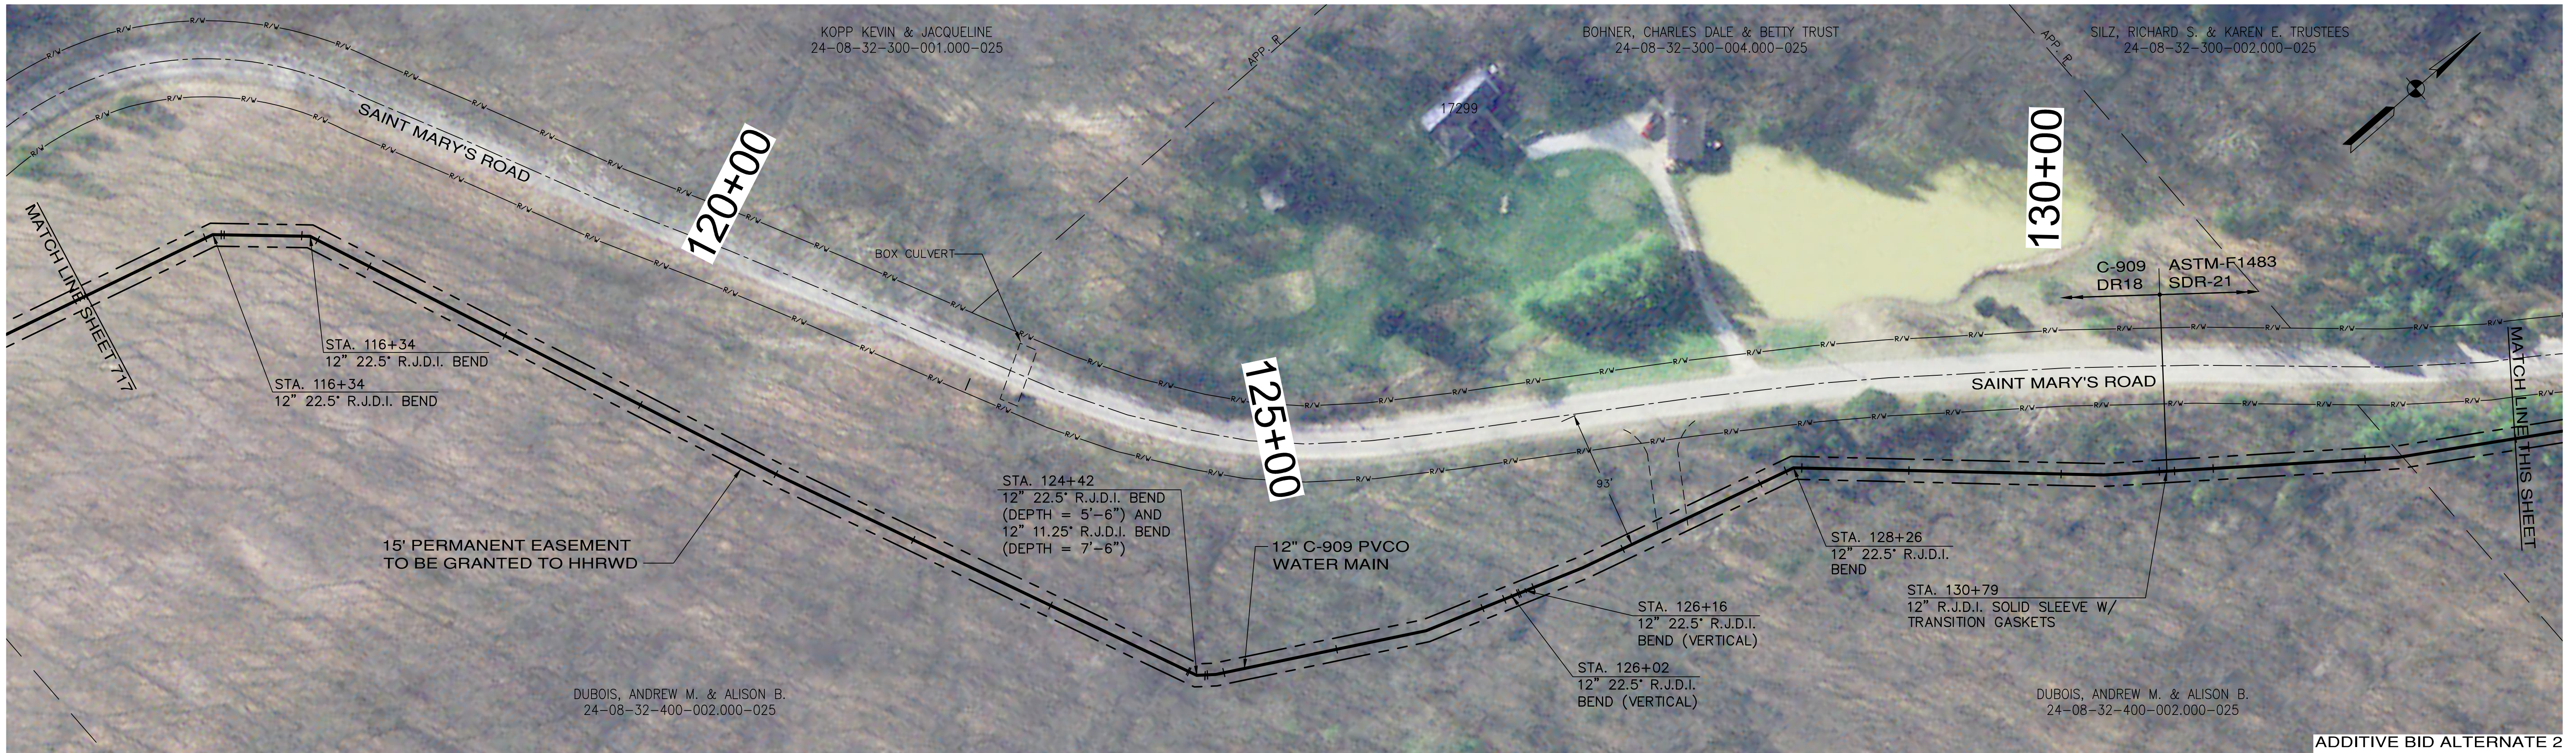

ADDITIVE BID ALTERNATE 2

NOTES: 1.) THE UTILITIES AND THEIR LOCATION SHOWN ON PLANS ARE APPROXIMATE. CONTRACTOR SHALL VERIFY ALL UTILITIES IN THE FIELD AND NOTIFY ALL UTILITY COMPANIES PRIOR TO INSTALLATION OF THE WATER LINE.  
2.) ALL PIPING SHALL BE CLASS 200 UNLESS OTHERWISE NOTED.  
3.) 48" MINIMUM COVER REQUIRED OVER TOP OF WATER LINE UNLESS OTHERWISE NOTED.

THIS RECORD DOCUMENT HAS BEEN PREPARED BASED ON INFORMATION PROVIDED BY THE CONSTRUCTION CONTRACTOR. GRW ENGINEERS, INC. HAS ATTEMPTED TO VERIFY THE ACCURACY AND/OR COMPLETENESS OF THIS INFORMATION BUT SHALL NOT BE RESPONSIBLE FOR ANY ERRORS OR OMISSIONS WHICH MAY BE INCORPORATED HEREIN AS A RESULT.

**GRW**  
ENGINEERS - ARCHITECTS - PLANNERS  
www.grwinc.com

ENGINEER/ARCHITECT: ALEX L. WHITE  
CONSTRUCTION COMPANY: BRACKNEY, INC.  
DATE: AUGUST 2013

<b>SAINT MARY'S ROAD &amp; CANE MILL ROAD CONTRACT G-4 WATER MAIN IMPROVEMENTS HOOSIER HILLS REGIONAL WATER DISTRICT DIVISION "G" SYSTEM IMPROVEMENTS</b>			CLIENT CONTRACT NO. G-4		GRW PROJECT NO. 3235-04	
DRAWING SCALE CHECK:			THIS MARK SHOULD MEASURE EXACTLY 1" WHEN PLOTTED			
ALL RIGHTS RESERVED: THIS DOCUMENT IS THE PROPERTY OF GRW ENGINEERS, INC. AND SHALL NOT BE REPRODUCED IN WHOLE OR IN PART OR USED FOR CONSTRUCTION OF OTHER THAN THIS SPECIFIC PROJECT WITHOUT WRITTEN PERMISSION OF GRW ENGINEERS, INC.			DESIGNED: CJF		DATE: AUGUST 2013	
1. AS-BUILTS			08-13		JEC	
NO. DESCRIPTION			DATE		BY	
REVISIONS						
 <b>GRW Engineers, Inc.</b> Engineers, Architects, Planners LEXINGTON LOUISVILLE NASHVILLE INDIANAPOLIS FORT MITCHELL KNOXVILLE ARLINGTON			This document, originally issued, sealed, and signed by Alex L. White, Indiana Professional Engineer, No. 11100292, on March 26, 2012, shall not be used in lieu of a certified document.		DRAWN: GCR REVIEWED: DRC APPROVED: ALW	
					SHEET NO. <b>718</b>	