



ROAD DRAIN TOP SLAB INLET PROTECTION
BY WIMCO, LLC OR APPROVED EQUAL

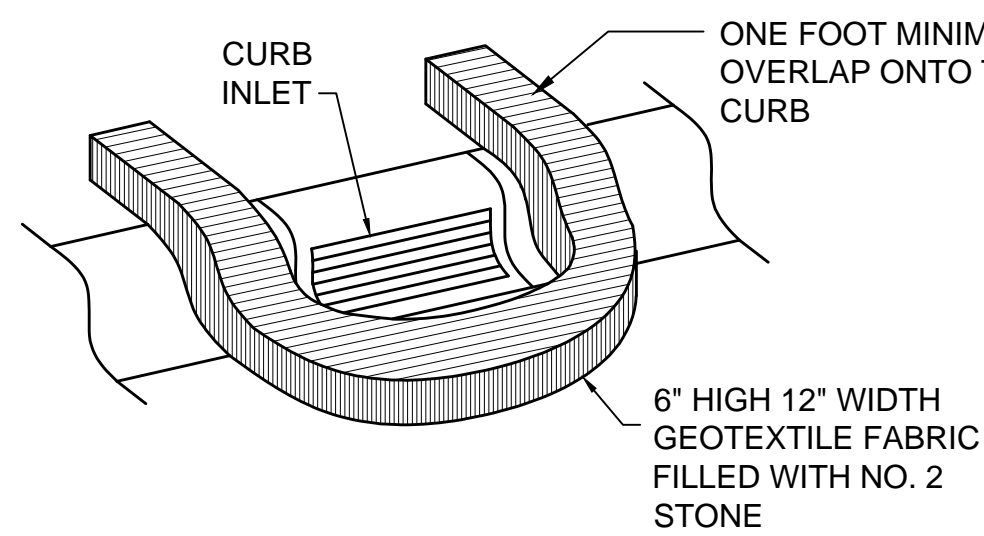


CURB INLET PROTECTION

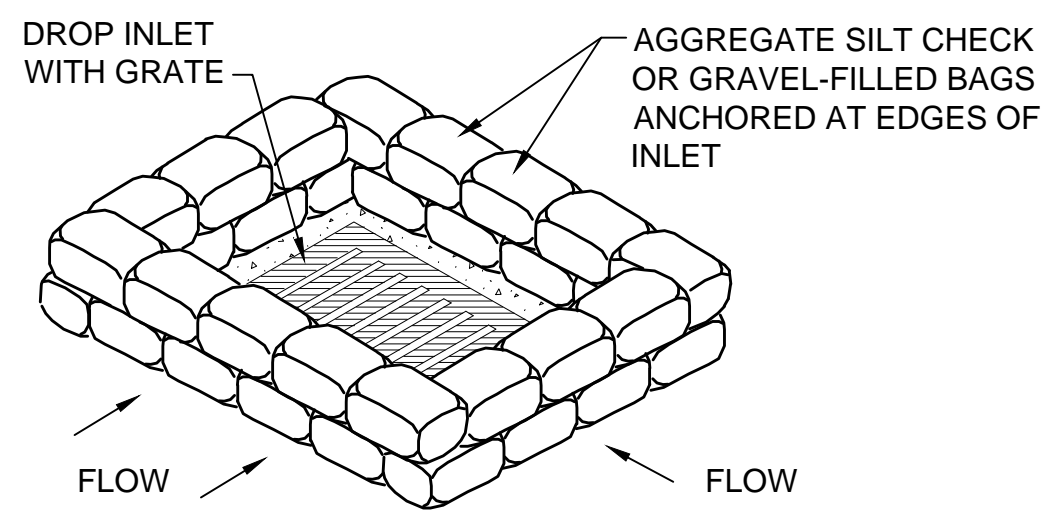

DROP INLET SEDIMENT FILTER

INLET PROTECTION DETAILS


NOT TO SCALE

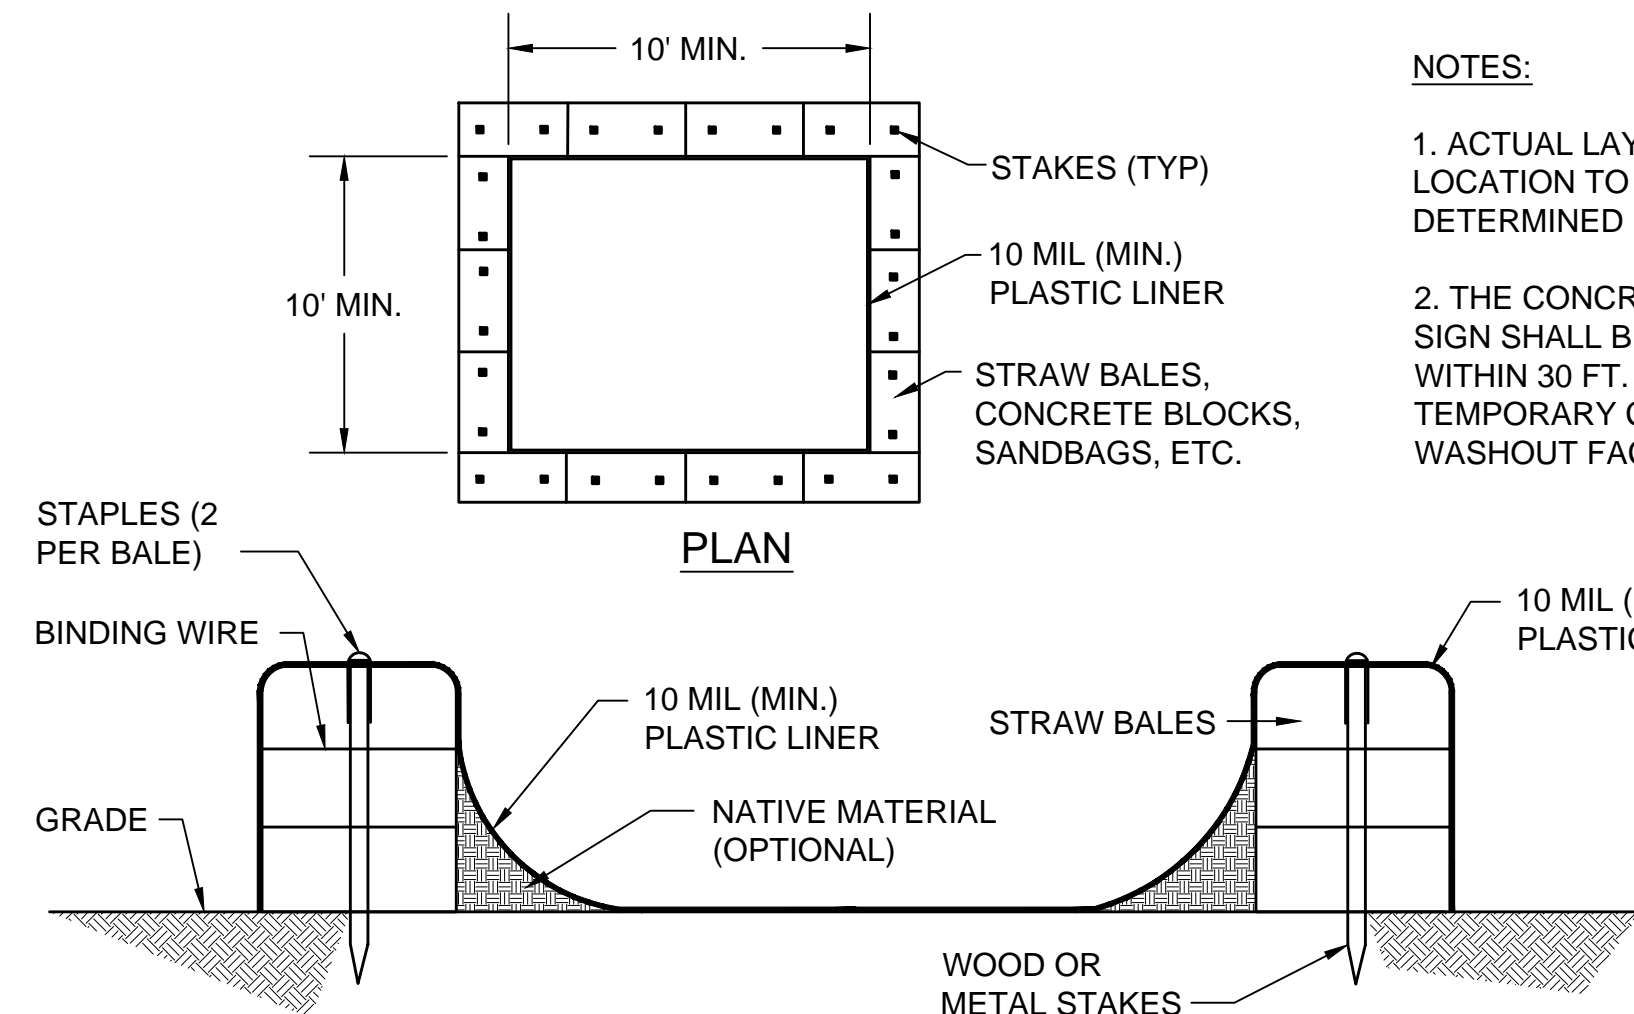


SECTION

CONCRETE WASHOUT DETAILS

NOT TO SCALE

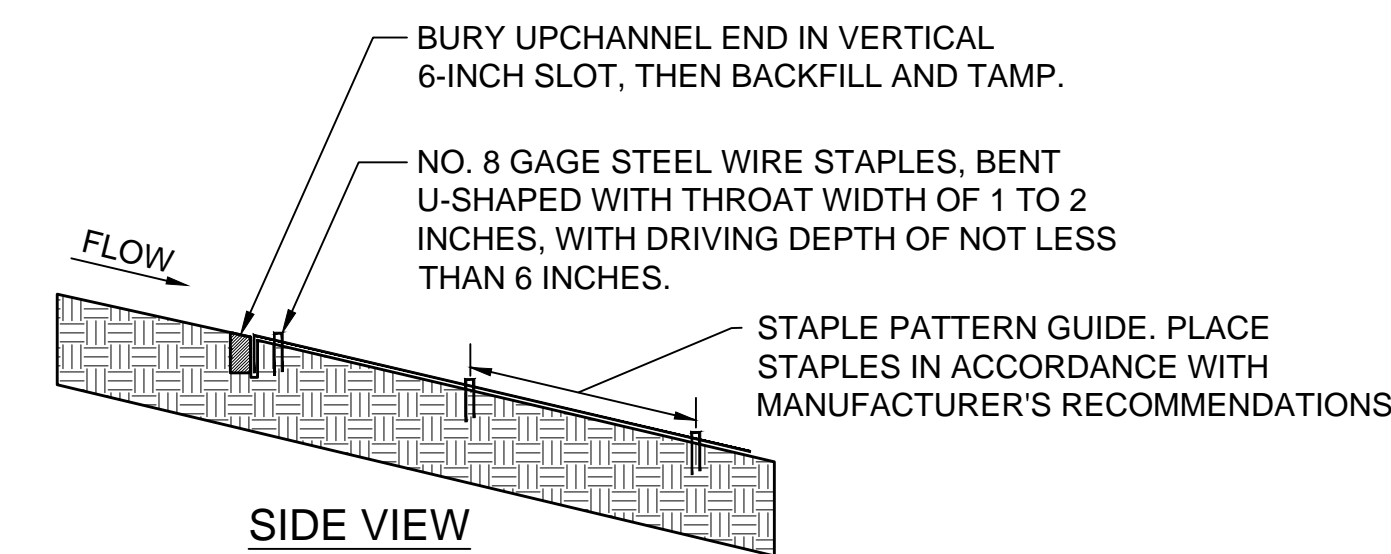

SIDE VIEW


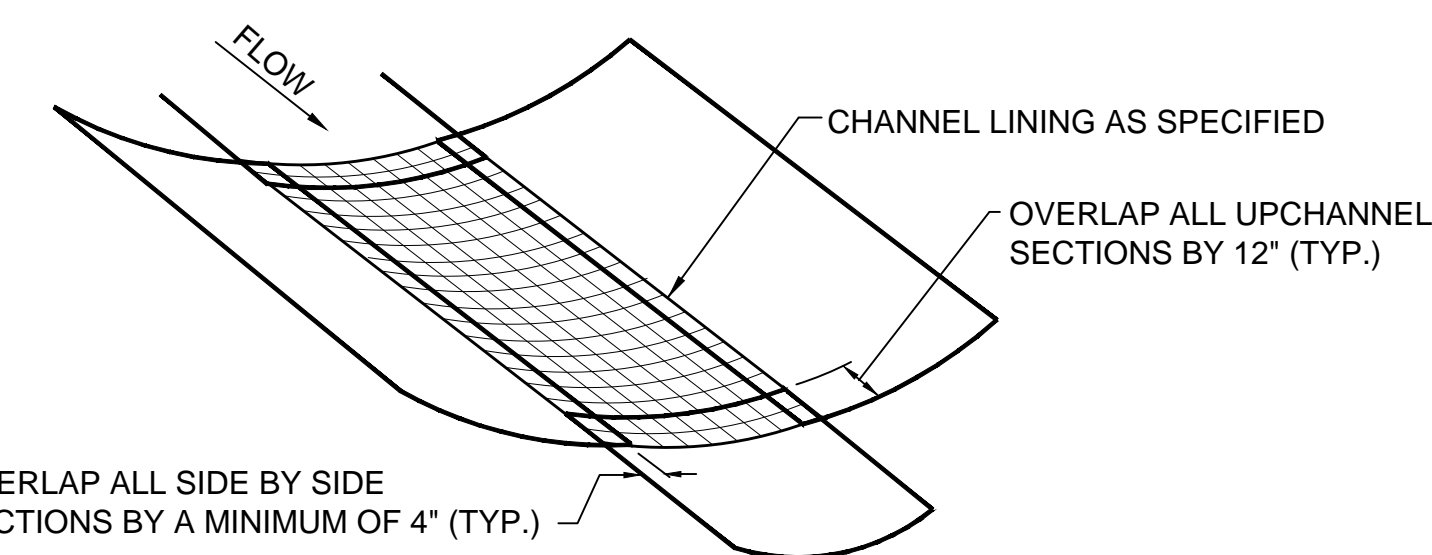


FRONT VIEW

SEEDING TO BE APPLIED PRIOR TO THE INSTALLATION OF BLANKET. CONTRACTOR TO ENSURE THAT A STABLE AND UNIFORM GRASS COVER DEVELOPS IN THE SWALE.


EROSION CONTROL BLANKET INSTALLATION DETAIL

NOT TO SCALE

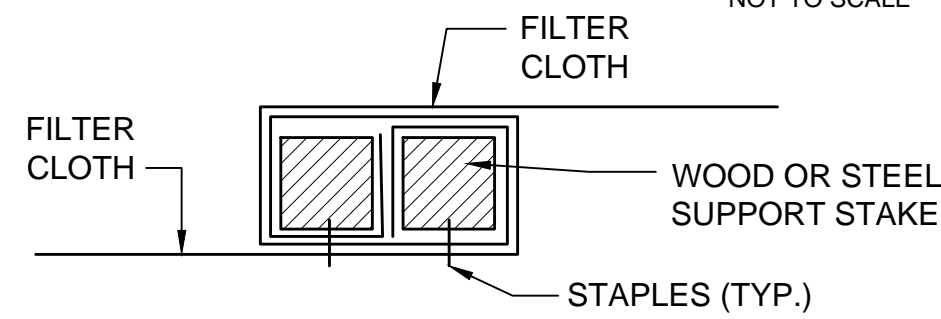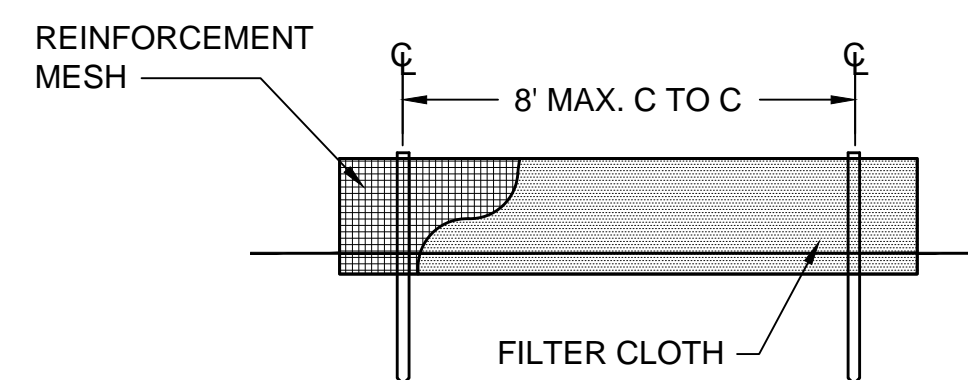

NOTE: FILTER CLOTH TO BE SPUN AROUND STAKES AND STAPLED AS SHOWN AT ALL FENCE OR MATERIAL SPLICES

JOINING FENCE SECTIONS

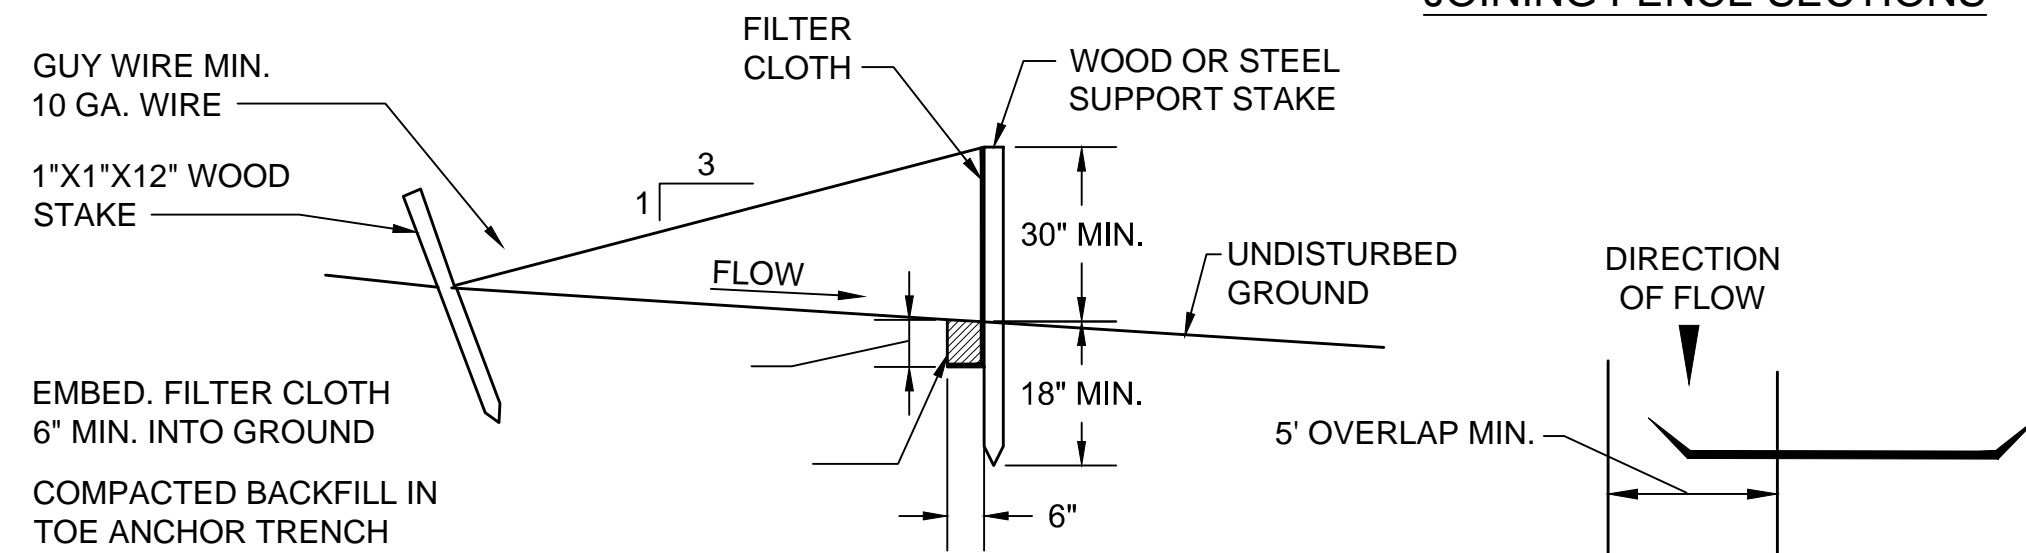

NOTE: MAXIMUM FENCE HEIGHT = 36". MESH CAN BE EITHER INDUSTRIAL POLYPROPYLENE OR STEEL MESH WITH MAXIMUM 6" OPENING. USE MINIMUM 14 GA. WIRE.


FF-30 FILTER FABRIC FENCE

FILTER FABRIC FENCE DETAILS


NOT TO SCALE

NOTES:


1. ACTUAL LAYOUT AND LOCATION TO BE DETERMINED IN FIELD.
2. THE CONCRETE WASHOUT SIGN SHALL BE INSTALLED WITHIN 30 FT. OF THE TEMPORARY CONCRETE WASHOUT FACILITY.

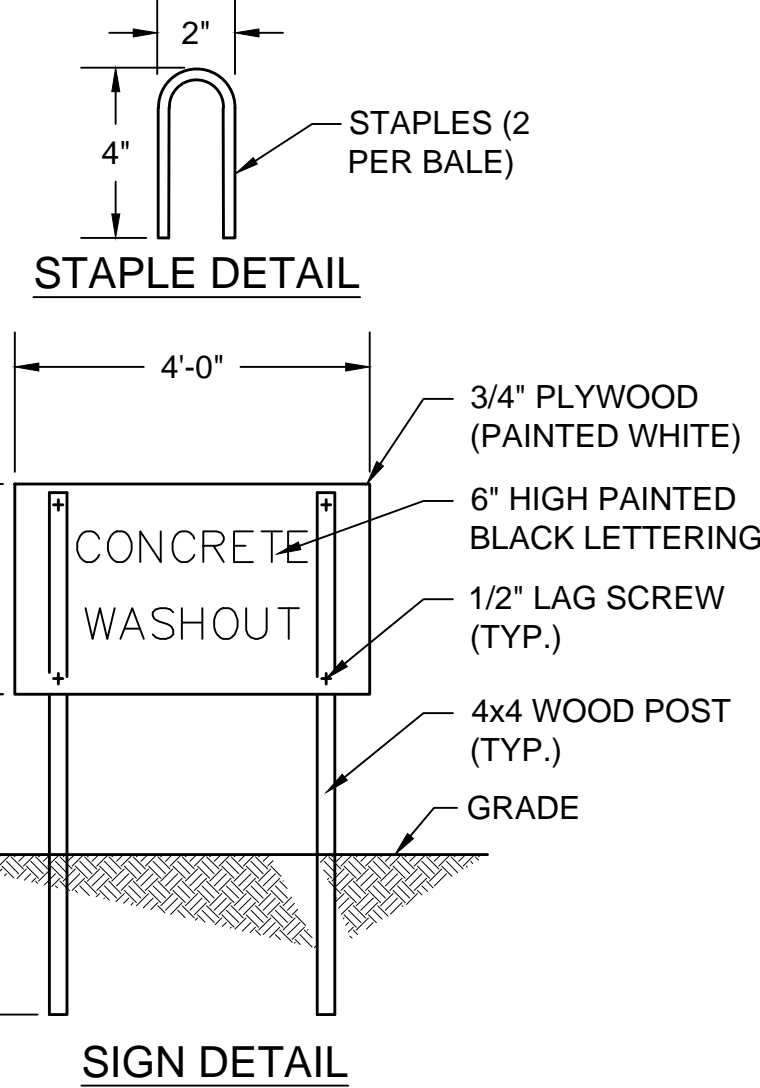

SIGN DETAIL

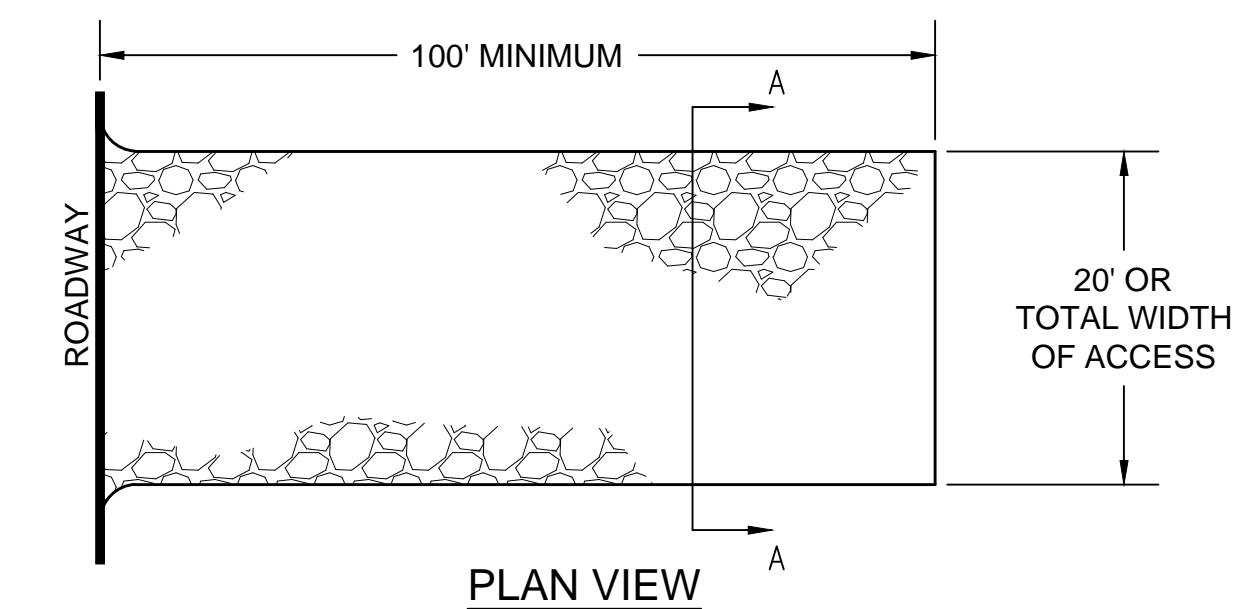

PLAN VIEW

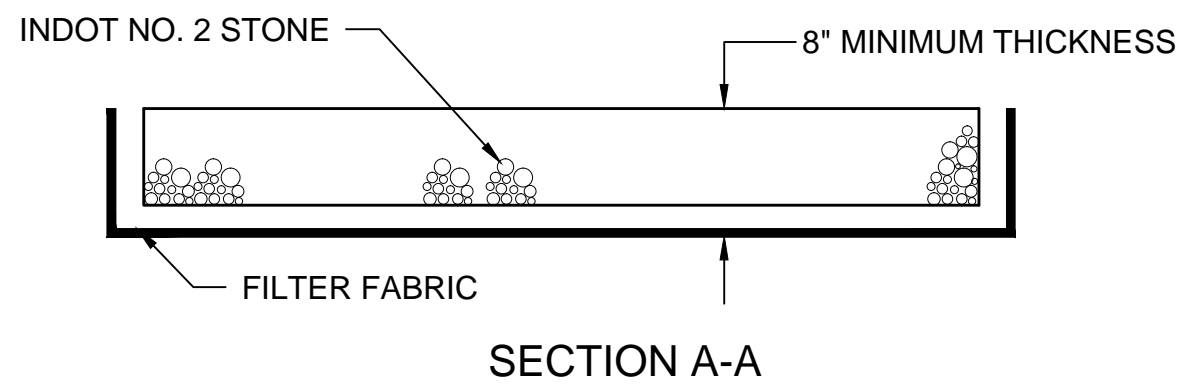

SECTION A-A

MAINTENANCE: THE STABILIZED CONSTRUCTION ENTRANCE SHALL BE INSTALLED WHERE SHOWN ON THE PLAN. THE ENTRANCE SHALL BE INSPECTED WEEKLY AND ADDITIONAL INDOT NO. 2 STONE SHALL BE KEPT ON SITE SO THAT THE MINIMUM DIMENSIONS CAN BE MAINTAINED THROUGHOUT THE PROJECT. SEDIMENT TRACKED ONTO A PUBLIC ROADWAY SHALL BE REMOVED AT THE END OF EACH CONSTRUCTION DAY AND PLACED ON THE TOPSOIL STOCKPILE. NO OTHER ENTRANCE SHALL BE USED TO GAIN ACCESS TO THE SITE BY ANY CONSTRUCTION, PERSONAL OR DELIVERY VEHICLES.

ROCK CONSTRUCTION ENTRANCE

NOT TO SCALE

STABILIZATION PRACTICE	JAN.	FEB.	MAR.	APR.	MAY	JUN.	JUL.	AUG.	SEP.	OCT.	NOV.	DEC.
PERMANENT SEEDING				A			*//////////N////////*					
DORMANT SEEDING	B										B	
TEMPORARY SEEDING			C						D			
SODDING			E**				*//////////N////////*					
MULCHING	F											

A = INDOT SEED MIXTURE TYPE "R" - 170 LBS/ACRE PLUS 2 TONS STRAW MULCH/ACRE.

B = KENTUCKY BLUEGRASS 60 LBS/ACRE; CREEPING RED FESCUE 60 LBS/ACRE; PLUS 2 TONS STRAW MULCH/ACRE, OR ADD ANNUAL RYEGRASS 30 LBS/ACRE.

C = INDOT SEED MIXTURE TYPE "T" SPRING OATS - 150 LBS/ACRE


D = INDOT SEE MIXTURE TYPE "T" WINTER WHEAT - 150 LBS/ACRE

E = SOD

F = STRAW MULCH 2 TONS/ACRE

///I/ IRRIGATION NEEDED DURING JUNE, JULY, AND/OR AUGUST.

** IRRIGATION NEEDED FOR 2 TO 3 WEEKS AFTER APPLYING SOD.

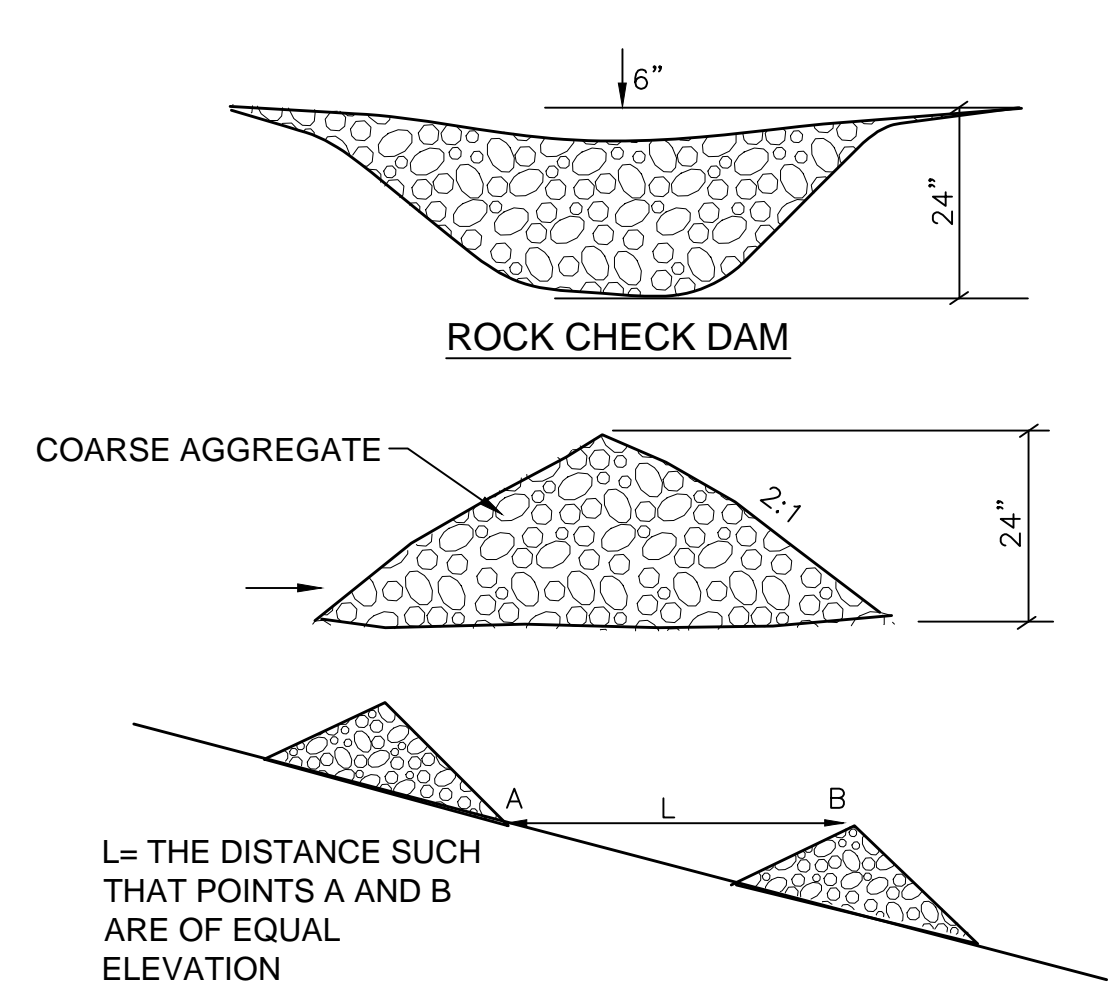


SPACING BETWEEN CHECK DAMS

NOTE: STONE BAGS MAY BE USED FOR TEMPORARY CHECK DAMS. INSTALL IN SAME CONFIGURATION.

CHECK DAM DETAILS

NOT TO SCALE

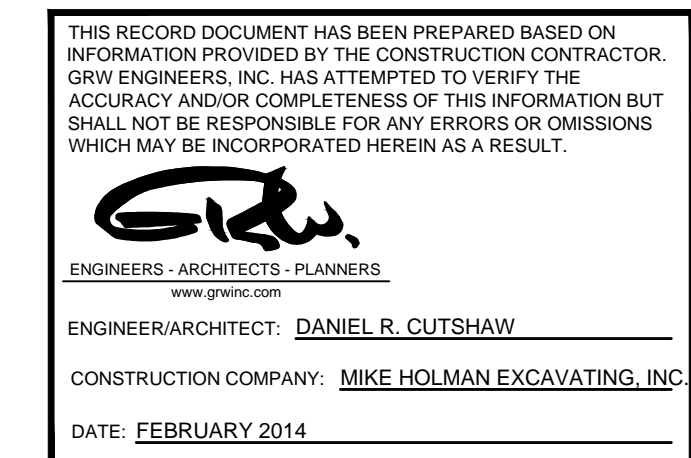

EROSION CONTROL DETAILS

DIVISION G-6 - SPADES RD. BPS WATER MAIN IMPROVEMENTS
HOOSIER HILLS REGIONAL WATER DISTRICT
RIPLEY COUNTY, INDIANA

REVISIONS	DATE	BY	DESCRIPTION
NO.			
1.	4-14	MAA	AS-BUILT REVISED

DESIGNED	CJF
DRAWN	JAJ
REVIEWED	ALW
APPROVED	DRC

DATE: APRIL 2013
SCALE: N.T.S.
SHEET NO. C-02

This document, originally issued, sealed, and signed by Daniel R. Cutshaw, Indiana Professional Engineer, No. 11200431, on April 15, 2013, shall not be used in lieu of a certified document.

GRW PROJECT NO. 3235
CLIENT PROJECT NO. G-6
ALL RIGHTS RESERVED. NO PART OF THIS DOCUMENT MAY BE REPRODUCED IN WHOLE OR IN PART WITHOUT THE WRITTEN PERMISSION OF GRW ENGINEERS, INC.

GRW ENGINEERS - ARCHITECTS - PLANNERS
www.grwinc.com