




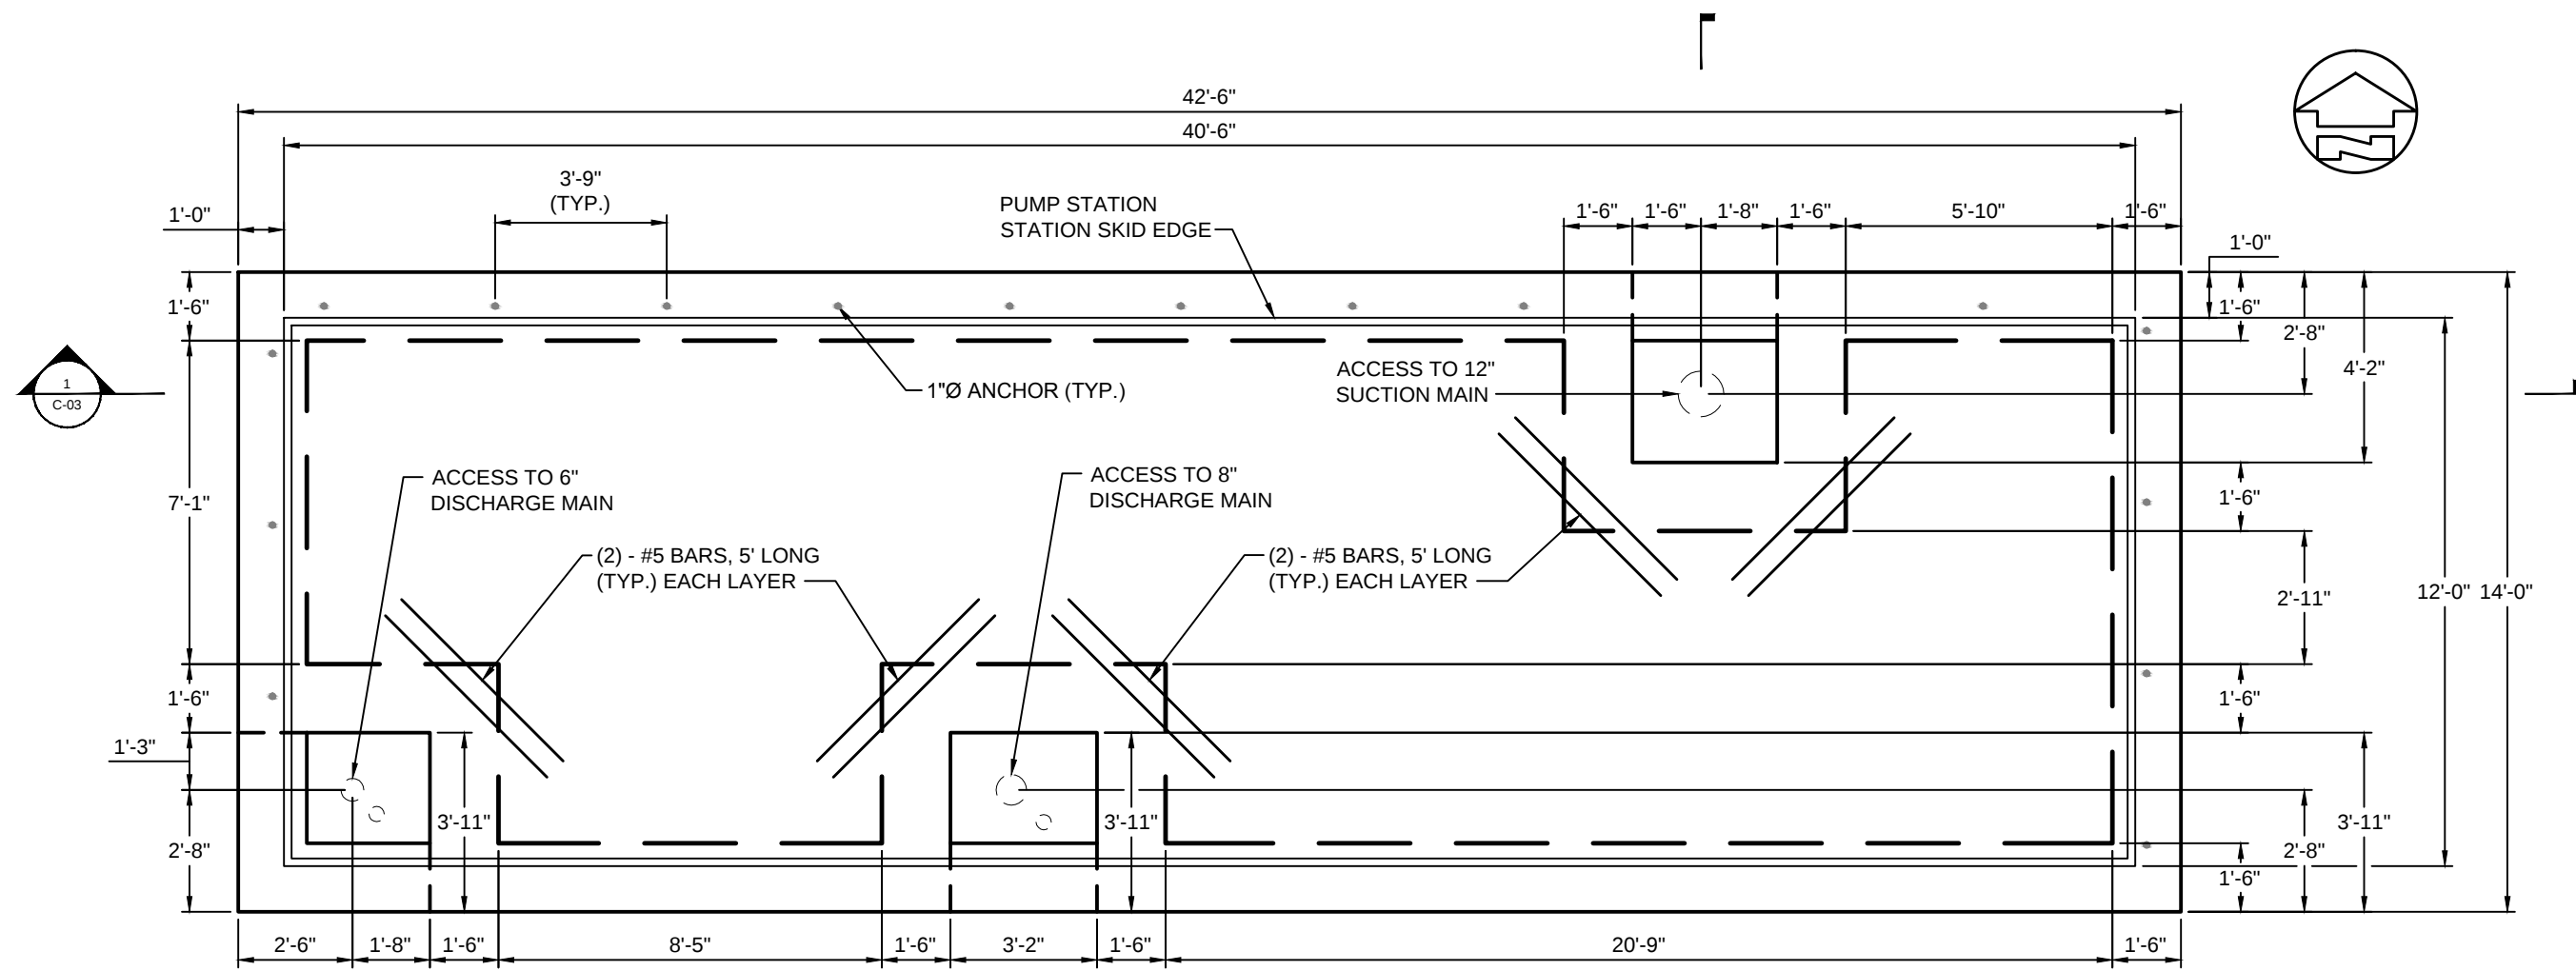


TYPICAL FOUNDATION LAYOUT - DETAIL
SCALE: 1/4"=1'-0"

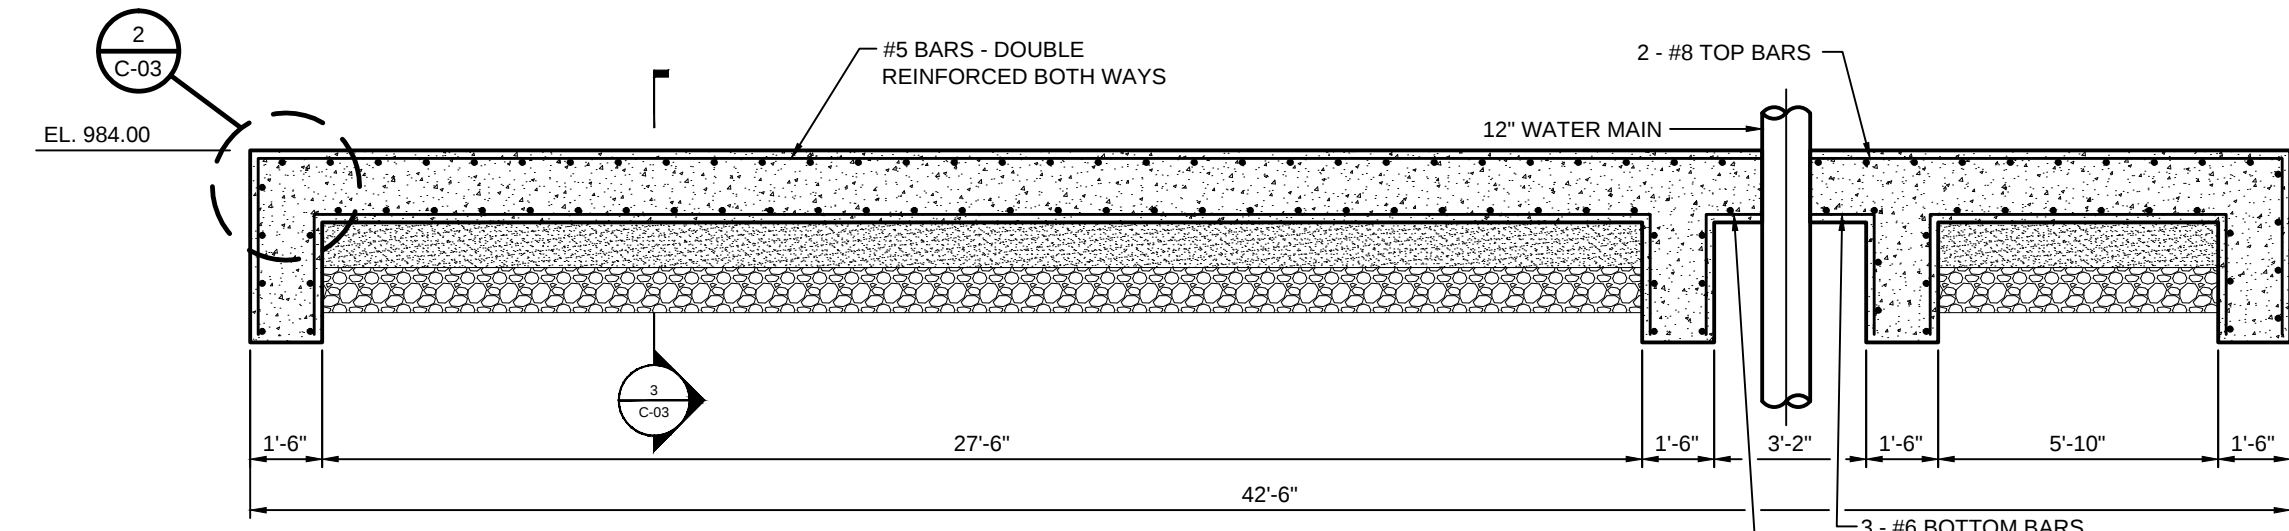


1 SECTION
SCALE: 1/4"=1'-0"

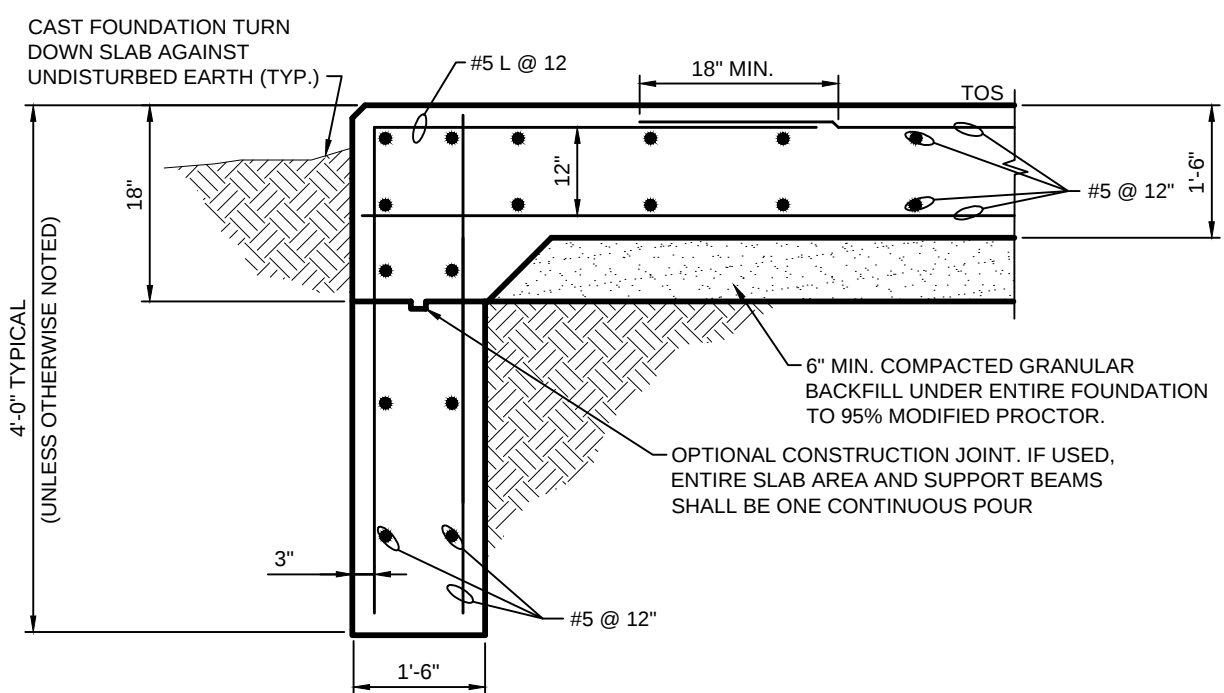


2 DETAIL
NOT TO SCALE

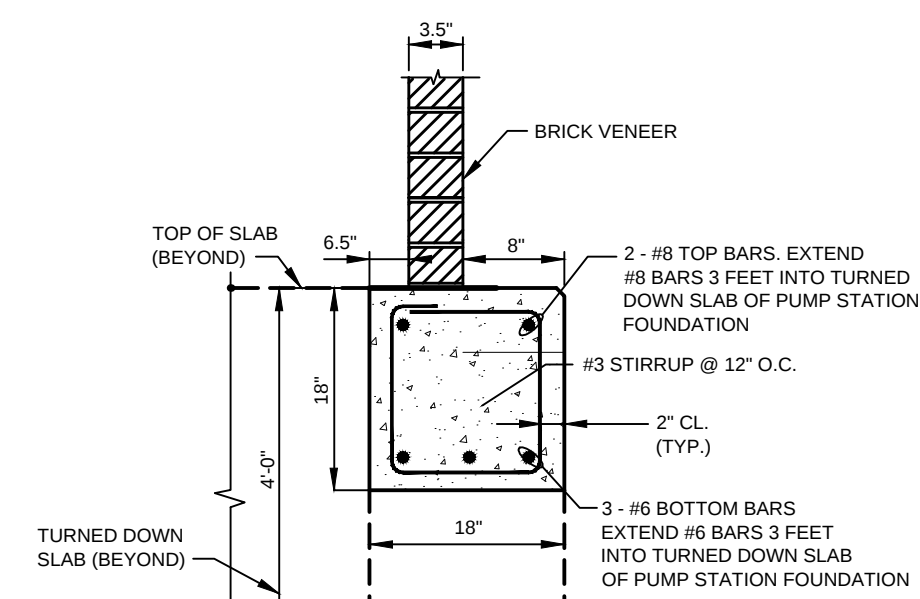

3 DETAIL
NOT TO SCALE

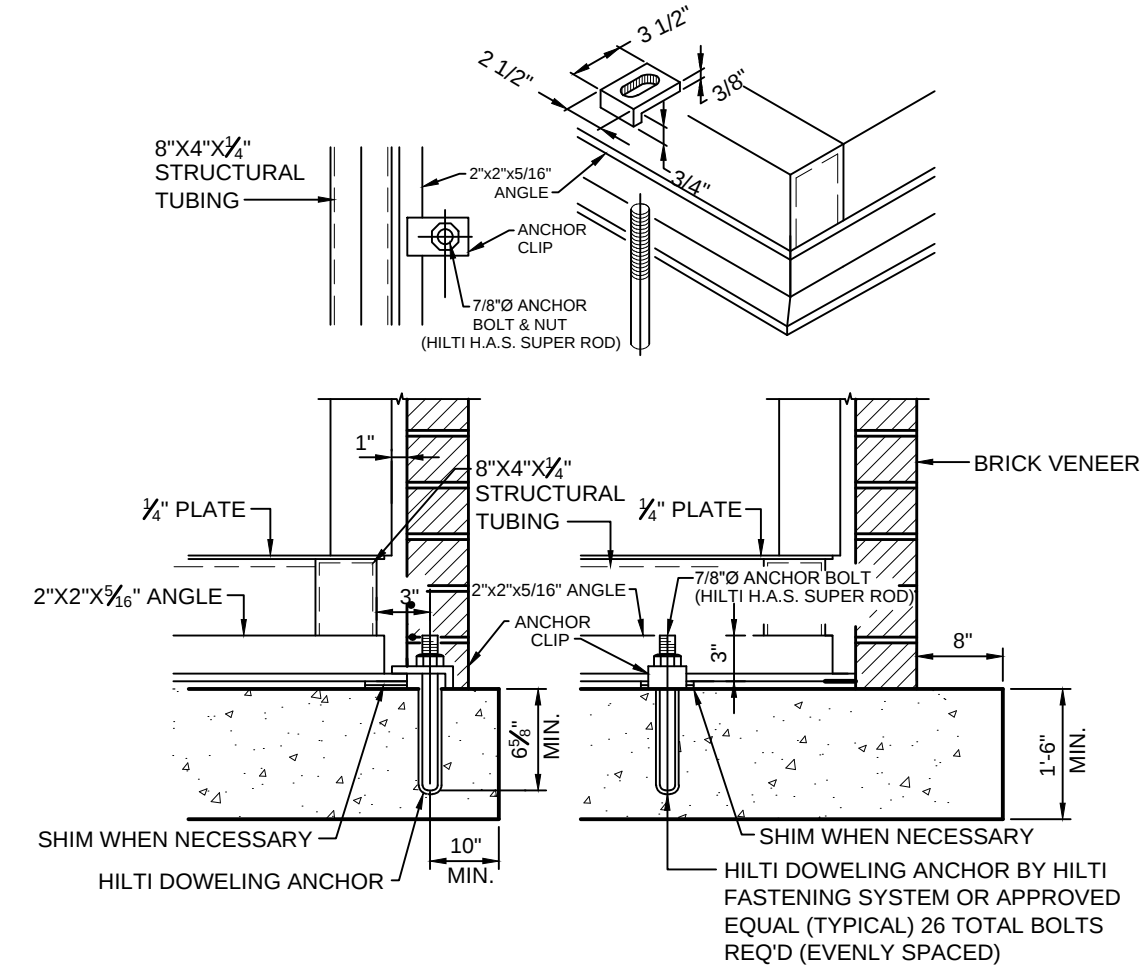

TYPICAL LEDGE - DETAIL
NOT TO SCALE

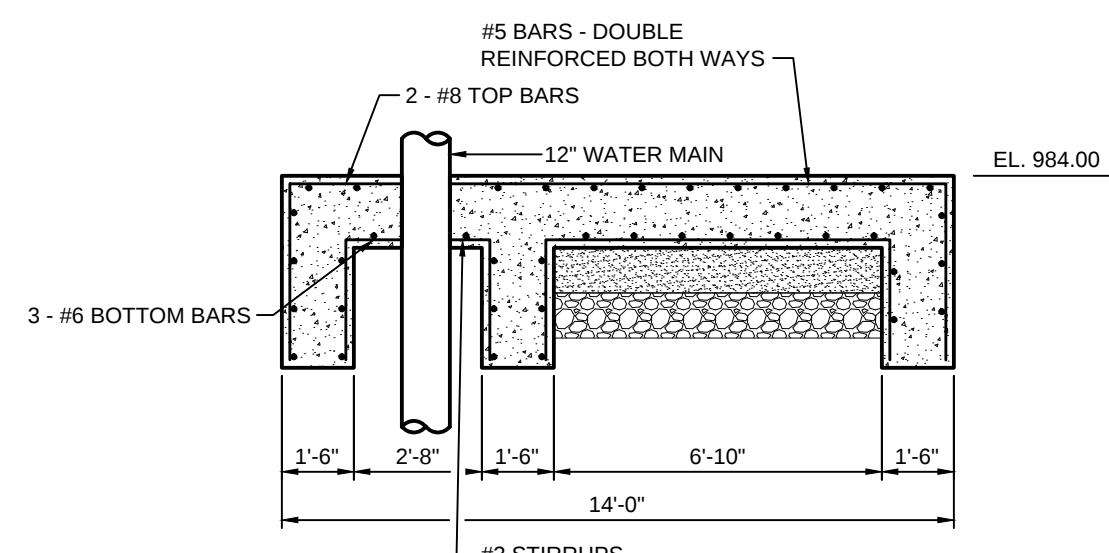


4 SECTION
SCALE: 1/4"=1'-0"


THIS RECORD DOCUMENT HAS BEEN PREPARED BASED ON INFORMATION PROVIDED BY THE CONSTRUCTION CONTRACTOR. GRW ENGINEERS, INC. HAS ATTEMPTED TO VERIFY THE ACCURACY AND/OR COMPLETENESS OF THIS INFORMATION BUT SHALL NOT BE RESPONSIBLE FOR ANY ERRORS OR OMISSIONS WHICH MAY BE INCORPORATED HEREIN AS A RESULT.

GRW
ENGINEERS - ARCHITECTS - PLANNERS
www.grwinc.com


ENGINEER/ARCHITECT: **CRAIG FARRELL**
CONSTRUCTION COMPANY: **ENGINEERED FLUID, INC.**
DATE: **9/2014**

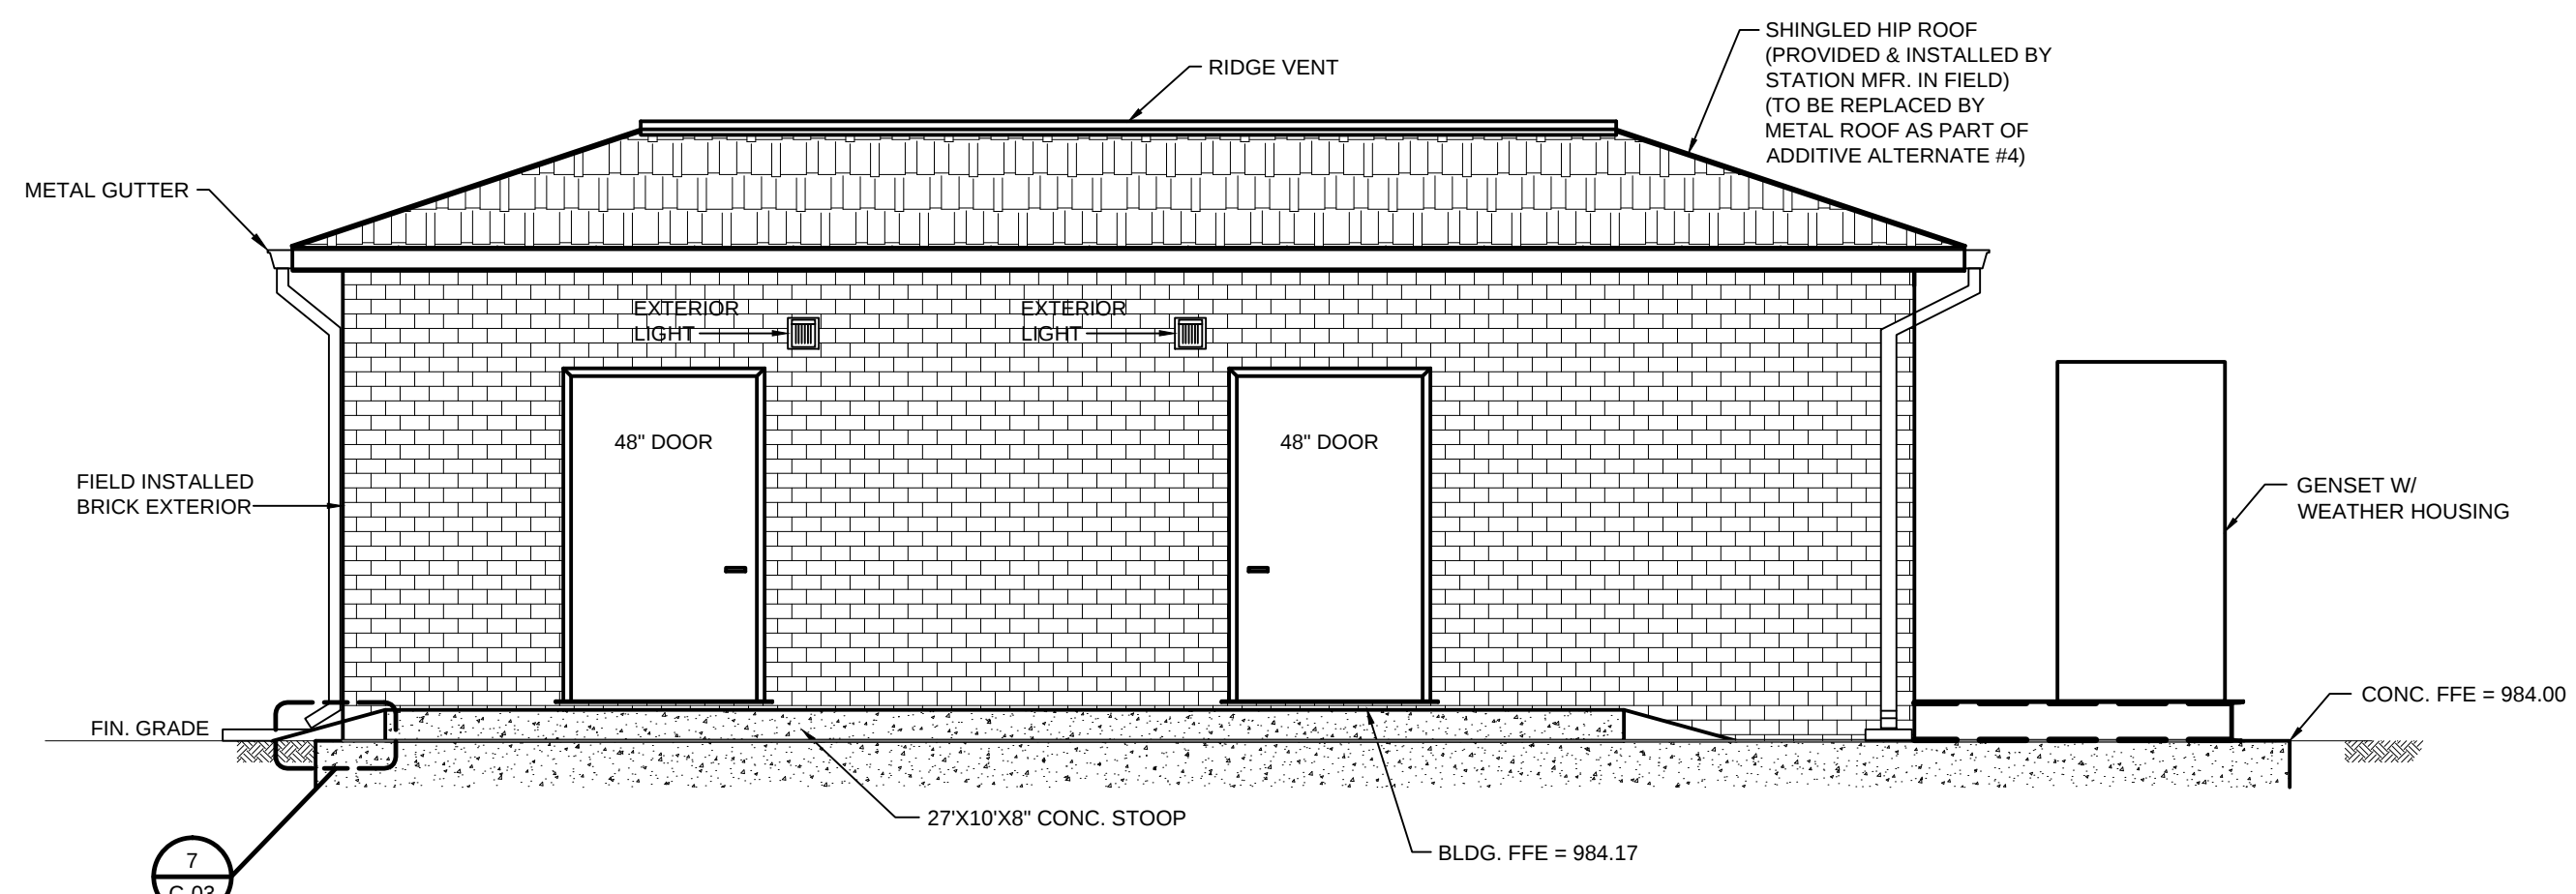


FRONT ELEVATION
SCALE: 1/4"=1'-0"

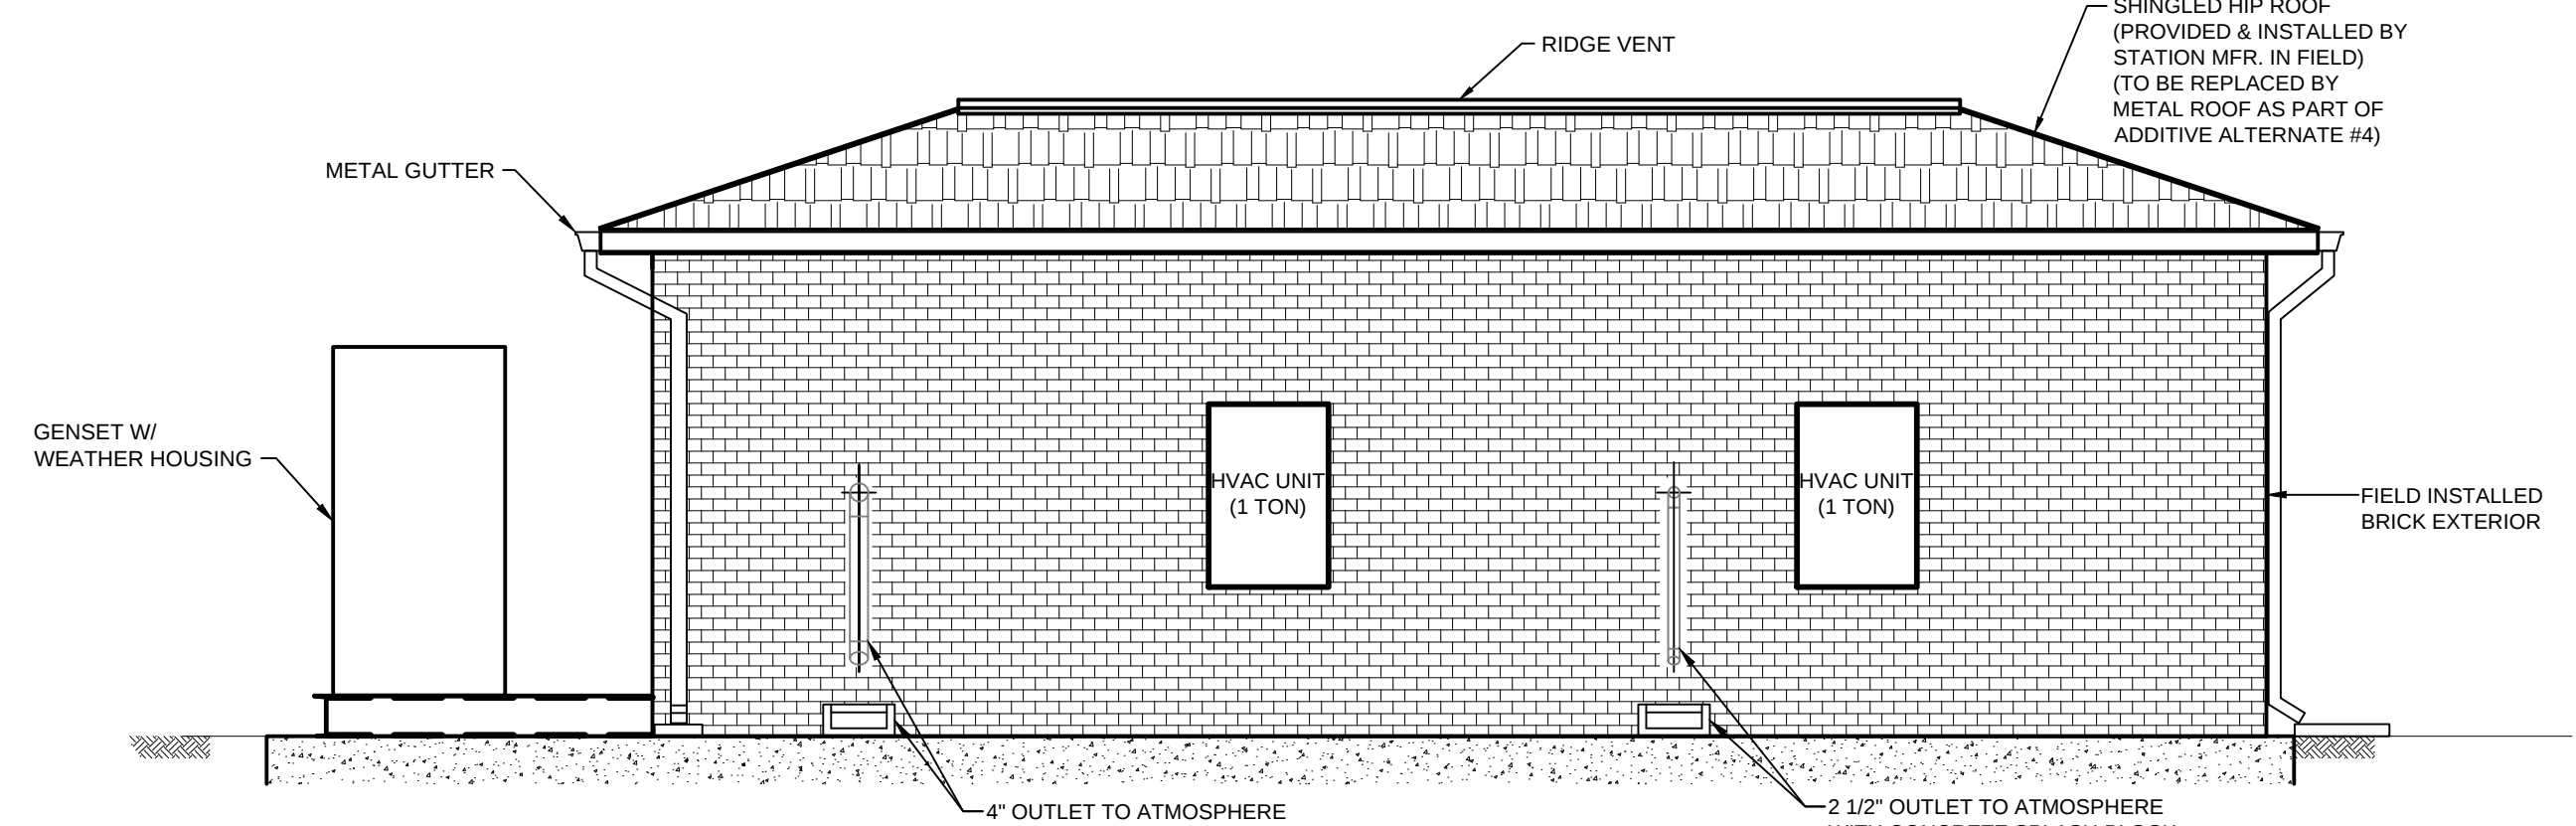


REAR ELEVATION
SCALE: 1/4"=1'-0"

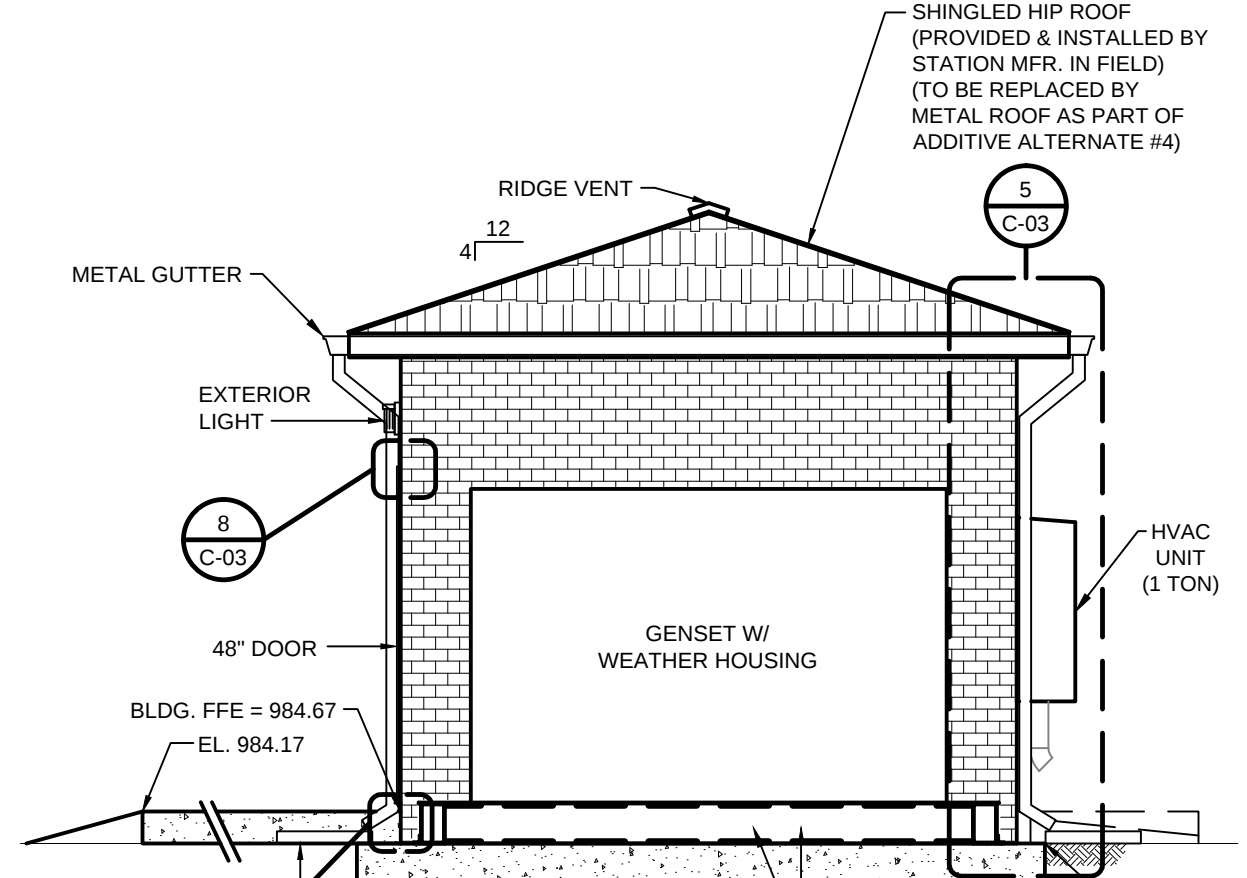


RIGHT SIDE ELEVATION
SCALE: 1/4"=1'-0"

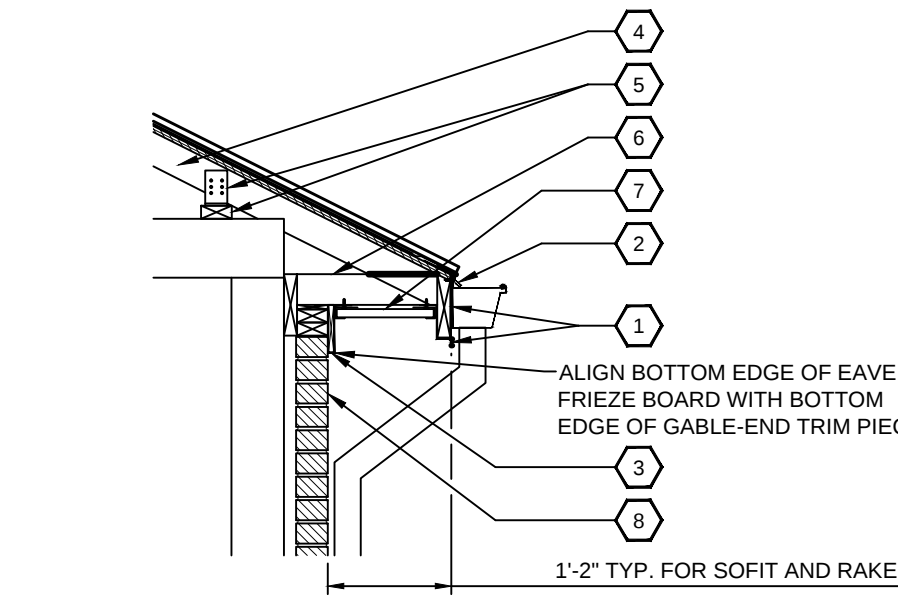


5 WALL SECTION
NOT TO SCALE

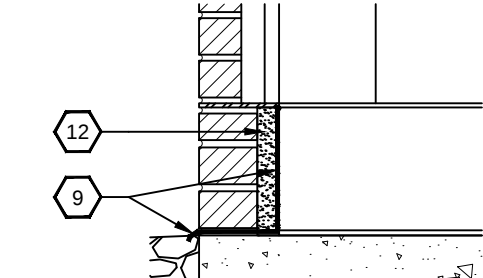


6 DETAIL
NOT TO SCALE

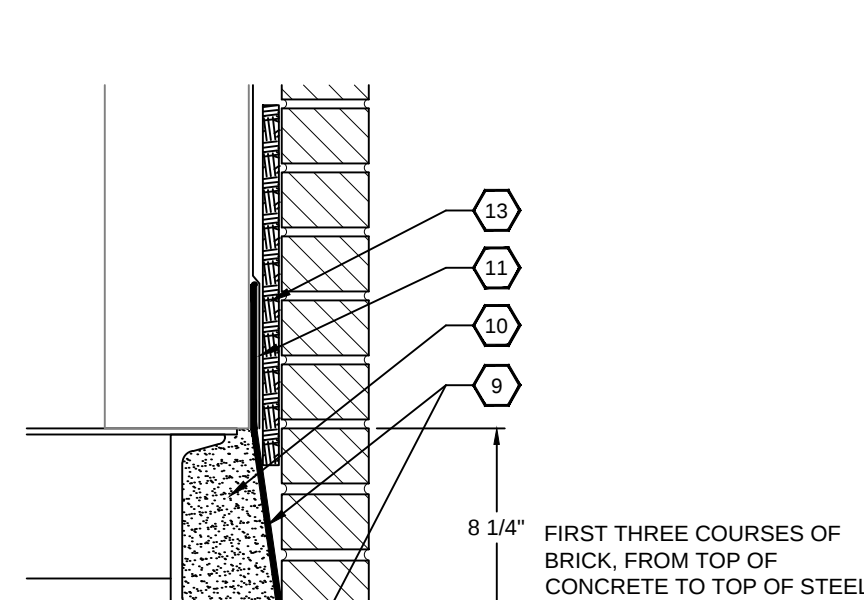

7 DETAIL
NOT TO SCALE

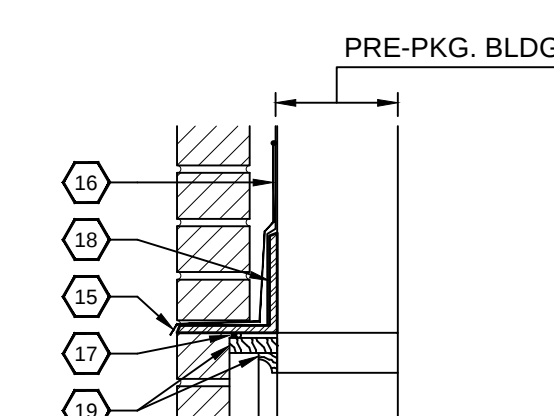

8 DETAIL
NOT TO SCALE

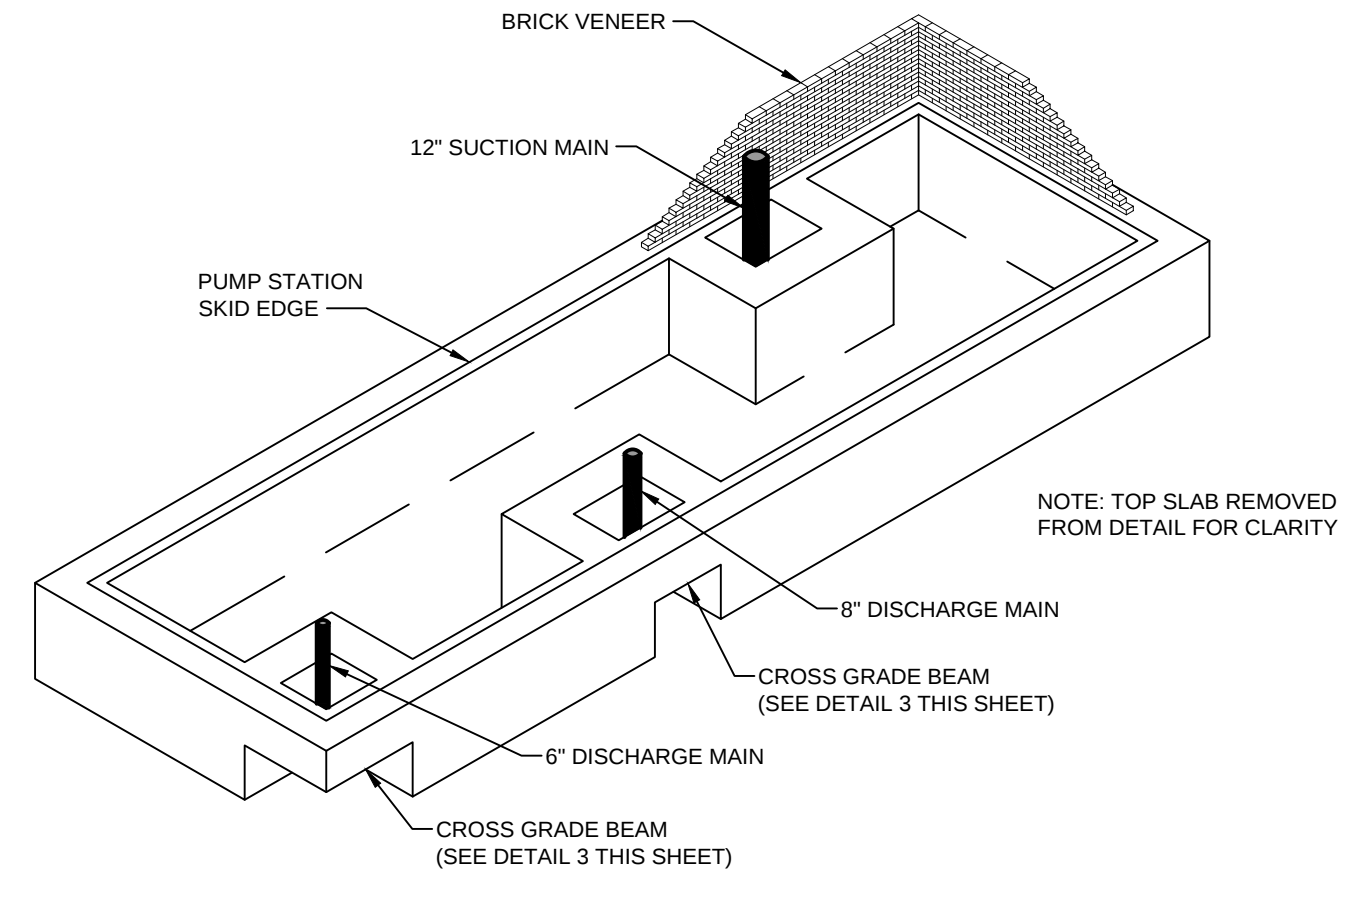

FOUNDATION ISOMETRIC - DETAIL
NOT TO SCALE

SHEET KEYNOTES:

- METAL-WRAP WITH DRIP, 2X FASCIA BOARD.
- CONTINUOUS METAL DRIP EDGE AT ROOF SHEATHING EDGE.
- METAL-WRAP 1X BOTTOM TRIM PIECE.
- 2 X 4 ROOF FRAMING WITH 1X RIDGE BOARD, 2X CROSS-TIES. PROVIDE HURRICANE CLIPS.
- CONTINUOUS 2 X 4 CLEAT ATTACHED AT EACH CEILING JOIST. PROVIDE HURRICANE CLIP, ATTACH TO CLEAT AND TO RAFTER, ONE CLIP PER EACH RAFTER, PER WALL SIDE.
- 2 X 4 SOFFIT FRAMING LOOK-OUT.
- METAL SOFFIT PANEL, PERFORATED AT EAVES.
- TOP-OF-WALL CELLULAR PLASTIC.
- WEEP VENT AT 4'-0" O.C. HEAD JOINTS, IN TOP MOST COURSE THAT IS FULLY BELOW SOFFIT TRIM.
- CONTINUOUS IN-VIEW METAL FLASHING.
- PROVIDE SOLID GROUT-FILL SUPPORT FOR FLASHING (TYPICAL).
- PROVIDE AT LEAST ONE EXTRA LAYER OF WEATHER-RESISTANT BARRIER PAPER TAPED TO OVER-LAP METAL FLASHING 8" MINIMUM.
- GROUT-FILL SOLID BETWEEN MASONRY AND STEEL SKID SYSTEM. PROVIDE IN-VIEW METAL FLASHING BETWEEN SKID AND GROUT.
- CAVITY DRAINAGE MATERIAL.
- CONCRETE SPLASHBLOCK TYPE "1"
- (SEE SPECS.)
- CONTINUOUS IN-VIEW METAL FLASHING.
- PROVIDE AT LEAST ONE EXTRA LAYER OF WEATHER-RESISTANT BARRIER PAPER TAPED TO OVER-LAP METAL FLASHING 8" MINIMUM.
- SEALANT (AND BACKING ROD, IF NEEDED).
- PROVIDE STEEL LINTEL ANGLE 5 X 5 X 3/8 FOR BRICK SUPPORT AT HEAD OF DOUBLE DOORS, AND AT HEAD OF HVAC UNIT.
- PROVIDE WOOD TRIM BRICK-MOULDING AT DOOR HEAD AND JAMBS TO SPAN GAP IN CAVITY WALL SYSTEM. PRIME AND PAINT FINISH.

This document, originally issued, sealed, and signed by Daniel R. Cutshaw, Indiana Professional Engineer, No. 11200431, on April 19, 2013, shall not be used in lieu of a certified document.

GRW PROJECT NO. 3916-08

CLIENT CONTRACT NO H-1

ALL RIGHTS RESERVED. NO PART OF THIS DOCUMENT SHALL BE REPRODUCED IN WHOLE OR IN PART WITHOUT THE WRITTEN PERMISSION OF GRW ENGINEERS, INC. AND SHALL NOT BE USED FOR ANY OTHER PROJECT OTHER THAN THIS SPECIFIC PROJECT WITHOUT THE WRITTEN PERMISSION OF GRW ENGINEERS, INC.

GRW
ENGINEERS - ARCHITECTS - PLANNERS
www.grwinc.com

U.S. 421 P.S. DETAILS-ELEVATION VIEWS
CONTRACT H-1 - U.S. 421 P.S. & TELEMETRY
DIVISION H - WATERWORKS SYSTEM IMPROVEMENTS
HOOSIER HILLS REGIONAL WATER DISTRICT
RIPLEY COUNTY, INDIANA

DESIGNED	ALW	DATE	9/2014	BY	JEC	REVIEWED	CJF	APPROVED	DRC
NO.	1	AS-BUILT REVISION							

DATE: **APRIL 2013**
SCALE: **AS NOTED**
SHEET NO.

C-03