



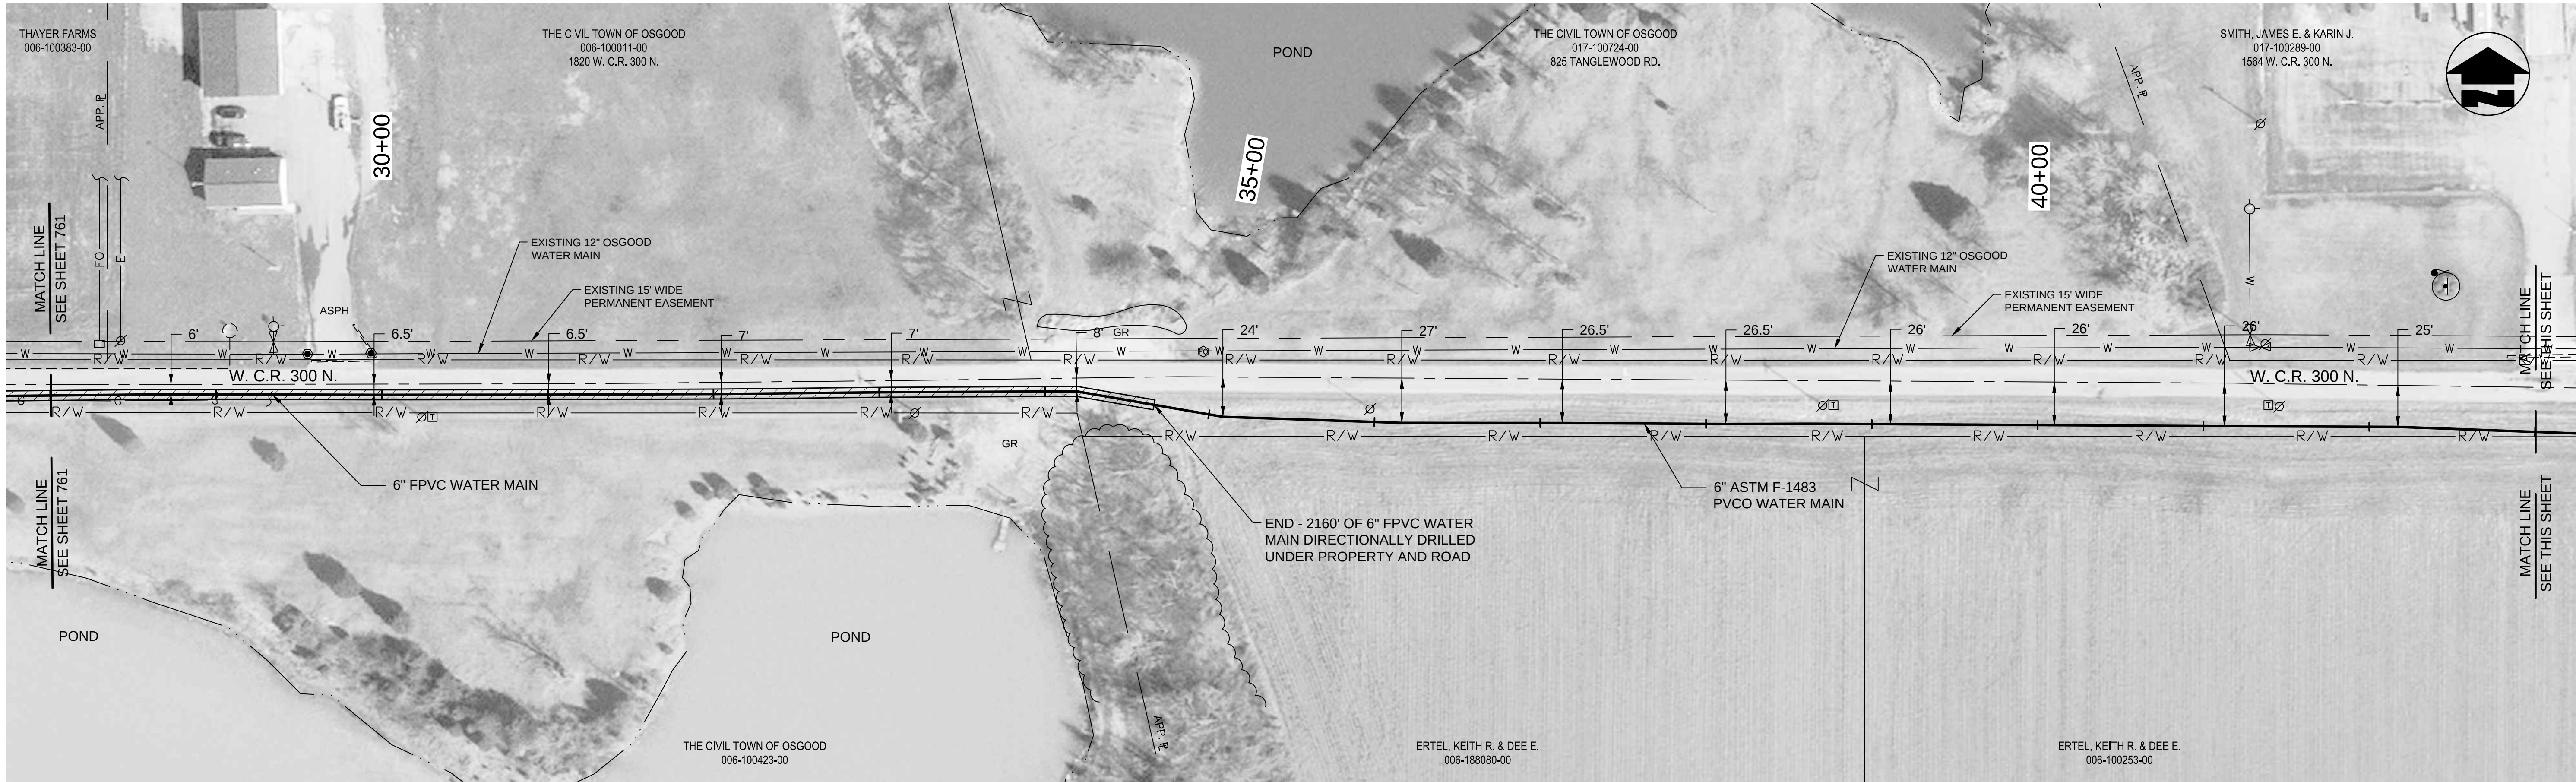

PLAN VIEW - STA. 28+00 TO STA. 43+00 LINE "W-3"

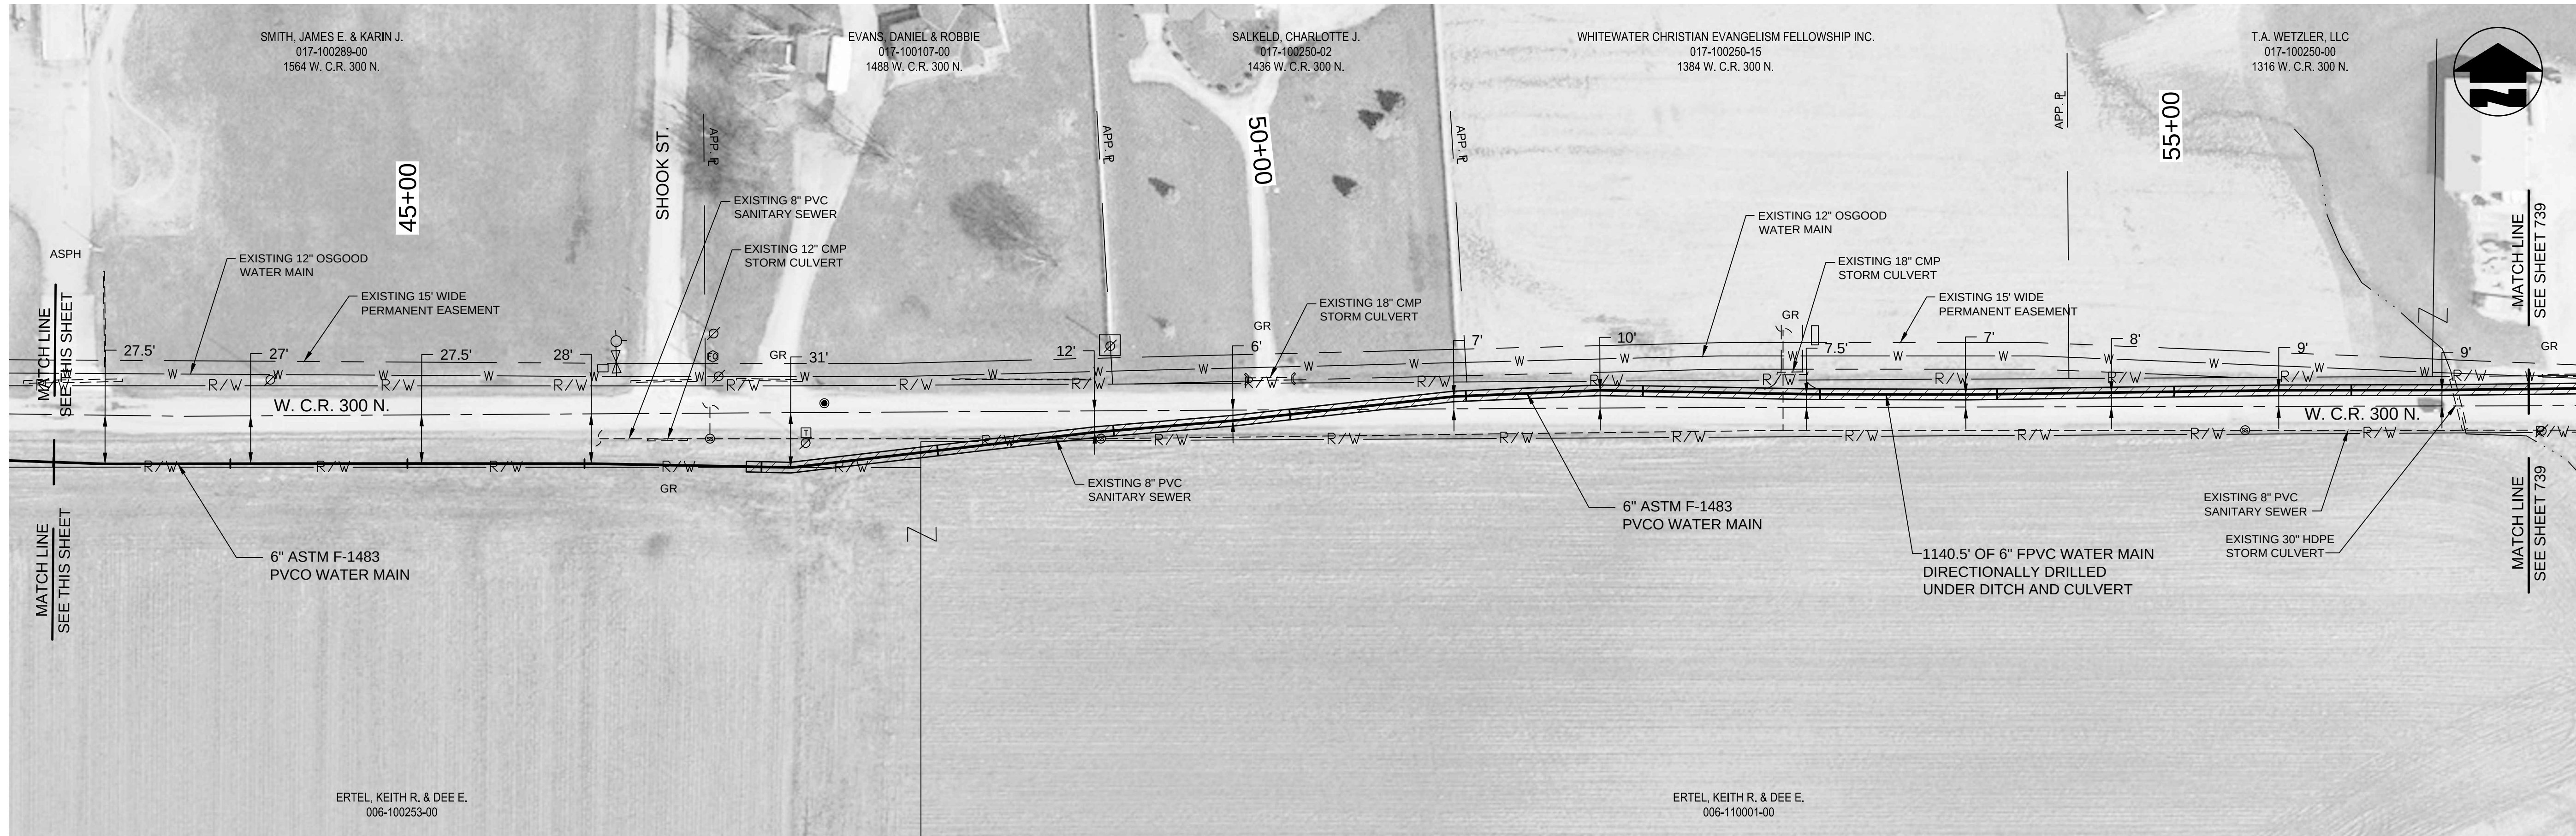

PLAN VIEW - STA. 43+00 TO STA. 57+00 LINE "W-3"

NOTES:

1. THE UTILITIES AND THEIR LOCATION SHOWN ON PLANS ARE APPROXIMATE. CONTRACTOR SHALL VERIFY ALL UTILITIES IN THE FIELD AND NOTIFY ALL UTILITY COMPANIES PRIOR TO INSTALLATION OF THE WATER LINE.
2. ALL PIPING SHALL BE CLASS 200 UNLESS OTHERWISE NOTED.
3. 48" MINIMUM COVER REQUIRED OVER TOP OF WATER LINE UNLESS OTHERWISE NOTED.


THIS RECORD DOCUMENT HAS BEEN PREPARED BASED ON INFORMATION PROVIDED BY THE CONSTRUCTION CONTRACTOR. GRW ENGINEERS, INC. HAS ATTEMPTED TO VERIFY THE ACCURACY AND/OR COMPLETENESS OF THIS INFORMATION BUT SHALL NOT BE RESPONSIBLE FOR ANY ERRORS OR OMISSIONS WHICH MAY BE INCORPORATED HEREIN AS A RESULT.

GRW
ENGINEERS - ARCHITECTS - PLANNERS
www.grwinc.com

ENGINEER/ARCHITECT: **CRAIG FARRELL**

CONSTRUCTION COMPANY: **LITTLE CREEK CONSTRUCTION, INC.**

DATE: **9/2014**

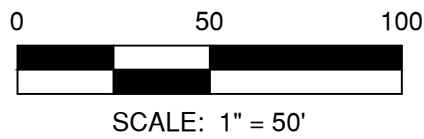

GRW PROJECT NO. 3916-01

CLIENT CONTRACT NO. H-2

ALL RIGHTS RESERVED. NO PART OF THIS DOCUMENT SHALL BE REPRODUCED IN WHOLE OR IN PART WITHOUT WRITTEN PERMISSION OF GRW ENGINEERS, INC.

GRW
ENGINEERS - ARCHITECTS - PLANNERS
www.grwinc.com

C.R. 300 N.

CONTRACT H-2 - VERSAILLES AREA

DIVISION H - WATERWORKS SYSTEM IMPROVEMENTS

HOOSIER HILLS REGIONAL WATER DISTRICT

RIPLEY AND FRANKLIN COUNTIES, INDIANA

DESIGNED		DRAWN		REVIEWED		APPROVED	
ALW		JAJ		CJF		DRC	
NO.	DATE	NO.	DATE	NO.	DATE	NO.	DATE
1.	9/2014						

REVISIONS

NO.	DESCRIPTION
1.	AS-BUILT REVISION

DATE: **APRIL 2013**

SCALE: **1"=50'**

SHEET NO.

762