
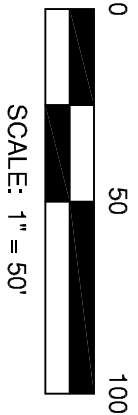
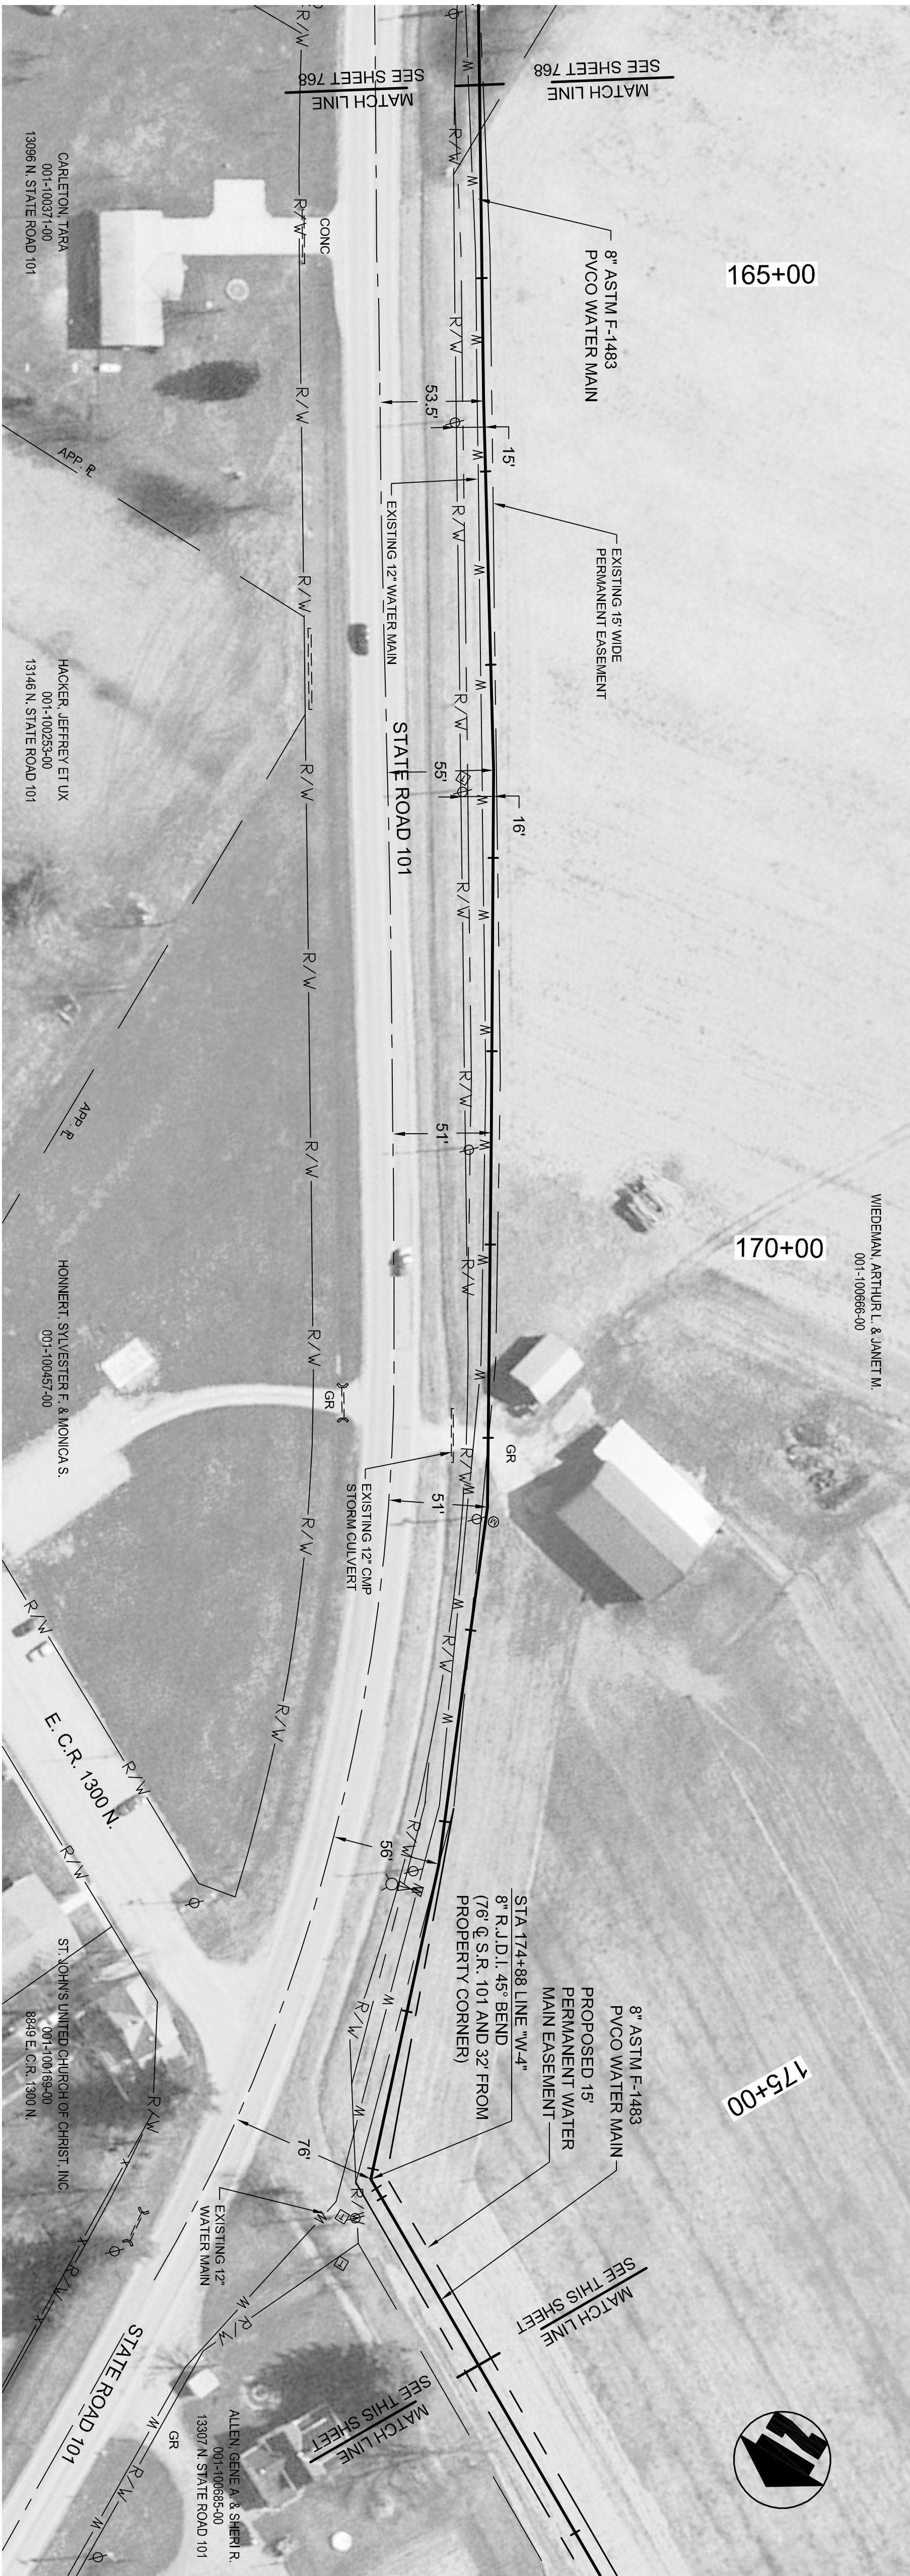


- NOTES:
1. THE UTILITIES AND THEIR LOCATION SHOWN ON PLANS ARE APPROXIMATE. CONTRACTOR SHALL VERIFY ALL UTILITIES IN THE FIELD AND NOTIFY ALL UTILITY COMPANIES PRIOR TO INSTALLATION OF THE WATER LINE.
 2. ALL PIPING SHALL BE CLASS 200 UNLESS OTHERWISE NOTED.
 3. 48" MINIMUM COVER REQUIRED OVER TOP OF WATER LINE UNLESS OTHERWISE NOTED.

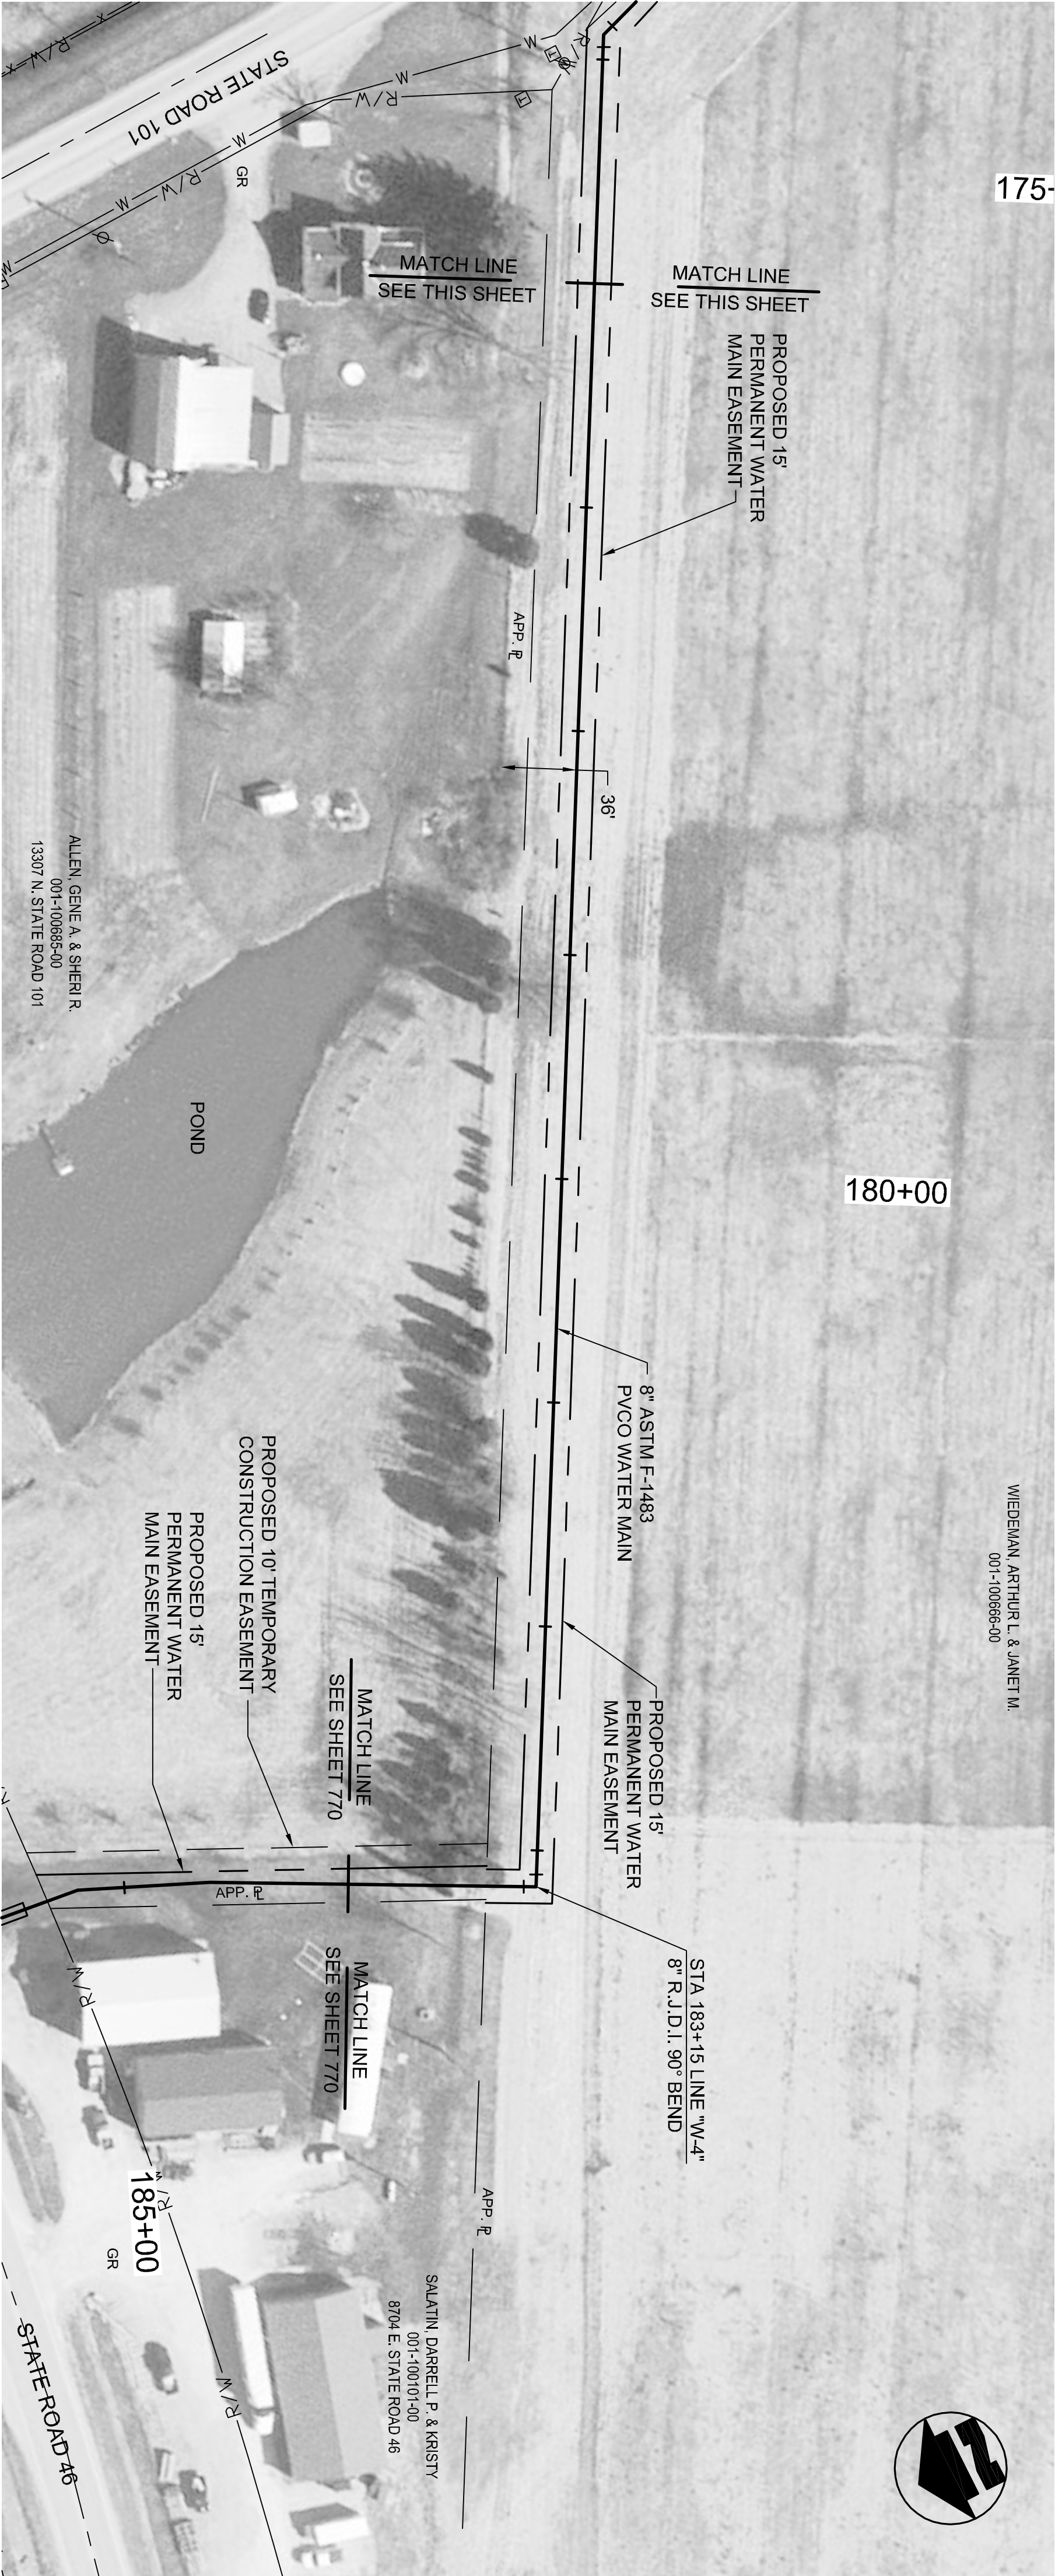

THIS RECORD DOCUMENT HAS BEEN PREPARED BASED ON INFORMATION PROVIDED BY THE CONSTRUCTION CONTRACTOR. GRW ENGINEERS, ARCHITECTS & PLANNERS, INC. SHALL NOT BE RESPONSIBLE FOR ANY ERRORS OR OMISSIONS WHICH MAY BE INCORPORATED HEREIN AS A RESULT.

GRW
ENGINEERS - ARCHITECTS - PLANNERS
www.grwinc.com

ENGINEER/ARCHITECT: CRAIG PARRELL
CONSTRUCTION COMPANY: MIKE HOLMAN EXC. INC.
DATE: 9/20/14

DATE: APRIL 2013 SCALE: 1"=60' SHEET NO. 769	REVISIONS				DESIGNED:
	NO.	DESCRIPTION	DATE	BY	ALW
	1.	AS-BUILT REVISION	9/2014	JEC	DRAWN: JAJ
					REVIEWED: CJF
					APPROVED: DRC
	SCALE CHECK: THIS MARK SHOULD MEASURE EXACTLY 1" WHEN PLOTTED				

STATE ROAD 101 AND STATE ROAD 46
CONTRACT H-3 - PENNTOWN AREA
DIVISION H - WATERWORKS SYSTEM IMPROVEMENTS
HOOSIER HILLS REGIONAL WATER DISTRICT
RIPLEY AND FRANKLIN COUNTIES, INDIANA

GRW
ENGINEERS - ARCHITECTS - PLANNERS
www.grwinc.com

GRW PROJECT NO. 3916-01
CLIENT PROJECT NO. H-3
ALL RIGHTS RESERVED: THIS DOCUMENT IS THE PROPERTY OF GRW ENGINEERS, INC. AND SHALL NOT BE REPRODUCED IN WHOLE OR IN PART OR USED FOR CONSTRUCTION OF OTHER THAN THIS SPECIFIC PROJECT WITHOUT WRITTEN PERMISSION

This document, originally issued and prepared by Daniel R. Culbreth, Indiana Professional Engineer, No. 11200431, on April 15, 2013, shall not be used in lieu of a certified document.