


PRINTED: 11/22/2014 @ 3:30PM

FILE NAME: Y:\3916-HRWWD-Div-H\Working Drawings\Civil 3D\H-4\3916-786.dwg



PLAN VIEW - STA. 177+00 TO STA. 193+00 LINE "W-6"

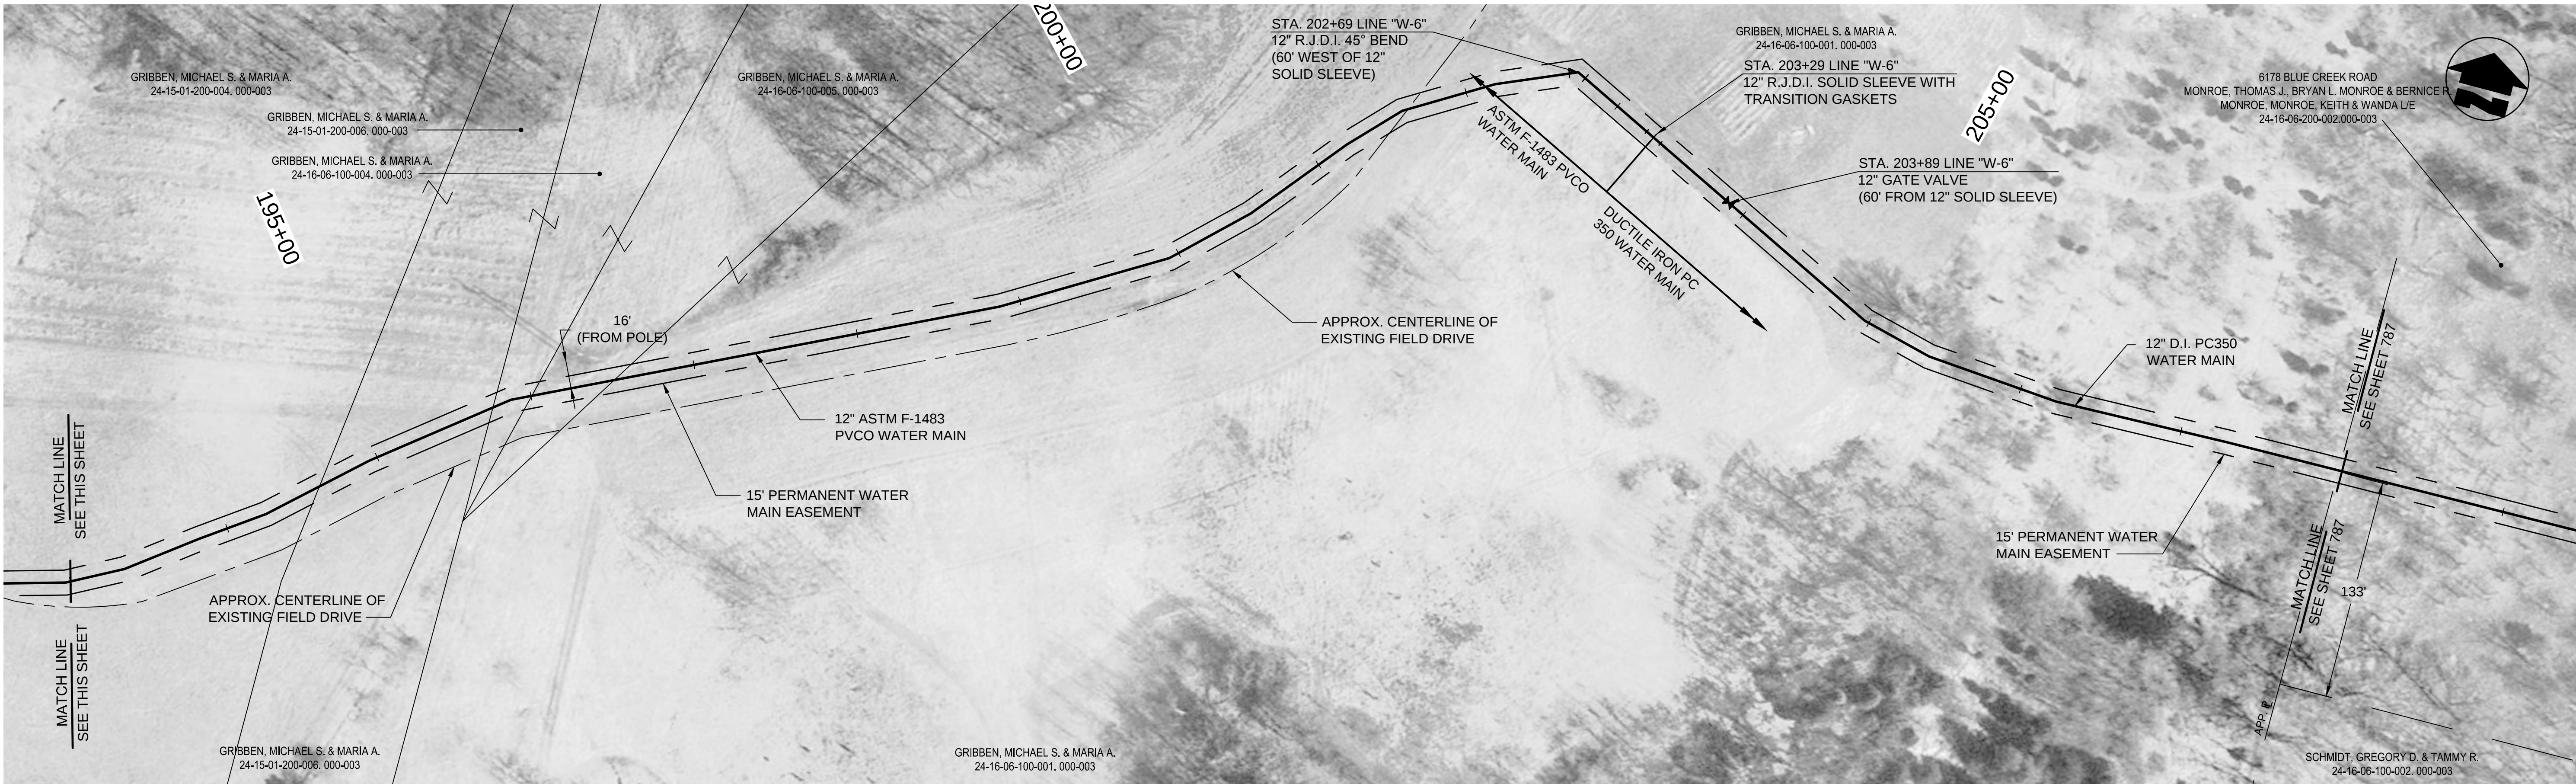

PLAN VIEW - STA. 193+00 TO STA. 208+00 LINE "W-6"

NOTES:

1. THE UTILITIES AND THEIR LOCATION SHOWN ON PLANS ARE APPROXIMATE. CONTRACTOR SHALL VERIFY ALL UTILITIES IN THE FIELD AND NOTIFY ALL UTILITY COMPANIES PRIOR TO INSTALLATION OF THE WATER LINE.
2. ALL PIPING SHALL BE CLASS 200 UNLESS OTHERWISE NOTED.
3. 48" MINIMUM COVER REQUIRED OVER TOP OF WATER LINE UNLESS OTHERWISE NOTED.


THIS RECORD DOCUMENT HAS BEEN PREPARED BASED ON INFORMATION PROVIDED BY THE CONSTRUCTION CONTRACTOR. GRW ENGINEERS, INC. HAS ATTEMPTED TO VERIFY THE ACCURACY AND/OR COMPLETENESS OF THIS INFORMATION BUT SHALL NOT BE RESPONSIBLE FOR ANY ERRORS OR OMISSIONS WHICH MAY BE INCORPORATED HEREIN AS A RESULT.

ENGINEERS - ARCHITECTS - PLANNERS
www.grwinc.com

ENGINEER/ARCHITECT: CRAIG FARRELL

CONSTRUCTION COMPANY: BRACKNEY, INC.

DATE: 9/2014

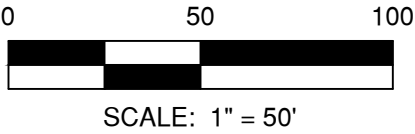

This document, originally issued, sealed, and signed by Daniel R. Cutshaw, Indiana Professional Engineer, No. 11200431, on April 15, 2013, shall not be used in lieu of a certified document.

GRW PROJECT NO. 3916-01

CLIENT PROJECT NO. H-4

ALL RIGHTS RESERVED. NO PART OF THIS DOCUMENT SHALL BE REPRODUCED IN WHOLE OR IN PART WITHOUT THE WRITTEN PERMISSION OF GRW ENGINEERS, INC. OTHER THAN THIS SPECIFIC PROJECT WITHOUT WRITTEN PERMISSION.

ENGINEERS - ARCHITECTS - PLANNERS
www.grwinc.com

HERTEL ROAD

CONTRACT H-4 - CANE MILL AREA

DIVISION H - WATERWORKS SYSTEM IMPROVEMENTS

HOOSIER HILLS REGIONAL WATER DISTRICT

RIPLEY AND FRANKLIN COUNTIES, INDIANA

DESIGNED	ALW	BY	DATE	DESCRIPTION
DRAWN	JAJ	JEC	9/2014	1. AS-BUILT REVISION
REVIEWED	CJF			
APPROVED	DRC			

DATE: APRIL 2013

SCALE: 1"=50'

SHEET NO.

786