


MAINTENANCE: THE STABILIZED CONSTRUCTION ENTRANCE SHALL BE INSTALLED WHERE SHOWN ON THE PLAN. THE ENTRANCE SHALL BE INSPECTED WEEKLY AND ADDITIONAL INDOT NO. 2 STONE SHALL BE KEPT ON SITE SO THAT THE MINIMUM DIMENSIONS CAN BE MAINTAINED THROUGHOUT THE PROJECT. SEDIMENT TRACKED ONTO A PUBLIC ROADWAY SHALL BE REMOVED AT THE END OF EACH CONSTRUCTION DAY AND PLACED ON THE TOPSOIL STOCKPILE. NO OTHER ENTRANCE SHALL BE USED TO GAIN ACCESS TO THE SITE BY ANY CONSTRUCTION, PERSONAL OR DELIVERY VEHICLES.

STABILIZATION PRACTICE	JAN.	FEB.	MAR.	APR.	MAY	JUN.	JUL.	AUG.	SEP.	OCT.	NOV.	DEC.
PERMANENT SEEDING				A			*//////////N////////*					
DORMANT SEEDING	B										B	
TEMPORARY SEEDING			C						D			
SODDING			E**				*//////////N////////*					
MULCHING	F											

A = INDOT SEED MIXTURE GRASS TYPE 2; PLUS 2 TONS STRAW MULCH/ACRE.
 B = KENTUCKY BLUEGRASS 60 LBS/ACRE; CREEPING RED FESCUE 60 LBS/ACRE; PLUS 2 TONS STRAW MULCH/ACRE, OR ADD ANNUAL RYEGRASS 30 LBS/ACRE.
 C = INDOT SEED MIXTURE TYPE "T" SPRING OATS - 150 LBS/ACRE
 D = INDOT SEE MIXTURE TYPE "T" WINTER WHEAT - 150 LBS/ACRE
 E = SOD
 F = STRAW MULCH 2 TONS/ACRE
 //// IRRIGATION NEEDED DURING JUNE, JULY, AND/OR AUGUST.
 ** IRRIGATION NEEDED FOR 2 TO 3 WEEKS AFTER APPLYING SOD.

SEASONAL SOIL PROTECTION CHART

NOT TO SCALE

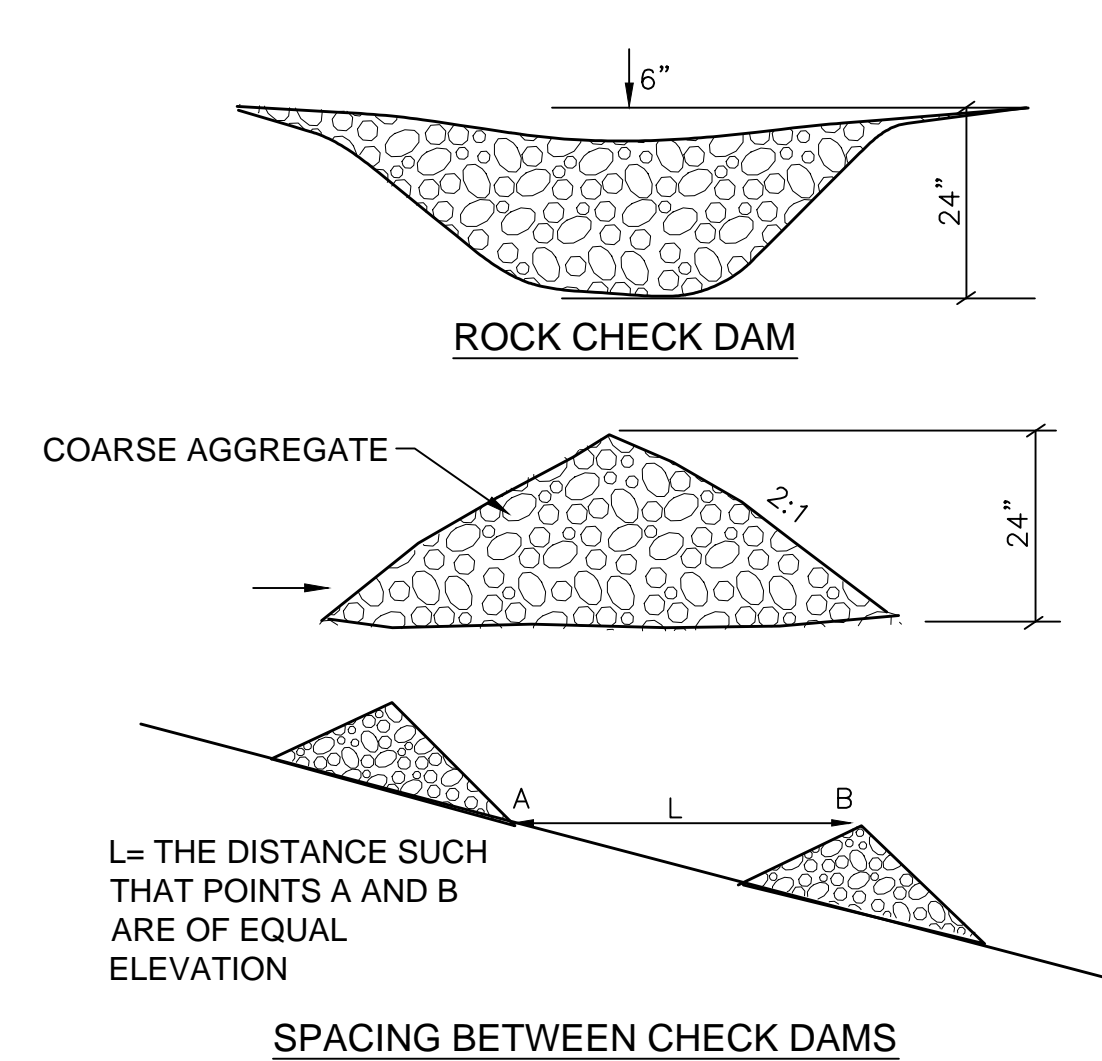

NOTE: STONE BAGS MAY BE USED FOR TEMPORARY CHECK DAMS. INSTALL IN SAME CONFIGURATION.

CHECK DAM DETAILS

CONTRACT H-2

THIS RECORD DOCUMENT HAS BEEN PREPARED BASED ON INFORMATION PROVIDED BY THE CONSTRUCTION CONTRACTOR. GRW ENGINEERS, INC. HAS ATTEMPTED TO VERIFY THE ACCURACY AND/OR COMPLETENESS OF THIS INFORMATION BUT SHALL NOT BE RESPONSIBLE FOR ANY ERRORS OR OMISSIONS WHICH MAY BE INCORPORATED HEREIN AS A RESULT.

ENGINEER/ARCHITECT: CRAIG FARRELL
CONSTRUCTION COMPANY: LITTLE CREEK CONSTRUCTION, INC.
 DATE: 9/2014

CONTRACT H-3

THIS RECORD DOCUMENT HAS BEEN PREPARED BASED ON INFORMATION PROVIDED BY THE CONSTRUCTION CONTRACTOR. GRW ENGINEERS, INC. HAS ATTEMPTED TO VERIFY THE ACCURACY AND/OR COMPLETENESS OF THIS INFORMATION BUT SHALL NOT BE RESPONSIBLE FOR ANY ERRORS OR OMISSIONS WHICH MAY BE INCORPORATED HEREIN AS A RESULT.

ENGINEER/ARCHITECT: CRAIG FARRELL
CONSTRUCTION COMPANY: MIKE HOLMAN EXC., INC.
 DATE: 9/2014

CONTRACT H-4

THIS RECORD DOCUMENT HAS BEEN PREPARED BASED ON INFORMATION PROVIDED BY THE CONSTRUCTION CONTRACTOR. GRW ENGINEERS, INC. HAS ATTEMPTED TO VERIFY THE ACCURACY AND/OR COMPLETENESS OF THIS INFORMATION BUT SHALL NOT BE RESPONSIBLE FOR ANY ERRORS OR OMISSIONS WHICH MAY BE INCORPORATED HEREIN AS A RESULT.

ENGINEER/ARCHITECT: CRAIG FARRELL
CONSTRUCTION COMPANY: BRACKNEY, INC.
 DATE: 9/2014

EROSION CONTROL DETAILS

DIVISION H - WATERWORKS SYSTEM IMPROVEMENTS
 HOOSIER HILLS REGIONAL WATER DISTRICT
 RIPLEY AND FRANKLIN COUNTIES, INDIANA

DESIGNED	ALW	DRAWN	JAJ	REVIEWED	CJF	APPROVED	DRC
DATE	9/2014	JEC					
NO.	1.	AS-BUILT REVISION					
DESCRIPTION							
SCALE CHECK							
DATE:	APRIL 2013						
SCALE:	NONE						
SHEET NO.							