



 **W-4 CONTRACT "H-3"**  
**PENNTOWN AREA SHEET INDEX**  
SCALE: 1" = 2000'

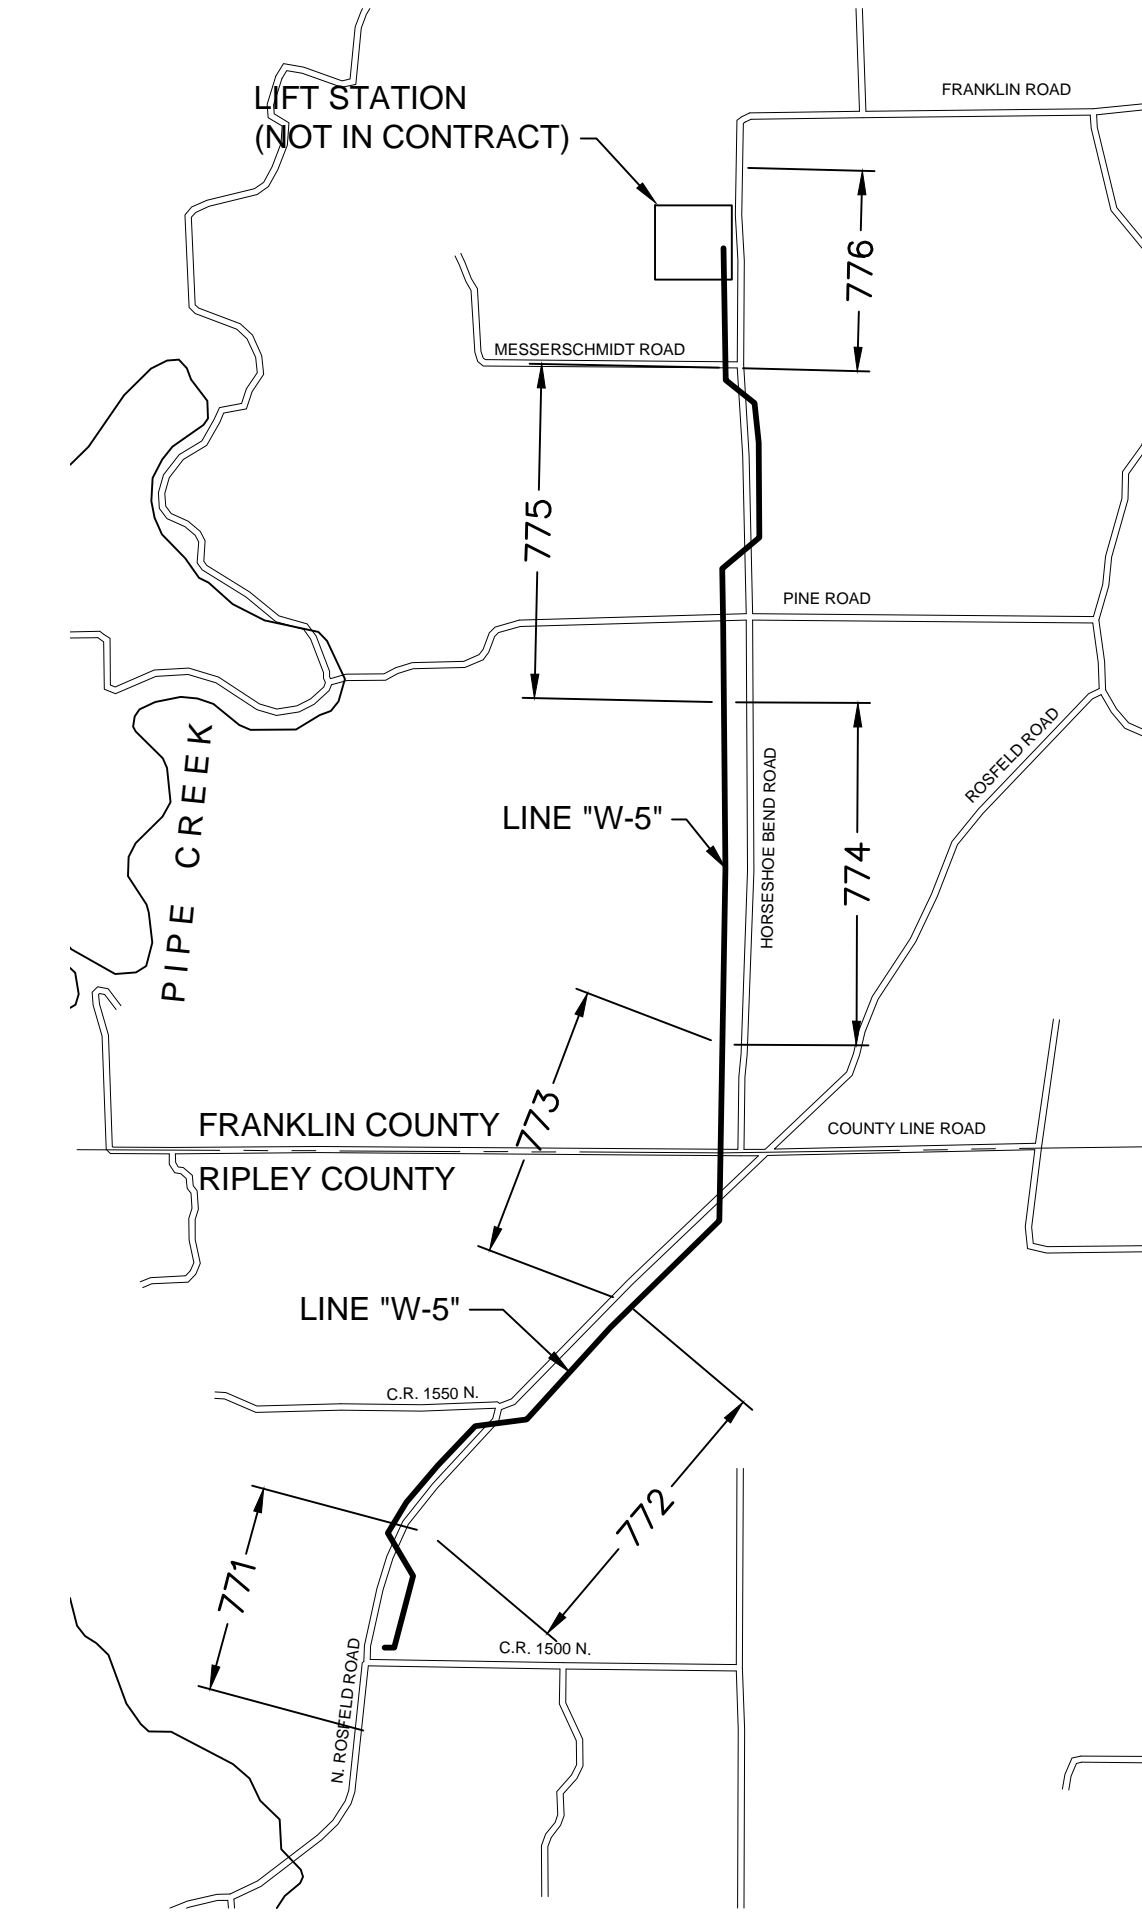


 **W-5 CONTRACT "H-3"**  
**HORSESHOE BEND AREA SHEET INDEX**  
SCALE: 1" = 2000'

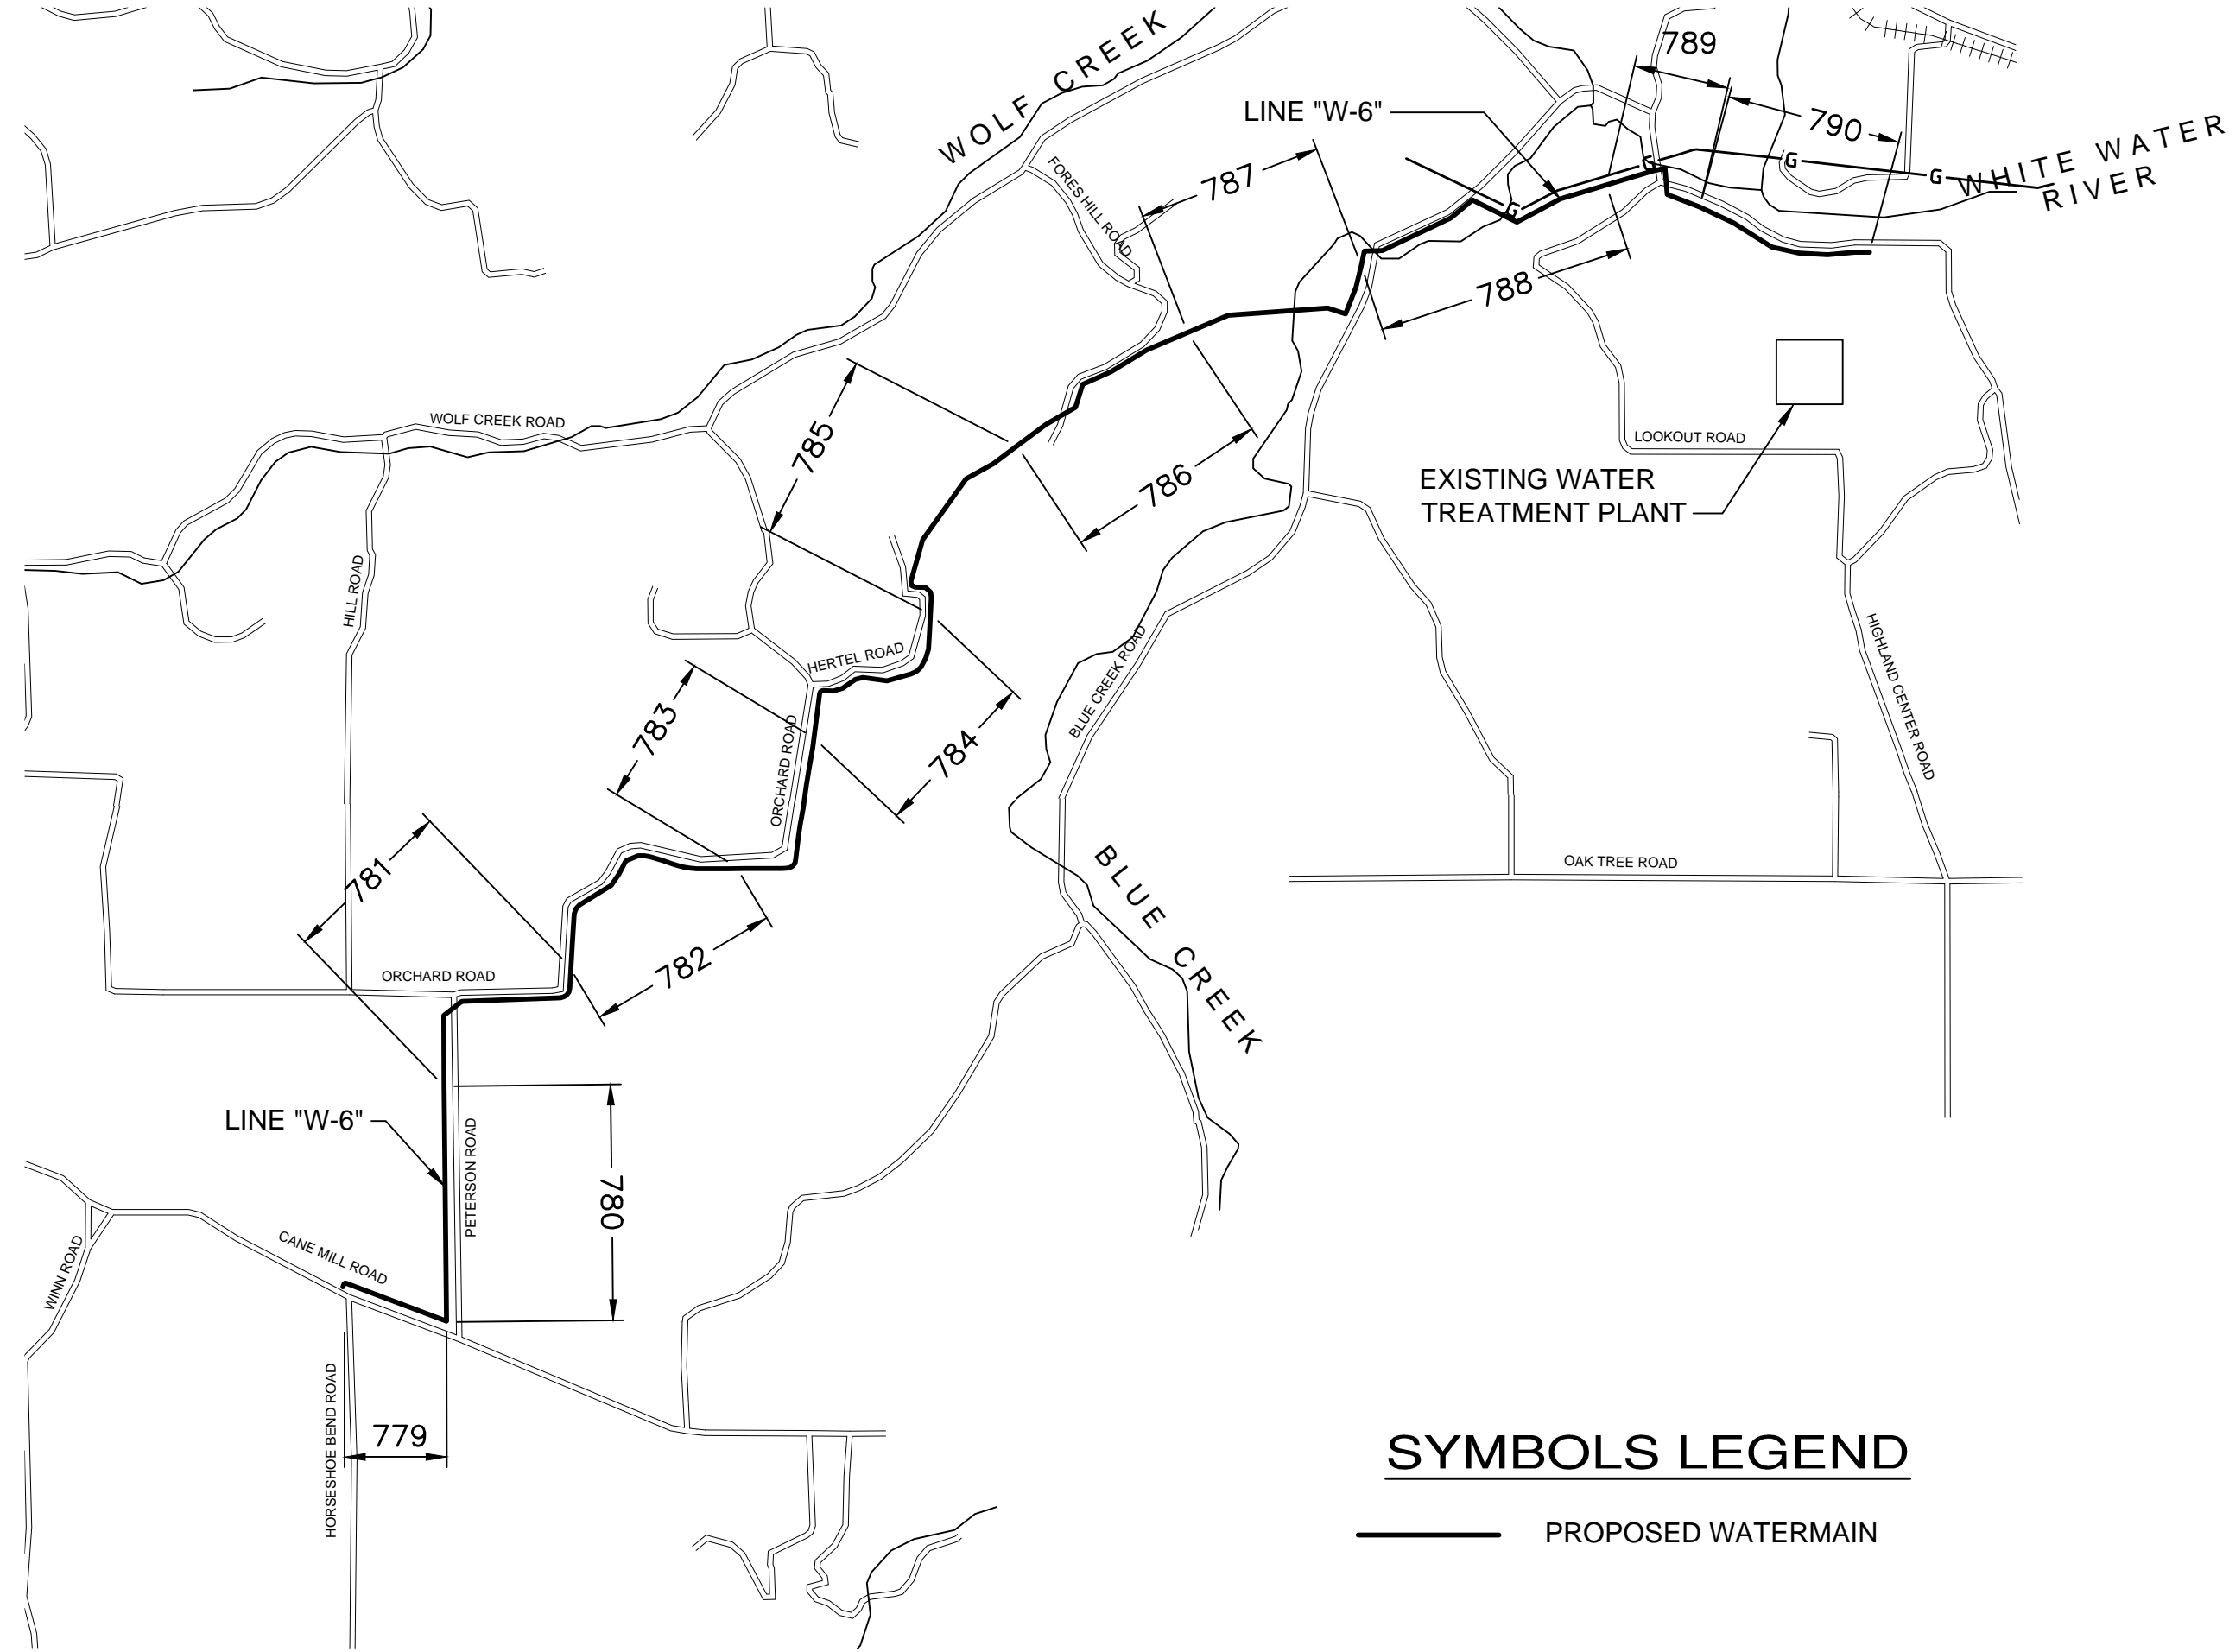


 **W-6 CONTRACT "H-4"**  
**CANE MILL AREA SHEET INDEX**  
SCALE: 1" = 2000'

**SYMBOLS LEGEND**  
— PROPOSED WATERMAIN

THIS RECORD DOCUMENT HAS BEEN PREPARED BASED ON INFORMATION PROVIDED BY THE CONSTRUCTION CONTRACTOR. GRW ENGINEERS, INC. HAS ATTEMPTED TO VERIFY THE ACCURACY AND/OR COMPLETENESS OF THIS INFORMATION BUT SHALL NOT BE RESPONSIBLE FOR ANY ERRORS OR OMISSIONS WHICH MAY BE INCORPORATED HEREIN AS A RESULT.

  
ENGINEERS - ARCHITECTS - PLANNERS  
www.grwinc.com  
ENGINEER/ARCHITECT: CRAIG FARRELL  
CONSTRUCTION COMPANY: MIKE HOLMAN EXC., INC.  
DATE: 9/2014

THIS RECORD DOCUMENT HAS BEEN PREPARED BASED ON INFORMATION PROVIDED BY THE CONSTRUCTION CONTRACTOR. GRW ENGINEERS, INC. HAS ATTEMPTED TO VERIFY THE ACCURACY AND/OR COMPLETENESS OF THIS INFORMATION BUT SHALL NOT BE RESPONSIBLE FOR ANY ERRORS OR OMISSIONS WHICH MAY BE INCORPORATED HEREIN AS A RESULT.


  
ENGINEERS - ARCHITECTS - PLANNERS  
www.grwinc.com  
ENGINEER/ARCHITECT: CRAIG FARRELL  
CONSTRUCTION COMPANY: BRACKNEY, INC.  
DATE: 9/2014

This document, originally issued, sealed, and signed by Daniel R. Cutshaw, Indiana Professional Engineer, No. 11200431, on April 19, 2013, shall not be used in lieu of a certified document.

GRW PROJECT NO. 3916-01

CLIENT CONTRACT NO. H-384

ALL RIGHTS RESERVED. NO PART OF THIS DOCUMENT SHALL BE REPRODUCED IN WHOLE OR IN PART WITHOUT THE WRITTEN PERMISSION OF GRW ENGINEERS, INC. AND SHALL NOT BE USED FOR ANY OTHER PROJECT OTHER THAN THIS SPECIFIC PROJECT WITHOUT WRITTEN PERMISSION.

  
ENGINEERS - ARCHITECTS - PLANNERS  
www.grwinc.com

**PENNTOWN, HORSESHOE BEND & CANE MILL**  
**PROJECT AREA SHEET INDEX**  
DIVISION H - WATERWORKS SYSTEM IMPROVEMENTS  
HOOSIER HILLS REGIONAL WATER DISTRICT  
RIPLEY AND FRANKLIN COUNTIES, INDIANA

| NO. | REVISIONS         | DATE   | BY  | DESIGNED | DRC |
|-----|-------------------|--------|-----|----------|-----|
|     |                   |        |     | ALW      |     |
| 1.  | AS-BUILT REVISION | 9/2014 | JEC | JAJ      |     |
|     |                   |        |     | CJF      |     |
|     |                   |        |     |          |     |
|     |                   |        |     |          |     |
|     |                   |        |     |          |     |

DATE: **APRIL 2013**

SCALE: **1"=2000'**

SHEET NO. **G-03**

SCALE CHECK: \_\_\_\_\_ THIS MARK SHOULD MEASURE EXACTLY 1" WHEN PLOTTED