




NOTES:

|           |             |      |     |
|-----------|-------------|------|-----|
|           |             |      |     |
|           |             |      |     |
| 2         | RENUMBERED  | 6-03 | GCR |
| 1         | AS-BUILT    | 8-01 | MAT |
| NO.       | DESCRIPTION | DATE | BY  |
| REVISIONS |             |      |     |

HOOSIER HILLS REGIONAL  
WATER DISTRICT

GRIMSLEY ROAD EAST WATER MAIN LINE EXTENSION

GRW PROJECT NO. 2543-29

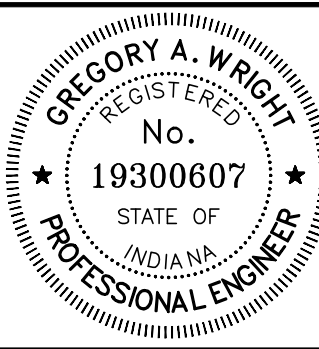

|                          |                         |
|--------------------------|-------------------------|
| DRAWN:<br>GCR            | DATE:<br>SEPTEMBER 2000 |
| FILE NAME:<br>SHT644.DWG | SCALE:<br>1"=50'        |
| CHECKED:                 | SHEET NO.               |
| APPROVED:                | 644                     |

RECORD DRAWING

This drawing has been revised from the original contract drawings to show minor / major changes made during construction. This drawing is not warranted to be complete and accurate in all respects.

GRW Engineers, Inc.

Date: 8-8-01 By: M.A.T.