


HOOSIER HILLS REGIONAL WATER DISTRICT HICKORY ROAD WATER MAIN IMPROVEMENTS

SITE VICINITY MAP




PROJECT LOCATION

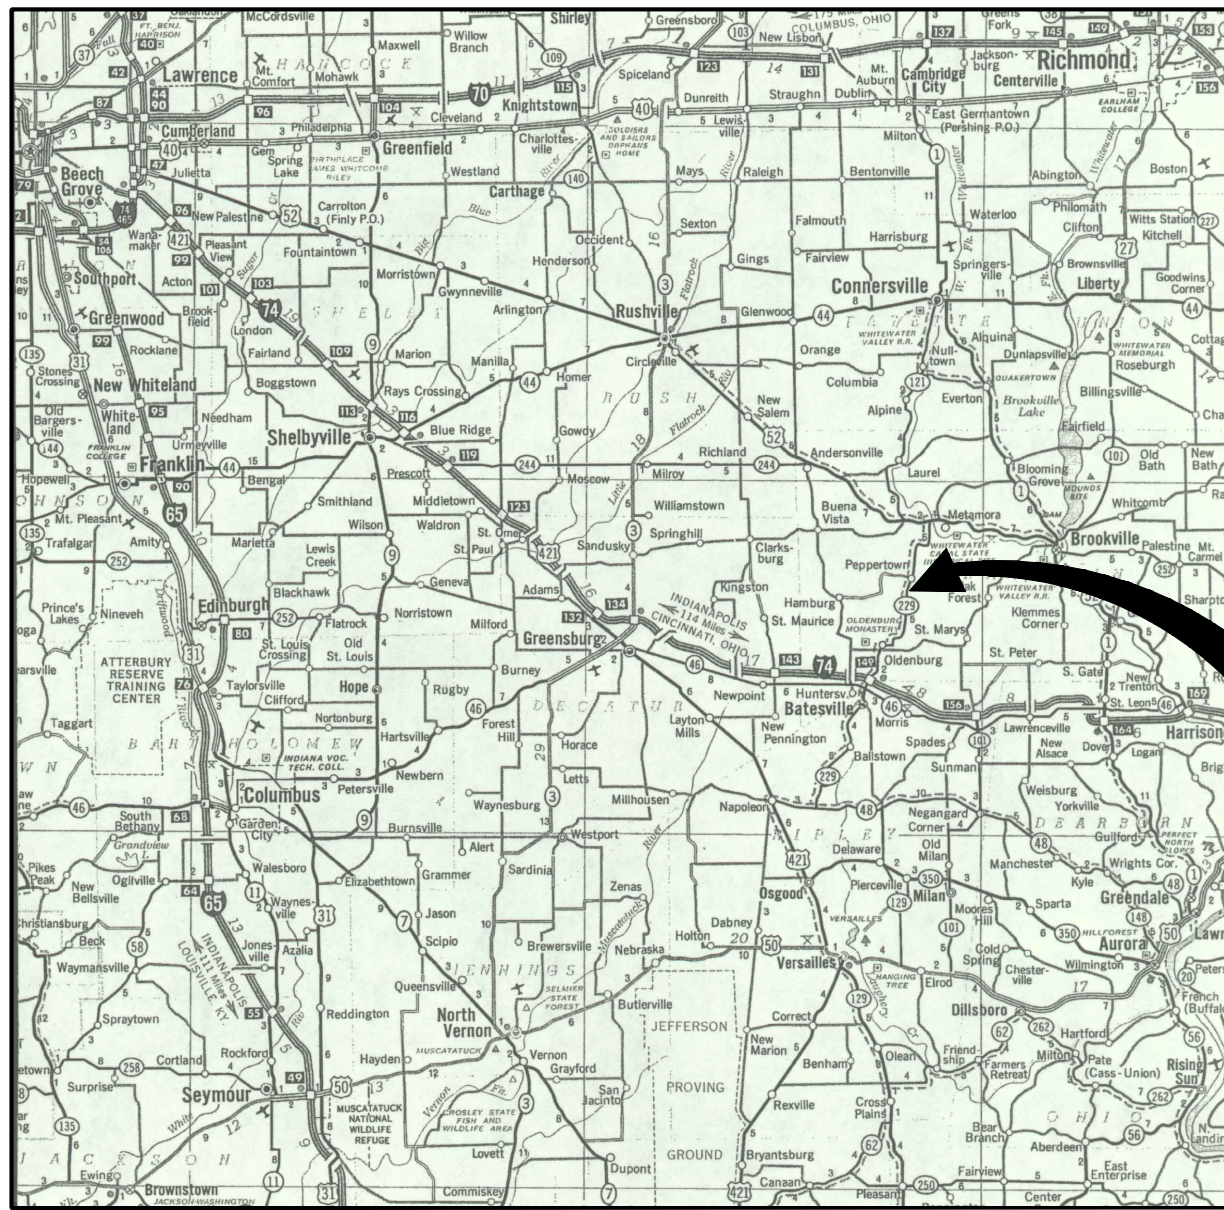

GRW Engineers, Inc.
7112 WALDEMAR DRIVE
INDIANAPOLIS, IN. 46268
(317) 347-3650

INDIANAPOLIS, INDIANA
LEXINGTON & LOUISVILLE, KENTUCKY
NASHVILLE, TENNESSEE
ARLINGTON, TEXAS
CINCINNATI, OHIO

SITE LOCATION MAP

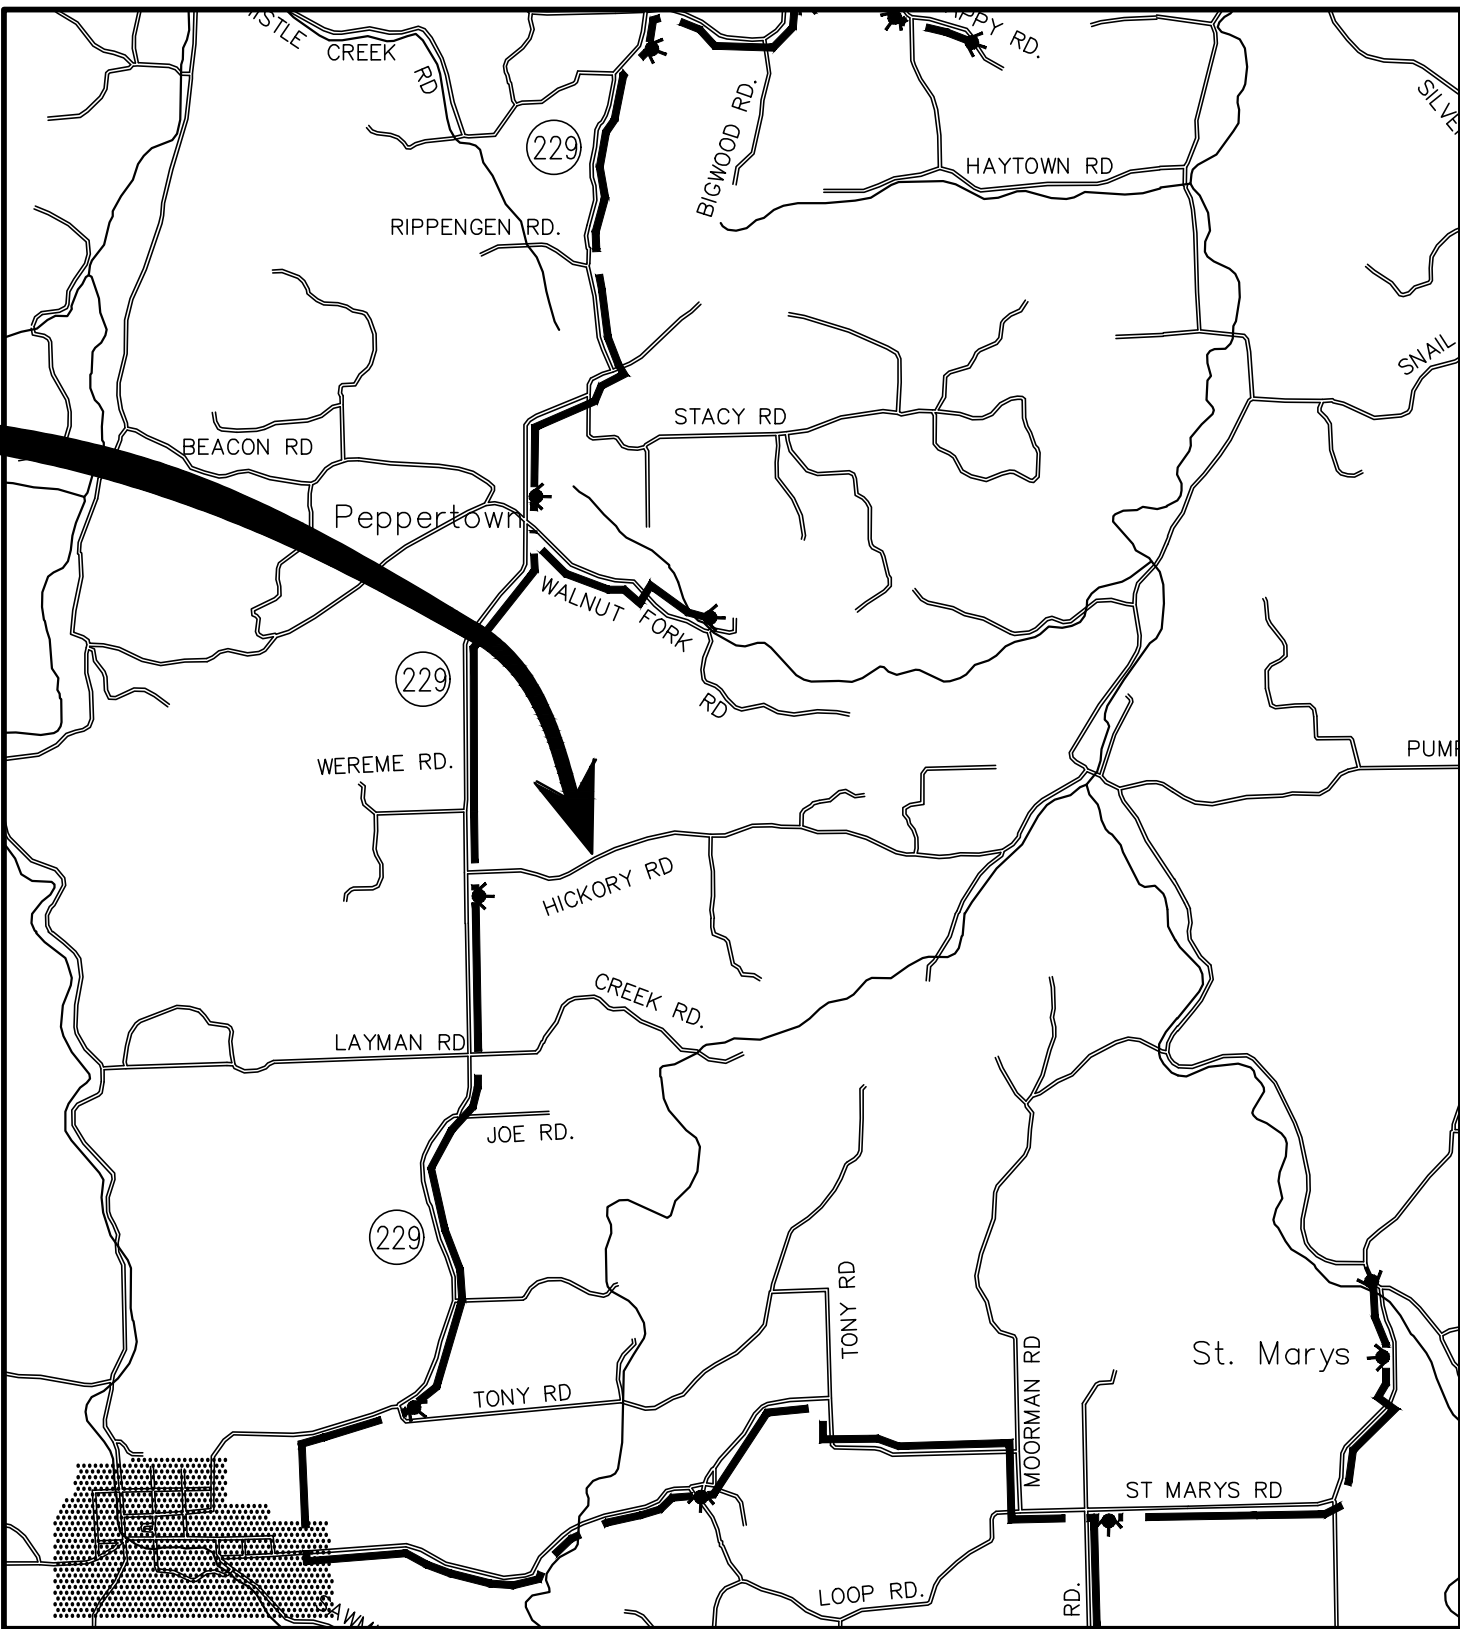

PROPOSED WATER MAIN
EXTENSION LOCATION

INDEX OF DRAWINGS

SHEET NO.	DESCRIPTION
---	COVER SHEET
642	HICKORY ROAD, 10+00 TO 32+58
643	HICKORY ROAD, 32+58 TO 65+20

AUGUST 2000

RECORD DRAWING
This drawing has been revised from the original contract drawings to show minor / major changes made during construction. This drawing is not warranted to be complete and accurate in all respects.
GRW Engineers, Inc.
Date: 12-5-02 By: Mary Thomas

GREGORY A. WRIGHT, P.E.
INDIANA REG. NO. 19300607

