


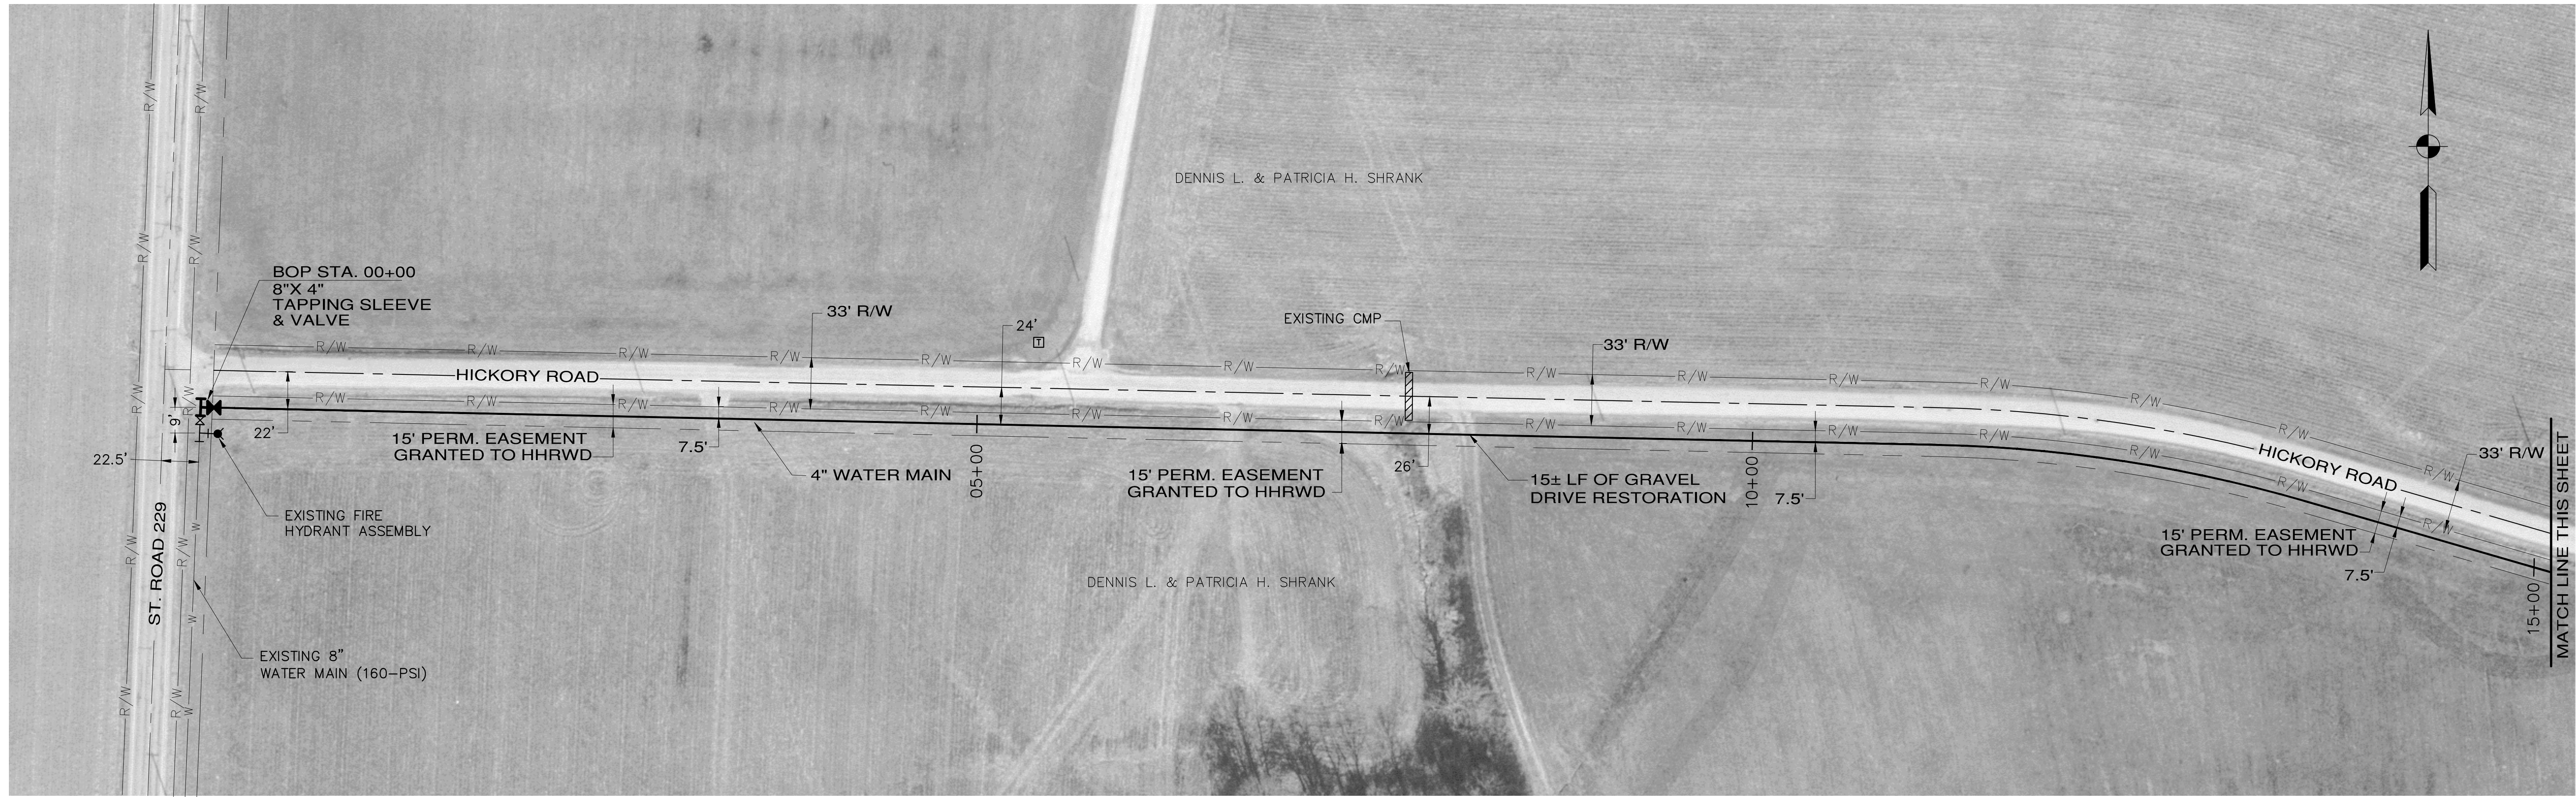


NOTES:
ALL PIPING SHALL BE SDR 21 PVC UNLESS OTHERWISE NOTED.

NO.	DESCRIPTION	DATE	BY
2	RENUMBERED	6-03	GCR
1	REVISED PER ASBUILT DRAWINGS	12-5-02	MAT
REVISIONS			

HOOSIER HILLS REGIONAL
WATER DISTRICT

HICKORY ROAD WATER MAIN EXTENSION

GRW PROJECT NO. 2543-25

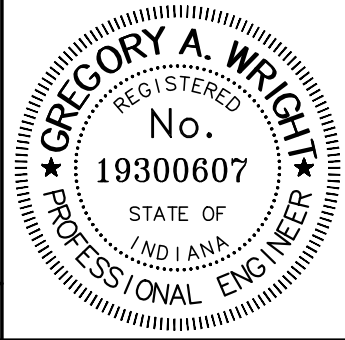

GRW Engineers, Inc.
Engineers, Architects, Planners
INDIANAPOLIS, INDIANA
LOUISVILLE & LEXINGTON, KENTUCKY
CINCINNATI, OHIO
NASHVILLE, TENNESSEE
ARLINGTON, TEXAS

DRAWN: GR	DATE: AUGUST2000
FILE NAME: SHT642.DWG	SCALE: 1"=50'
CHECKED: DRC	SHEET NO.
APPROVED: GAW	642