


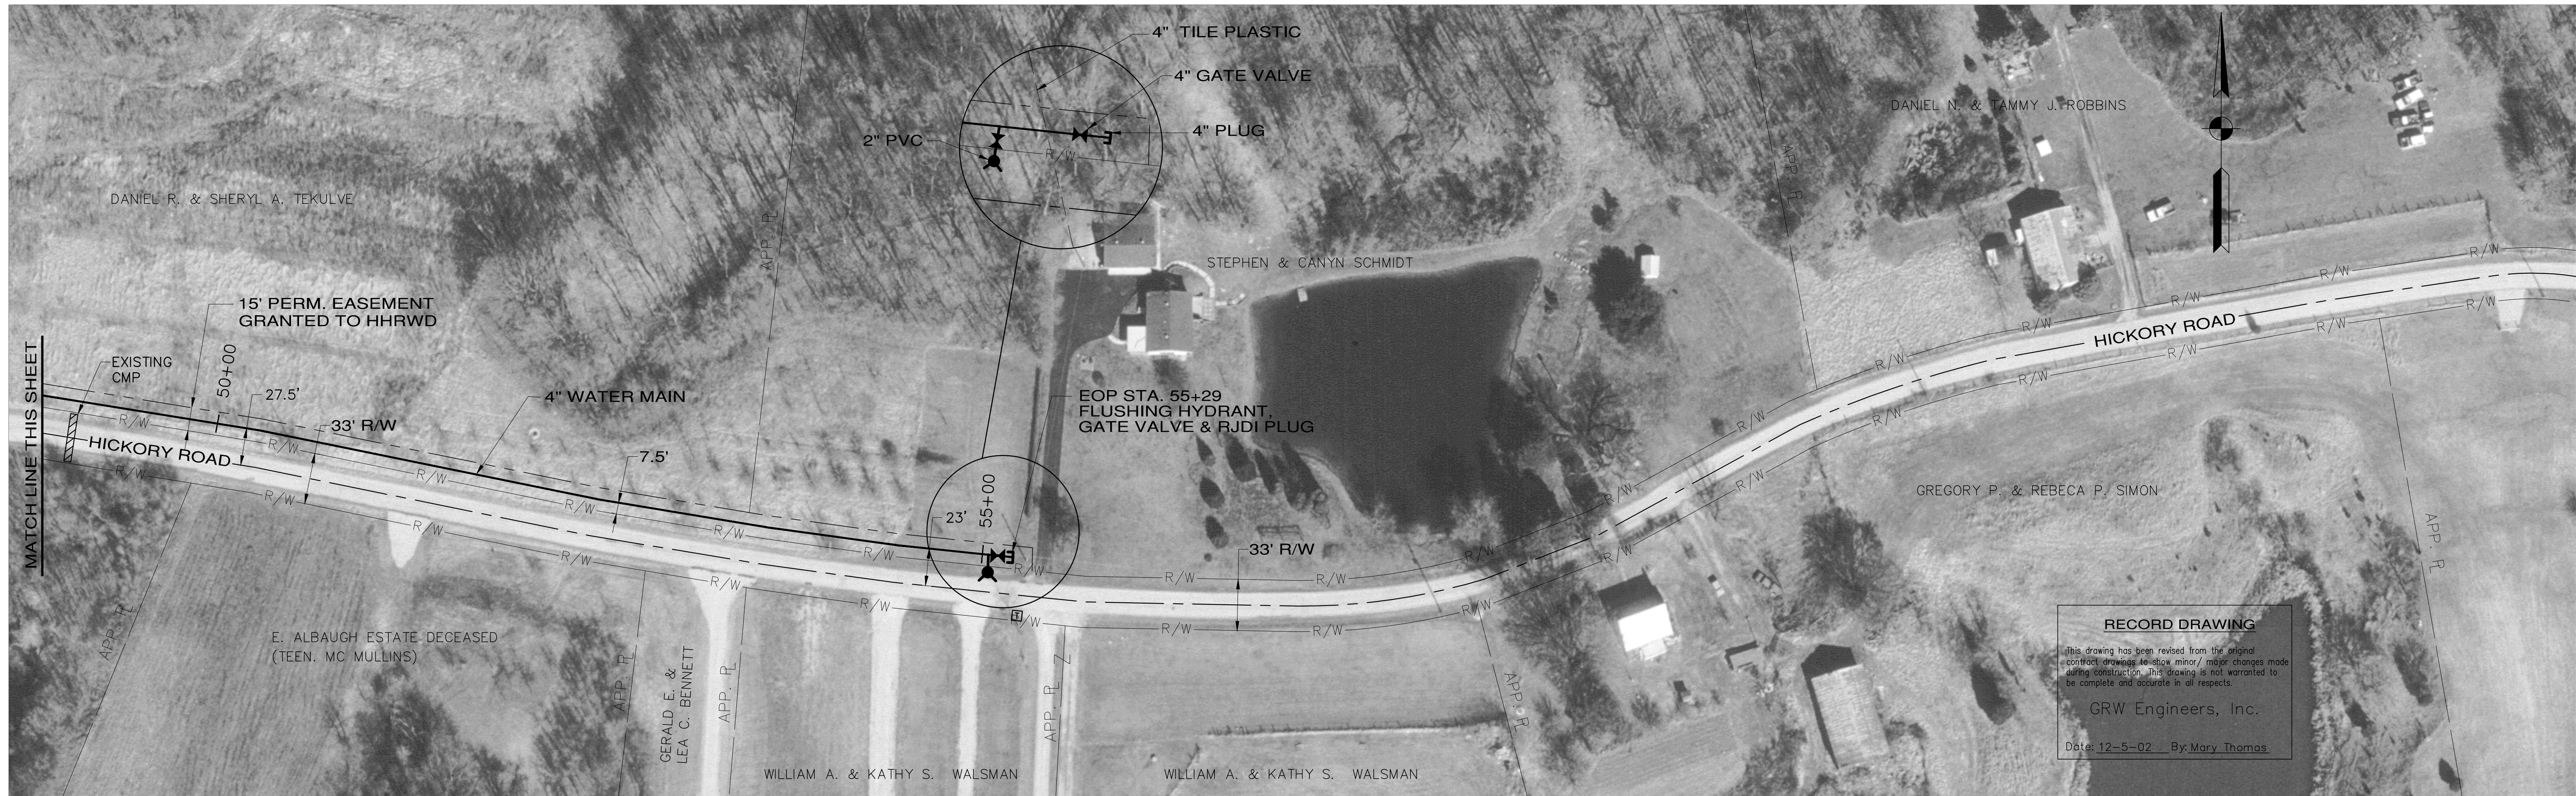


NOTES:
ALL PIPING SHALL BE SDR 21 PVC UNLESS OTHERWISE NOTED.

NO.	DESCRIPTION	DATE	BY
2	RENUMBERED	6-03	GCR
1	REVISED PER ASBUILT DRAWINGS	12-5-02	MAT
REVISIONS			

HOOSIER HILLS REGIONAL
WATER DISTRICT

HICKORY ROAD WATER MAIN EXTENSION

GRW PROJECT NO. 2543-25 & 77

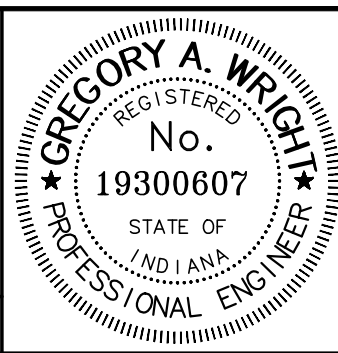

DRAWN: GR	DATE: AUGUST2000
FILE NAME: SHT643.DWG	SCALE: 1"=50'
CHECKED: DRC	SHEET NO. 643
APPROVED: GAW	