



HOOSIER HILLS REGIONAL WATER DISTRICT LAKEVIEW DRIVE WATER MAIN EXTENSION

HOOSIER HILLS REGIONAL WATER DISTRICT BOARD OF DIRECTORS

GREGORY DOLE – PRESIDENT
RANDY SCUDDER – VICE PRESIDENT
CHARLES HYNES – SECRETARY
HELEN GRIGSBY – TREASURER
ANDREW WEISENBACH – ASST. TREASURER
TED MEER – BOARD MEMBER
ROY B. MEYER – BOARD MEMBER
RUSSELL MORTARA – BOARD MEMBER
ANTHONY CLARK – BOARD MEMBER
SCOTT STIRN – GENERAL MANAGER



SITE LOCATION MAP

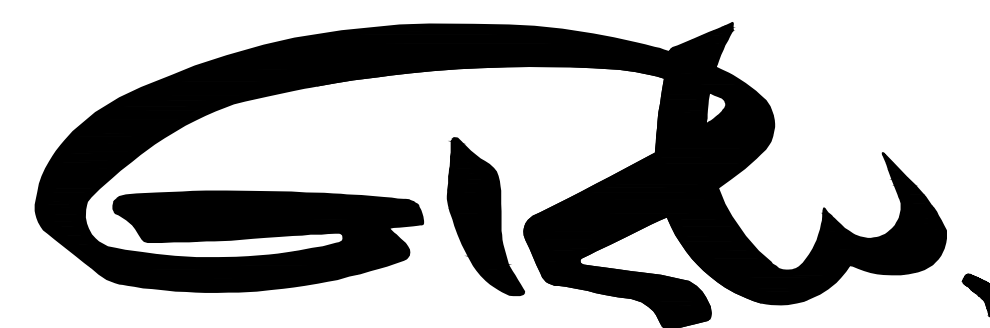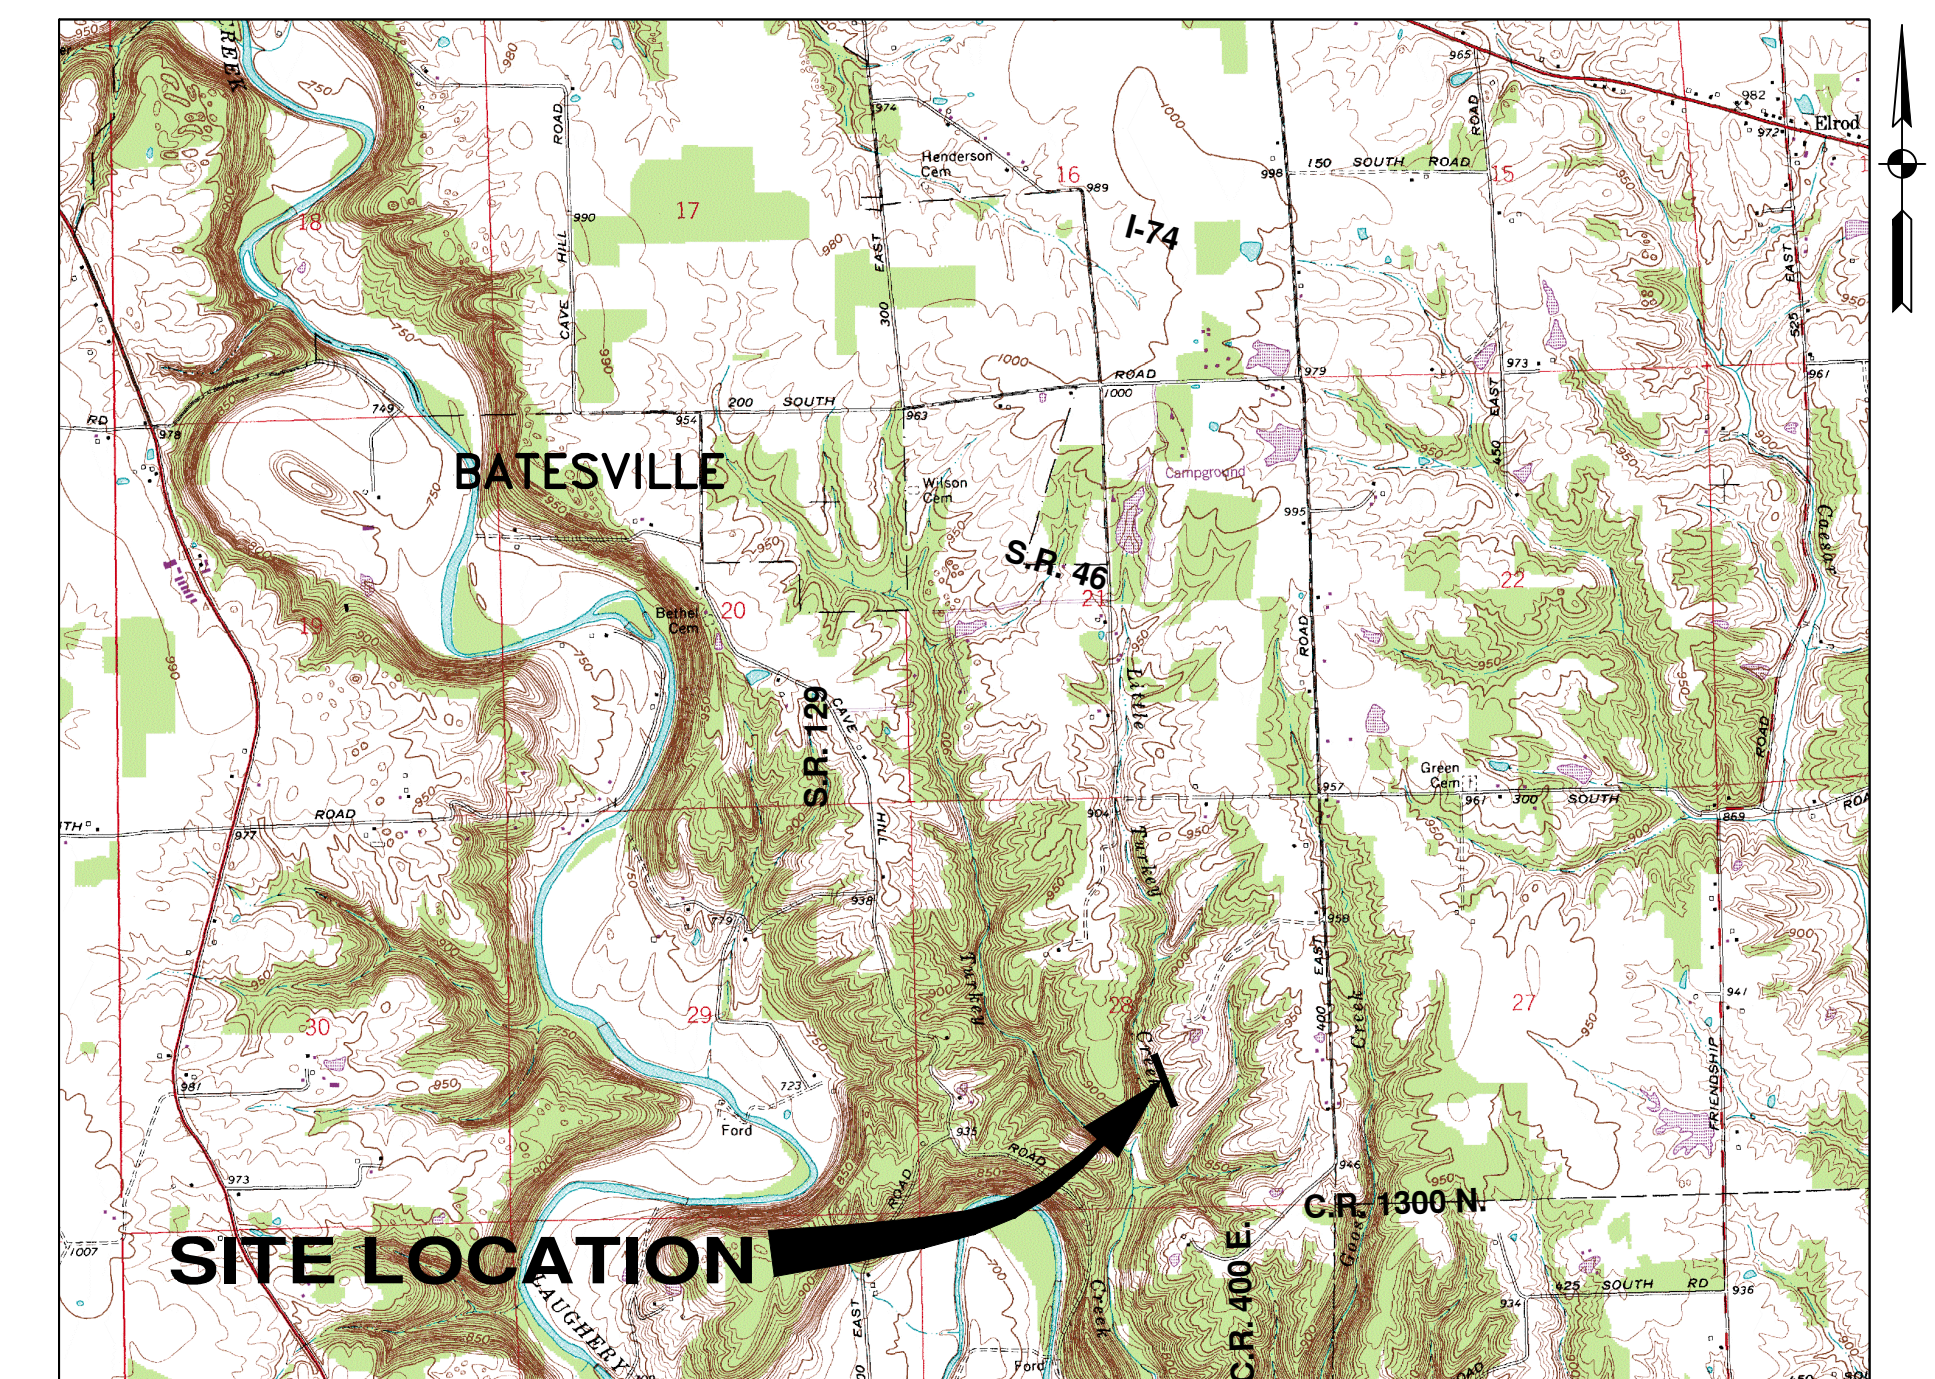

GRW Engineers, Inc.
Engineers, Architects, Planners

7112 WALDEMAR DRIVE - INDIANAPOLIS, IN. 46268
PH. (317)347-3650 FAX (317)347-3656
LEXINGTON LOUISVILLE NASHVILLE INDIANAPOLIS
FORT MITCHELL KNOXVILLE ARLINGTON COLUMBUS



RECORD DRAWING

This drawing has been revised from the original contract drawings to show minor/ major changes made during construction. This drawing is not intended to be complete and accurate in all respects.

GRW Engineers, Inc.

Date: 9-25-2009 By: TNW

INDEX OF DRAWINGS	
NO.	DRAWING TITLE
GENERAL	
G-00	COVER SHEET
CIVIL	
705	LAKEVIEW DRIVE

APRIL 2009

GRW PROJECT NO. 3421-28