




RECORD DRAWING

This drawing has been revised from the original contract drawings to show minor / major changes made during construction. This drawing is not warranted to be complete and accurate in all respects.

GRW Engineers, Inc.

Date: 9-25-2009 By: TNW

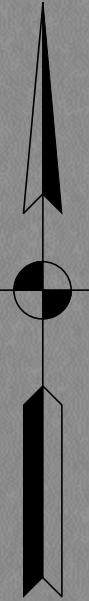


- NOTES:
- 1). THE UTILITIES AND THEIR LOCATION SHOWN ON PLANS ARE APPROXIMATE. CONTRACTOR SHALL VERIFY ALL UTILITIES IN THE FIELD AND NOTIFY ALL UTILITY COMPANIES PRIOR TO INSTALLATION OF THE WATER LINE.
 - 2). ALL PIPING SHALL BE CLASS 200 PVC UNLESS OTHERWISE NOTED.
 - 3). 48" MINIMUM COVER REQUIRED OVER TOP OF WATER LINE.
 - 4). THE LOCATION OF AIR RELEASE VALVES IS APPROXIMATE. VALVES SHALL BE LOCATED AND INSTALLED BY THE CONTRACTOR AT THE HIGH POINT ALONG THE WATER LINE.

1	AS BUILT	9-04	CLC
NO.	DESCRIPTION	DATE	BY
REVISIONS			

HOOSIER HILLS REGIONAL
WATER DISTRICT

LAKEVIEW DRIVE
WATER MAIN EXTENSION

GRW PROJECT NO. 2543-78 & 3421-28

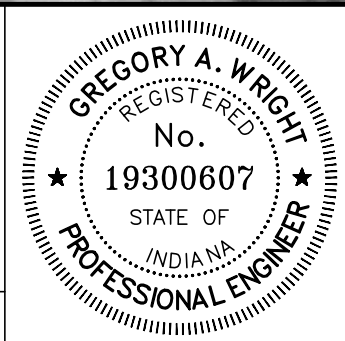

GRW Engineers, Inc.
Engineers, Architects, Planners
INDIANAPOLIS, INDIANA
LOUISVILLE & LEXINGTON, KENTUCKY
CINCINNATI, OHIO
KNOXVILLE & NASHVILLE, TENNESSEE
ARLINGTON, TEXAS

DRAWN: GCR
FILE NAME: SHT705.DWG
CHECKED: GCR TNW
APPROVED: DRC

DATE: APRIL 2009
SCALE: 1" = 50'
SHEET NO. 705